



ENCROACHMENT PERMIT
General Permit
 City of Riverside - Public Works Dept.
 951-826-5341

Issuance of this permit shall not be construed as a waiver of any other applicable permit or requirement, and is only revocable permission to use the land for the purpose described.

Owner: ELIZABETH BURDEN
Location: 3345 PACHAPPA DR RIVE
A.P.N.: 219-241-003

Encroachment: RETAINING WALL ENCROACHING INTO A PU EASEMENT

The above-described encroachment being shown on Exhibit A attached hereto.

Upon issuance of this permit, I agree to comply with the attached terms and conditions.

Date: 11/18/11

By: Elizabeth Burden

Date: _____

By: _____

Applicant
 ELIZABETH BURDEN

Contractor/Developer

ENCROACHMENT PERMIT APPROVAL

This permit has been reviewed and approved by the Departments listed below, provided the attached terms and conditions are adhered to:

- P/W ENGINEERING
- P/W TRAFFIC
- P/U WATER
- P/U ELECTRIC
- PLANNING

FINAL APPROVAL

Date: 11/18/11

[Signature]
 City Engineer

THIS PERMIT IS NOT VALID UNTIL ISSUED AND POSTED IN CITY RECORDS

Issued By: A. Clark

Dated: 11-18-11




City of Riverside

The following are requirements that need to be met for your permit #PW11-0586 .

- 1: Permittee acknowledges that the area of encroachment is owned or controlled by the City of Riverside.
- 2: Permittee acknowledges that the described property could be needed for a proposed or planned public improvement and the City may revoke this permit. Upon written notice of revocation, the permittee shall, within the time prescribed by the City, remove all improvements placed, constructed or maintained. If the permittee fails to abide by the removal order of the City, the City shall have the right to remove and destroy the improvements without reimbursement to the permittee. The cost of such removal shall be paid by the permittee to the City and shall constitute a debt owed to the City.
- 3: Permittee waives the right of claim, loss, damage or action against the City resulting from revocation, termination, removal of improvements or any action of the City, its officers, agents or employees taken in accordance with the terms herein.
- 4: If the Public Works Director of the City of Riverside finds that the permittee is in default of the terms of this permit, that shall be cause for revocation.
- 5: Permittee herewith agrees to hold the City of Riverside harmless from and against all claims demands, costs, losses, damages, injuries, actions for damages and/or injuries, and liability in connection with the construction, encroachment, and/or maintenance to be done by permittee within the described property.
- 6: Prior to any construction taking place on City controlled property, permittee shall obtain a Construction Permit or Street Opening Permit from the City Public Works Department.
- 7: The permittee agrees to insure that construction of their improvements will not interfere in any way with any existing City or utility facilities.
- 8: Permittee acknowledges that existing city or utility facilities will require future maintenance, reconstruction, and revisions and that facilities may be added, any of which may result in removal or alteration of the permittee's improvements without reimbursement to the permittee.
- 9: Prior to construction, permittee shall contact Underground Service Alert to field locate existing utility lines. Any conflicts discovered will void the permit until acceptable revisions are made. It shall be Permittee's responsibility to determine the location and required clearances from all public and private utility, sewer and drainage facilities prior to drilling and shall only drill in compliance with such clearance requirements.

The City of Riverside makes no warranty on the accuracy or content of the data shown on this map. This map shall not be reproduced or distributed. © Copyright 2011, City of Riverside, California

Scale 1" = 60'

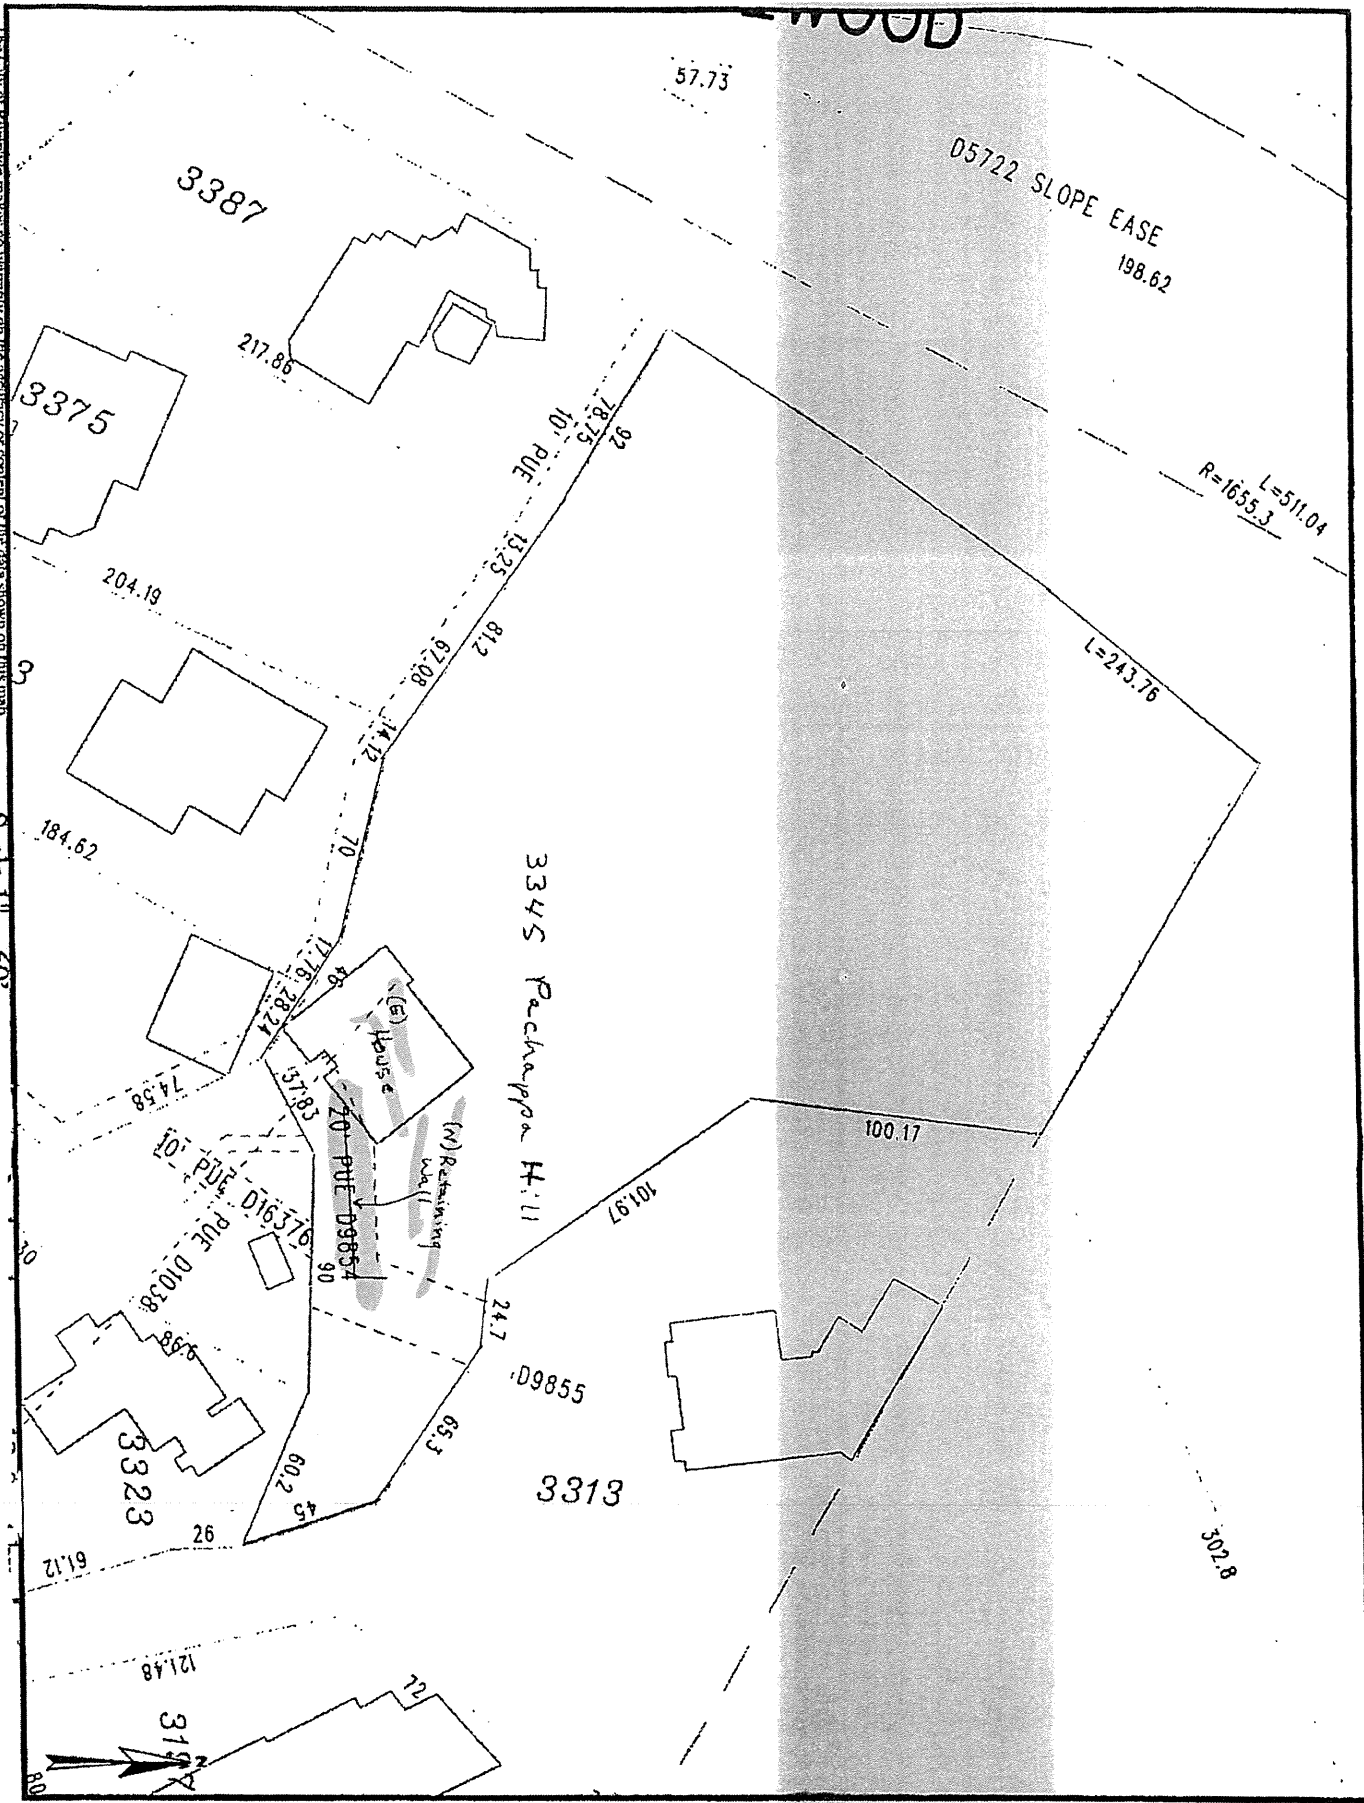

E11-0586

From: Norton, Brian [<mailto:BNorton@riversideca.gov>]
Sent: Thursday, October 13, 2011 9:57 AM
To: Clarice Burden
Subject: RE: CITY OF RIVERSIDE - 3345 Pachappa Hill Dr.

Clarice-

Summer Delgado from P.U. was fine with placing the wall in the easement contingent on the encroachment permit being approved.

Thanks-
Brian

BRIAN NORTON
PLANNING TECHNICIAN
3RD FLOOR
PLANNING DIVISION
COMMUNITY DEVELOPMENT DEPARTMENT
CITY OF RIVERSIDE
PHONE-951-826-2308
E-MAIL BNORTON@RIVERSIDECA.GOV