

ENCROACHMENT PERMIT

Pursuant to Resolution No. 11065 of the City of Riverside, permission is hereby granted to Hugh C. and Patricia L. Oren

their heirs and assigns, hereinafter referred to as "Permittee" to use and occupy the following described property. That portion of the public right of way of Hollyridge Drive adjacent to Lot 33 of Tract 3026, MB57/14-15, Rec. Riv. Co. known as 5945 Kitty Hawk Drive as shown on Exhibit "A":

in accordance with the terms hereof.

1. Permittee shall use and occupy the described property only in the manner and for the purposes as follows: for construction and maintenance of a concrete block retaining wall, ranging from 2 foot high at the south end to 7 foot high at the north end, encroaching 4.5 feet into the right of way as shown on Exhibit "A".

1a. Permittees contractor shall obtain street opening permit from the City Public Works Department

1b. Permittee shall verify that no gas or telephone facilities are in the area of the wall.

1c. Wall shall not be built within 36 inches of any portion of the existing Fire Hydrant.

1d. Street tree shall be protected to the specifications of the Parks Department.

2. Permittee, by acceptance of the benefits hereunder, acknowledges title to the property to be in the City of Riverside and waives any right to contest the validity of the dedication or grant.

3. Permittee acknowledges that the described property is the site of a proposed or planned public improvement and that, accordingly, all rights and privileges of use permitted shall cease and expire upon notice of revocation by the City. Upon the expiration or revocation, Permittee shall, within the time prescribed by the City, remove all improvements or obstructions placed, constructed or maintained by the Permittee. If the Permittee fails to abide by the removal order of the City within the time prescribed, the City shall have the right to remove and destroy the improvements without reimbursement to the Permittee and the cost of such removal shall be paid by the Permittee to the City of Riverside and shall constitute a debt owed to the City of Riverside.

4. Permittee, by acceptance hereof, waives the right of claim, loss, damage or action against the City of Riverside arising out of or resulting from revocation, termination, removal of the improvements or any action of the City of Riverside, its officers, agents or employees taken in accordance with the terms hereof.

5. Finding and determination by the City Council of the City of Riverside that the Permittee, or his heirs and assigns or successors in interest, are in default of the terms hereunder shall be cause for revocation.

6. Permittee herewith agrees to hold the City of Riverside harmless from and against all claims, demands, costs, losses, damages, injuries, action for damages and/or injuries, and liability growing or arising out of or in connection with the construction, encroachment, and/or maintenance to be done by Permittee or his agents, employees or contractors within the described property.

DATED: MAY 17 1990

CITY OF RIVERSIDE, a municipal corporation

By Terry Tringali Mayor

Attest Alicia P. Lane City Clerk

The foregoing is accepted by:

[Signature]
(Signature(s) of Permittee)
[Signature] 5/14/90

APPROVED AS TO CONTENT

[Signature]
Department Head - Public Works

[Signature]
PARK SUPERINTENDENT

APPROVED AS TO FORM

[Signature]
City Attorney


CITY MANAGER APPROVAL

[Signature]
City Manager

9² of N.W.⁴ of SEC.



EXHIBIT A
SHT 1 of 2

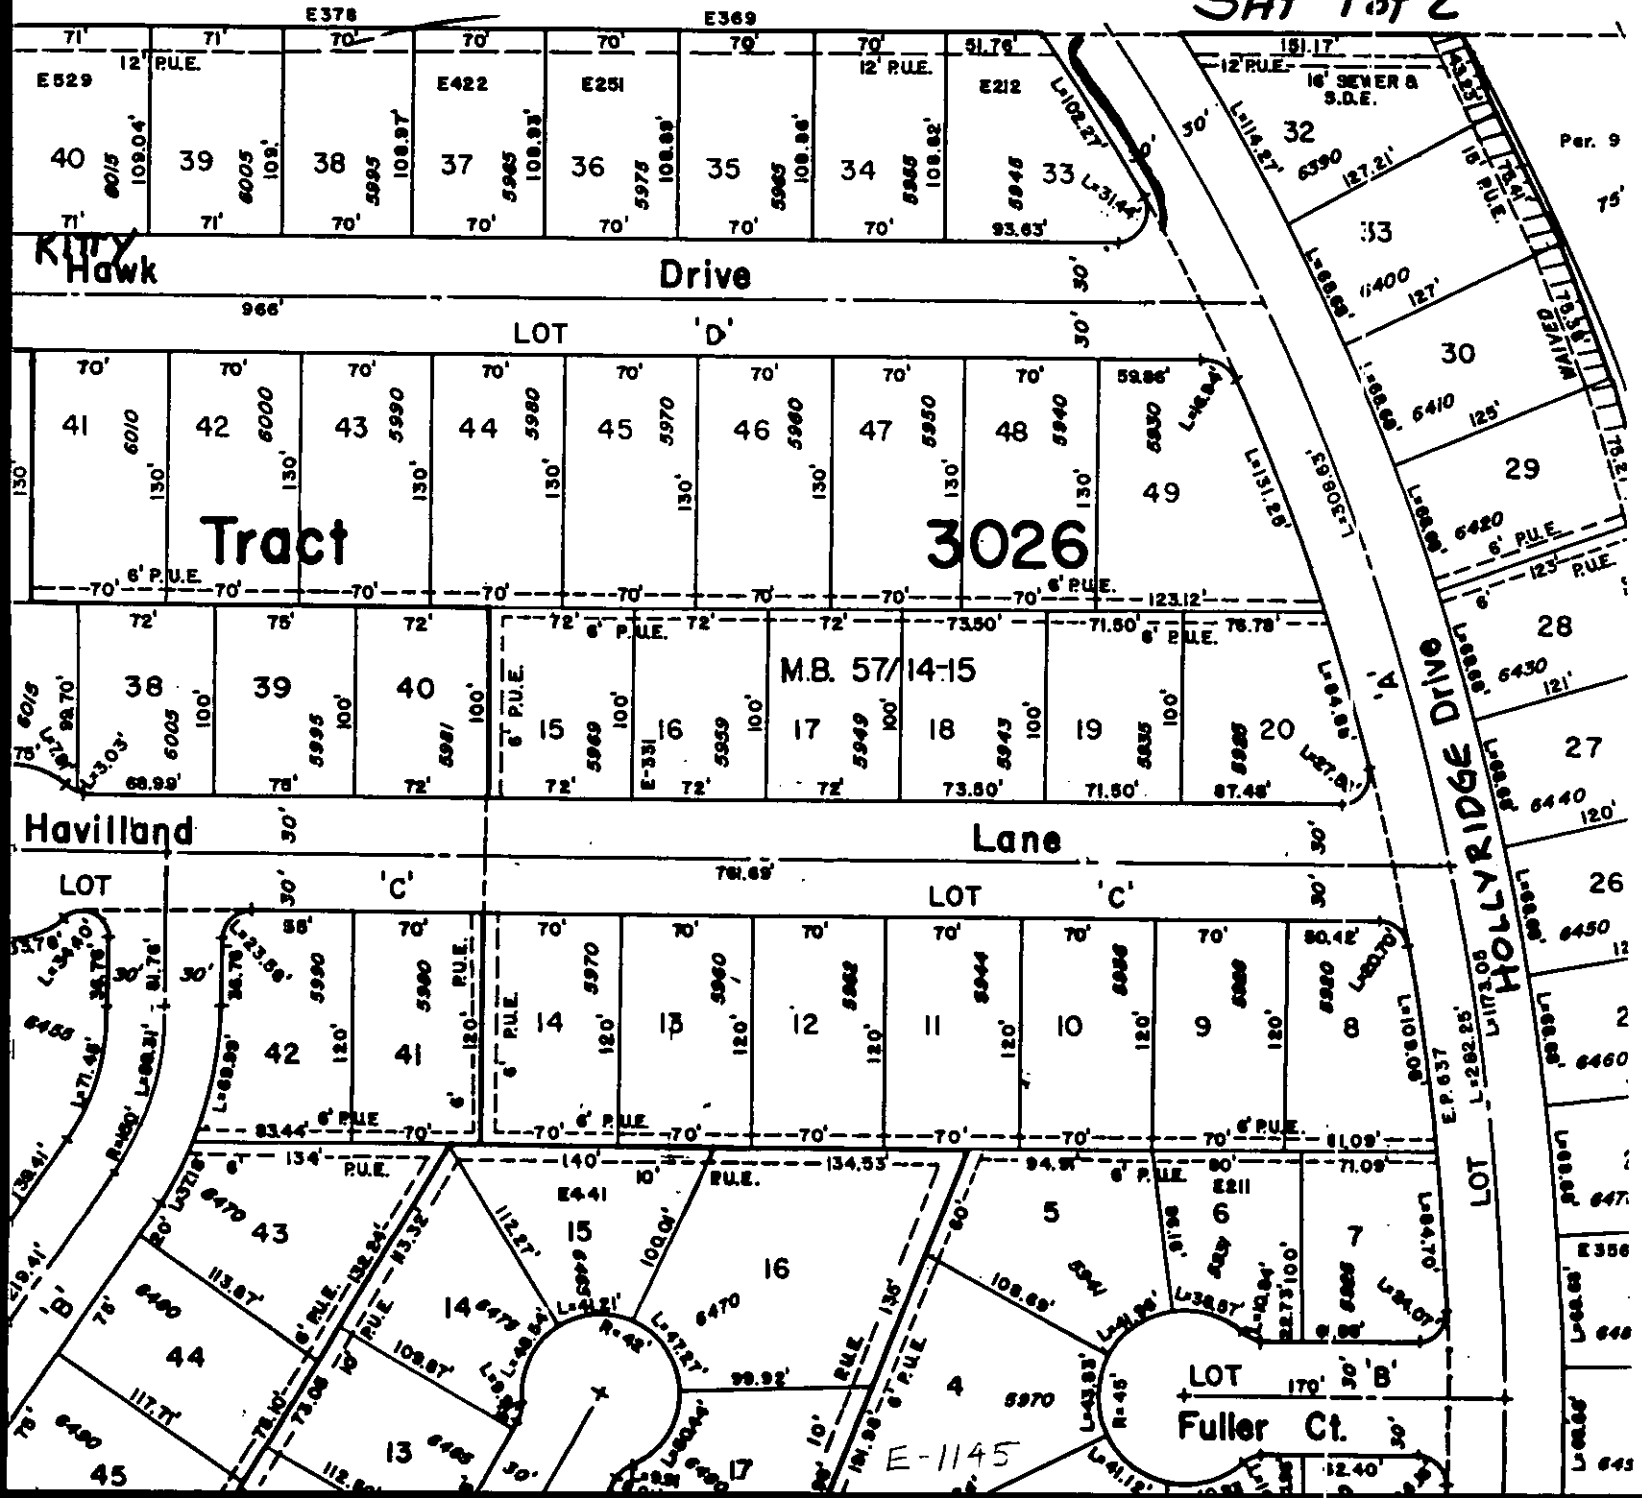

⚠	①	5.
⚠	②	5.

ON PROPERTY LINE (200' NORTH OF AC
 E REMOVED AND SALVAGED BY CITY
 RING INSTALLATION OF NEW WATER MAIN

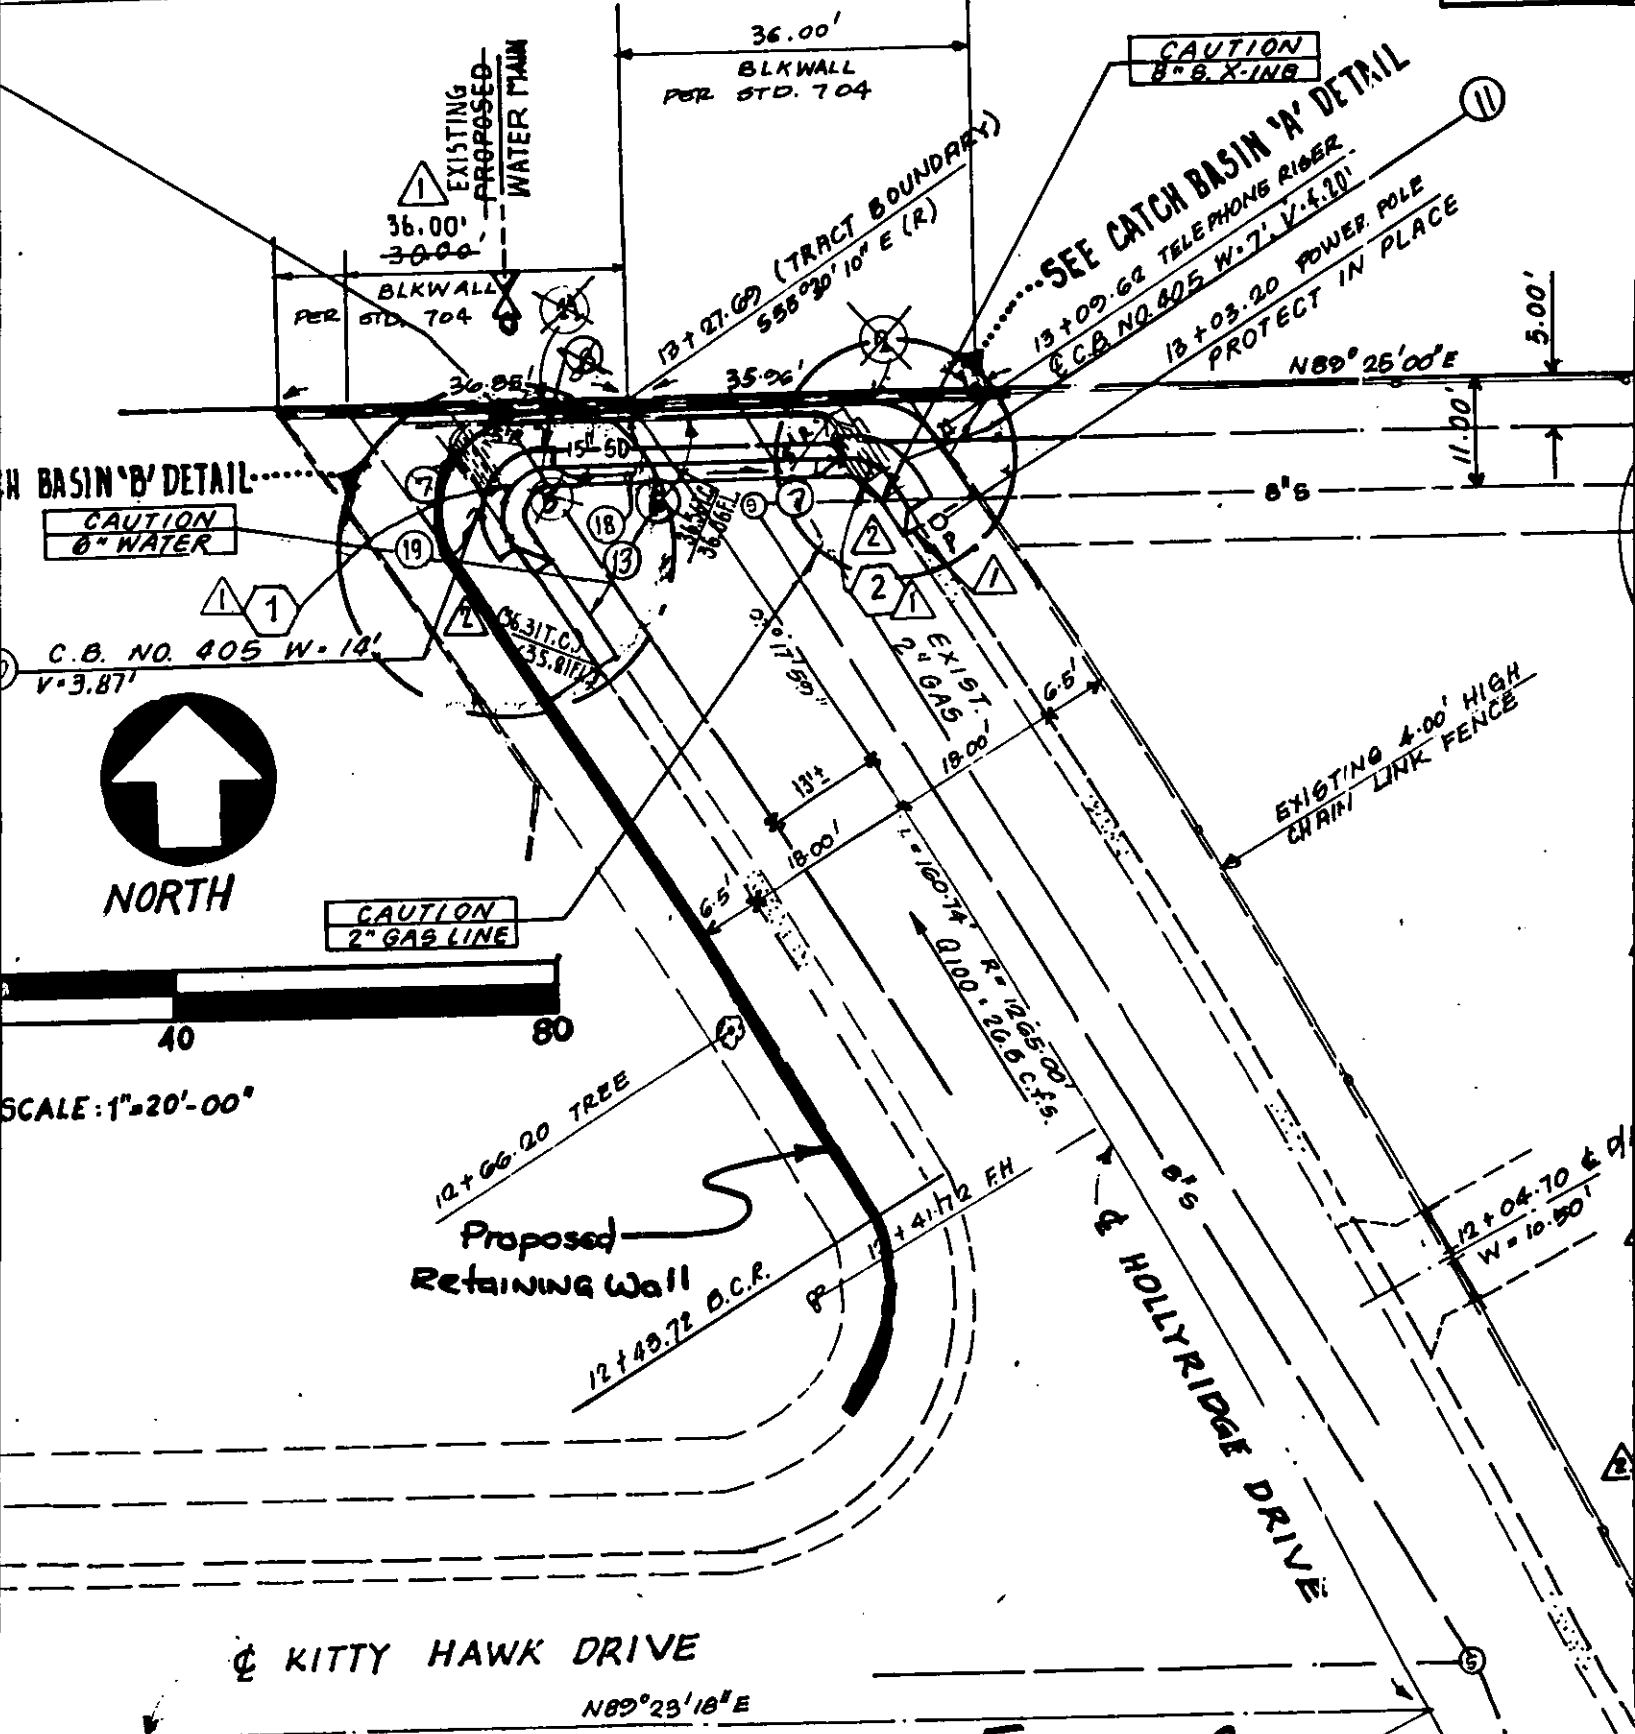


EXHIBIT A
SHT 20F2
 E-1145
 KITTY HAWK DRIVE
 HOLLYRIDGE DR (37-37)