

APPLICATION FOR ENCROACHMENT PERMIT

(to be completed by applicant)

CHRISTINA J. AYALA MEJIA, the X Owner Lessee of the property located at 3007 CRIDGE STREET in the City of Riverside, Assessors Parcel No. 219-114-007 hereby requests permission to MAINTAIN AN EXISTING TWO STORY WOOD FRAME GARAGE WITH CONCRETE APRON 5.0' INTO

the public right of way of HOWARD STREET /or the _____ easement at the rear/ side/ front of said property. The attached drawing shows the requested encroachment. Upon issuance of this permit, I agree to comply with the attached terms and conditions.

Date _____
IF NOT SIGNED BY OWNER IT IS VOID

ENCROACHMENT PERMIT APPROVAL
(to be completed by City)

This permit shall become effective upon the approval of the Departments listed below. Issuance of this permit shall not be construed as a waiver of any other applicable permit or requirement, but is only revocable permission to use the land for the purpose described.

- Public Utilities Water B. Simpson 6/21/94
- Public Utilities Electric Dwayne D. Robinson
- Planning Waij Aaron 6-22-94
- Parks and Recreation _____
- (other) _____
- (other) _____

Upon obtaining the above signatures, return this permit to the Public Works Department for final approval.

Date 6/22/94 [Signature]
Public Works Director


Encroachment Permit No. 1268

TERMS AND CONDITIONS

The following indicated terms and conditions apply to Encroachment Permit No. 1268

1. Permittee acknowledges that the area of the encroachment is owned or controlled by the City of Riverside.
2. Permittee herewith agrees to hold the City of Riverside harmless from and against all claims demands, costs, losses, damages, injuries, actions for damages and/or injuries, and liability in connection with the construction, encroachment, and/or maintenance to be done by permittee within the described property.
3. If the City Council of the City of Riverside finds that the permittee is in default of the terms of this permit, that shall be cause for revocation.
4. The existing improvements may remain in place until such time as further development upon the permittee's property occurs which eliminates the need for the existing structure within the encroachment area.

PROPOSED ENCROACHMENT

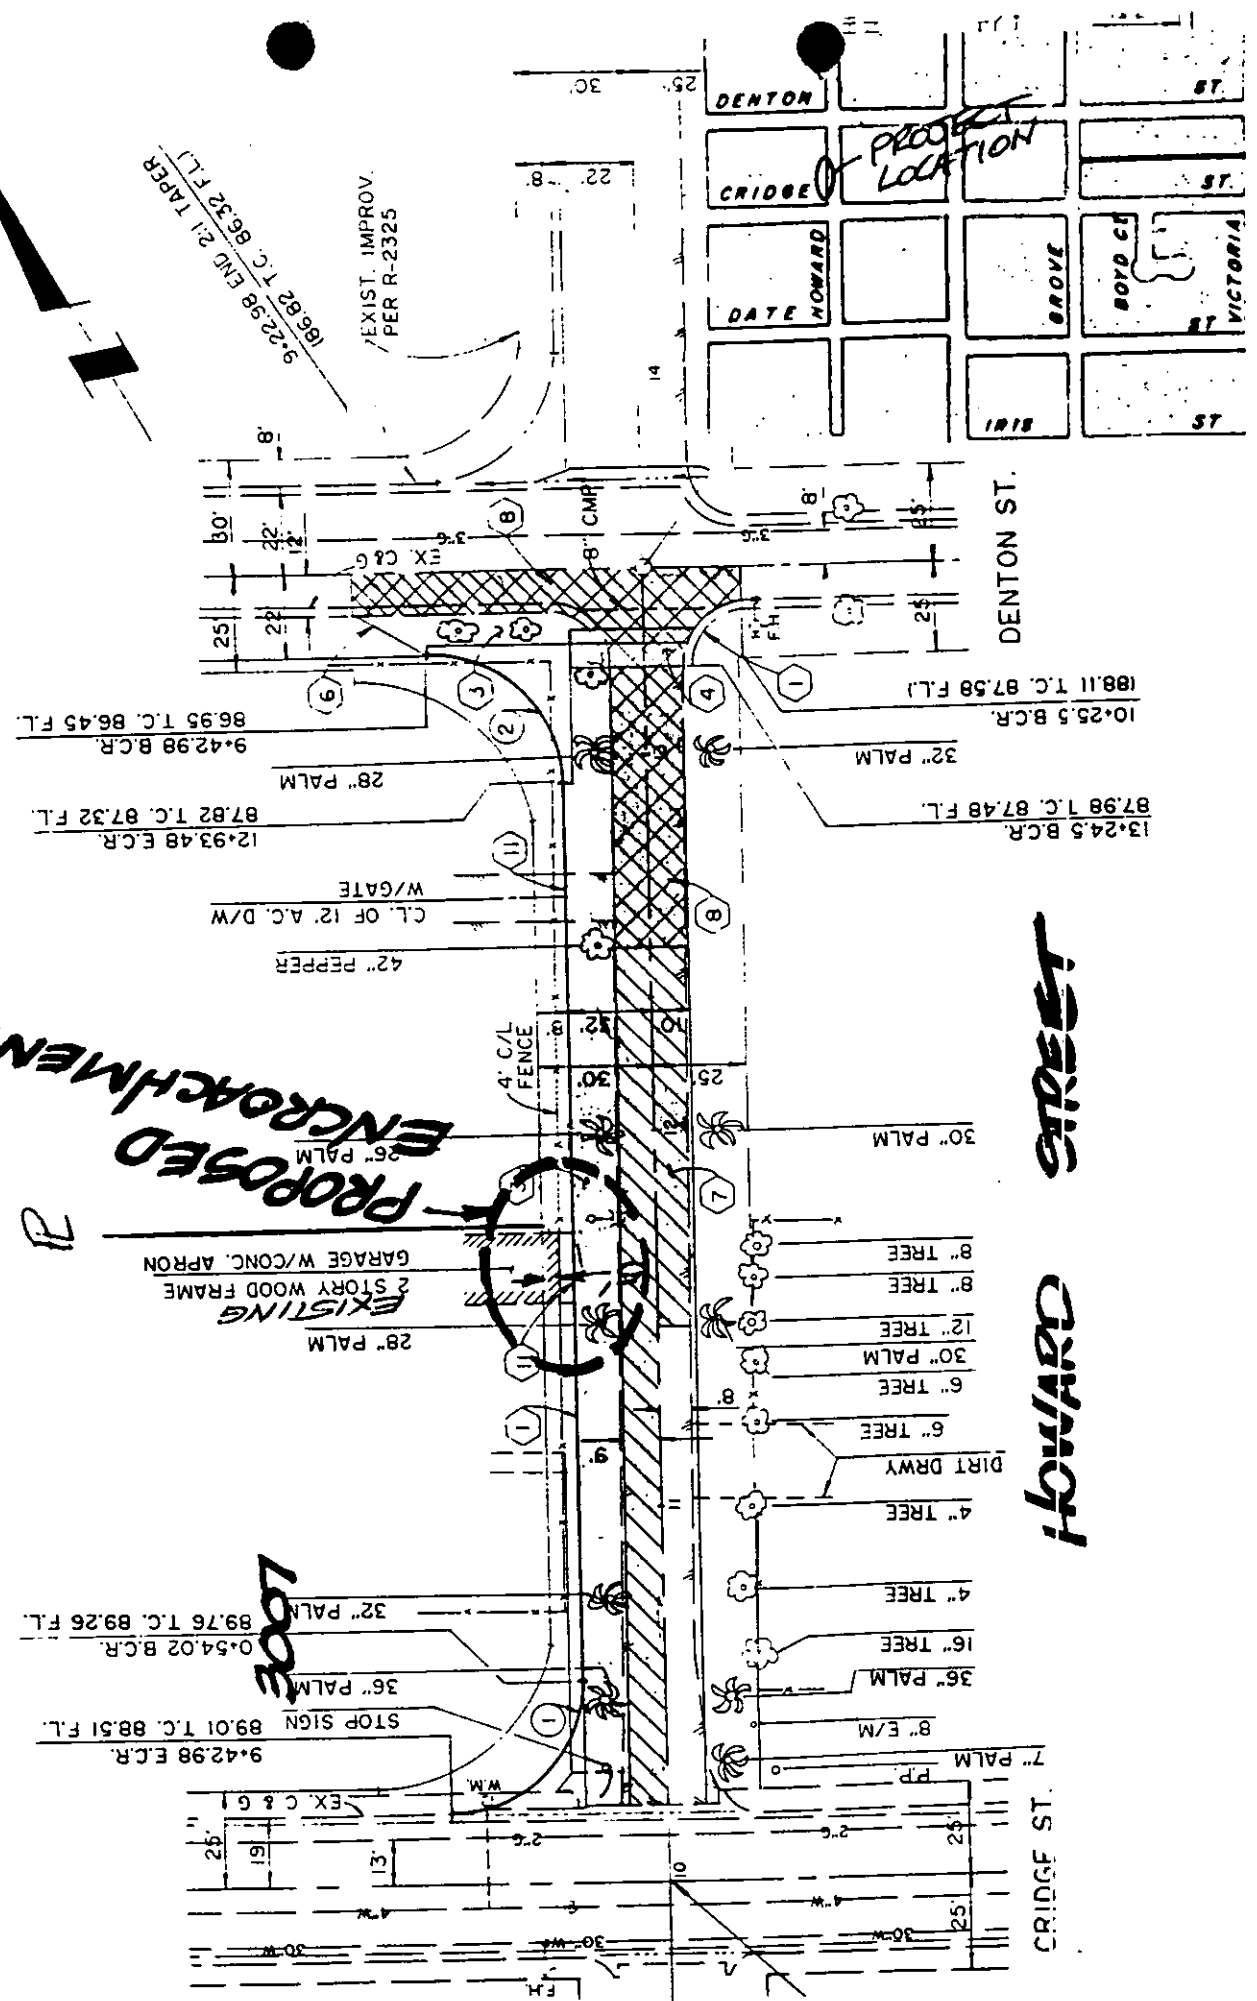


12+93.48 E.C.R. 87.82 T.C. 87.32 F.L.
9-42.98 B.C.R. 86.95 T.C. 86.45 F.L.
10+25.5 B.C.R. 188.11 T.C. 87.58 F.L.
13+24.5 B.C.R. 87.98 T.C. 87.48 F.L.

9-42.98 E.C.R. 89.01 T.C. 88.51 F.L.
STOP SIGN 89.01 T.C. 88.51 F.L.
36" PALM
0-54.02 B.C.R. 89.76 T.C. 89.26 F.L.
32" PALM

7" PALM P.P.
8" E/M
36" PALM
16" TREE
4" TREE
4" TREE
DIRT DRWY
6" TREE
6" TREE
30" PALM
12" TREE
8" TREE
8" TREE
30" PALM
4" C/L FENCE
42" PEPPER
CL. OF 12' A.C. D/W
W/GATE
12+93.48 E.C.R. 87.82 T.C. 87.32 F.L.
9-42.98 B.C.R. 86.95 T.C. 86.45 F.L.
10+25.5 B.C.R. 188.11 T.C. 87.58 F.L.
32" PALM
32" PALM
188.11 T.C. 87.58 F.L.
13+24.5 B.C.R. 87.98 T.C. 87.48 F.L.

9-22.98 E.C.R. 86.32 F.L.
188.92 T.C. 86.32 F.L.

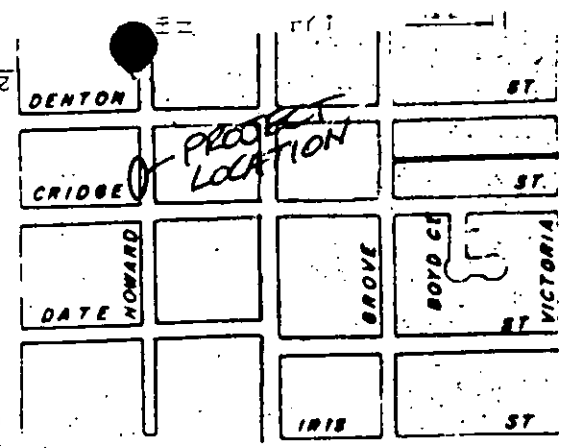

LESLIE GUYMON

