

ENCROACHMENT PERMIT

Pursuant to Resolution No. 11065 of the City of Riverside, permission is hereby granted to First Church of the Nazarene, a religious corporation, Third and Lime Streets, Riverside, California

their heirs and assigns, hereinafter referred to as "Permittee" to use and occupy the following described property.

Portions of the Third Street right of way adjacent to Lot 12, Resubdivision of Block 3, Range 3, as recorded in Map Book 4, Page 89, Riverside County Records, being 3310 Lime Street and 3366 Third Street.

in accordance with the terms hereof.

1. Permittee shall use and occupy the described property only in the manner and for the purposes as follows: **to maintain portions of the existing building encroaching into the Third Street Right of Way, as shown on Exhibit "A" attached hereto and made a part of this Encroachment Permit.**

2. Permittee, by acceptance of the benefits hereunder, acknowledges title to the property to be in the City of Riverside and waives any right to contest the validity of the dedication or grant.

3. Permittee acknowledges that the described property is the site of a proposed or planned public improvement and that, accordingly, all rights and privileges of use permitted shall cease and expire upon notice of revocation by the City. Upon the expiration or revocation, Permittee shall, within the time prescribed by the City, remove all improvements or obstructions placed, constructed or maintained by the Permittee. If the Permittee fails to abide by the removal order of the City within the time prescribed, the City shall have the right to remove and destroy the improvements without reimbursement to the Permittee and the cost of such removal shall be paid by the Permittee to the City of Riverside and shall constitute a debt owed to the City of Riverside.

4. Permittee, by acceptance hereof, waives the right of claim, loss, damage or action against the City of Riverside arising out of or resulting from revocation, termination, removal of the improvements or any action of the City of Riverside, its officers, agents or employees taken in accordance with the terms hereof.

5. Finding and determination by the City Council of the City of Riverside that the Permittee, or his heirs and assigns or successors in interest, are in default of the terms hereunder shall be cause for revocation.

6. Permittee herewith agrees to hold the City of Riverside harmless from and against all claims, demands, costs, losses, damages, injuries, action for damages and/or injuries, and liability growing or arising out of or in connection with the construction, encroachment, and/or maintenance to be done by Permittee or his agents, employees or contractors within the described property.

DATED: Oct. 13, 1970

CITY OF RIVERSIDE, a municipal corporation

By [Signature] Mayor

Attest Virginia J. Strohecker City Clerk

The foregoing is accepted by:

(Signature(s) of Permittee)
Paul W. Anderson (Pastor)
Mrs Art Henderson (Audrey) (Sec)

APPROVED AS TO CONTENT
[Signature]
Department Head

APPROVED AS TO FORM
John Woodhead
City Attorney

CITY MANAGER APPROVAL
[Signature]
City Manager

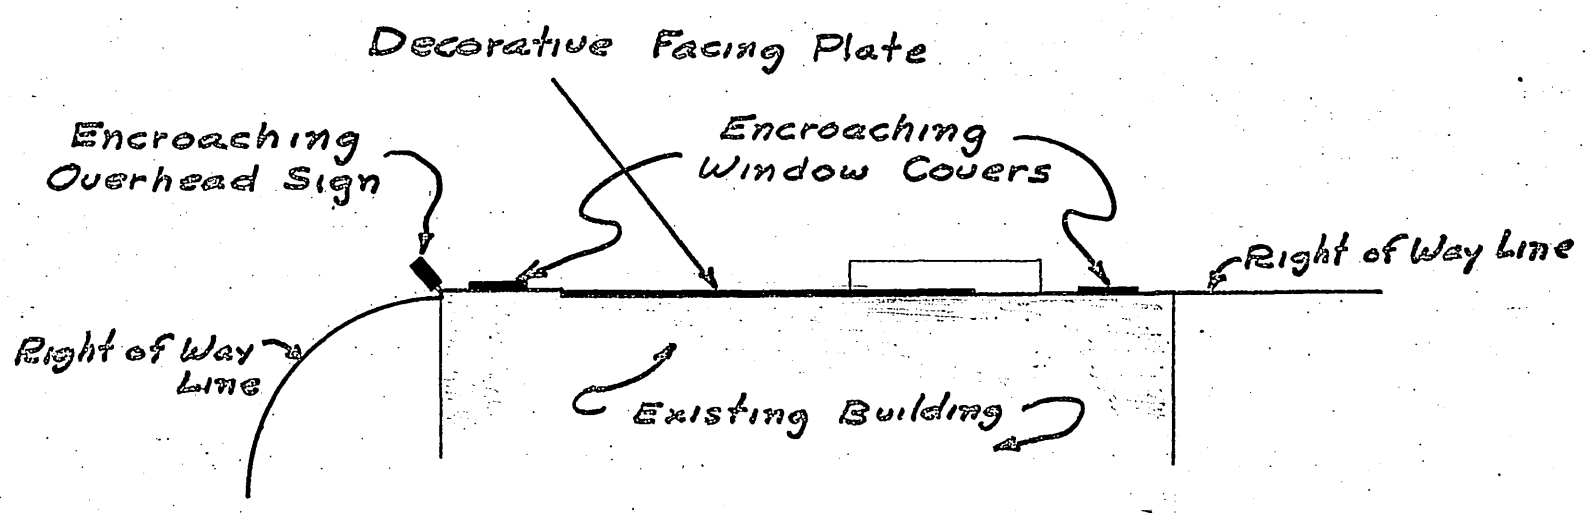
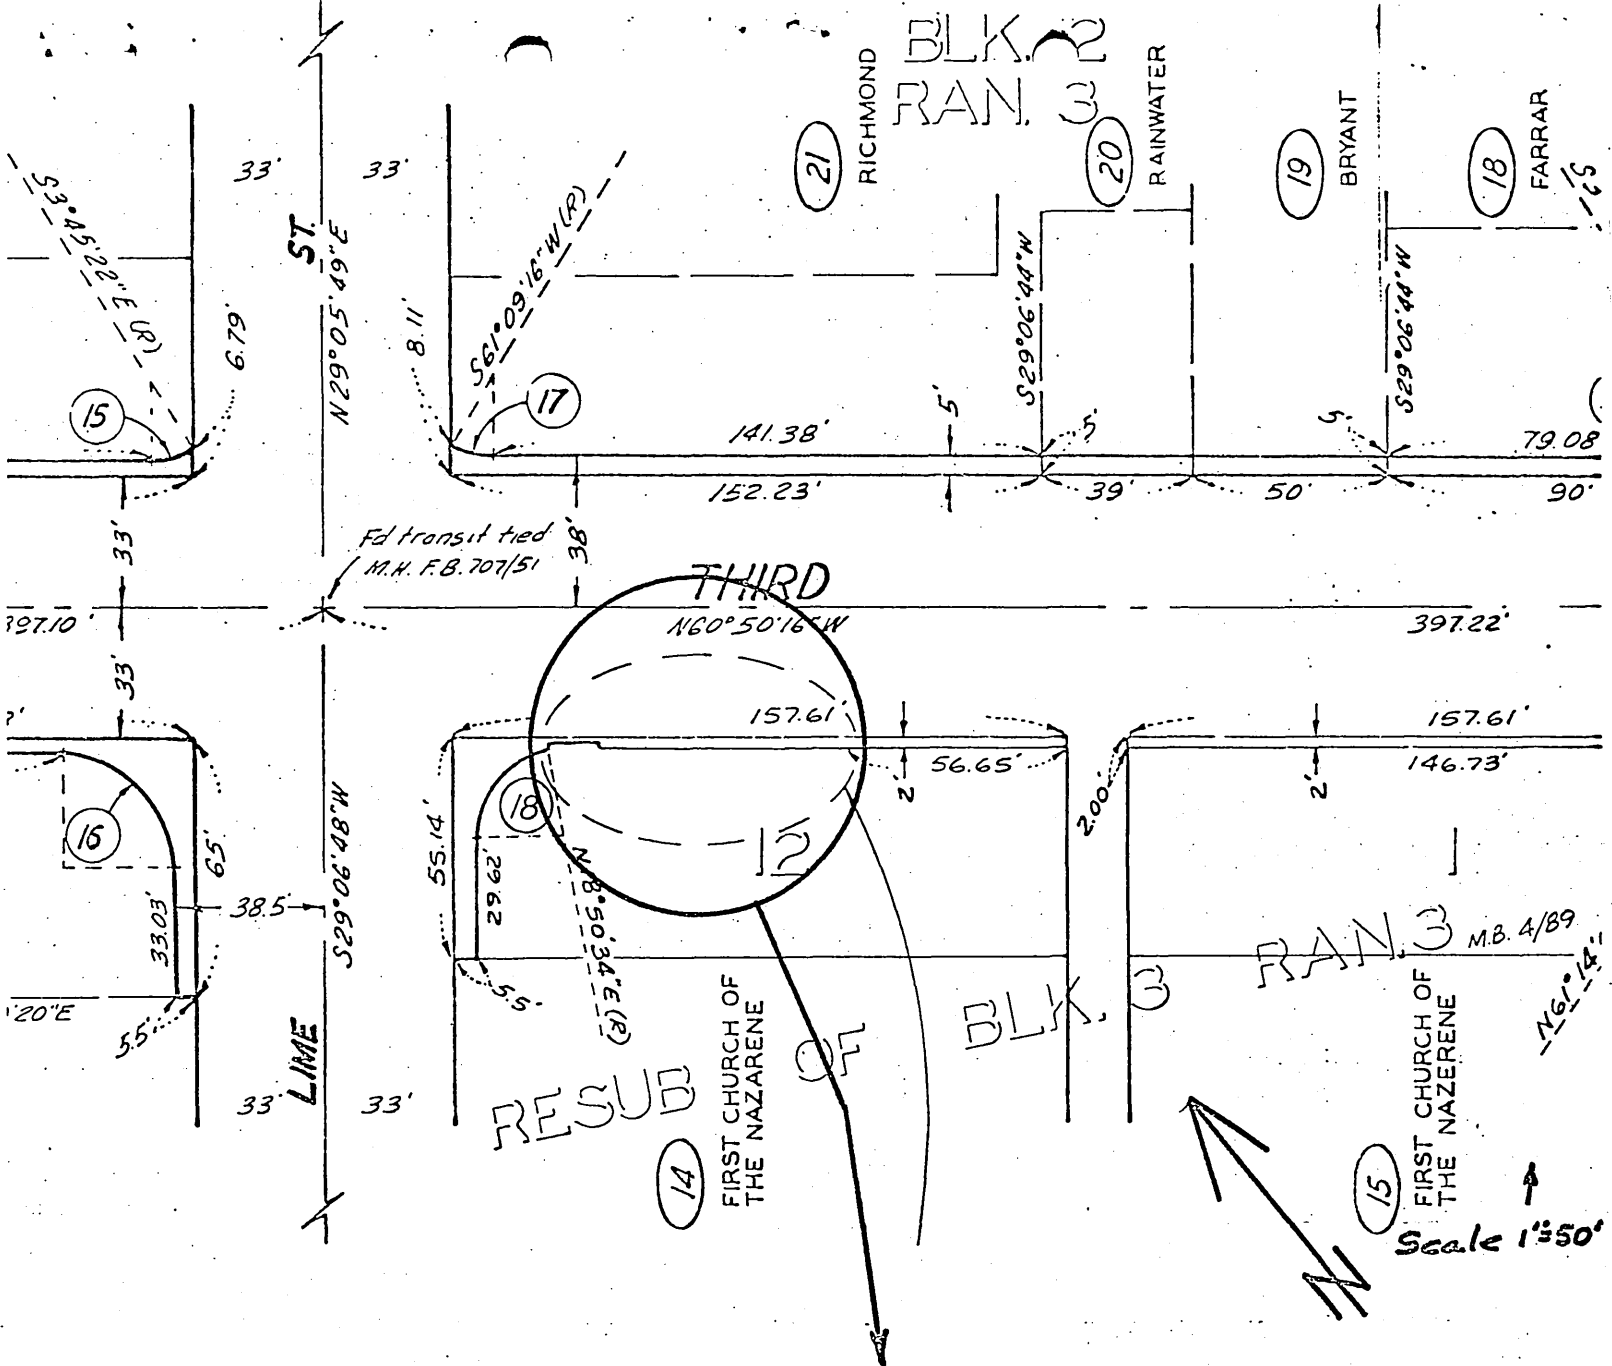


Exhibit "A"

September 11, 1970

Bruce Kopp, Planning Dept.

Fred Porphir, PUD, Electric Division

8281 Briarwood PUE Encroachment

The Public Utilities Department has no objection to the existing 2 1/2 foot encroachment on the 10' P.U.E. on the above property. The encroachment does not violate any state law applicable to this type of construction.

It is recommended that the encroachment be granted upon proper request from the property owner.

FGP:s1



cc: J. Johnson
H. Kamrath, PWD

RECEIVED
SEP 14 1970

DEPT. OF PUBLIC WORKS

Public Works Dept.			
	Initial	Info.	Action
Director			
Assistant			
Building			
Traffic			
Airport			
Off. Eng.			
Cap. Proj.			
1911 Act			
Plan Ch'g.			
Rt. of W.			
Inspection			
Survey			
Clerical			
File			