

ENCROACHMENT PERMIT

Pursuant to Resolution No. 11065 of the City of Riverside, permission is hereby granted to GIL E. RUIZ and SEFERINA G. RUIZ
6041 Alhambra Street
Riverside, CA 92505

their heirs and assigns, hereinafter referred to as "Permittee" to use and occupy the following described property. That portion of Alhambra Street, a public right of way adjacent to the westerly line of Parcel 2 of Parcel Map 10467, on file in Book 79 of Parcel Maps at Pages 8 and 9 thereof, records of Riverside County, California,

in accordance with the terms hereof.

1. Permittee shall use and occupy the described property only in the manner and for the purposes as follows: To construct and maintain a wrought iron fence, with brick pilasters, encroaching into said public right of way a maximum of 8.00 feet as shown by Exhibit "A" attached and made a part hereof by this reference.

2. Permittee, by acceptance of the benefits hereunder, acknowledges title to the property to be in the City of Riverside and waives any right to contest the validity of the dedication or grant.

3. Permittee acknowledges that the described property is the site of a proposed or planned public improvement and that, accordingly, all rights and privileges of use permitted shall cease and expire upon notice of revocation by the City. Upon the expiration or revocation, Permittee shall, within the time prescribed by the City, remove all improvements or obstructions placed, constructed or maintained by the Permittee. If the Permittee fails to abide by the removal order of the City within the time prescribed, the City shall have the right to remove and destroy the improvements without reimbursement to the Permittee and the cost of such removal shall be paid by the Permittee to the City of Riverside and shall constitute a debt owed to the City of Riverside.

4. Permittee, by acceptance hereof, waives the right of claim, loss, damage or action against the City of Riverside arising out of or resulting from revocation, termination, removal of the improvements or any action of the City of Riverside, its officers, agents or employees taken in accordance with the terms hereof.

5. Finding and determination by the City Council of the City of Riverside that the Permittee, or his heirs and assigns or successors in interest, are in default of the terms hereunder shall be cause for revocation.

6. Permittee herewith agrees to hold the City of Riverside harmless from and against all claims, demands, costs, losses, damages, injuries, action for damages and/or injuries, and liability growing or arising out of or in connection with the construction, encroachment, and/or maintenance to be done by Permittee or his agents, employees or contractors within the described property.

DATED: Oct 15, 1982

CITY OF RIVERSIDE, a municipal corporation

By [Signature] Mayor

Attest [Signature] City Clerk

The foregoing is accepted by:

[Signature] [Signature]
(Signature(s) of Permittee)

APPROVED AS TO CONTENT

[Signature]
Department Head


APPROVED AS TO FORM

[Signature]
City Attorney

CITY MANAGER APPROVAL

[Signature]
City Manager

EXHIBIT 'A'

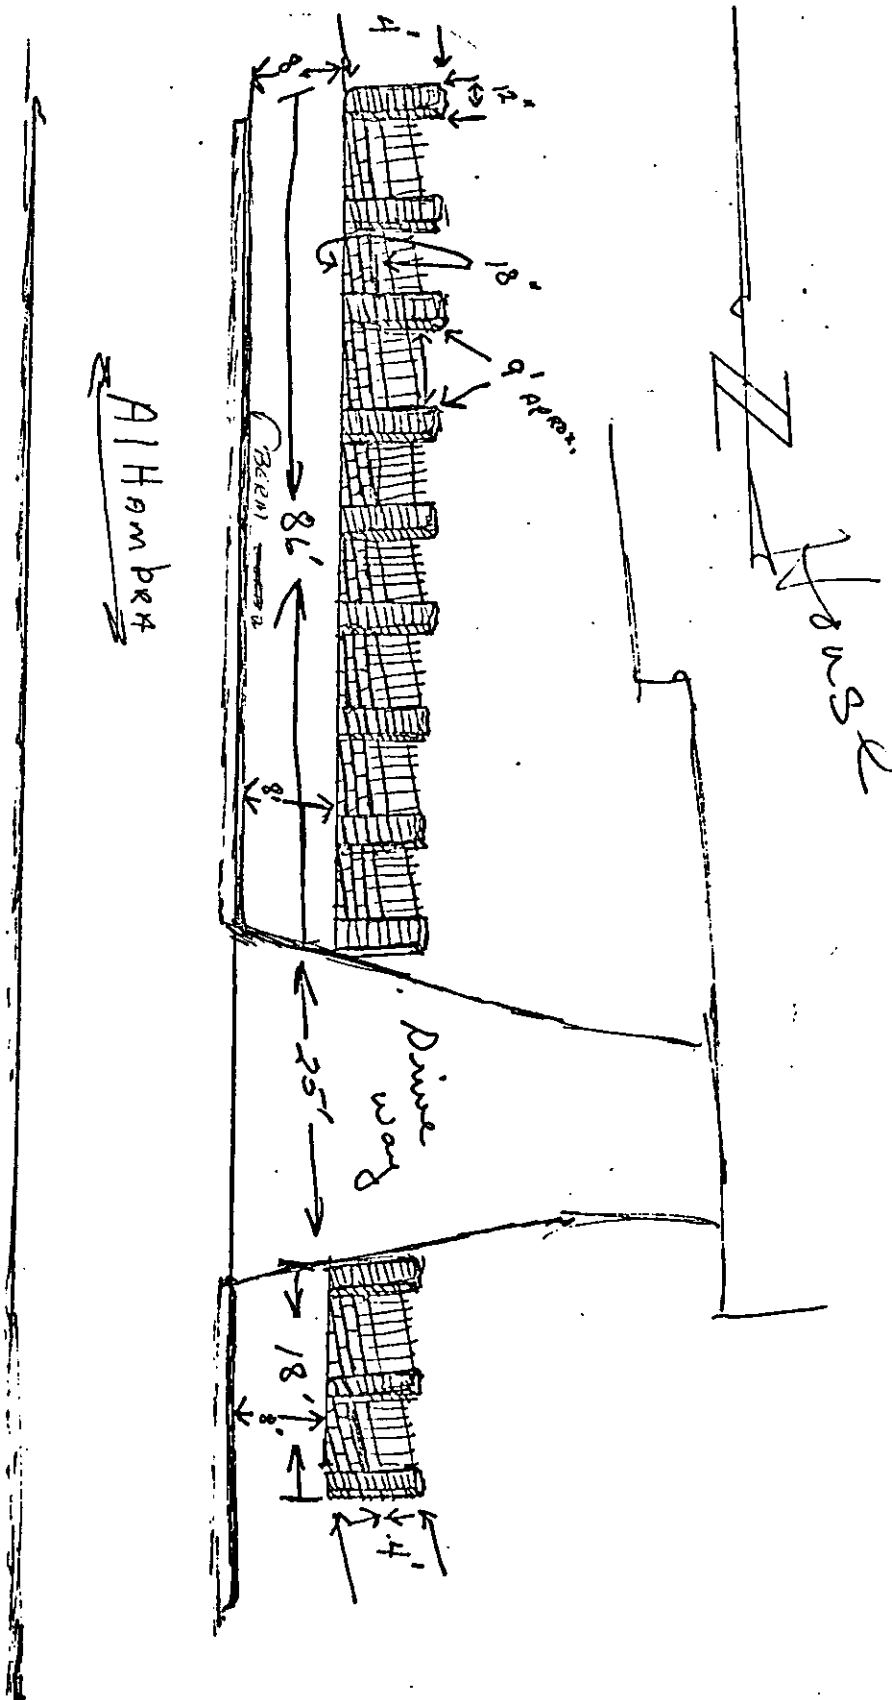


· CITY OF RIVERSIDE, CALIFORNIA ·

Parcel 2, PM 7918 RIV CO.	SHEET 1 OF 3	6/13-1
SCALE: 1" = 20'	DRAWN BY JFE DATE 9/24/10	SUBJECT: Encroachment Permit - 6041 ALHAMBRA AVE

E-845

EXHIBIT 'A'

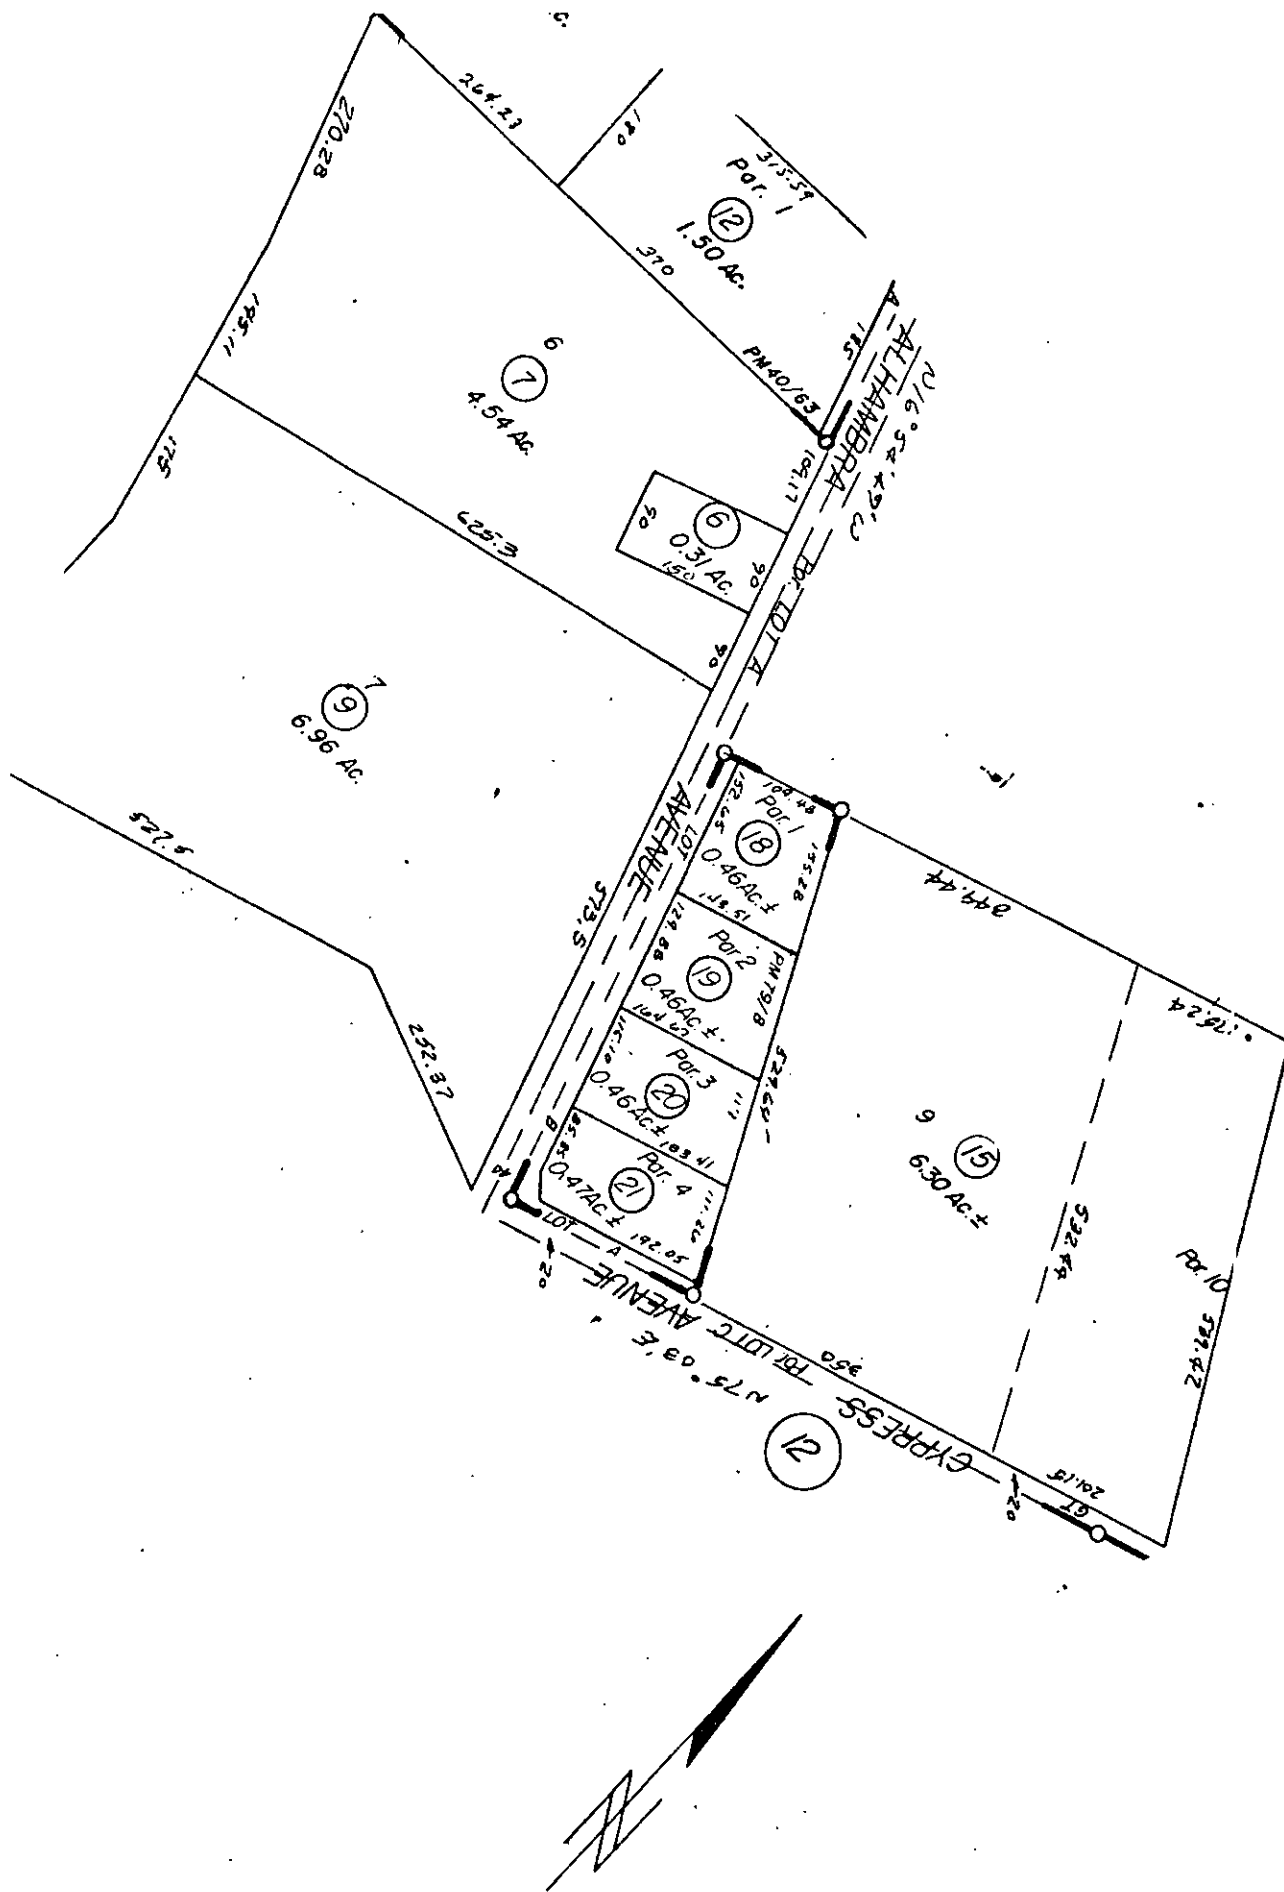

· CITY OF RIVERSIDE, CALIFORNIA ·

SHEET 2 OF 3


SCALE: 1" = _____

DRAWN BY _____ DATE ____/____/____

SUBJECT: Encroachment Permit -

E-845

EXHIBIT 'A'

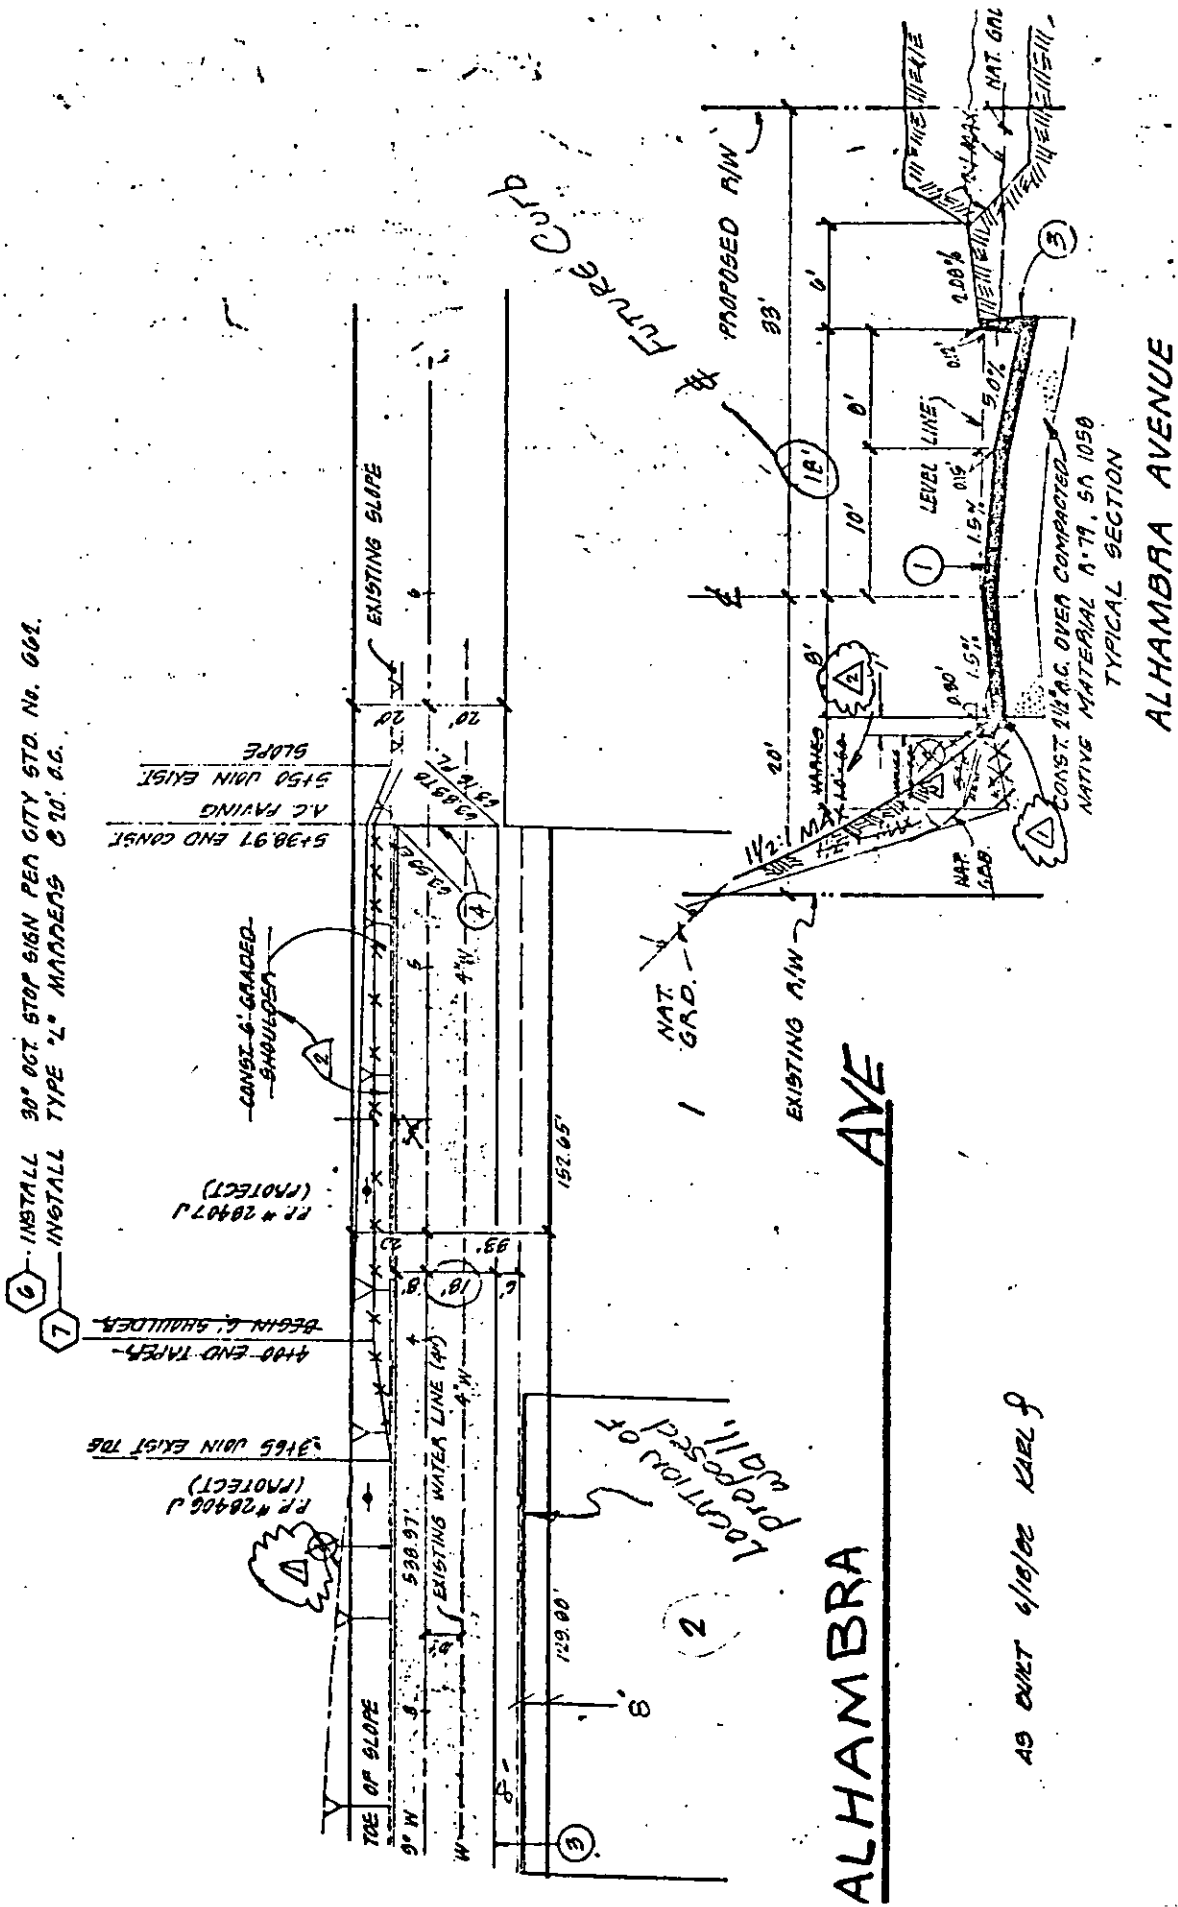

- 6 - INSTALL 30" OCT STOP SIGN PER CITY STD. NO. 662.
- 7 - INSTALL TYPE "L" MARKERS @ 20' OC.

3165 JOIN EXIST TRS
 R.P. #28406 J (PROTECT)
 4100 END TAPER -
 BEGIN L' SHOULDER
 R.P. #28407 J (PROTECT)
 CONST. 6" GRADED SHOULDER

AS EXIST 6/15/02 KARL J

CITY OF RIVERSIDE, CALIFORNIA

SHEET 3 OF 3

SCALE: 1" = 20'

DRAWN BY _____ DATE ____/____/____

SUBJECT: Encroachment Permit

E-845