
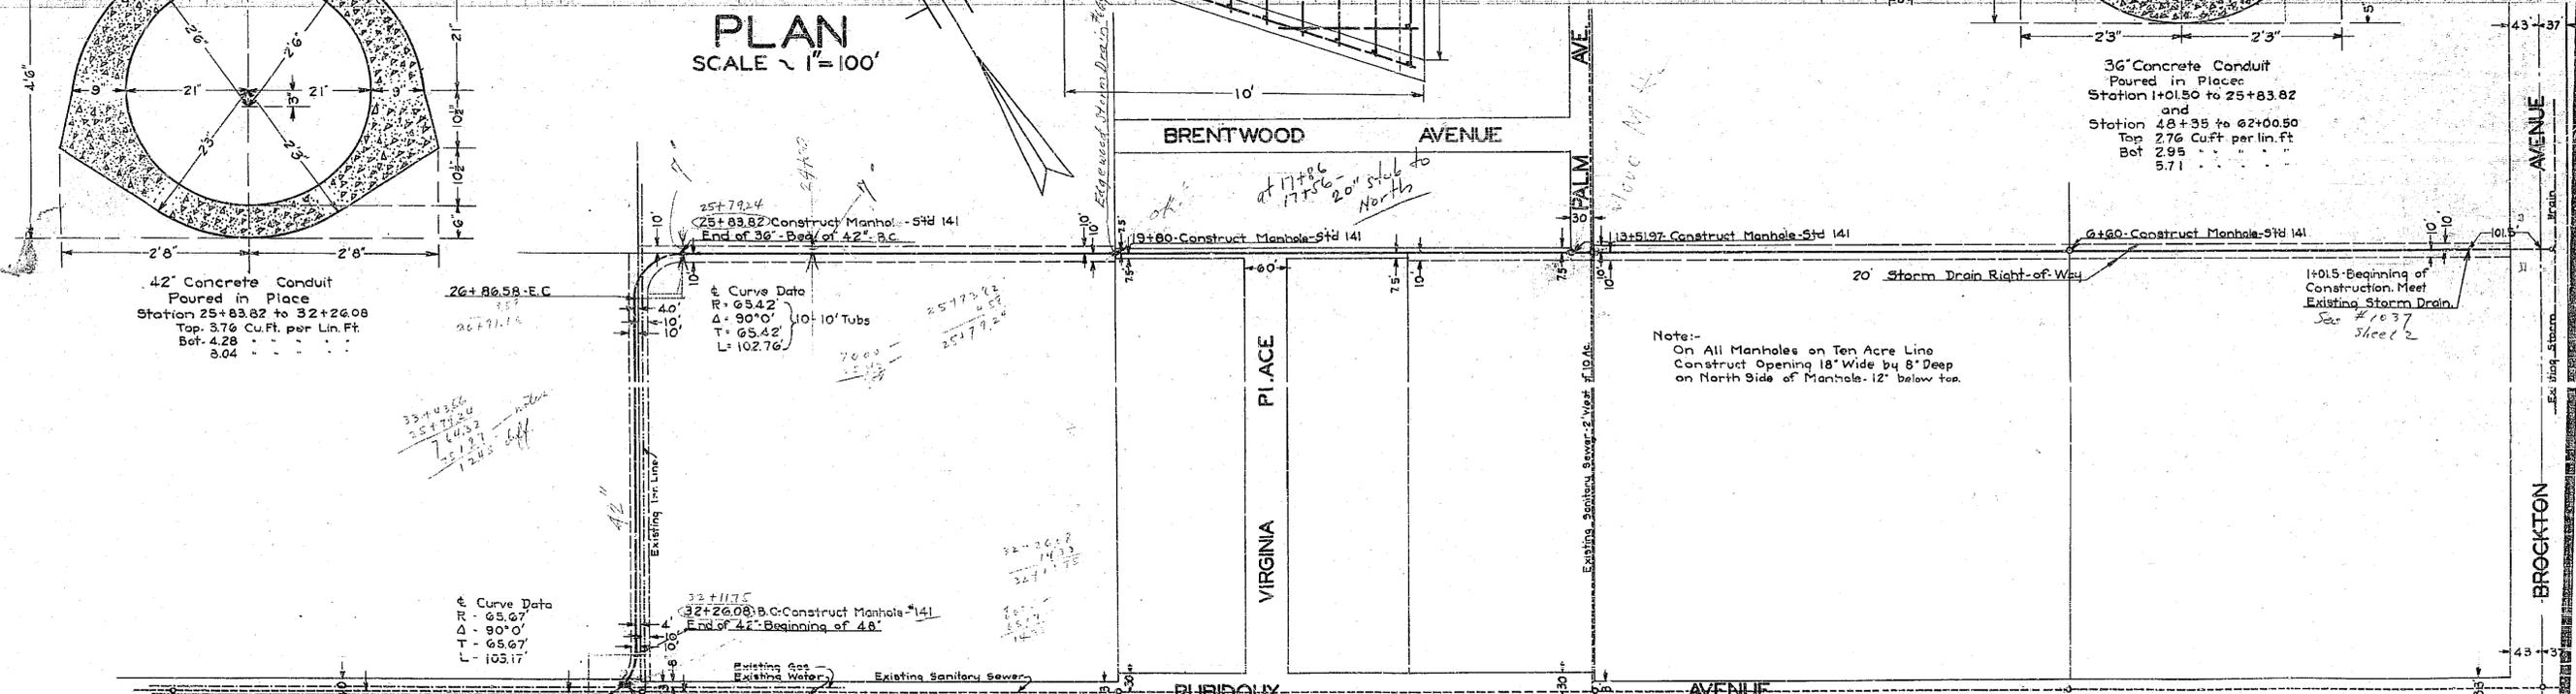


Rubidoux Avenue Storm Drain			
Drawing Number	Sheet Number	Total Sheets	Field Books
1031	1	2	355-364
Drawn	Checked	Approved	
Arthur N. Riedel June 23, 1938			

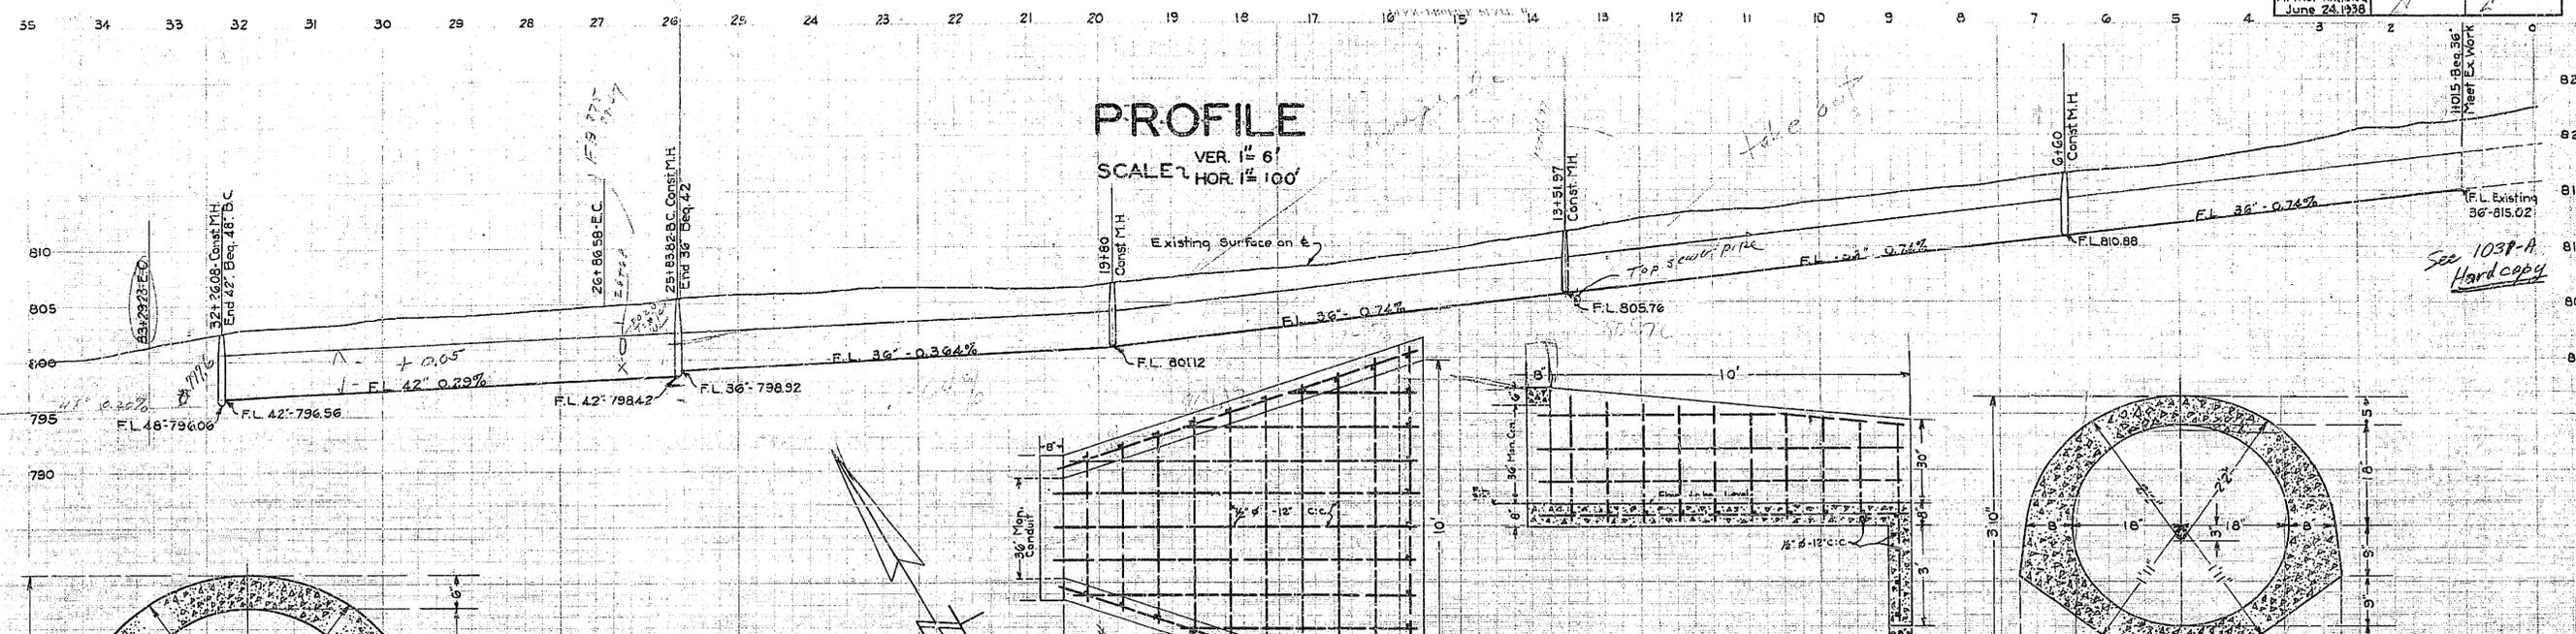

Note:-  
 On All Manholes on Ten Acre Line  
 Construct Opening 18" Wide by 8" Deep  
 on North Side of Manhole - 12" below top.

1031

1001

