


GENERAL NOTES

- IT SHALL BE THE RESPONSIBILITY OF THE CONTRACTOR TO CLEAR THE RIGHT OF WAY IN ACCORDANCE WITH THE PROVISIONS OF LAW AS IT AFFECTS EACH UTILITY INCLUDING IRRIGATION LINES AND APPURTENANCES AND AT NO COST TO THE CITY.
- CONSTRUCTION SHALL BE IN ACCORDANCE WITH THE CITY OF RIVERSIDE DEPARTMENT OF PUBLIC WORKS, STANDARD DRAWINGS, AND THE STANDARD SPECIFICATIONS FOR PUBLIC WORKS CONSTRUCTION, 1982 EDITION.
- LOCATION OF LATERALS TO BE DETERMINED IN THE FIELD AT THE DIRECTION OF THE OWNER. AVOID CONFLICT WITH PROPOSED AND/OR EXISTING FACILITIES.
- CONTRACTOR IS TO VERIFY EXISTING SEWER ELEVATION PRIOR TO CONSTRUCTION.
- NO FINISHED FLOOR ELEVATION SHALL BE LESS THAN 4' ABOVE THE SEWER FLOW LINES AT POINT OF CONNECTION WITHOUT HAVING A PROPER BACKWATER VALVE INSTALLED IN THE LATERAL.
- QUANTITIES SHOWN ARE FOR INFORMATION ONLY AND THE CITY OF RIVERSIDE IS NOT RESPONSIBLE FOR THEIR ACCURACY.
- THE SEWER CONTRACTOR SHALL ADJUST MANHOLES TO FINAL GRADE AFTER PAVING IS COMPLETED.
- A PLUG SHALL BE INSTALLED AND WILL REMAIN IN PLACE WHERE THE NEW SEWER CONNECTS WITH THE EXISTING SEWER UNTIL THE NEW SEWER IS ACCEPTED BY THE CITY.
- THE PRIVATE ENGINEER SIGNING THESE PLANS IS RESPONSIBLE FOR ASSURING THE ACCURACY AND ACCEPTABILITY OF THE WORK HEREON. IN THE EVENT OF DISCREPANCIES ARISING DURING CONSTRUCTION, THE PRIVATE ENGINEER SHALL BE RESPONSIBLE FOR DETERMINING AN ACCEPTABLE SOLUTION AND REVISING THE PLANS FOR APPROVAL BY THE CITY.
- THE CONTRACTOR SHALL CALL IN A LOCATION REQUEST TO UNDERGROUND SERVICE ALERT (USA), PHONE NO. 1-800-422-4133, TWO WORKING DAYS BEFORE DIGGING. NO CONSTRUCTION PERMIT WILL BE ISSUED BY THE PUBLIC WORKS DEPARTMENT INVOLVING EXCAVATION FOR UNDERGROUND FACILITIES UNLESS THE APPLICANT HAS BEEN PROVIDED AN INQUIRY IDENTIFICATION NUMBER BY U.S.A.
- THE PRIVATE ENGINEER PREPARING THESE PLANS SHALL BE RESPONSIBLE FOR PRESERVING OR RE-ESTABLISHING AND REFERENCING SURVEY MONUMENTS DESTROYED, DISTURBED OR BURIED AS A RESULT OF CONSTRUCTION SHOWN HEREON.

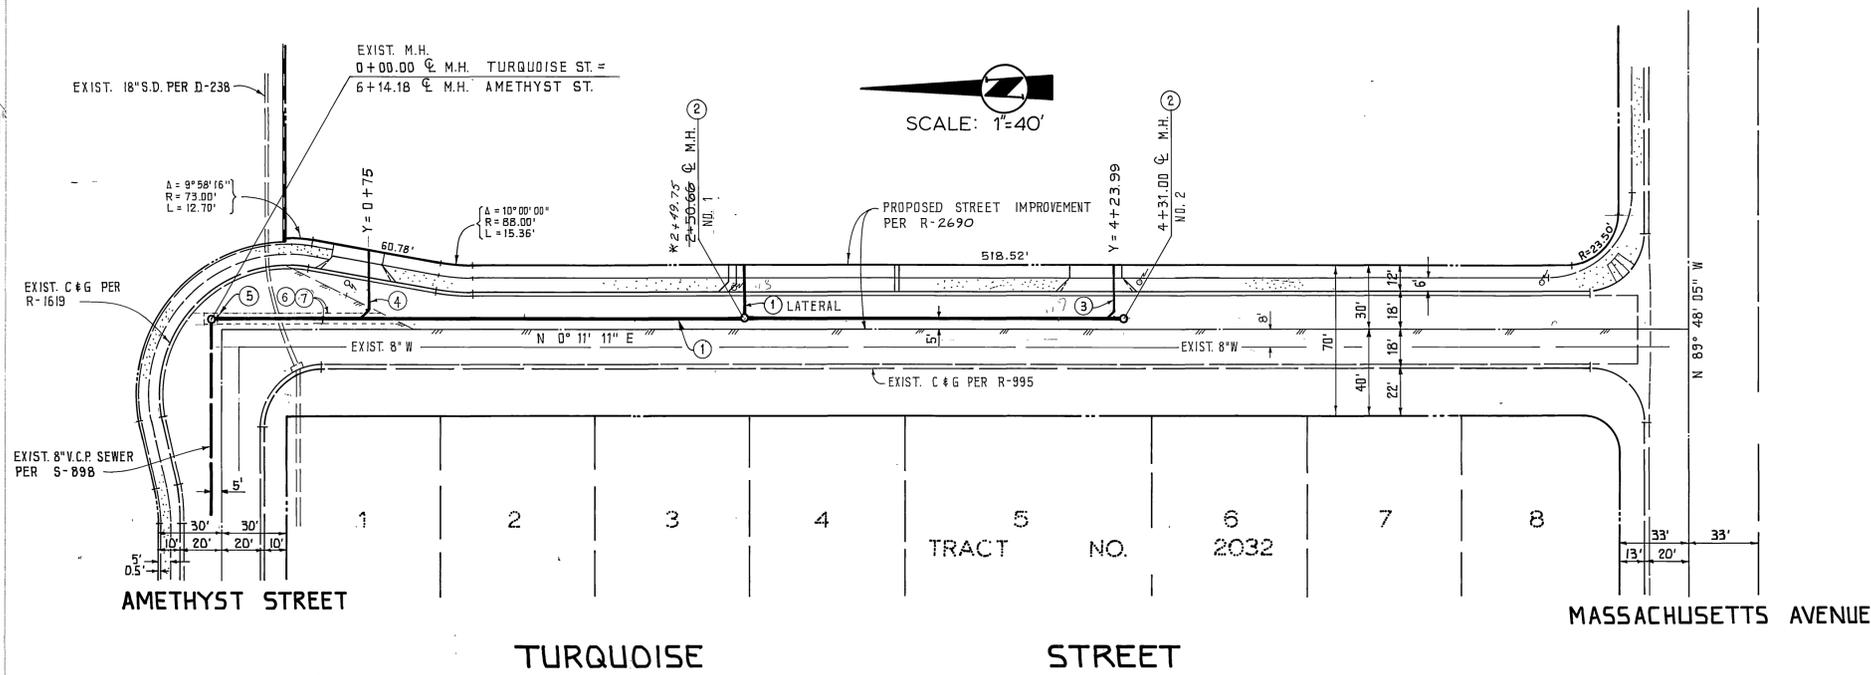

CONSTRUCTION NOTES & QUANTITIES

1	CONST. 8" V.C.P. SEWER	446 L.F.
2	CONST. MANHOLE PER CITY STD. 500	2 EA.
3	CONST. 6" V.C.P. SEWER LATERAL PER CITY STD. 562	25 L.F.
4	CONST. 4" V.C.P. SEWER LATERAL PER CITY STD. 562	33 L.F.
5	CONNECT TO EXIST. 8" STUB	1 EA.
6	SAWCUT AND REMOVE EXIST. PAVEMENT	270 S.F.
7	CONST. 3" A.C. ON 4" A.B.	270 S.F.

CITY OF RIVERSIDE
WATER SYSTEM
De La Rosa
APPROVED DATE 4-1-85

BENCH MARK
17'-E P.K. NAIL AND TAG IN CONCRETE
BASE OF STREET LIGHT ON NORTHEAST
CORNER OF CHICAGO AVENUE AND
SPRUCE STREET F.B. 847/7
ELEV. = 910.371

BOYER ENGINEERING CO.
2950 AIRWAY AVE. SUITE B-2
COSTA MESA, CA. 92626
(714) 966-0808
Delbert D. Boyer
DELBERT D. BOYER 13542
R.C.E.

REVISIONS
DESIGNED BY REP DRAWN BY PS CHECKED BY REP

PUBLIC WORKS DEPARTMENT
APPROVED BY DATE BY APPROVED BY
PRINCIPAL ENGINEER DATE 4-1-85 BY William D. Gardner
TRAFFIC DIVISION PUBLIC WORKS DIRECTOR
CHIEF V. ENGINEER DATE APRIL 23, 1985

As built 9-20-85
SEWER PLAN AND PROFILE
TURQUOISE STREET
FROM AMETHYST STREET
TO 431' SOUTH
PRD-16-834
INDEX W/P
S-1387
1 1