
## GENERAL NOTES.

- 1. IT SHALL BE THE RESPONSIBILITY OF THE CONTRACTOR TO CLEAR THE RIGHT OF WAY IN ACCORDANCE WITH THE PROVISIONS OF LAW AS IT AFFECTS EACH UTILITY INCLUDING IRRIGATION LINES AND APPURTENANCES AND AT NO COST TO THE CITY.
- 2. CONSTRUCTION SHALL BE IN ACCORDANCE WITH THE CITY OF RIVERSIDE DEPARTMENT OF PUBLIC WORKS, STANDARD DRAWINGS, STANDARD DRAWING N°. 10 AND STANDARD SPECIFICATIONS FOR PUBLIC WORKS CONSTRUCTION, CURRENT EDITION.
- 3. THE PRIVATE ENGINEER SIGNING THESE PLANS IS RESPONSIBLE FOR ASSURING THE ACCURACY AND ACCEPTABILITY OF THE WORK HEREON. IN THE EVENT OF DISCREPANCIES ARISISING DURING CONSTRUCTION. THE PRIVATE ENGINEER SHALL BE RESPONSIBLE FOR DETERMINING AN ACCEPTABLE SOLUTION AND REVISING THE PLANS FOR APPROVAL BY THE CITY.
- 4. QUANTITIES SHOWN ARE FOR INFORMATION ONLY AND THE CITY OF RIVERSIDE IS NOT RESPONSIBLE FOR THEIR ACCURACY.
- 5. THE DEVELOPER SHALL BE RESPONSIBLE FOR PRESERVING OR RE-ESTABLISHING AND REFERENCING SURVEY MONUMENTS DESTROYED. DISTURBED OR BURIED AS A RESULT OF CONSTRUCTION SHOWN HEREON.
- 6. ALL FLAGGED ELEVATIONS SHALL BE STAKED IN THE FIELD BY THE PRIVATE ENGINEER.
- 7. ANY TRAFFIC CONTROL STRIPING OBLITERATED AND / OR BADLY WORN DURING CONSTRUCTION SHALL BE RESTORED BY THE CONTRACTOR WITHIN FIVE DAYS AFTER NOTIFICATION FROM CITY INSPECTORS.
- 8. THE CONTRACTOR SHALL CALL IN LOCATION REQUEST TO UNDERGROUND SERVICE ALERT (USA) PHONE: 1-800-422-4133, TWO WORKING DAYS BEFORE DIGGING. NO CONSTRUCTION PERMIT WILL BE ISSUED BY THE PUBLIC WORKS DEPARTMENT INVOLVING EXCAVATION FOR UNDERGROUND FACILITIES UNLESS THE APPLICANT HAS BEEN PROVIDED AN INQUIRY IDENTIFICATION NUMBER BY
- 9. CONTRACTOR IS TO VERIFY EXISTING SEWER ELEVATIONS PRIOR TO CONSTRUCTION.
- 10. LOCATION OF LATERALS TO BE DETERMINED IN THE FIELD AT THE DIRECTION OF THE OWNER. AVOID CONFLICT WITH PROPOSED AND / OR EXISTING FACILITIES.
- 11. NO FINISHED FLOOR ELEVATION SHALL BE LESS THAN 4' ABOVE THE SEWER FLOW LINE AT POINT OF CONNECTION WITHOUT HAVING A PROPER BACKWATER VALVE INSTALLED IN THE LATERAL.
- 12. A PLUG SHALL BE INSTALLED AND WILL REMAIN IN PLACE WHERE THE NEW SEWER CONNECTS WITH THE EXISTING SEWER UNTIL THE NEW SEWER IS ACCEPTED BY THE CITY.
- 13. THE SEWER CONTRACTOR SHALL ADJUST MANHOLES TO FINAL GRADE AFTER PAVING IS
- 14. TRIM EDGE OF EXISTING PAVEMENT WHERE NEW PAVEMENT JOINS TO A SMOOTH, STRAIGHT LINE. CONSTRUCT MATCH-UP PAVING AS SHOWN ON PLAN AND OVERLAY PAVING AS DIRECTED IN THE FIELD TO PRODUCE A SMOOTH SECTION.
- 15. ON ALL AREAS WITHIN PUBLIC RIGHT OF WAY WHERE THE FILL IS ONE (1) FOOT GREATER, A LETTER WILL BE REQUIRED FROM THE SOILS ENGINEER, CERTIFYING THE COMPACTION OF THE FILL BELOW SUBGRADE, PRIOR TO ISSUANCE OF THE CONSTRUCTION PERMIT/CUT SHEETS.
- 16. IN PAVEMENT OVERLAY AREAS, DISTRESSED EXISTING PAVEMENT SHALL BE REMOVED AND REPLACED AS DIRECTED BY THE INSPECTOR PRIOR TO OVERLAYING WITH A. C. PAVING.

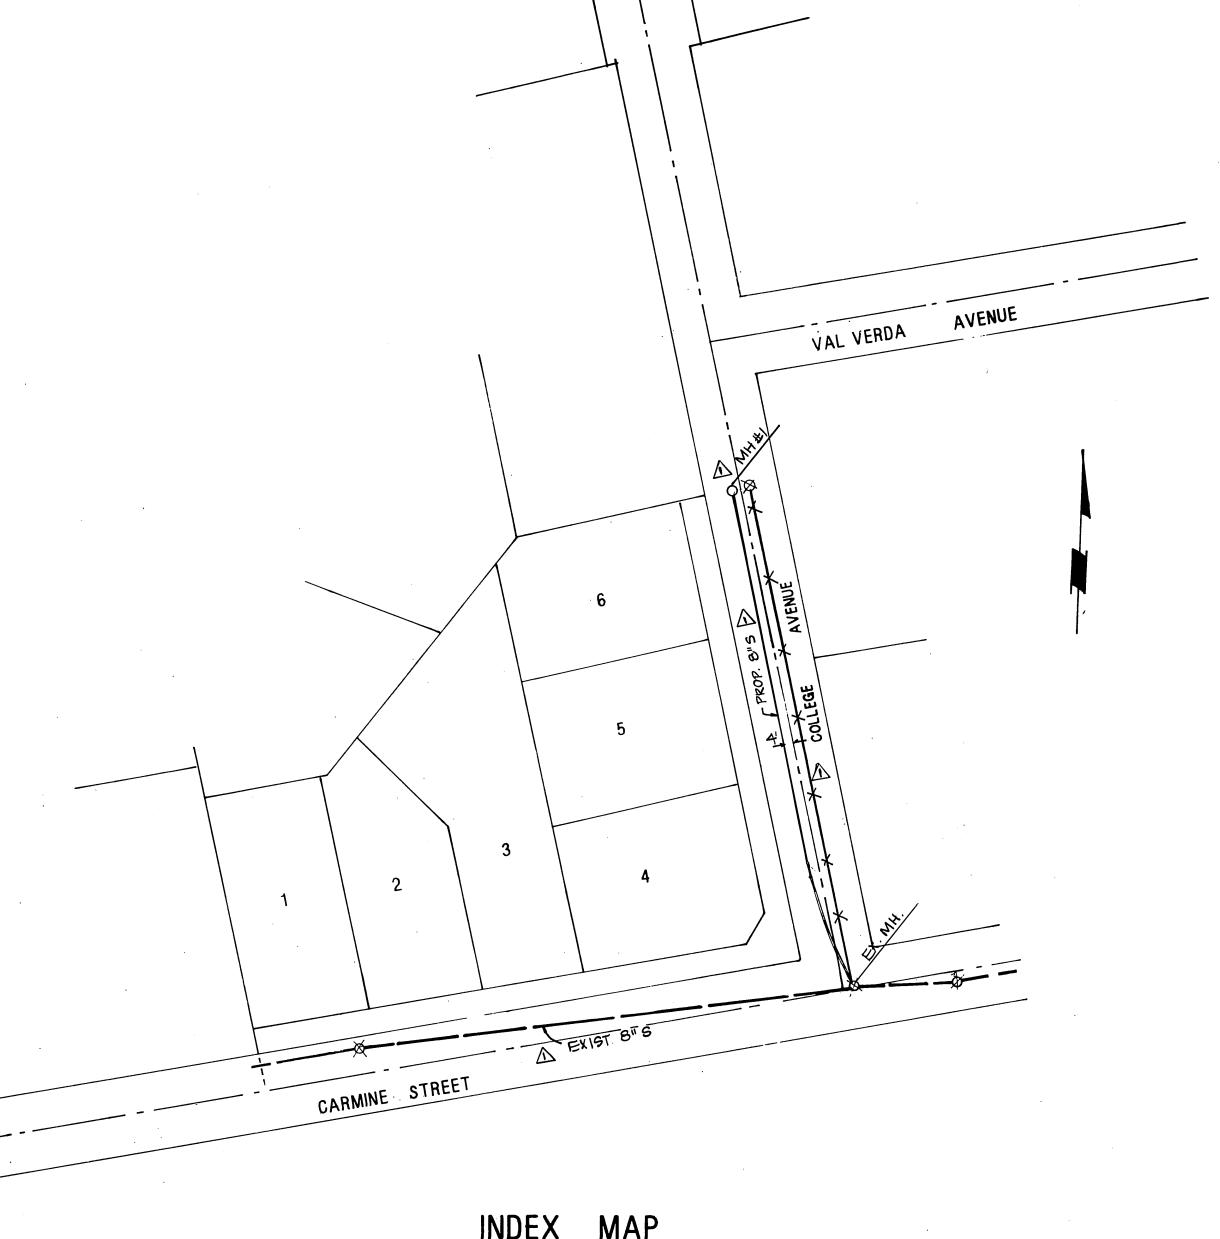

INDEX MAP

SCALE : 1" = 50'

CONSTRUCTION NOTES & QUANTITY ESTIMATE

VICINITY MAP (N.T.S)

CONSTRUCT 8" V.C.P. CONST. M.H. PER CITY STD. 500 3) CONST. SEWER LATERAL PER CITY STD. 562 4 RECONTOUR THE M.H BATTOM.

EXIST. WATER METER TO BE RELOCATED BY CITY FORCES.

ENCASE SEWER PER C.W.D.-022

REVISION APPROVED BY:

27**6** L.F.

1 EA.

5 EA. 1 EA.

CITY BUSINESS TAX NO. 29004. EXP DATE AUG 13, 1991.

THO WORKING DAYS BEFORE YOU DIG GAS COMPANY

CENCOM CABLE TV. DATE : 5-13-50 DATE : 8/22/90

CITY OF RIVERSIDE CITY OF RIVERSIDE ELECT. DEPT WATER DEPT.

DATE: 2 - 1 - 91 1 5 8 5 - 6-94

**BENCH** MARK F2.B F.D. CONC. MON. WITH CAPPED INTERSECTION OF SIERRA VISTA AVE. & NORWOOD AVE. EL. 786.734

F.C.ELAHL ASSOCIATES INC 7250 MAGNOLIA AVENUE RIVERSIDE, CA 92504 TEL: (714) 785 - 1100 FAX: (714) 785 - 1197

DESIGNED BY M.Z. DRAWN BY J.Y.C CHECKED BY F.C.E.

PUBLIC WORKS DEPARTMENT

SEWER PLAN

COLLEGE AVE. NORTH OF CARMINE STREET SHEET \_\_\_\_\_ HORIZ. SCALE : AS SHOWN VERT. SCALE : AS SHOWN

AS BUILT 5/16/96 RUM ACCOUNT No. 5-1599

INDEXED 4-21-93 4H

