


GENERAL NOTES:

- 1). CONSTRUCTION SHALL BE IN ACCORDANCE WITH THE CITY OF RIVERSIDE STANDARD DRAWINGS AND STANDARD SPECIFICATIONS FOR PUBLIC WORKS CONSTRUCTION, 2009 EDITION.
- 2). EXISTING UTILITIES SHOWN ON THIS PLAN ARE PLOTTED FROM PUBLIC RECORDS. THE CONTRACTOR IS REQUIRED TO TAKE DUE PRECAUTIONARY MEASURES TO LOCATE AND PROTECT ALL UTILITIES WHETHER OR NOT SHOWN ON THIS PLAN.
- 3). PRIME CONTRACTOR BIDDING THIS WORK SHALL HAVE A CLASS "A" OR A "C-42" LICENSE.

RIVERSIDE CALIFORNIA

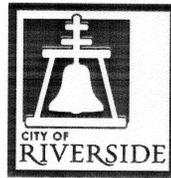


PUBLIC WORKS DEPARTMENT SEWER MANHOLE REHABILITATION AT THE SOUTHWEST CORNER OF JURUPA AVE AND VAN BUREN BLVD

CONSTRUCTION NOTES:


NUMBERS ABOVE 100 IN A HEXAGON ON THE PLAN REFER TO THE RESPECTIVE STANDARD DRAWING AND SHALL BE CONSTRUCTED ACCORDINGLY. UNLESS MODIFICATIONS ARE NOTED ON THE PLAN OR COVER SHEET. ANY NUMBER SHOWN BELOW THE STANDARD DRAWING NUMBER INDICATES THE SPECIFIC ALTERNATE TO BE CONSTRUCTED.

FULL MANHOLE REHABILITATION. CONTRACTOR SHALL REMOVE ALL EXISTING LINER FROM WITHIN RECTANGULAR (9'L X 8'W) SEWER MANHOLE AND APPLY "CURED IN PLACE MANHOLE (CIPM)" LINER ABOVE THE CHANNEL SPRING LINE, MANHOLE SHELF, MANHOLE WALLS, GRADE RINGS AND THE ROOF OF THE MANHOLE STRUCTURE. NOTE: DISTANCE FROM MANHOLE RIM TO INVERT 42 INCH SEWER MAIN IS 10 FEET +/-.

CONTRACTOR SHALL FURNISH AND INSTALL NEW 36" FRAME AND COVER (ALHAMBRA FOUNDRY: A1251-6 OR CITY APPROVED EQUAL).

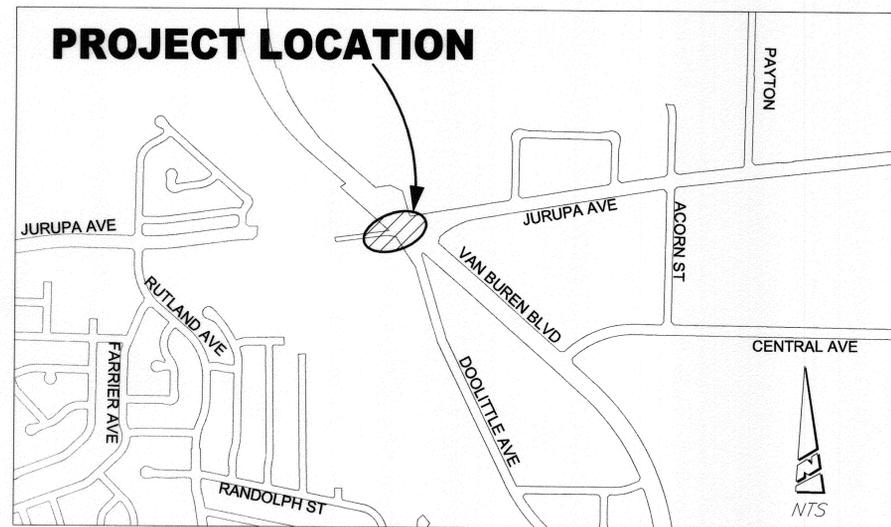

VICINITY MAP

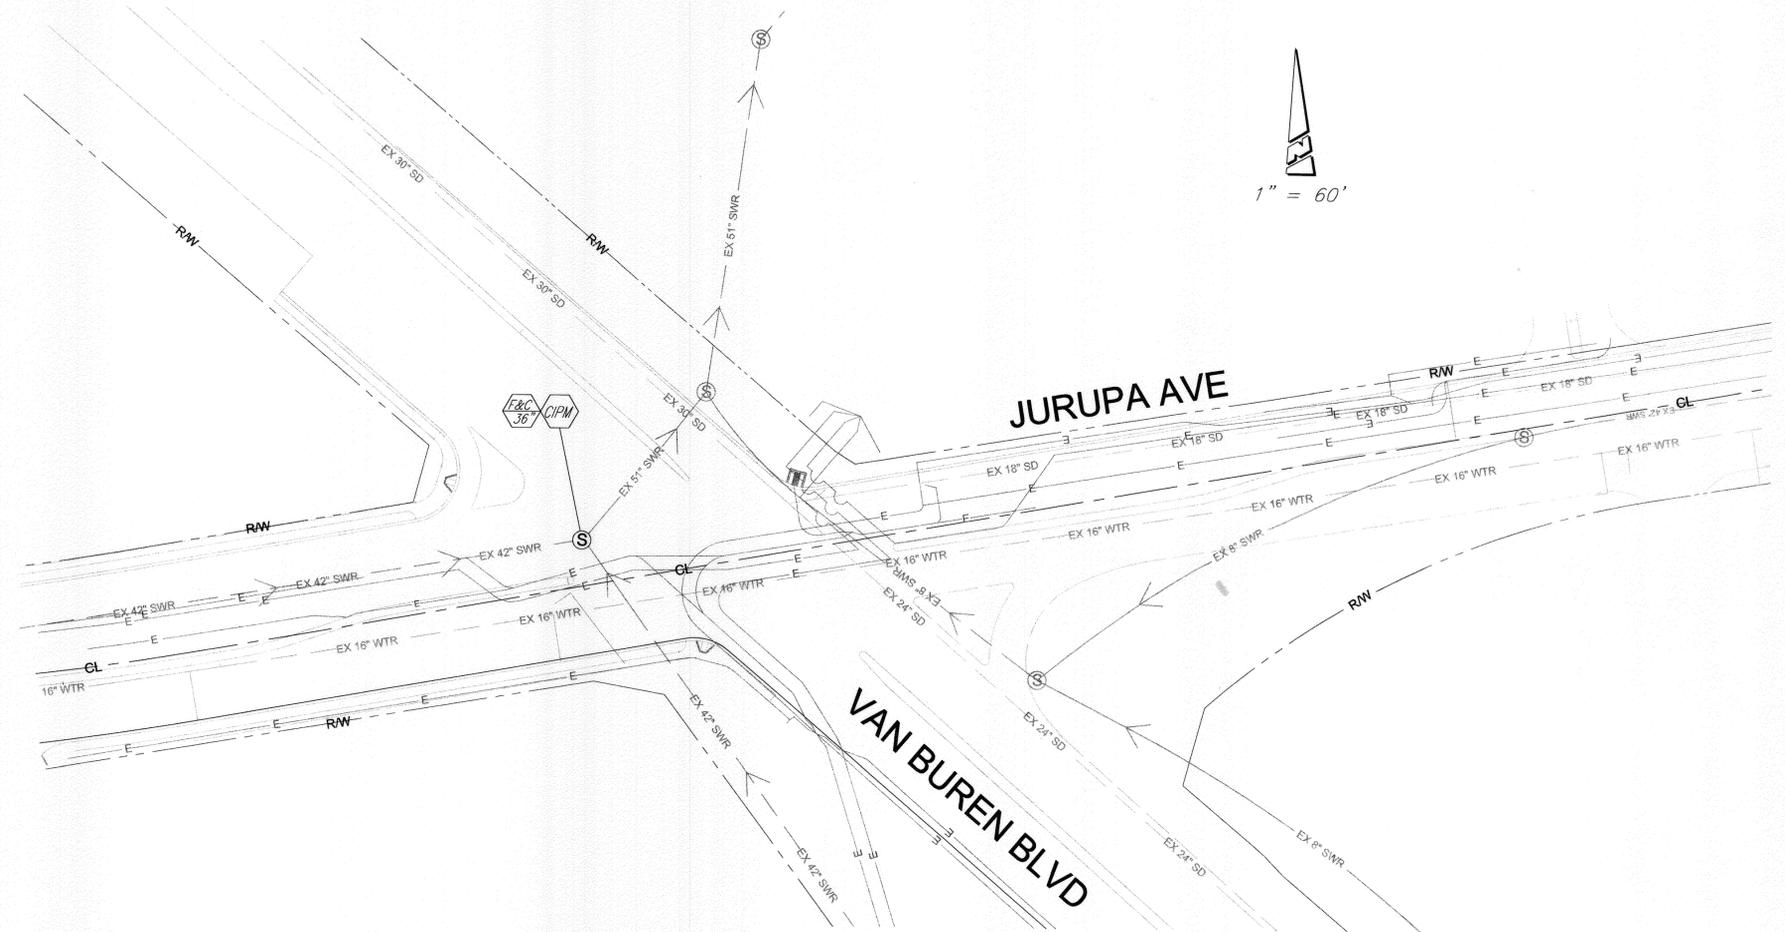

CONSTRUCTION LEGEND:

- ⊙ EXISTING SEWER MANHOLE.
- < DIRECTION OF FLOW
- STREET CENTERLINE
- - - STREET R/W

EXISTING UNDERGROUND UTILITIES:

- SANITARY SEWER ——— EX SWR
- WATER LINE ——— EX WTR
- STORM DRAIN ——— EX SD
- UNDERGROUND ELECTRIC ——— E



ENGINEER IN RESPONSIBLE CHARGE
LONNIE LY YOUNG
R.C.E. No. 43216 EXPIRES: 3-31-2014
DATE 03/01/2012



MARK	REVISIONS	APPR.	DATE

CITY OF RIVERSIDE, CALIFORNIA DEPARTMENT OF PUBLIC WORKS			
APPROVED BY	BY	DATE	APPROVED BY
PRINCIPAL ENGINEER	LA	3/1/12	[Signature]
ENGINEERING MANAGER	PM	3/1/12	CITY ENGINEER
CONSTRUCTION ADMIN.	DC	3/1/12	DATE 3/1/2012
TRAFFIC DIVISION			

SEWER MANHOLE REHABILITATION	
SEWER MANHOLE REHABILITATION AT THE SOUTHWEST CORNER OF JURUPA AVE AND VAN BUREN BLVD.	
TITLE SHEET	
HORIZ. SCALE: 1" = 60'	VERT. SCALE: N/A

ACCT. NO. 986082303 440301
S-2102
SHEET 1 OF 1
FILE NAME: S-2102-1

Indexed 6-12-12 BM

AS-BUILT
05/14/2012