

**ESTIMATE OF QUANTITIES**

ITEM	QUANTITY
8" V.C.P.	1804 Inft.
Manhole (Std.)	10
Wye 8"x4"	33
Point Replacement	5289 sq.ft.
5'x5' Catch Basin	27250 sq.ft.

- NOTE:**
- Contractor to install 4" wyes shown thus:
  - Exact location of wyes to be determined in the field.
  - All manholes to be Riverside City Std. No. 500 with a maximum step spacing of 12"
  - All construction shall be in accordance with Standards and Specifications No. 461 of the City of Riverside, Department of Public Works.
  - It shall be the responsibility of the contractor to clear the right of way in accordance with provisions of the law as it affects each utility, including irrigation lines and appurtenances, and at no extra cost to the City of Riverside.
  - Rim elevation to match existing paving.
  - All stubs to be plugged and capped.

**BENCH MARK**  
Spike in gully pole No. 5588, S.W. corner intersection  
Dix Sparrows Rd. & Mt. Vernon Ave.  
Elev. 1130.46

**REVISIONS**

NO.	DESCRIPTION
1	11/16/63. Revised sewer alignment 2' SW by lot M1123 and M1145 & 5' (to line with M1123) 9/27/63

ACCOUNT NO. 05-3060-5031

**J. F. DAVIDSON-CIVIL ENGINEER**  
R.E. NO. 862  
RIVERSIDE, CALIFORNIA

APPROVED BY *George E. Martin* DATE 12/21/62

**CITY OF RIVERSIDE, CALIFORNIA**  
DEPARTMENT OF PUBLIC WORKS

**TRACT 2213 SEWER EXTENSION**

**BROADBENT DRIVE**



HORIZ. SCALE: 1" = 40'      VERT. SCALE: 1" = 4'

DESIGNED BY: *J.F. Davidson*  
CHECKED BY: *R.W. Smith*  
DRAWN BY: *R.W. Smith*  
RECOMMENDED BY: *A. J. ...*  
ASSISTANT CITY ENGINEER

DATE: 3-18-63

**S-386**

1 2

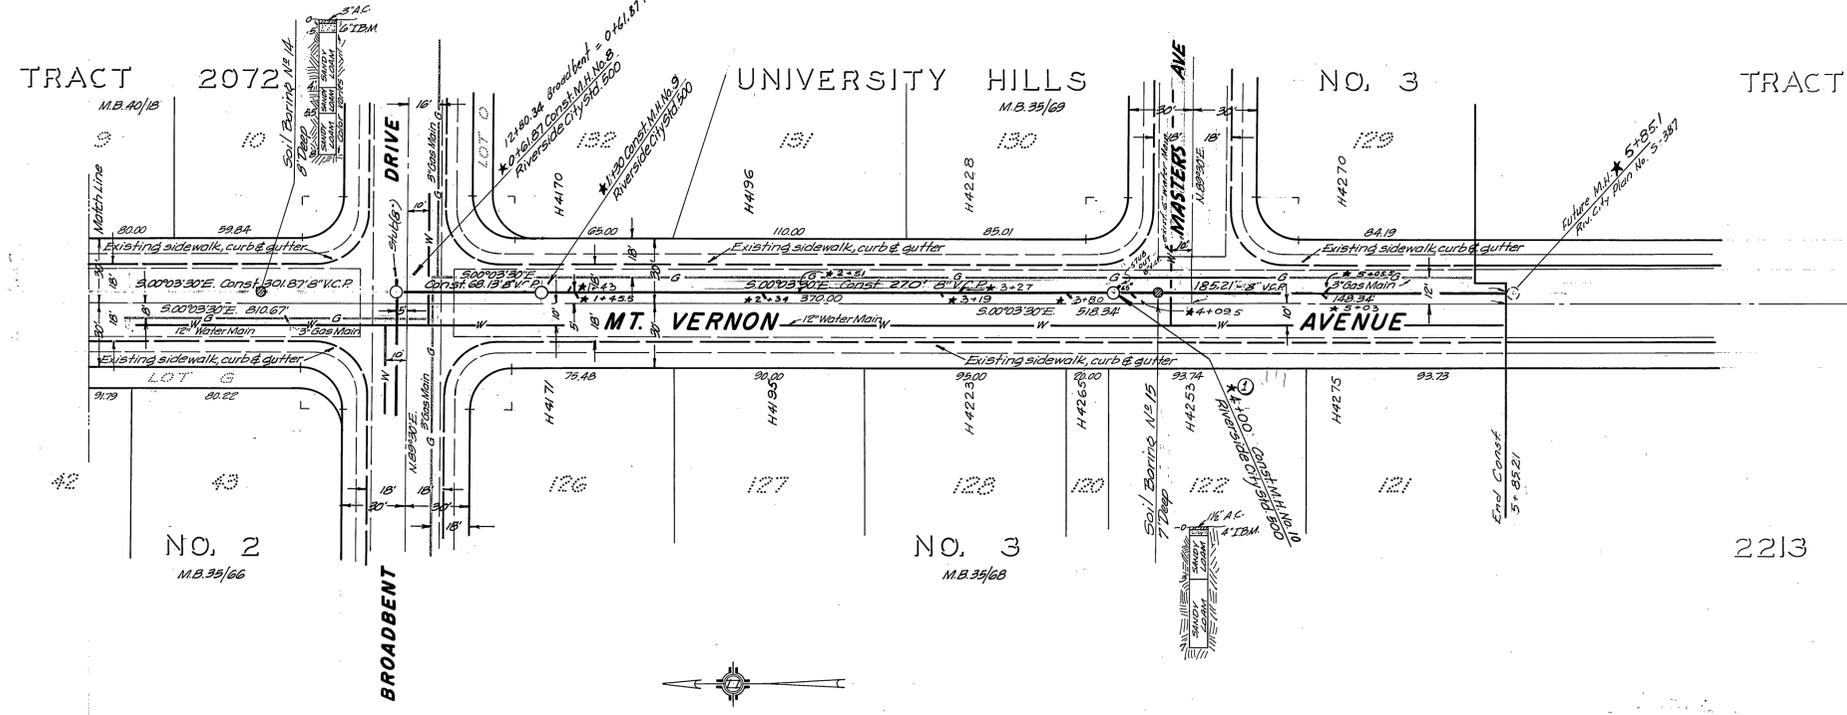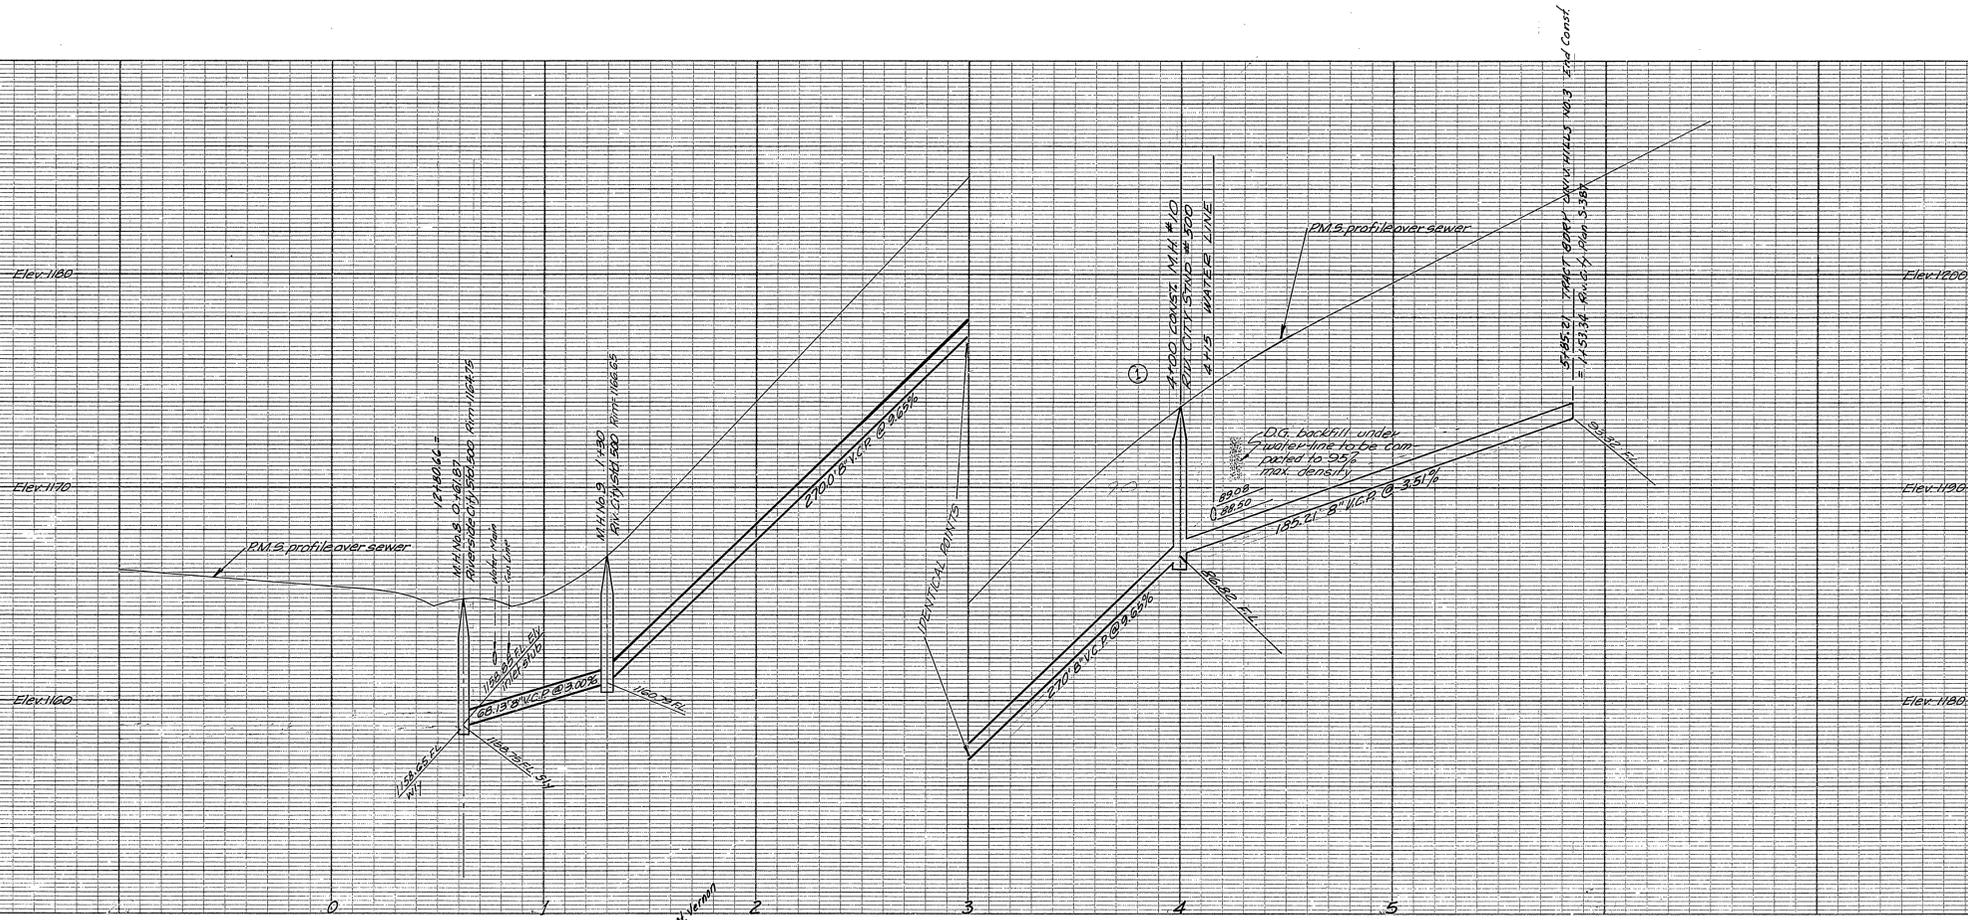

SEE SHEET 1

**BENCH MARK**  
Spike in survey pole No. 5588 @ W. cor. intersection  
BIG SPRINGS ROAD and MT. VERNON AVENUE  
Elev. 1190.46

★ AS BUILT 2.18.64, G.S.

MARK	DATE	DESCRIPTION
①	12-20-63	Revise Location M.H. 1210 & Grade 4100 to 4185.5'

ACCOUNT NO. 05-3060-5031
J. F. DAVIDSON-CIVIL ENGINEER R.E. NO. 962 RIVERSIDE, CALIFORNIA
APPROVED BY <i>George E. McCarty</i> DATE 12/21/63 Director of Public Works
CITY OF RIVERSIDE, CALIFORNIA DEPARTMENT OF PUBLIC WORKS
<b>TRACT 2213 SEWER EXTENSION</b>
<b>MT. VERNON AVENUE</b>
HORIZ. SCALE 1"=40' VERT. SCALE 1"=4'
DESIGNED BY
DRAWN BY
CHECKED BY <i>RIC</i>
APPROVED BY <i>J. F. Davidson</i> DATE 3-19-63 Assistant City Engineer
<b>S-386</b>
2 2