


B.M. EL. 1217.89 PK. NAIL IN  
 CENTER OF S.W. CORNER  
 AT QUAIL RD & BROADBENT DR.  
 FB. 5-10 14/21  
 SCALE VERT. 1"=4'  
 HORIZ. 1"=40'

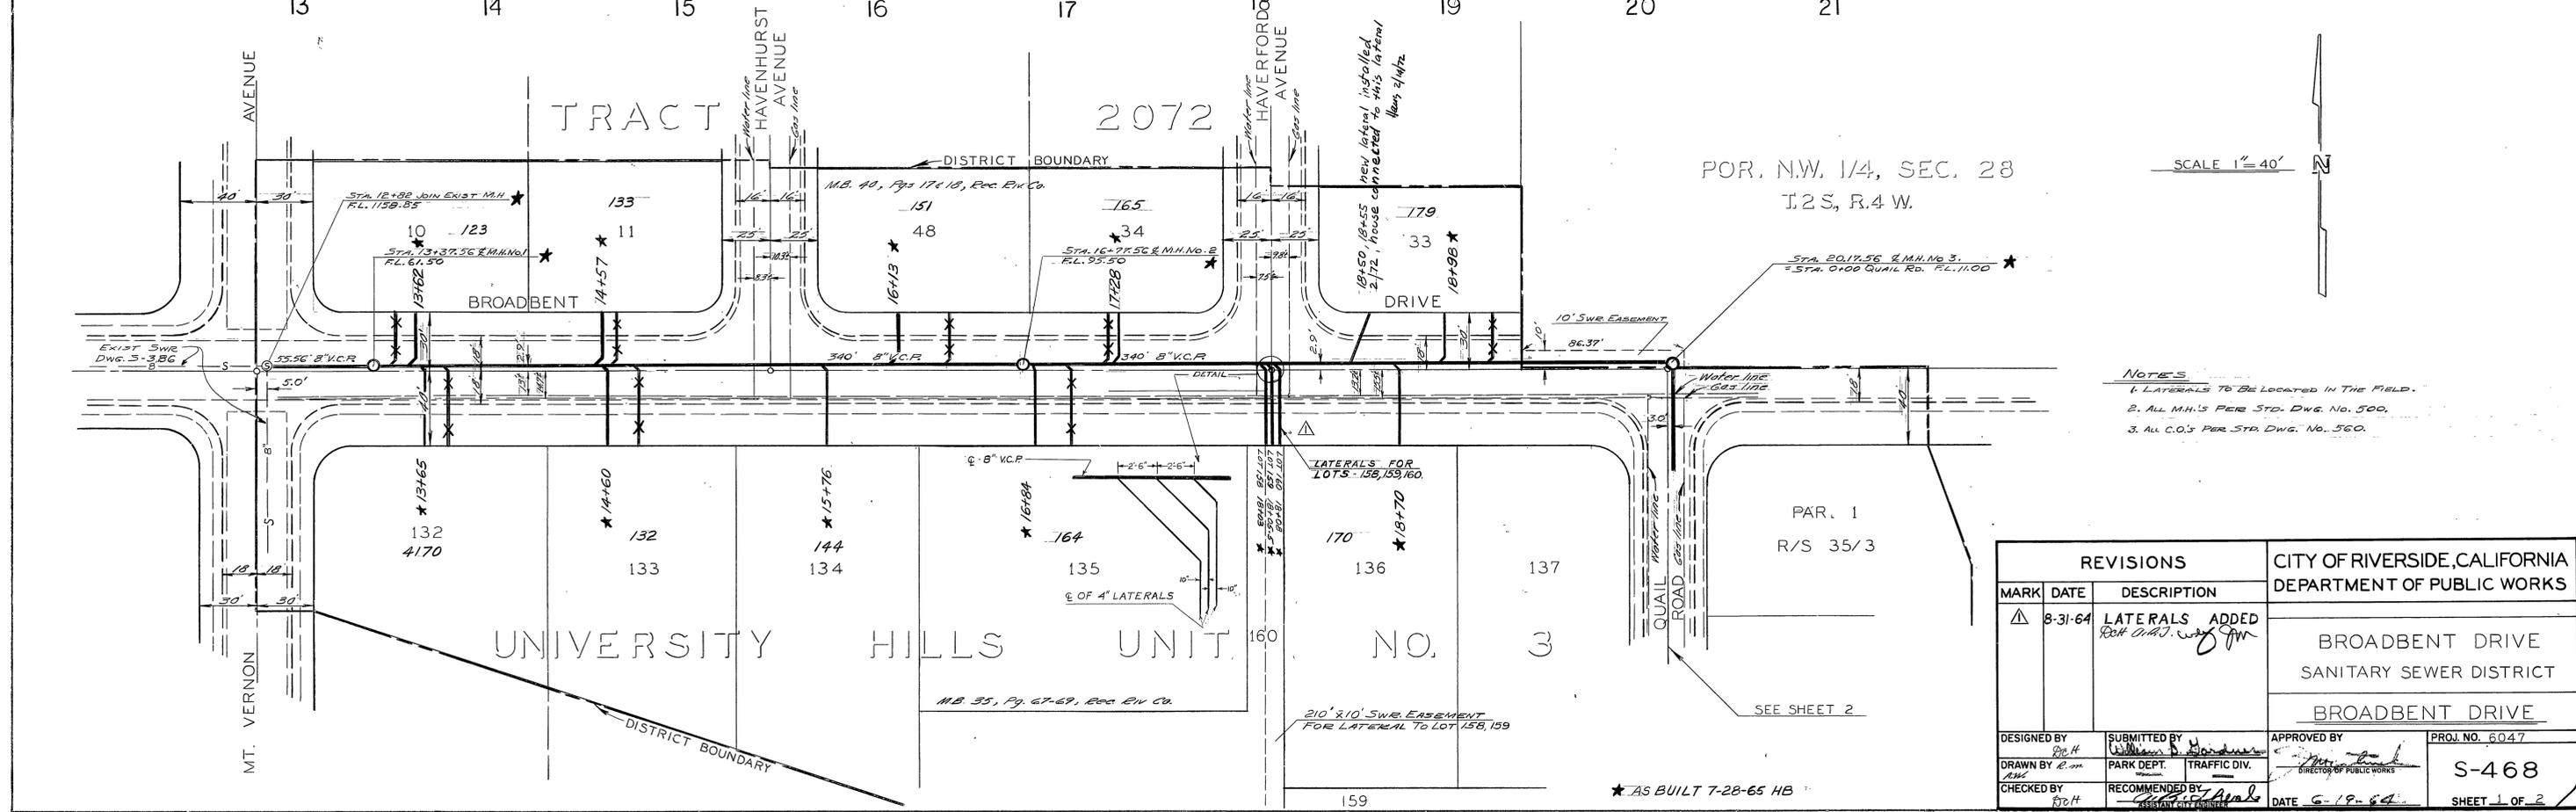

- NOTES
1. LATERALS TO BE LOCATED IN THE FIELD.
  2. ALL M.H.'S PER STD. DWG. NO. 500.
  3. ALL C.O.'S PER STD. DWG. NO. 500.

REVISIONS		CITY OF RIVERSIDE, CALIFORNIA DEPARTMENT OF PUBLIC WORKS	
MARK	DATE	DESCRIPTION	
Δ	8-31-64	LATERALS ADDED <i>Revised</i>	
		BROADBENT DRIVE SANITARY SEWER DISTRICT BROADBENT DRIVE	
DESIGNED BY	SUBMITTED BY	APPROVED BY	PROJ. NO. 6047
DRAWN BY R.M.	PARK DEPT. TRAFFIC DIV.	<i>[Signature]</i> DIRECTOR OF PUBLIC WORKS	S-468
CHECKED BY R.C.H.	RECOMMENDED BY	DATE 6-19-64	SHEET 1 OF 2


PROFILE

NO.	DATE	BY


PLAN

NO.	DATE	BY

★ AS BUILT 7-28-65 HB

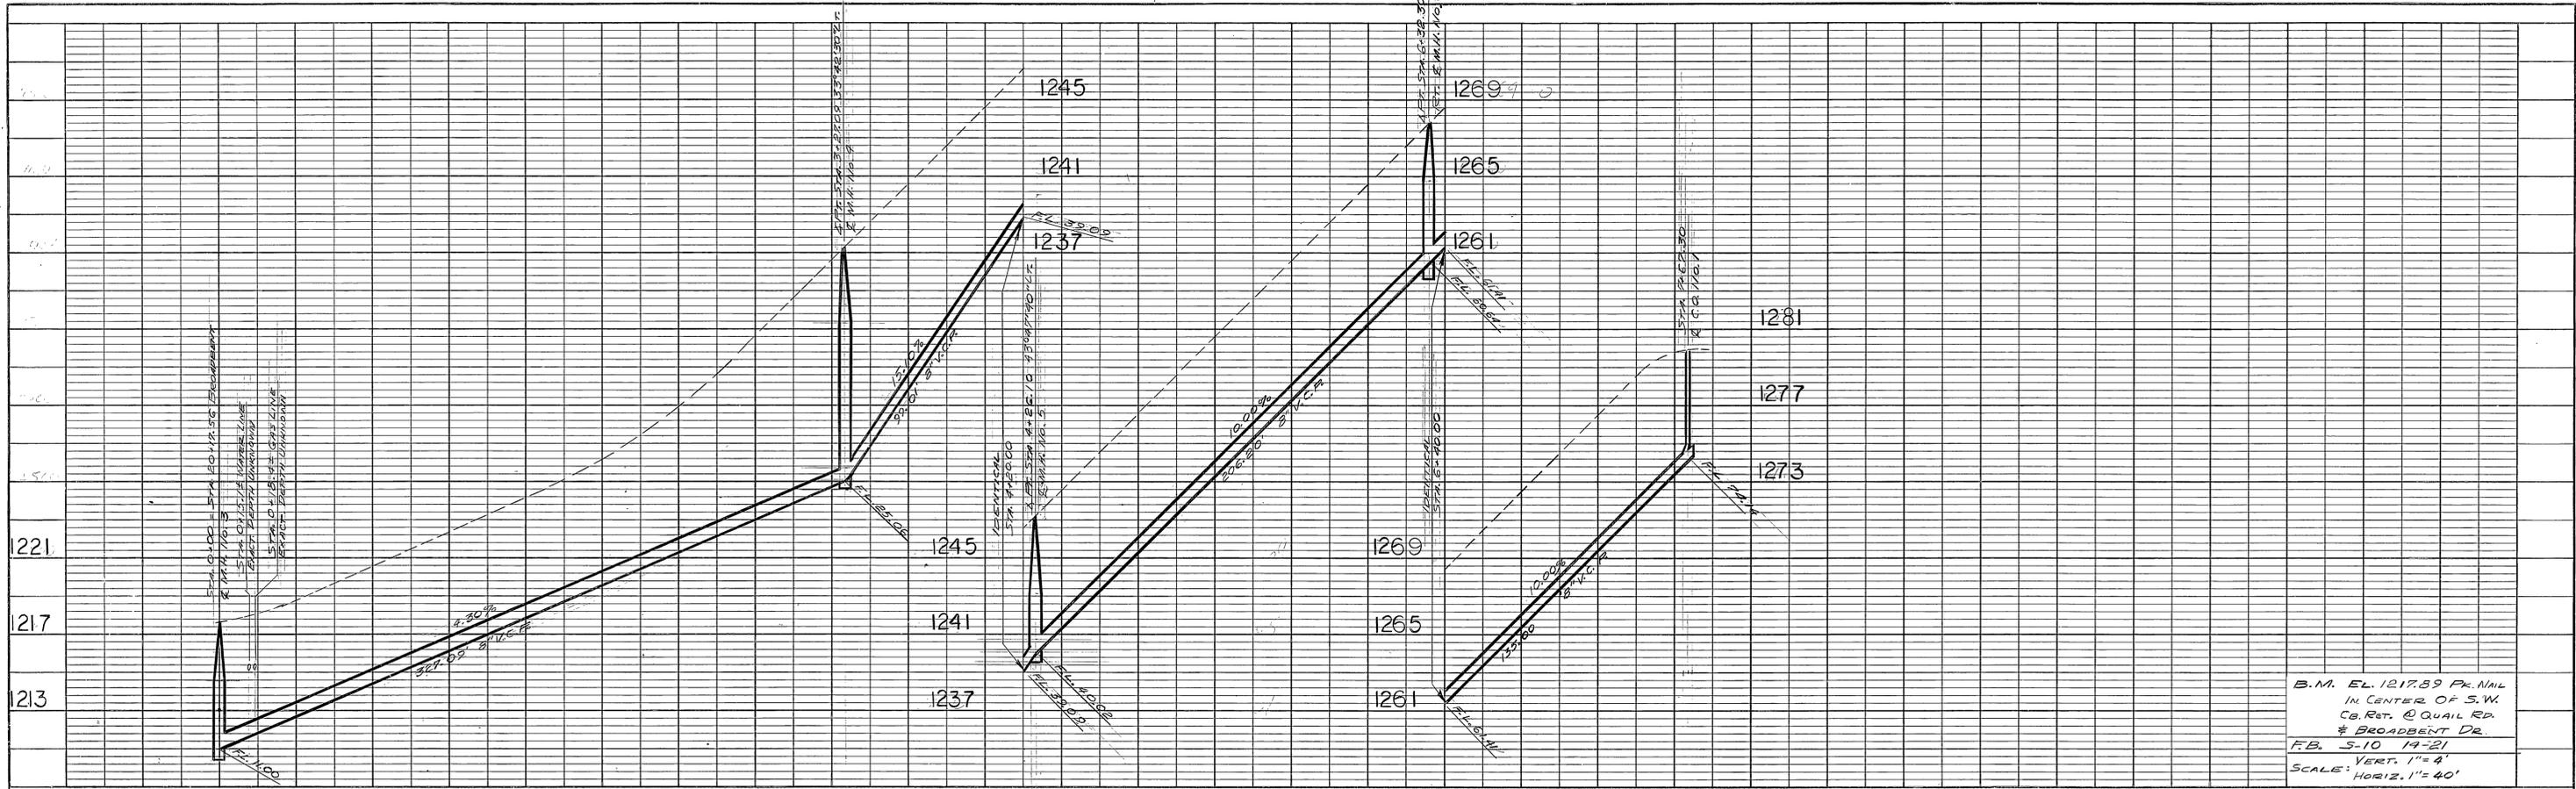

B.M. EL. 1217.89 Pk. Nail  
 IN CENTER OF S.W.  
 CORNER OF QUAIL RD.  
 & BROADBENT DR.  
 F.B. 5-10 19-21  
 VERT. 1" = 4'  
 SCALE: HORIZ. 1" = 40'

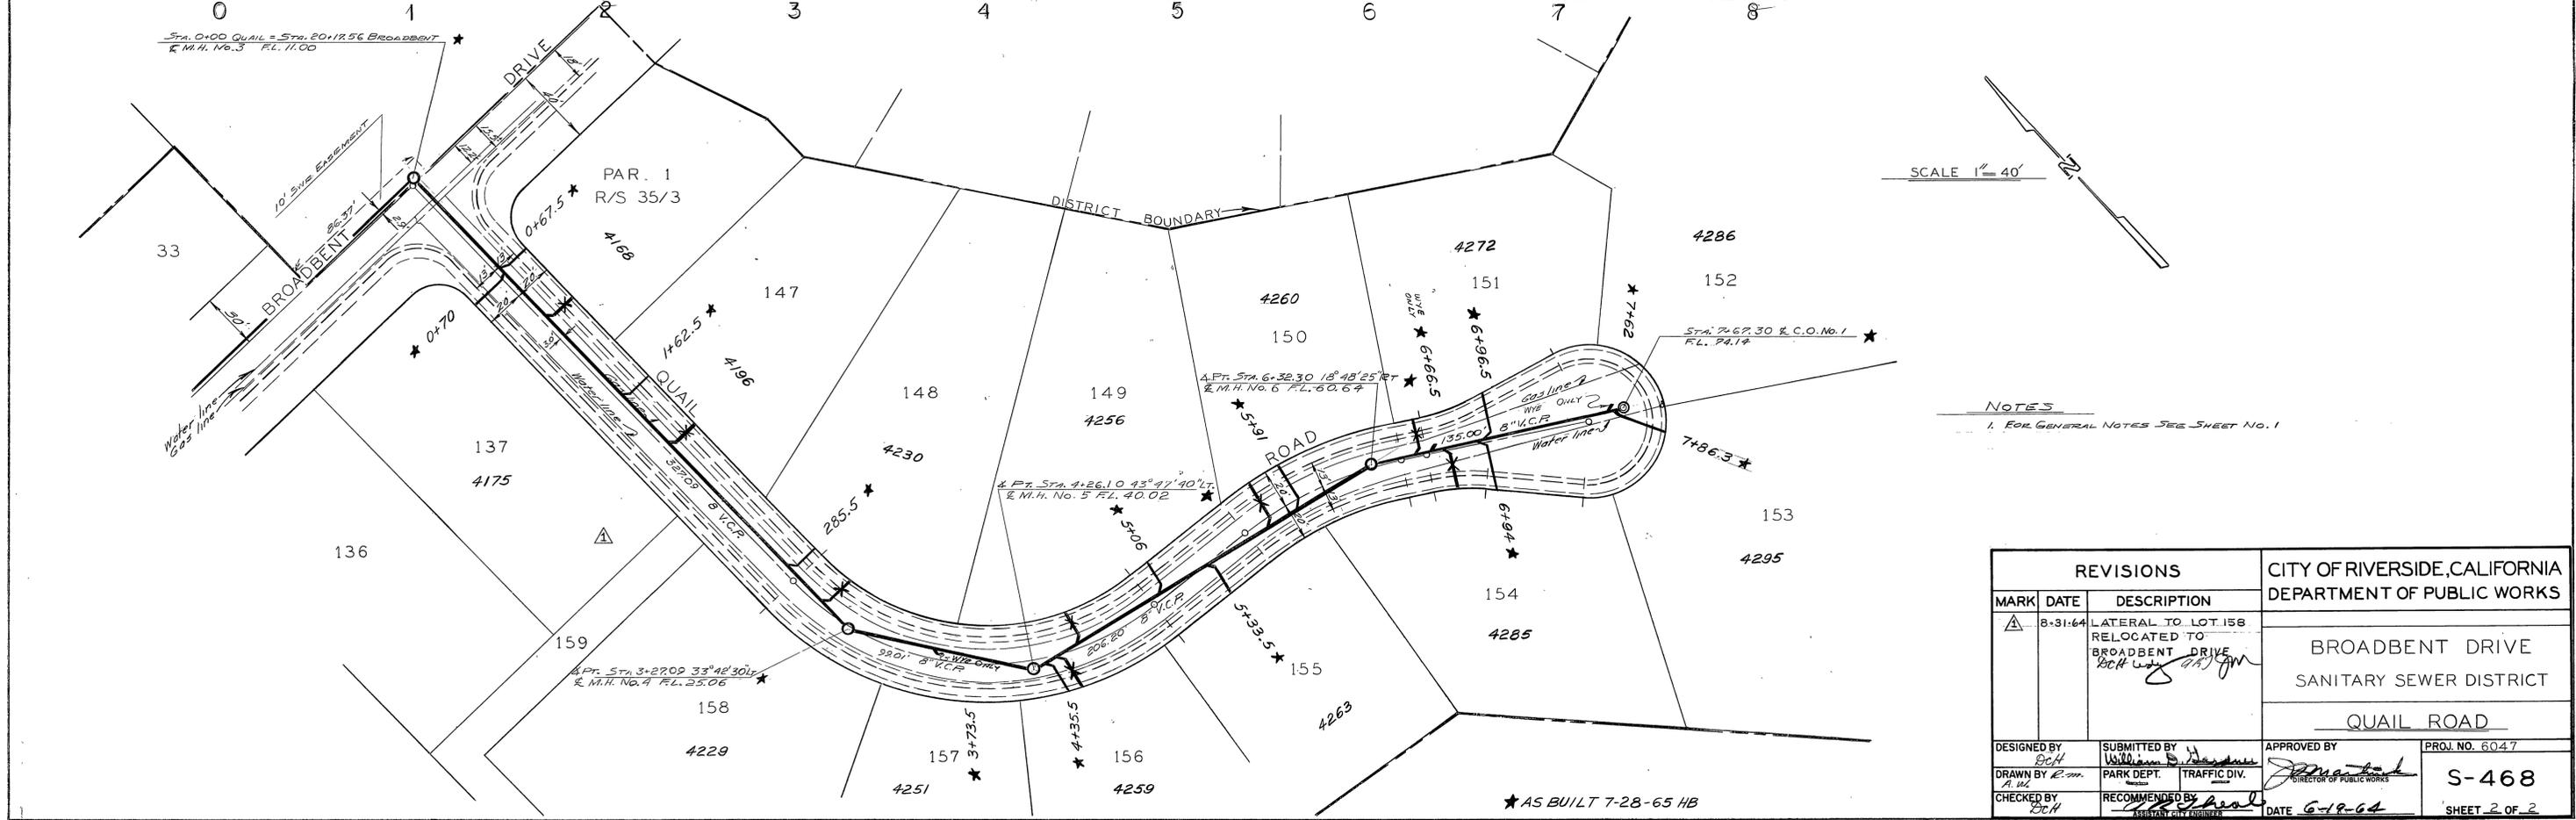

SCALE 1" = 40'

NOTES  
 1. FOR GENERAL NOTES SEE SHEET NO. 1

REVISIONS			CITY OF RIVERSIDE, CALIFORNIA DEPARTMENT OF PUBLIC WORKS	
MARK	DATE	DESCRIPTION		
△	8-31-64	LATERAL TO LOT 158 RELOCATED TO BROADBENT DRIVE <i>Boch</i>	BROADBENT DRIVE SANITARY SEWER DISTRICT QUAIL ROAD	
			SUBMITTED BY <i>William D. ...</i> PARK DEPT. TRAFFIC DIV. RECOMMENDED BY <i>Boch</i> ASSISTANT CITY ENGINEER	
			APPROVED BY <i>[Signature]</i> DIRECTOR OF PUBLIC WORKS PROJ. NO. 6047 S-468 SHEET 2 OF 2	
			DATE 6-19-64	

PROFILE

NO.	SUBMITTED	BY	DATE
	NOTED		
	CHECKED		
	DATE		

PLAN

NO.	SUBMITTED	BY	DATE
	NOTED		
	CHECKED		
	DATE		