
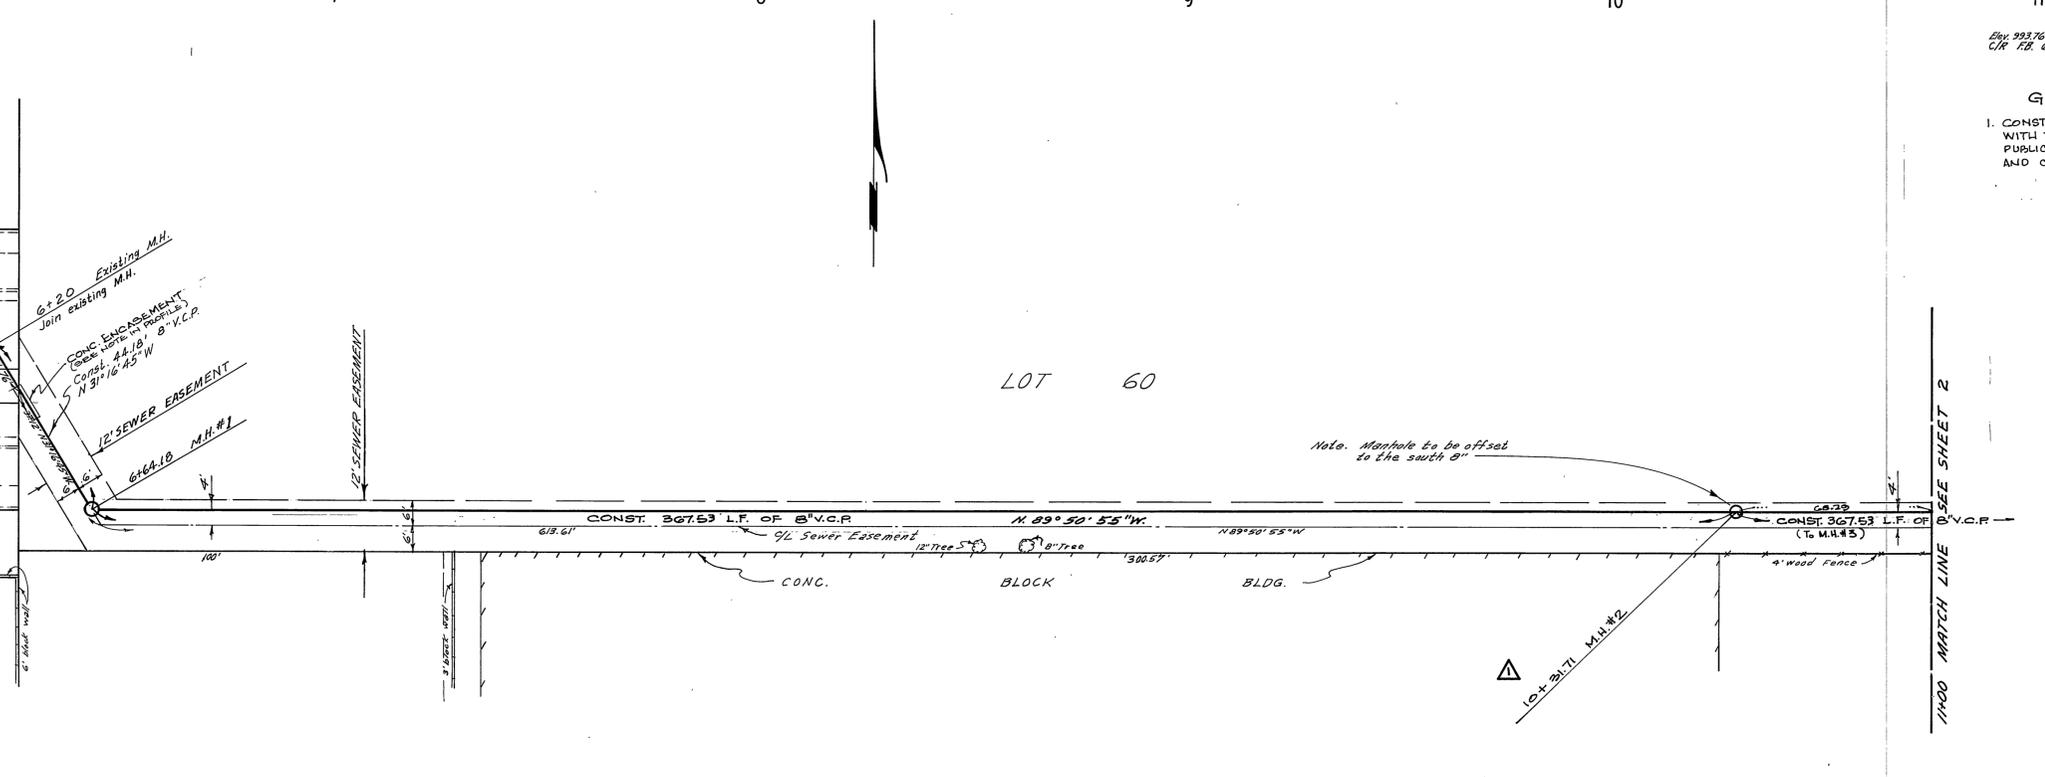


TRACT 2283 MB 42/66-67


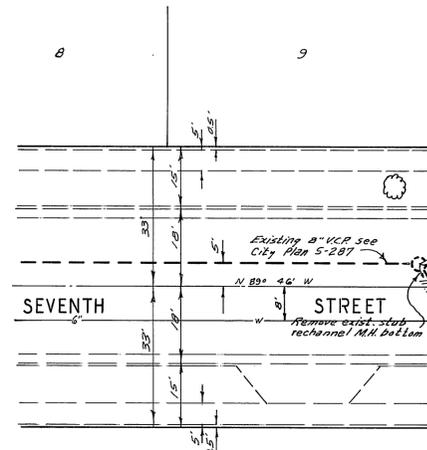


BENCH MARK
 Ety. 993.76. RR. nail in NE curb return Linden f Jaws
 C/R. P.R. 650/64

GENERAL NOTES
 1. CONSTRUCTION SHALL BE IN ACCORDANCE WITH THE STANDARD SPECIFICATIONS FOR PUBLIC WORKS CONSTRUCTION, 1973 EDITION, AND CITY OF RIVERSIDE STANDARD DRAWINGS.

Approved By *Herbert R. ...* 7-15-74
 General Superintendent & Chief Engineer - Water Dept.
 Date

ALBERT A. WEBB ASSOCIATES CIVIL ENGINEERS RIVERSIDE, CALIFORNIA APPROVED BY <i>Emil N. Webb</i> DATE 3/12/71 R.E. No. 9876 W.O. 73-219 FOR: CITY OF RIVERSIDE F.B. 1020	* "AS BUILT" 11/10/74 B.J.H. MOVED: M.H.#2 AND REV. GRADING CHG. ENCL. BM. MARK REVISIONS APPR. DATE DESIGNED BY B.E.L. DRAWN BY B.E.L. CHECKED BY E.N.W.	CITY OF RIVERSIDE, CALIFORNIA PUBLIC WORKS DEPARTMENT	SEWER PLAN AND PROFILE SEVENTH ST. SEWER EXTENSION FROM 620' Ely of Cranford Avenue TO 101st AVENUE FOR GARCEL MAP M.156	ACCOUNT No. 37-511-535 DRAWING NUMBER S-978 SHEET 1 OF 2 73-219 B
		APPROVED BY <i>William D. ...</i> DATE 7/19 PRINCIPAL ENGINEER PARK DEPARTMENT TRAFFIC DIVISION CHIEF PUB. WKS. ENGR.	APPROVED BY <i>William D. ...</i> DIRECTOR OF PUBLIC WORKS DATE 7/25/74	SCALE: 1" = 20' Horiz., 1" = 4' Vert.

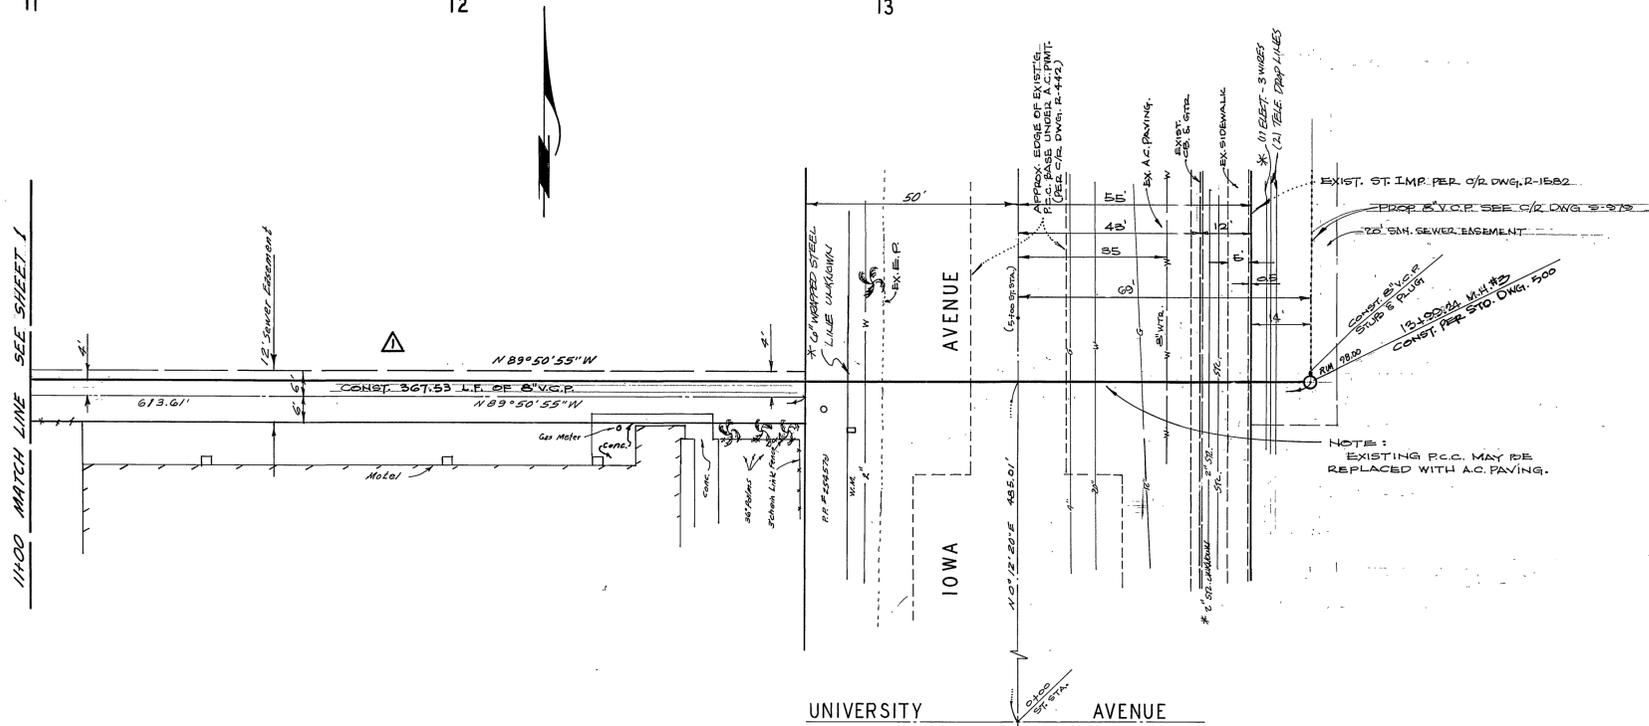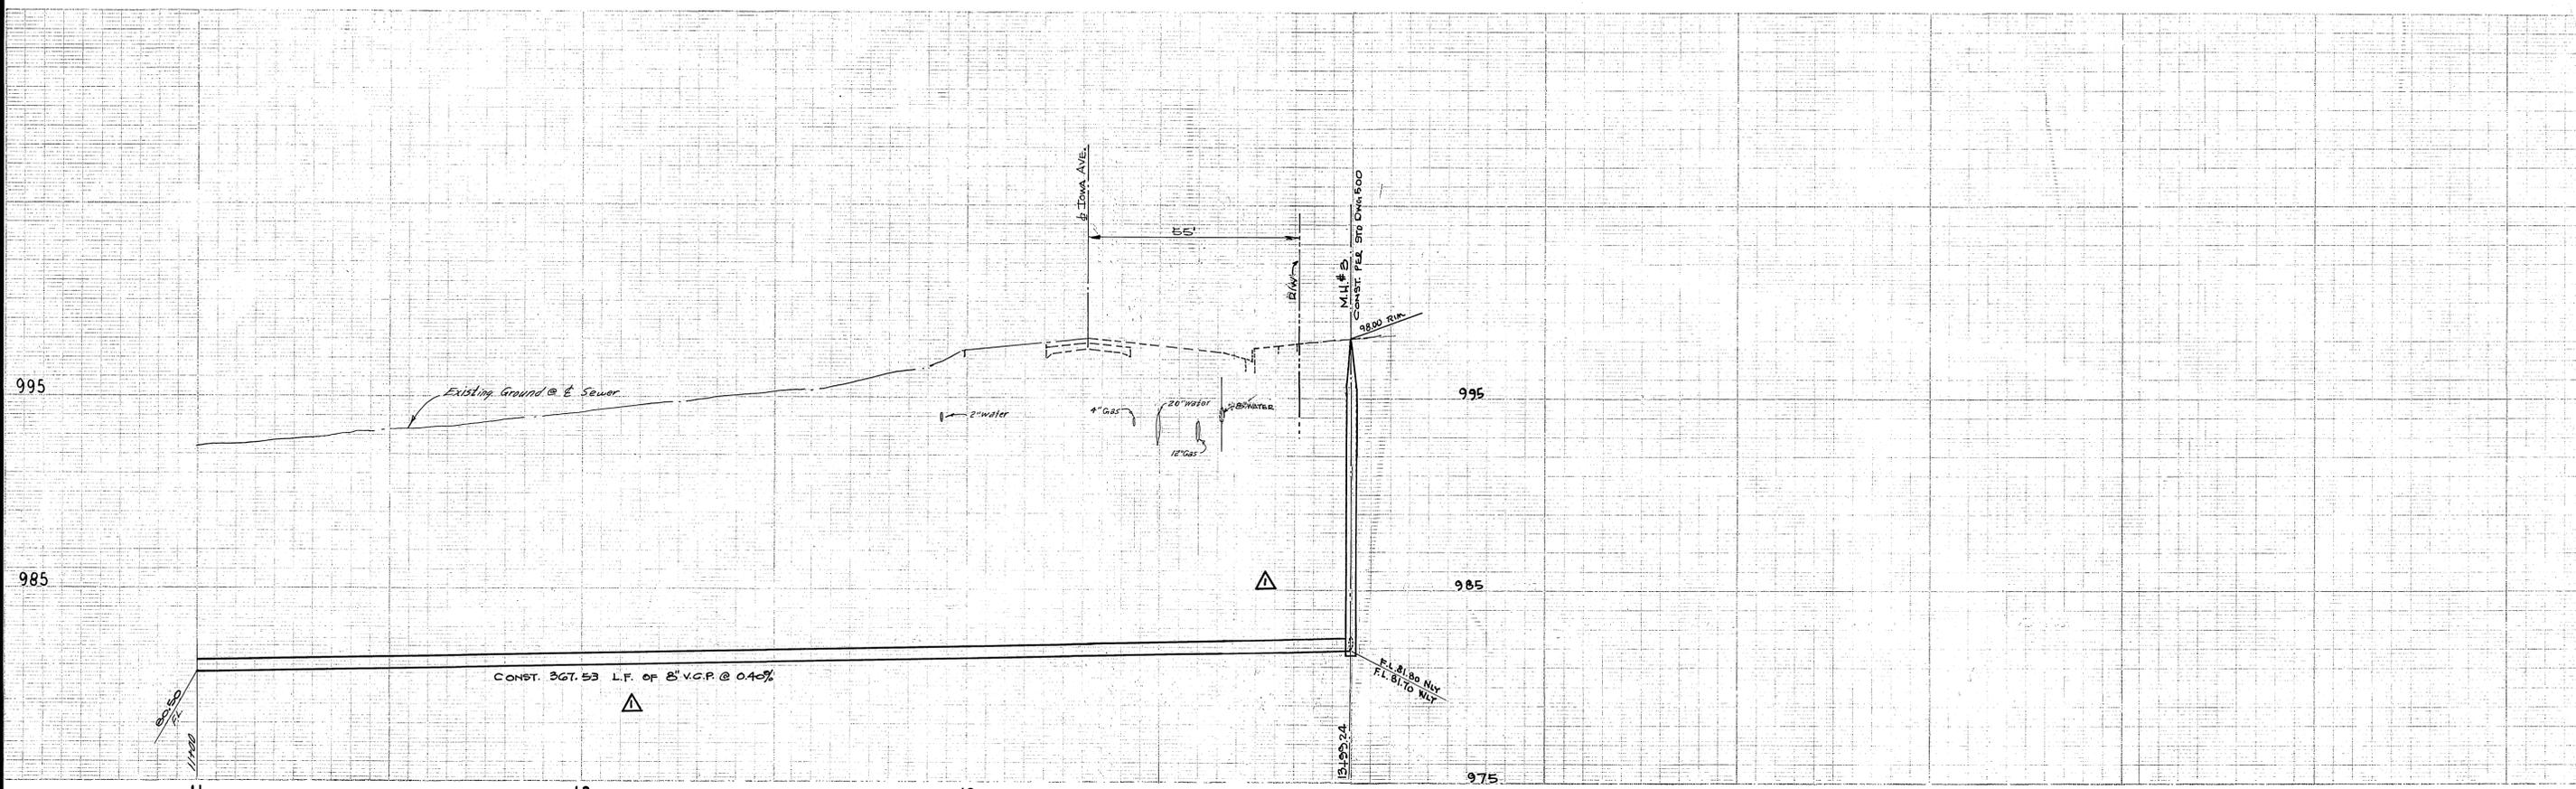

BENCH MARK
 Elev. 993.76 PK nail in NE curb return Linden / Iowa
 CIR FB. 650/64

NOTICE TO CONTRACTOR
 The existence and location of any underground utility pipes or structures shown in these plans are obtained by a review of the available records. To the best of our knowledge, there are no existing utilities except as shown on these plans.
 The Contractor is required to take the utmost necessary measures to protect the utility lines shown and any other files not of record or not shown on these plans.

Approved By Howard K. Creamer 7-15-74
 General Superintendent of Civil Engineer - Water Dept.
 Date

ALBERT A. WEBB ASSOCIATES
 CIVIL ENGINEERS
 RIVERSIDE, CALIFORNIA
 APPROVED BY Scott H. Wall DATE 3/12/74
 R.E. No. 9876
 W.O. 73-219 FOR CITY OF RIVERSIDE. F.B. 1020

* 11/15 BUILT 11/15/74 C.I.K.
 MARK REVISIONS APPR. DATE
 DESIGNED BY BEL DRAWN BY BEL CHECKED BY ENVO

CITY OF RIVERSIDE, CALIFORNIA
 PUBLIC WORKS DEPARTMENT
 APPROVED BY William D. Anderson DATE 7/25/74
 DIRECTOR OF PUBLIC WORKS
 DATE 7/25/74

SEWER PLAN AND PROFILE
 SEVENTH ST. SEWER EXTENSION
 FROM
 620' Ely of Cranford Avenue
 TO
 IOWA AVENUE
 FOR PARCEL MAP NO. 156
 SCALE: 1" = 20' Horiz., 1" = 4' Vert.

ACCOUNT No. 32-572-535
 DRAWING NUMBER
5-978
 SHEET 2 OF 2
 73-219 B