

NOTE: EXACT LATERAL LOCATION TO BE DETERMINED IN THE FIELD.
 IT SHALL BE THE RESPONSIBILITY OF THE CONTRACTOR TO CLEAR THE RIGHT-OF-WAY IN ACCORDANCE WITH THE PROVISIONS OF LAW AS IT EFFECTS EACH UTILITY, INCLUDING IRRIGATION LINES AND APPURTENANCES, AND AT NO EXTRA COST TO THE CITY.

- 1-29-58 Moved NH #1, Added stub. B.L.
- 3-24-58 As Built H.C. & Wye H. Butt
- 7-15-59 As Built Gas per Plan D-30 RB.


CITY OF RIVERSIDE, CALIFORNIA
 DEPARTMENT OF PUBLIC WORKS

JACKSON STREET TRUNK LINE SEWER
 CALIFORNIA TO MAGNOLIA




APPROVED BY: *[Signature]*
 DIRECTOR, PUBLIC WORKS

S-98
 SHEET 1 OF 2

PROJECT: JACKSON STREET SEWER TRUNK LINE
 DATE: 12-3-57
 DRAWN BY: J.L.B.
 CHECKED BY: J.L.B.
 APPROVED BY: J.L.B.
 CITY OF RIVERSIDE, CALIFORNIA

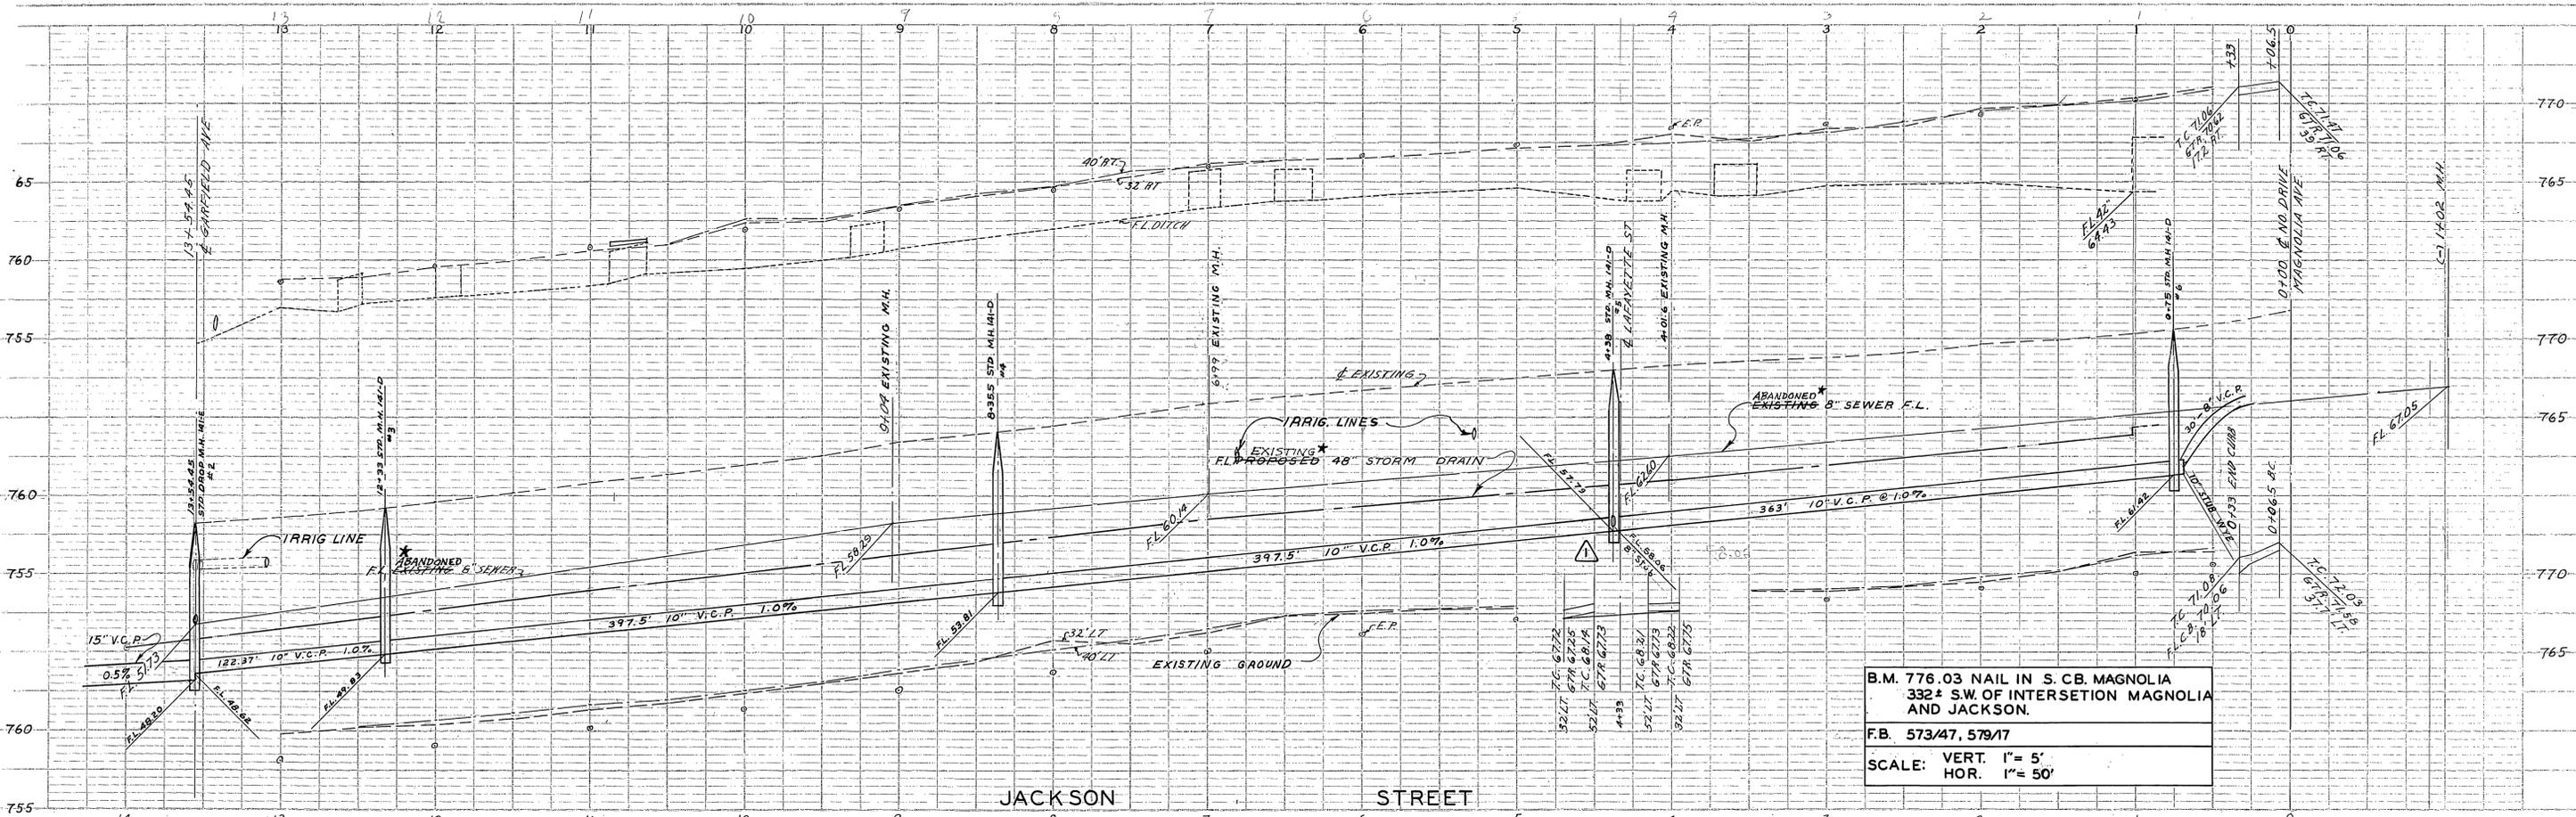

B.M. 776.03 NAIL IN S. CB. MAGNOLIA
 332# S.W. OF INTERSECTION MAGNOLIA
 AND JACKSON.
 F.B. 573/47, 579/17
 SCALE: VERT. 1" = 5'
 HOR. 1" = 50'

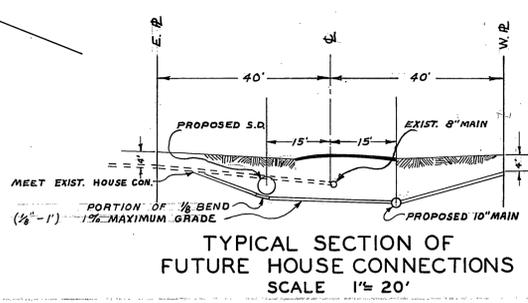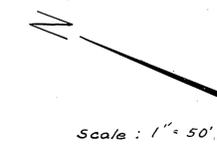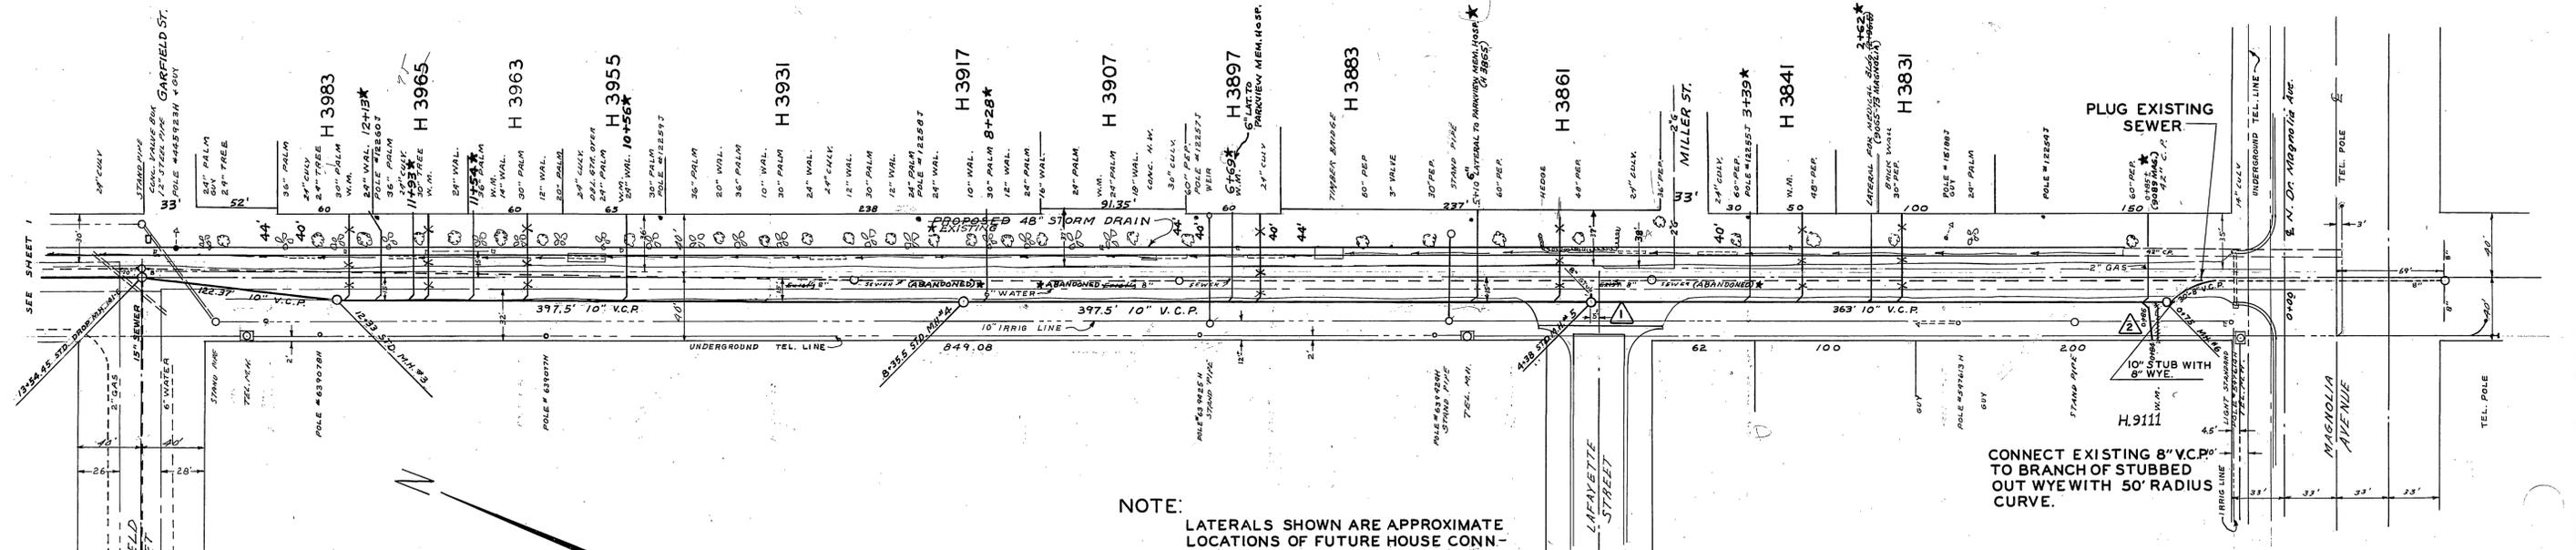

LAY WYE BRANCHES FLAT ON E SIDE ON FUTURE CONNECTIONS.

CONNECT EXISTING 8" V.C.P. TO BRANCH OF STUBBED OUT WYE WITH 50' RADIUS CURVE.

| EVICTIONS | | CITY OF RIVERSIDE CALIFORNIA DEPARTMENT OF PUBLIC WORKS | |
|-------------|-------------------------------|---|--|
| DESCRIPTION | | JACKSON STREET TRUNK LINE SEWER CALIFORNIA TO MAGNOLIA | |
| 1-29-58 | Added stub to MH #5. wdg | CHECKED BY J.L.B. ENGINEER DATE 12-3-57 SHEET 2 OF 2 | |
| 3-24-58 | As Built H.C. H. Bull | | |
| 7-15-59 | As Built (See Plan D-30) H.B. | | |

| | | |
|-----|------|-------------|
| NO. | DATE | DESCRIPTION |
| | | |
| | | |

| | | |
|-----|------|-------------|
| NO. | DATE | DESCRIPTION |
| | | |
| | | |