GENERAL NOTES

- 1. IT SHALL BE THE RESPONSIBILITY OF THE CONTRACTOR TO CLEAR THE RIGHT-OF-WAY IN ACCORDANCE WITH THE PROVISIONS OF THE LAW AS IT AFFECTS EACH UTILITY, INCLUDING IRRIGATION LINES AND APPURTENANCES AND AT NO COST TO THE CITY.
- 2. CONSTRUCTION SHALL BE IN ACCORDANCE WITH THE CITY OF RIVERSIDE DEPARTMENT OF PUBLIC WORKS, STANDARD DRAWINGS, STANDARD DRAWING #10, AND THE STANDARD SPECIFICATIONS FOR PUBLIC WORKS CONSTRUCTION, CURRENT
- 3. QUANTITIES SHOWN ARE FOR INFORMATION ONLY AND THE CITY OF RIVERSIDE IS NOT RESPONSIBLE FOR THEIR ACCURACY.
- 4. ALL FLAGGED ELEVATIONS SHALL BE STAKED IN THE FIELD BY THE PRIVATE ENGINEER.
- 5. CONTRACTOR SHALL REPLACE ALL EXISTING GROUND COVER, A.C. PAVEMENT, AND CURB AND GUTTER IN KIND.
- THE PRIVATE ENGINEER SIGNING THESE PLANS IS RESPONSIBLE FOR ASSURING THE ACCURACY AND ACCEPTABILITY OF THE WORK HEREON. IN THE EVENT OF DISCREPANCIES ARISING DURING CONSTRUCTION, THE PRIVATE ENGINEER SHALL BE RESPONSIBLE FOR DETERMINING AN ACCEPTABLE SOLUTION AND REVISING THE PLANS FOR APPROVAL BY THE CITY.
- 7. THE CONTRACTOR SHALL CALL IN A LOCATION REQUEST TO UNDERGROUND SERVICE ALERT (USA), PHONE NUMBER 1-800-422-4133, TWO WORKING DAYS BEFORE DIGGING. NO CONSTRUCTION PERMIT WILL BE ISSUED BY THE PUBLIC WORKS DEPARTMENT INVOLVING EXCAVATION FOR UNDERGROUND FACILITIES UNLESS THE APPLICANT HAS BEEN PROVIDED AN INQUIRY IDENTIFICATION NUMBER BY USA.
- 8. THE DEVELOPER SHALL BE RESPONSIBLE FOR PRESERVING OR RE-ESTABLISHING AND REFERENCING SURVEY MONUMENTS DESTROYED, DISTURBED OR BURIED AS A RESULT OF CONSTRUCTION SHOWN HEREON.
- 9. NOTICE TO CONTRACTOR: THE EXISTENCE AND LOCATION OF ANY UNDERGROUND UTILITY PIPES OR STRUCTURES SHOWN ON THESE PLANS WERE OBTAINED BY A SEARCH OF THE AVAILABLE RECORDS. TO THE BEST OF OUR KNOWLEDGE THERE ARE NO EXISTING UTILITIES EXCEPT AS SHOWN ON THESE PLANS. THE CON-TRACTOR IS REQUIRED TO TAKE PRECAUTIONARY MEASURES TO PROTECT THE UTILITY LINES SHOWN AND ANY OTHER LINES NOT OF RECORD OR NOT SHOWN ON THESE PLANS.
- 10. CONSTRUCTION CONTRACTOR AGREES THAT IN ACCORDANCE WITH GENERALLY ACCEPTED CONSTRUCTION PRACTICES, CONSTRUCTION CONTRACTOR WILL BE REQUIRED TO ASSUME SOLE AND COMPLETE RESPONSIBILITY FOR JOB SITE CONDITIONS DURING THE COURSE OF CONSTRUCTION OF THE PROJECT, INCLUDING SAFETY OF ALL PERSONS AND PROPERTY; THAT THIS REQUIREMENT SHALL BE MADE TO APPLY CONTINUOUSLY AND NOT BE LIMITED TO NORMAL WORKING HOURS, AND CONSTRUCTION CONTRACTOR FURTHER AGREES TO DEFEND, INDEMNITY AND HOLD DESIGN PROFESSIONAL HARMLESS FROM ANY AND ALL LIABILITY, REAL OR ALLEGED, IN CONNECTION WITH THE PERFORMANCE OF WORK ON THIS PROJECT, EXCEPTING LIABILITY ARISING FROM THE SOLE NEGLIGENCE OF DESIGN PROFESSIONAL.
- 11. ANY TRAFFIC CONTROL STRIPING OBLITERATED AND/OR BADLY WORN DURING CON-STRUCTION SHALL BE RESTORED BY THE CONTRACTOR WITHIN FIVE DAYS AFTER NOTIFICATION FROM THE CITY INSPECTORS.
- 12. A SEPARATE STREET OPENING PERMIT IS REQUIRED FOR REMOVAL OR RELOCATION OF TREES IN THE PUBLIC RIGHT-OF-WAY.

CONSTRUCTION NOTES AND QUANTITY ESTIMATES

NO.	ITEM DESCRIPTION	QUANITY	
		TOTAL	UNIT
\bigcirc	INSTALL 24" R.C.P (1350-D)	301	L.F.
(2)	INSTALL 18" R.C.P. (2.000-D)	40	L.F.
3	CONSTRUCT MANHOLE EZ PER CITY STD. 431	2	EA.
4	CONSTRUCT JUNCTION STRUCTURE No. 4 PER STD. 423		EA.
(5)	CONSTRUCT CATCH BASIN PER CITY STD. 405	l l	EA.
6	CONSTRUCT CONCRETE COLLAR PER STD. 424	1	EA.

Call:TOll FREE


TWO WORKING DAYS BEFORE YOU DIG


1-800





FALCON CABLE TV		
APPROVED BY: Malala		
DATE: 10-13-86		

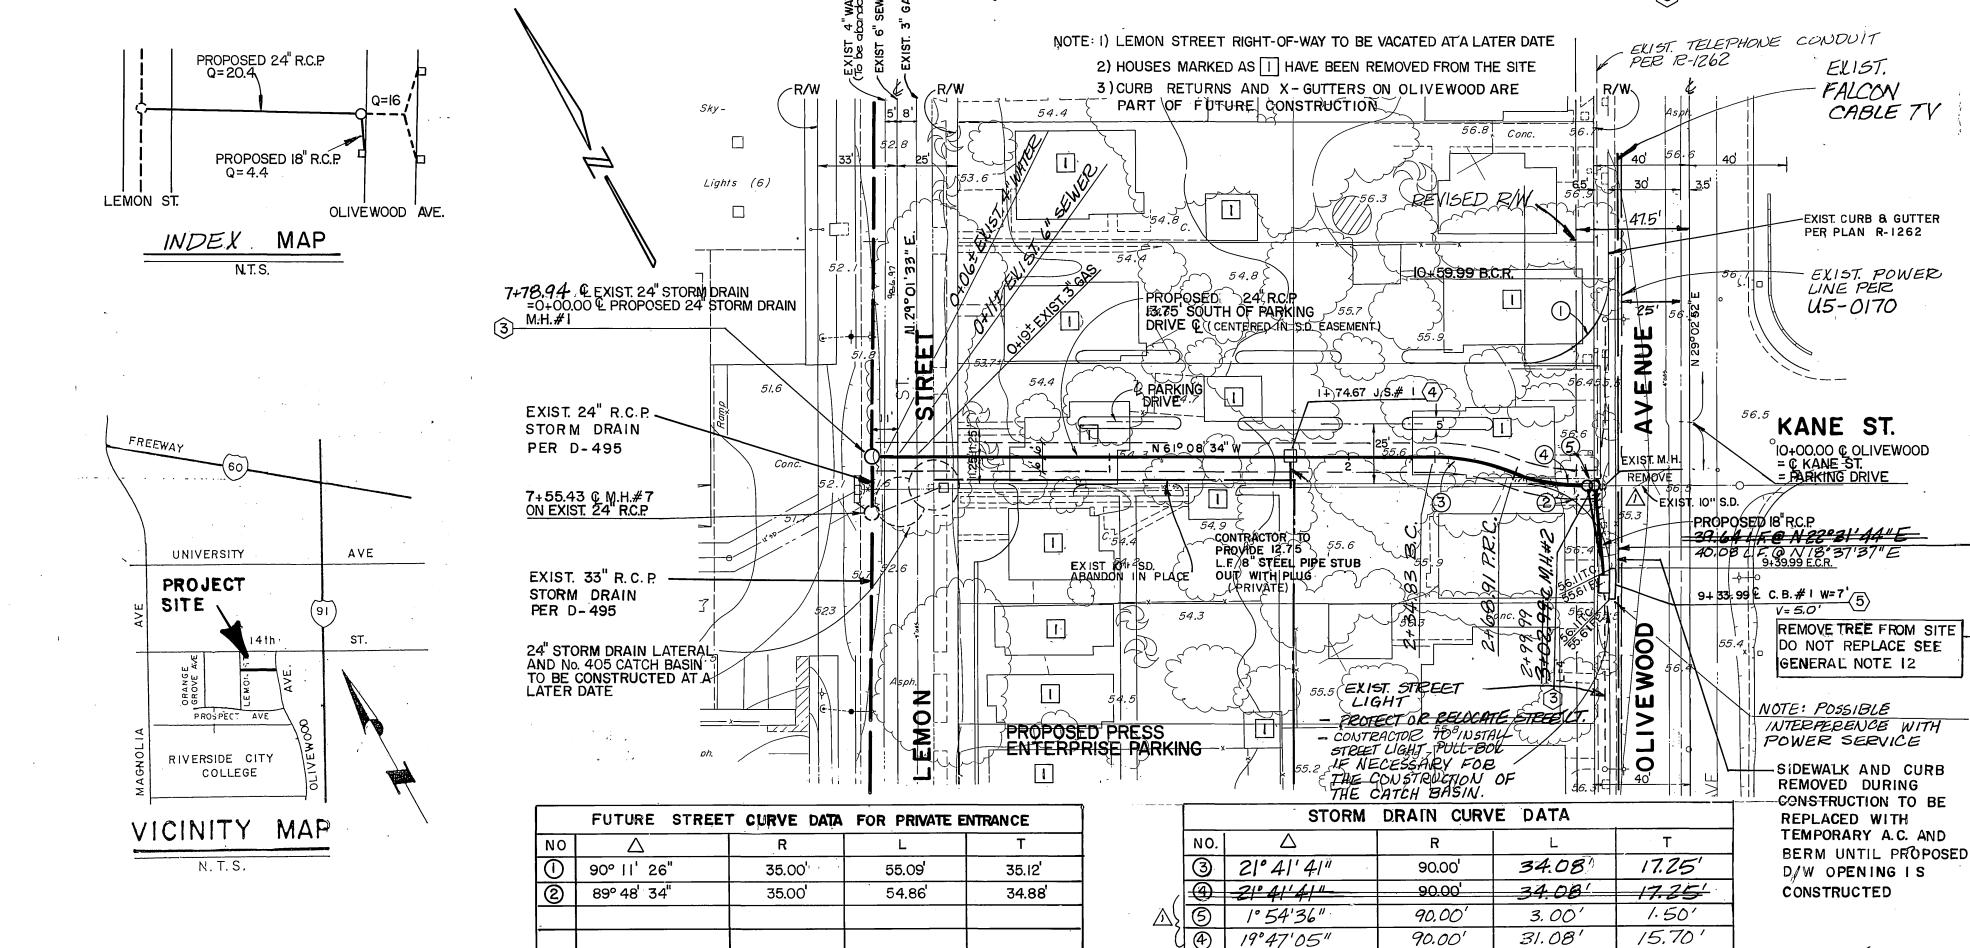

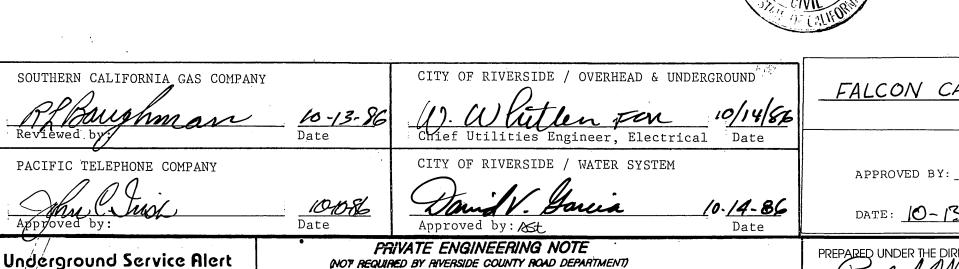

(NOT REQUIRED BY RIVERSIDE COUNTY ROAD DEPARTMENT) CONSTRUCTION CONTRACTOR AGREES THAT IN ACCORDANCE WITH GENERALLY ACCEPTED CONSTRUCTION PRACTICES, CONSTRUCTION CONTRACTOR WILL BE REQUIRED TO ASSUME SOLE AND COMPLETE RESPONSIBILITY FOR JOB SITE CONDITIONS DURING THE COURSE OF THAT THIS REQUIREMENT SHALL BE MADE TO APPLY CONTINUOUSLY AND NOT BE LIMITED TO NORMAL WORKING HOURS, AND CONSTRUCTION CONTRACTOR FURTHER AGREES TO DEFEND, INDEMNIFY AND HOLD DESIGN PROFESSIONAL HARMLESS FROM ANY AND ALL LIABILITY,

REAL OR ALLEGED. IN CONNECTION WITH THE PERFORMANCE OF WORK ON THIS PROJECT,

PREPARED UNDER THE DIRECTION OF EXPIRATION DATE ____ 3 - 30 - 89

APPROVED BY:

J F DAVIDSON ASSOCIATES, INC CIVIL ENGINEERS • SURVEYORS • PLANNERS 11200 SO, MT, VERNON AVE., #D 73-080 EL PASEO, #103 P.O. BOX 493 ■ RIVERSIDE, CA 92502 □ COLTON, CA 92324 □ PALM DESERT, CA 92260 (714) 686-0844 (714) 825-1082 (619) 346-5691

l" = 40'

DATE OCT 1986

H6-D FOUND P.K. NAIL AND CITY ENGINEER TAG IN CENTER OF

ELEV. 875.844

CURB RETURN AT COMMERCE ST. AND COTTAGE ST.

ARK DEPARTMENT AFFIC DIVISION APPR. DATE DESIGNED BY J.P. DRAWN BY T.F.E. CHECKED BY R.H. O

Shifted manhole # 2 0.4

CITY OF RIVERSIDE, CALIFORNIA DEPARTMENT OF PUBLIC WORKS

DIRECTOR OF PUBLIC WORKS

DATE 10-14-86

PROPOSED PARKING

CONTRACTOR TO PLUG AND ABANDON EXIST IO PIPE

Q = 20,4 ofs

V = 6 fps

PROPOSED

GRADE

WEST OF M.H. #2

LOLIVEWOOD AVE.

EXIST. IO CONC PIPE MAINTAIN IN PLACE

CONTRACTOR TO INSTALL 24 STUBOUT E IV WITH PLUG (FOR FUTURE USE)

RECONST. 10 CANCE PIRE 850

CREMOVE & REPLACE WITH

CONCRETE COLLAR

PER STD. 424

EXIST GRADE

FALSON CABLE

STREET LIGHT

OF 18"R.C.P. @ S=0.069

845

Q100 = 4.4 c.f.s. Q. 0376

CONST. 39.64 L.F.

V = 7 f.p.s.

LOT GRADE

-EXIST GROUND

ABOVE PIPE

0100 = 20,4 cf.s.

-EXIST GROUND

-CONST 12.75 LF OF 8"STEEL PIPE @ S=0.0200 INSTALL TEMP PLUG

V = 6 f.p.s.

850

Exist 4 water main

after tietover of

all exist, water

to be abandoned <u>ONLY</u>

OLIVEWOOD AVE. TO LEMON ST.

* As built 3/17/87 VE

VERT. SCALE: 1" = 4' | FILE NO. 9276-1

PROJECT NO.

SHEET.

STORM DRAIN CONNECTOR S/O 14th ST.

, -7- 25

HORIZ. SCALE: 1" = 40'

EXCEPTING LIABILITY ARISING FROM THE SOLE NEGLIGENCE OF DESIGN PROFESSIONAL.