
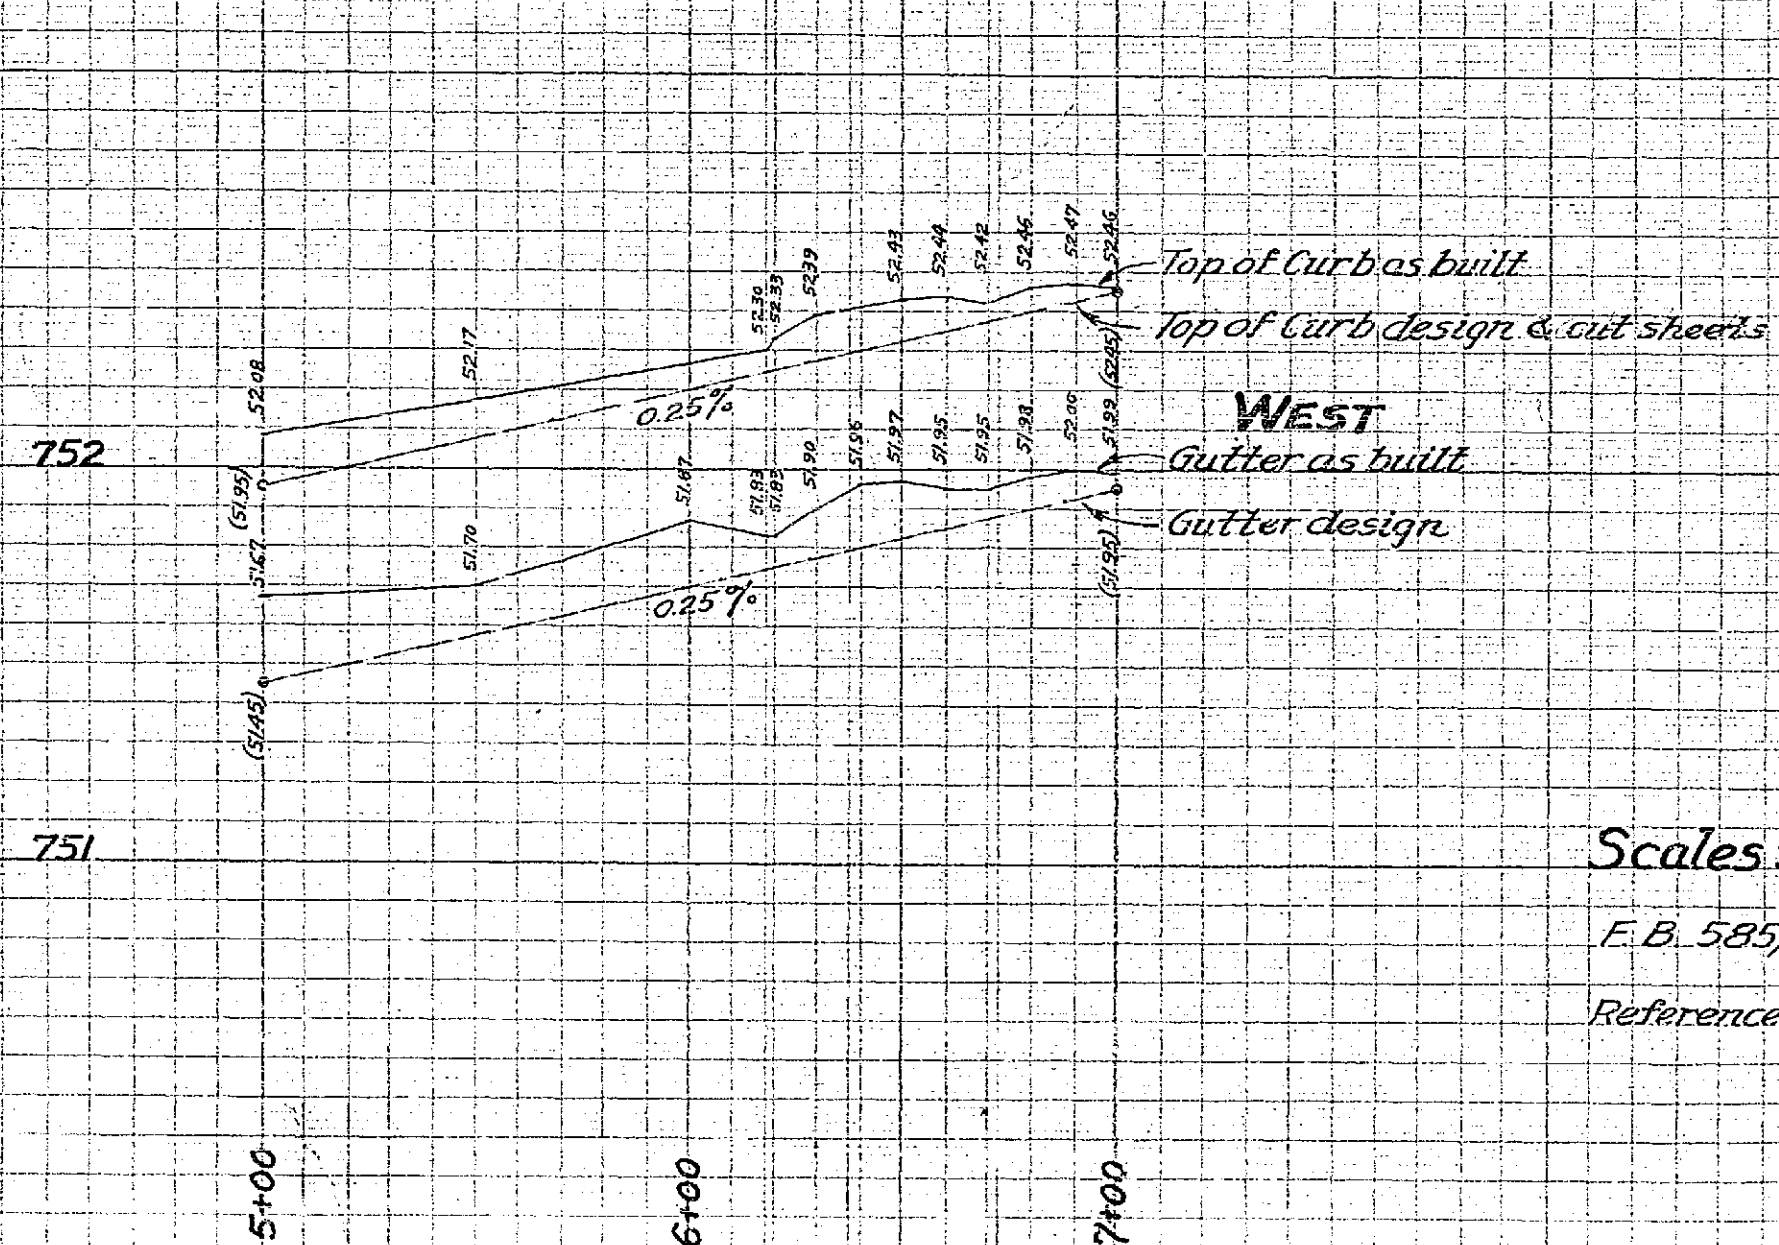


NESSEL ST.

WHEELER ST.

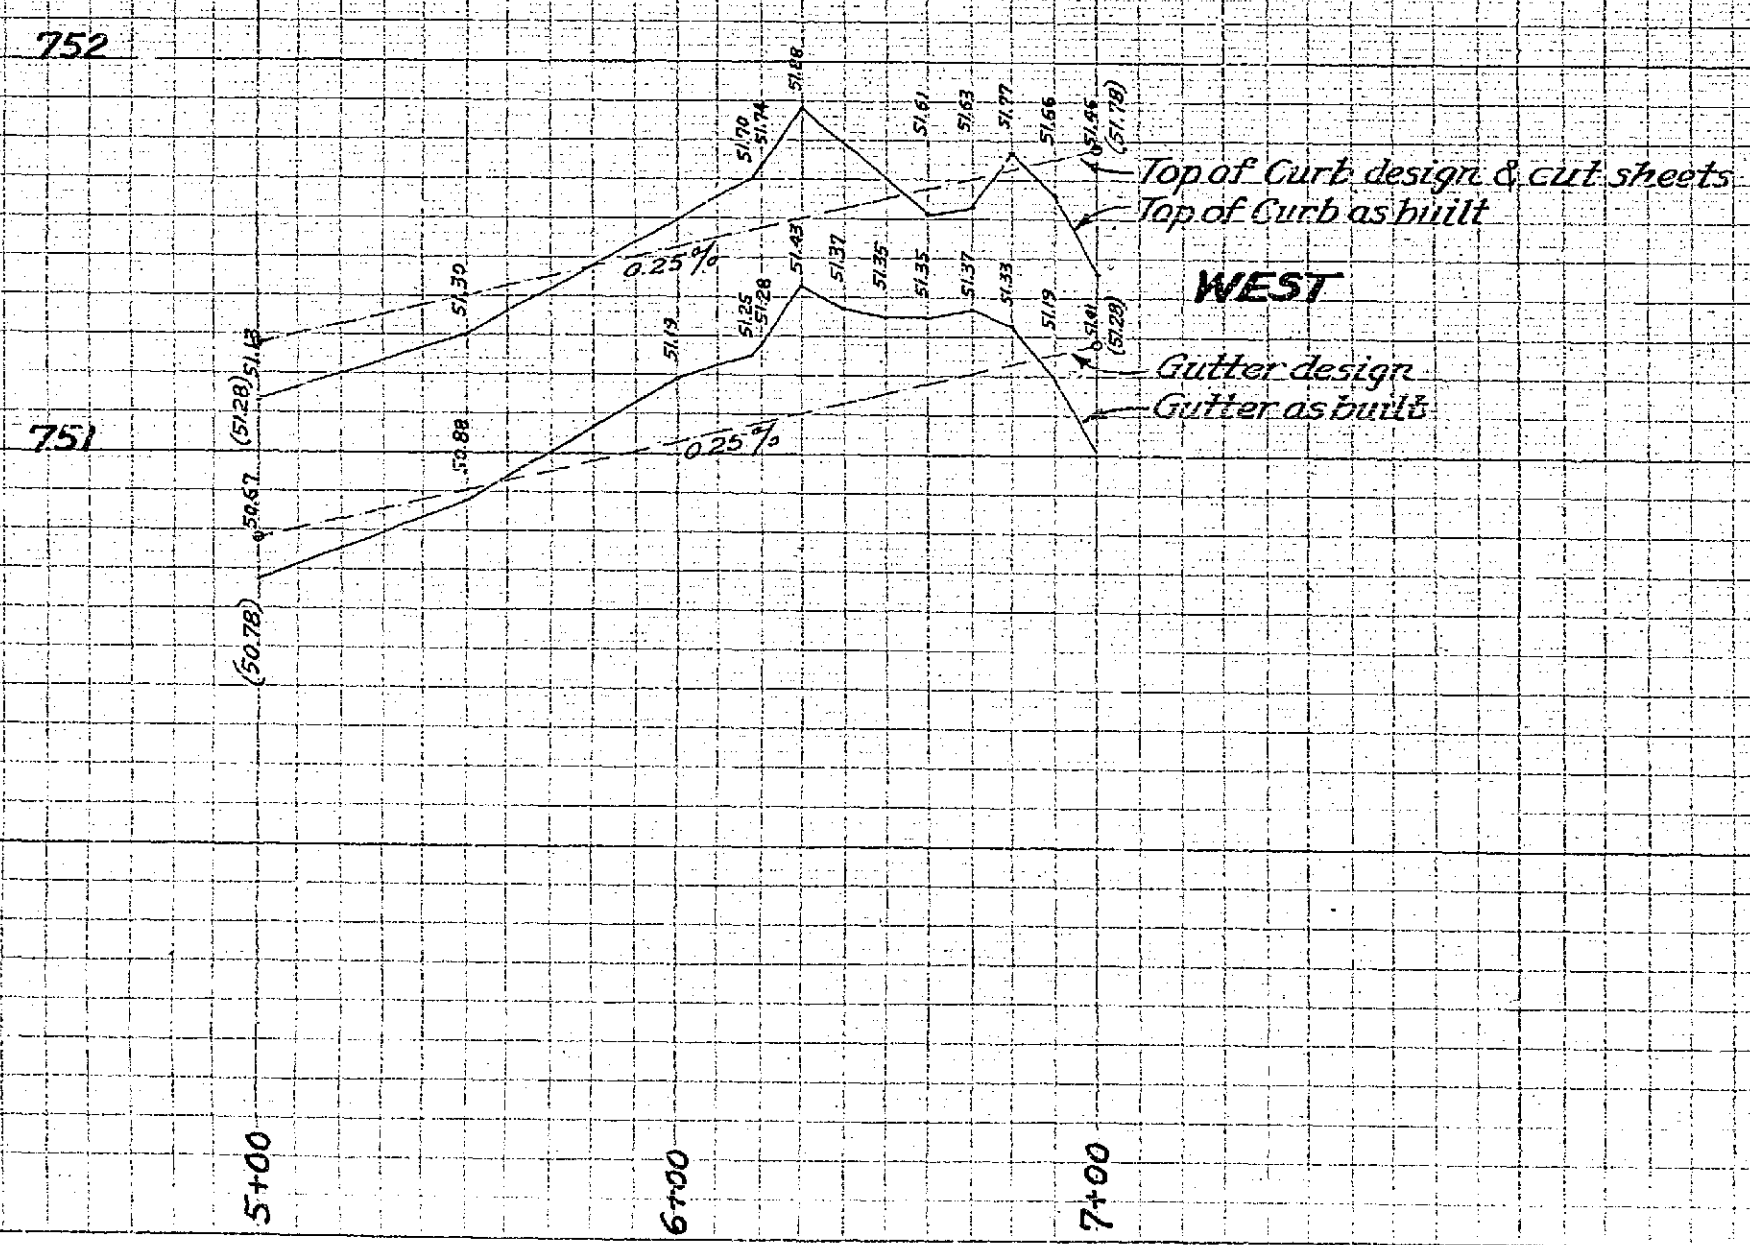

Scales: Hor 1"=40', Vert 1"=0.4'

F.B. 585/42.43

Reference - Dwg. #1516, Sheets 3&4

REVISIONS		CITY OF RIVERSIDE CALIFORNIA DEPARTMENT OF PUBLIC WORKS
MARK	DATE	
		"As Built" Curb & Gutter NESSEL STREET & WHEELER STREET 500 ft. to 700 ft. South of California Avenue
DESIGNED BY	CHECKED BY M.H.	APPROVED BY
DRAWN BY H.Ball		DIRECTOR OF PUBLIC WORKS
RECOMMENDED BY	ASSISTANT CITY ENGINEER	DATE

R-124

SHEET / OF

