


- NOTES:**
1. THIS PLAN IS FOR CONSTRUCTION OF MEDIAN CURBS AND MATCH-UP PAVING ONLY. SEE TYPICAL SECTION ON SHEET 2.
  2. REMOVE EXISTING SIDEWALKS BELONGING TO AREA OF MATCH-UP PAVING.
  3. REMOVE ANY EXISTING CURBS BETWEEN PROPOSED MEDIAN CURBS.
  4. ALL RASERS INVOLVED IN THIS PROJECT SHALL HAVE A MINIMUM 3" RADIUS OF 75'.
  5. THE LOCATION OF UTILITY SHAKES AND MANHOLES IN THIS SECTION IS REQUESTED TO TAKE FROM RECORD DRAWINGS TO LOCATE AND PROTECT ALL UTILITIES AND MANHOLES.
  6. GAPS BETWEEN CURBS IS SHOWN IN TYPICAL SECTION. GAPS BETWEEN CURBS SHALL BE 2" WIDER THAN GAPS BETWEEN SIDEWALKS.

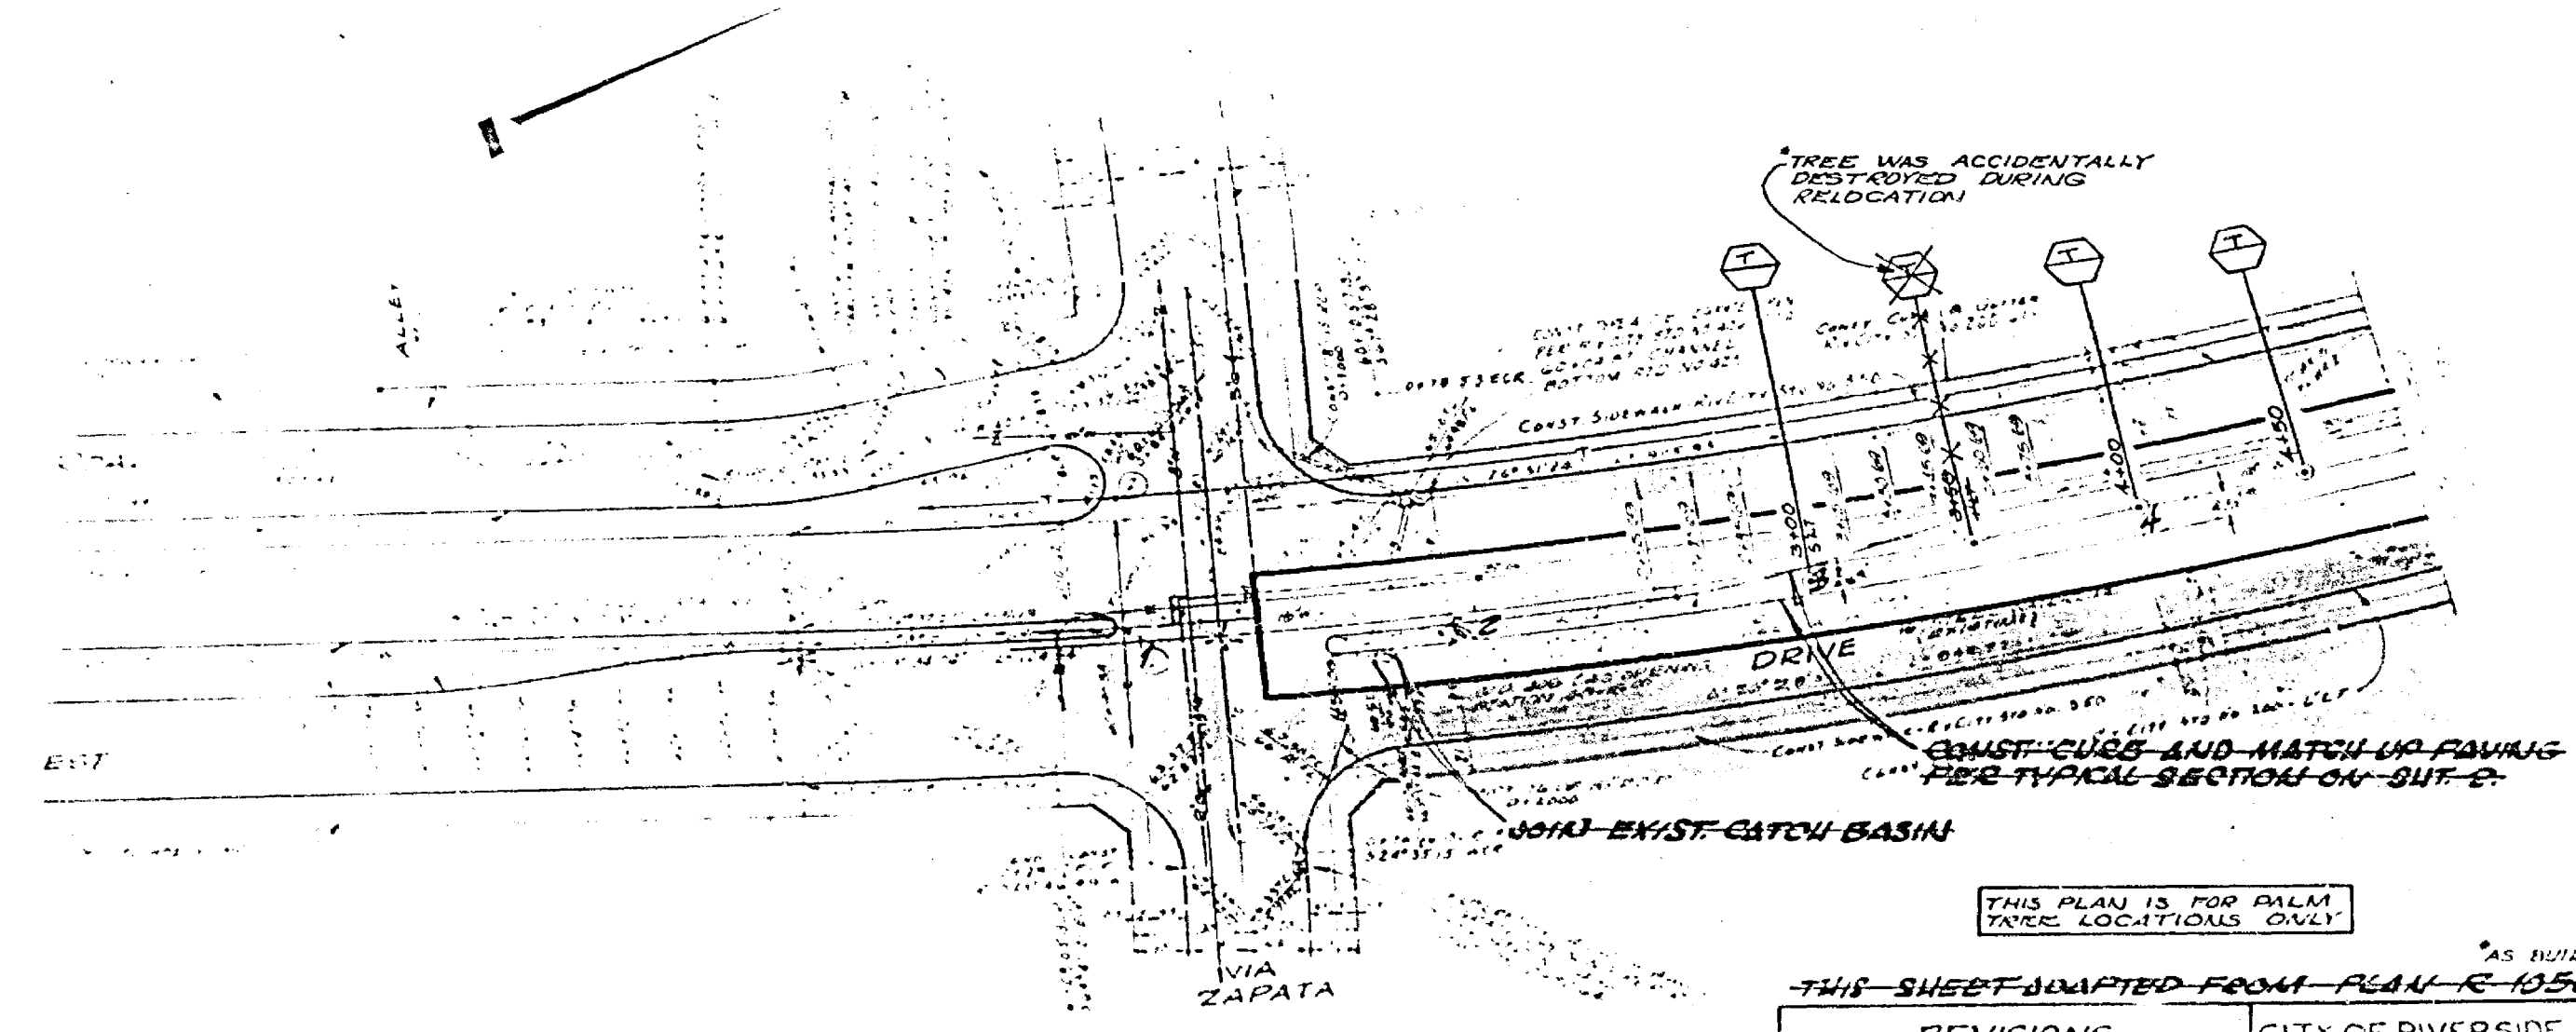

ADJACENT STAKING DATA


THIS PLAN IS FOR PALM TREE LOCATIONS ONLY

AS BUILT 4-11-77 JJK

THIS SHEET ADAPTED FROM PLAN R-1059

REVISIONS		CITY OF RIVERSIDE CALIFORNIA DEPARTMENT OF PUBLIC WORKS
NO.	DATE	
		TREE TRANSPLANTS FROM THIRD ST. WIDENING (R-1029) TO CANYON CREST DR. MEDIAN VIA ZAPATA TO EL CERRILLO

SCALE 1"=40'      WEST BAY 2"=40'

APPROVED BY: \_\_\_\_\_      NO. R-1024T

DIRECTOR OF PUBLIC WORKS      DATE: \_\_\_\_\_      SHEET 2 OF 2

