


PROFILE	NO.	DATE

**NOTES**

- The Contractor shall comply with all applicable portions of the City of Riverside Standard Specifications No. 461, including the requirements for insurance and bonds Sec. 1(1:16, 1:17)
- The Contractor shall be allowed 15 calendar days, after notice to begin is given by the City Engineer, to complete the project.
- Liquidated damages shall be in the amount of \$25.00 per day.
- Olivewood Avenue shall remain open to traffic at all times.
- Match up Asphalt Concrete paving shall require a prime coat & paint binder.

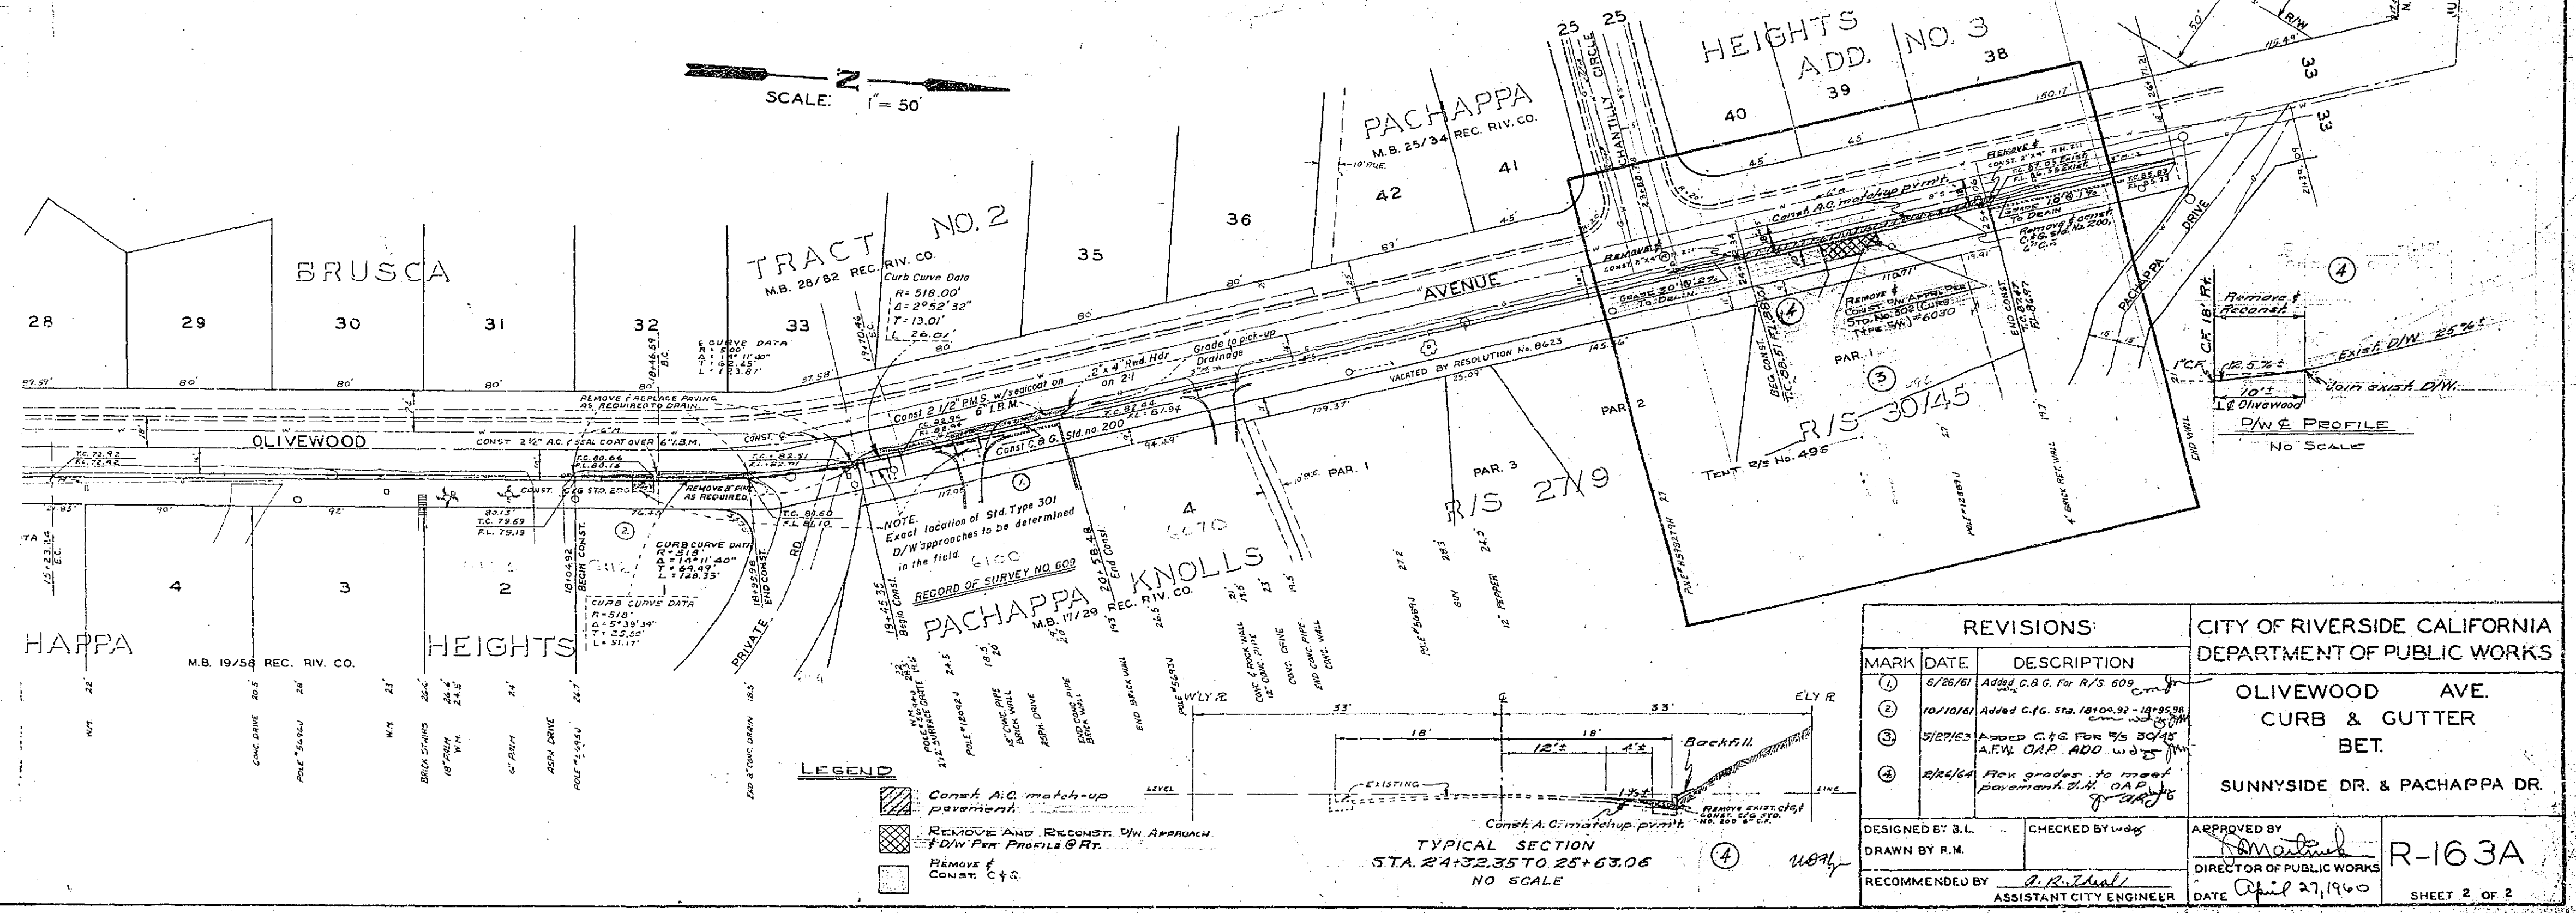

PLAN	NO.	DATE

REVISIONS		CITY OF RIVERSIDE CALIFORNIA DEPARTMENT OF PUBLIC WORKS
MARK	DATE	
1	8/26/40	Added C & G for R/S 809
2	10/10/40	Added C & G Sta. 19+00.31 - 19+35.38
3	5/27/41	Added C & G for 1/2 30' A.F.W. OAP ADD W/D'S
4	8/26/41	Rec. grades to meet pavement 2 1/2" OAP

DESIGNED BY S.L.      CHECKED BY W.B.G.      APPROVED BY *[Signature]*  
 DRAWN BY R.M.      ASSISTANT CITY ENGINEER      DIRECTOR OF PUBLIC WORKS  
 DATE: 8/27/40      R-163A

