

ASSESSMENT NO. 452  
DIAGRAM

EXHIBITING TENTH STREET IMPROVEMENT DISTRICT

IN THE CITY OF RIVERSIDE ON WHICH WORK HAS BEEN DONE UNDER THE OFFICIAL CONTRACT OF THE SUPERINTENDENT OF STREETS OF SAID CITY WITH CARL L. FREJD DATED JULY 7 1958 FOR THE CONSTRUCTION OF COMBINATION CURB AND GUTTER EASTERLY OF OTTAWA AVENUE AS IS MORE PARTICULARLY DESCRIBED IN SAID CONTRACT TO WHICH REFERENCE IS HEREBY MADE FOR FURTHER PARTICULARS SAID DIAGRAM ALSO SHOWS THE RELATIVE LOCATION OF EACH LOT PORTION OF LOT PIECE OR PARCEL OF LAND ASSESSED FOR THE WORK DONE NUMBERED IN CIRCLES TO CORRESPOND TO THE RED INK NUMBERS IN THE ASSESSMENT. HEREIN FIGURES NEXT TO PROPERTY LINES SHOW LENGTH OF SAID LINES IN FEET. THE MARK (') MEANS FEET. PROPERTY LINES THAT DIFFER FROM THE RECORDED SUBDIVISIONS ARE SHOWN BY BROKEN LINES. THE DISTRICT BENEFITED IS BOUNDED BY A HEAVY DASHED LINE. THE PROPERTY COVERED BY THIS ASSESSMENT IS SHOWN ON THE FOLLOWING RECORDED MAPS:  
FRANKLIN SQUARE M.B. 6/31 REC. S.B. CO.

HEREIN THE LEGEND OF THE DIFFERENT KINDS OF WORK PERFORMED IS SHOWN AS FOLLOWS:  
COMBINATION CURB AND GUTTER  
REMOVE AND REPLACE WALK

— (Symbol for Combination Curb and Gutter)  
- - - (Symbol for Remove and Replace Walk)

CITY ENGINEER OF THE CITY OF RIVERSIDE  
THE FOLLOWING IS A STATEMENT OF AMOUNTS OF DIFFERENT KINDS OF WORK DONE BY CARL L. FREJD UNDER CONTRACT DATED JULY 7 1958 PURSUANT TO RESOLUTION OF INTENTION NO. 8155 ADOPTED BY THE CITY COUNCIL OF THE CITY OF RIVERSIDE ON THE FIRST DAY OF APRIL 1958  
1169.88 L.F. 6" C.F. COMBINATION CURB AND GUTTER  
L.S. REMOVE AND REPLACE WALK

AT SAID CITY OF RIVERSIDE THIS 6TH DAY OF SEPTEMBER 1958

*William B. Hill*  
STREET SUPERINTENDENT  
OF THE CITY OF RIVERSIDE

I HEREBY CERTIFY THAT THE ABOVE WORK WAS DONE IN ACCORDANCE WITH LINES AND GRADES FURNISHED BY ME AND THAT THE DIAGRAM OF THE ASSESSMENT DISTRICT FOR THE SAME IS CORRECT.  
*Edward J. Fisher*  
CITY ENGINEER  
OF THE CITY OF RIVERSIDE

RECORDED AT 4:50 O'CLOCK P.M.  
THIS 16TH DAY OF DECEMBER 1958

*William B. Hill*  
SUPERINTENDENT OF STREETS  
OF THE CITY OF RIVERSIDE

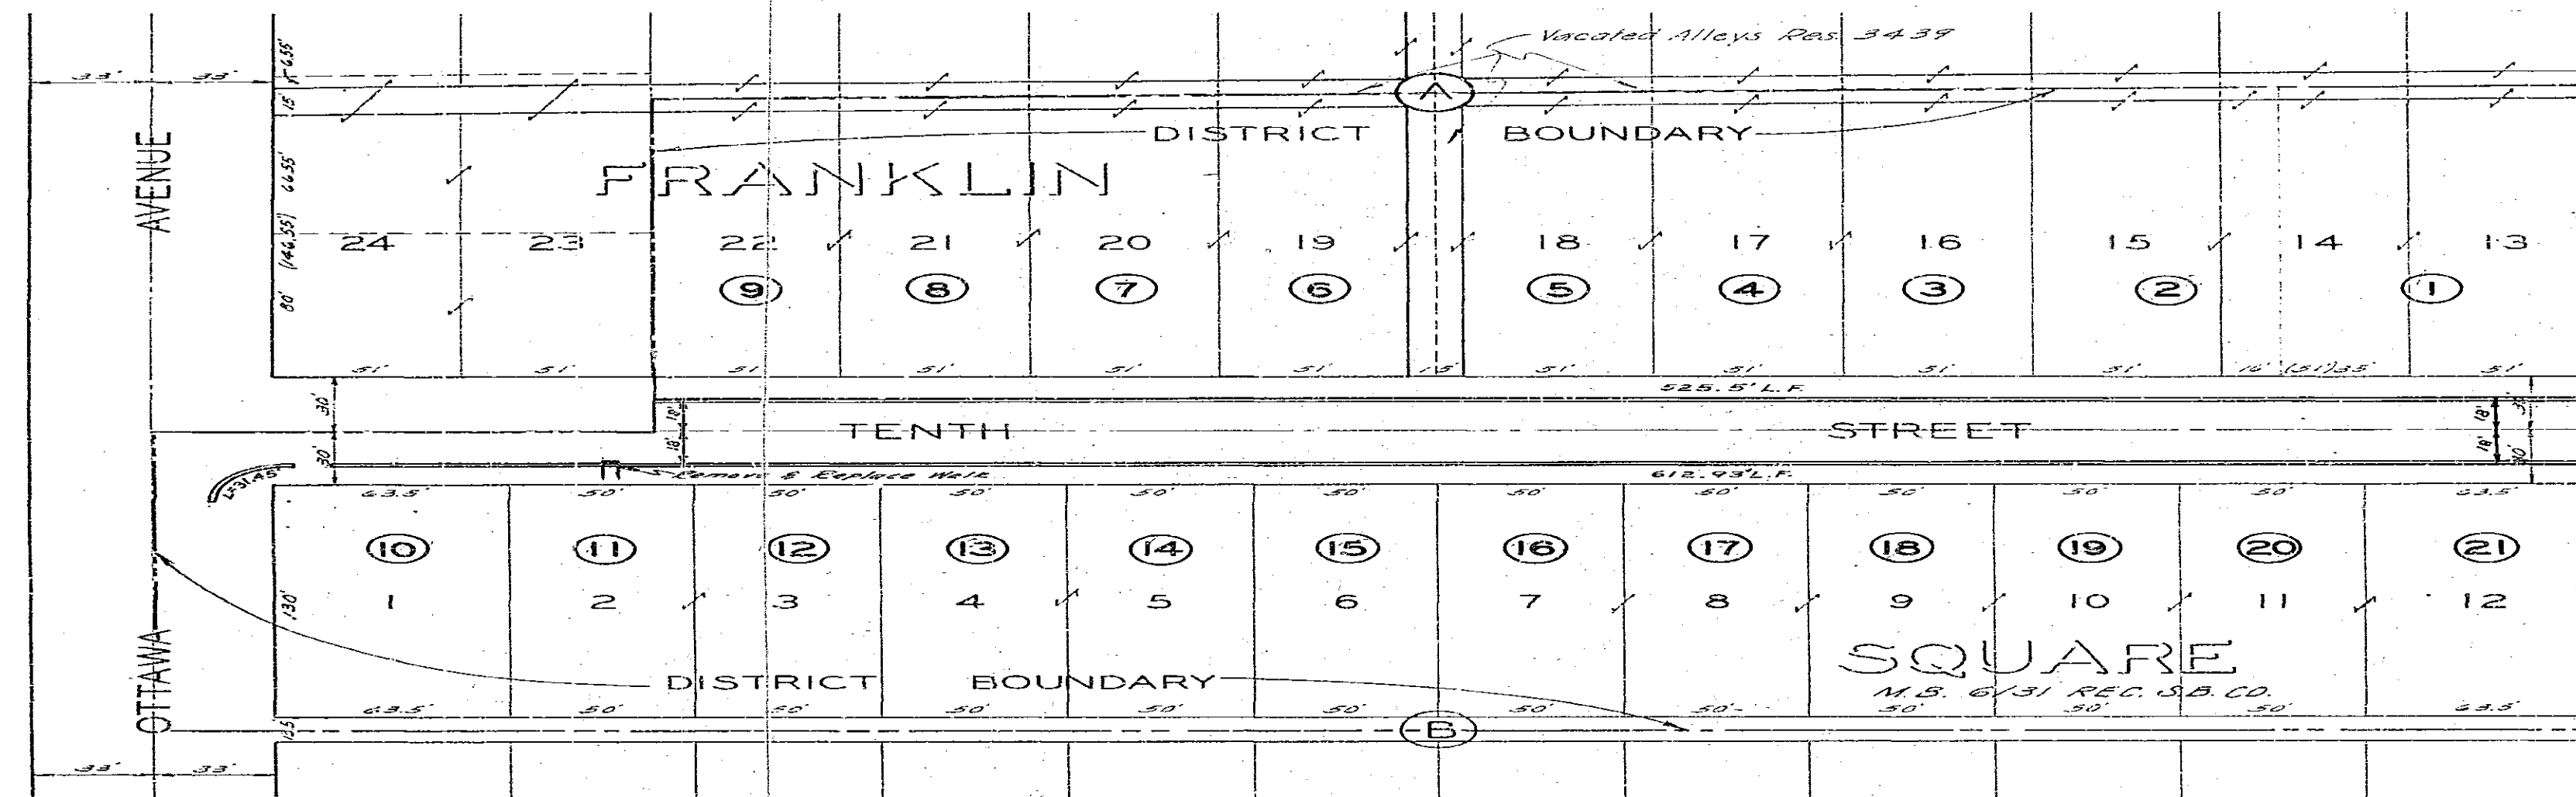


DIAGRAM  
OF THE PROPERTY AFFECTED OR BENEFITED  
BY THE WORK IN THE  
TENTH STREET IMPROVEMENT DISTRICT

CITY OF RIVERSIDE CALIFORNIA DEPARTMENT OF PUBLIC WORKS	
TENTH STREET IMPROVEMENT DISTRICT ELY. OF OTTAWA AVE.	
APPROVED BY <i>[Signature]</i> DIRECTOR OF PUBLIC WORKS	R-174-B
DATE <i>March 12, 1918</i>	SHEET 1 OF 1