


GENERAL NOTES

- CONSTRUCTION SHALL BE IN ACCORDANCE WITH THE CITY OF RIVERSIDE DEPARTMENT OF PUBLIC WORKS, STANDARD DRAWINGS, AND THE STANDARD SPECIFICATIONS FOR PUBLIC WORKS CONSTRUCTION, 1982 EDITION.
- THE FOLLOWING STD. DRAWINGS APPLY:
 - 200 CONSTRUCT CURB AND GUTTER PER STANDARD DRAWING NO. 200, 6" C.F.
 - 302 CONSTRUCT DRIVEWAY APPROACHES AS PER STANDARD DRAWING NO. 302 A&B AS NOTED
 - 304 CONSTRUCT WHEELCHAIR RAMPS AS PER STANDARD DRAWING NO. 304
 - 325 CONSTRUCT SIDEWALK AS PER STANDARD DRAWING NO. 325. NO GRADING TO BE DONE OUTSIDE OF STREET RIGHT OF WAY.
- REMOVE ALL JUNIPERS AND CACTUS IN THE AREA OF CONSTRUCTION.
- REMOVE AND REPLACE CURB & GUTTER WHERE DAMAGED BY TREE ROOTS BETWEEN STATION 8+00 AND MONTGOMERY STREET.

TREE PLANTING NOTES

- All related work shall conform to the City of Riverside, Park and Recreation Department Standards.
- Contact the Park Projects Inspector a minimum of 48 hours in advance at 787-7223 to schedule inspections. Inspections shall be required:
 - when plant locations have been spotted in the field prior to digging plant pits,
 - while digging plant pits and planting/relocating trees,
 - after planting and all other indicated or specified work has been completed for start of maintenance, and
 - at end of maintenance/final acceptance (contractor/developer will be released from maintenance only upon receipt of written notification from the city that the Park and Recreation Department is assuming maintenance responsibilities).
- The Contractor/Developer shall maintain all plantings for a minimum period of one (1) year.
- Street Tree planting shall be as follows:

Street Name	Botanical Name/Common Name	Min. Size	Approx. Spacing	No. Req.
TREY AVENUE	PRUNUS CERASIFERA / RED LEAF	15 GAL.	45'-50'	15
	MAHAITA URSUINUS / PLUM			

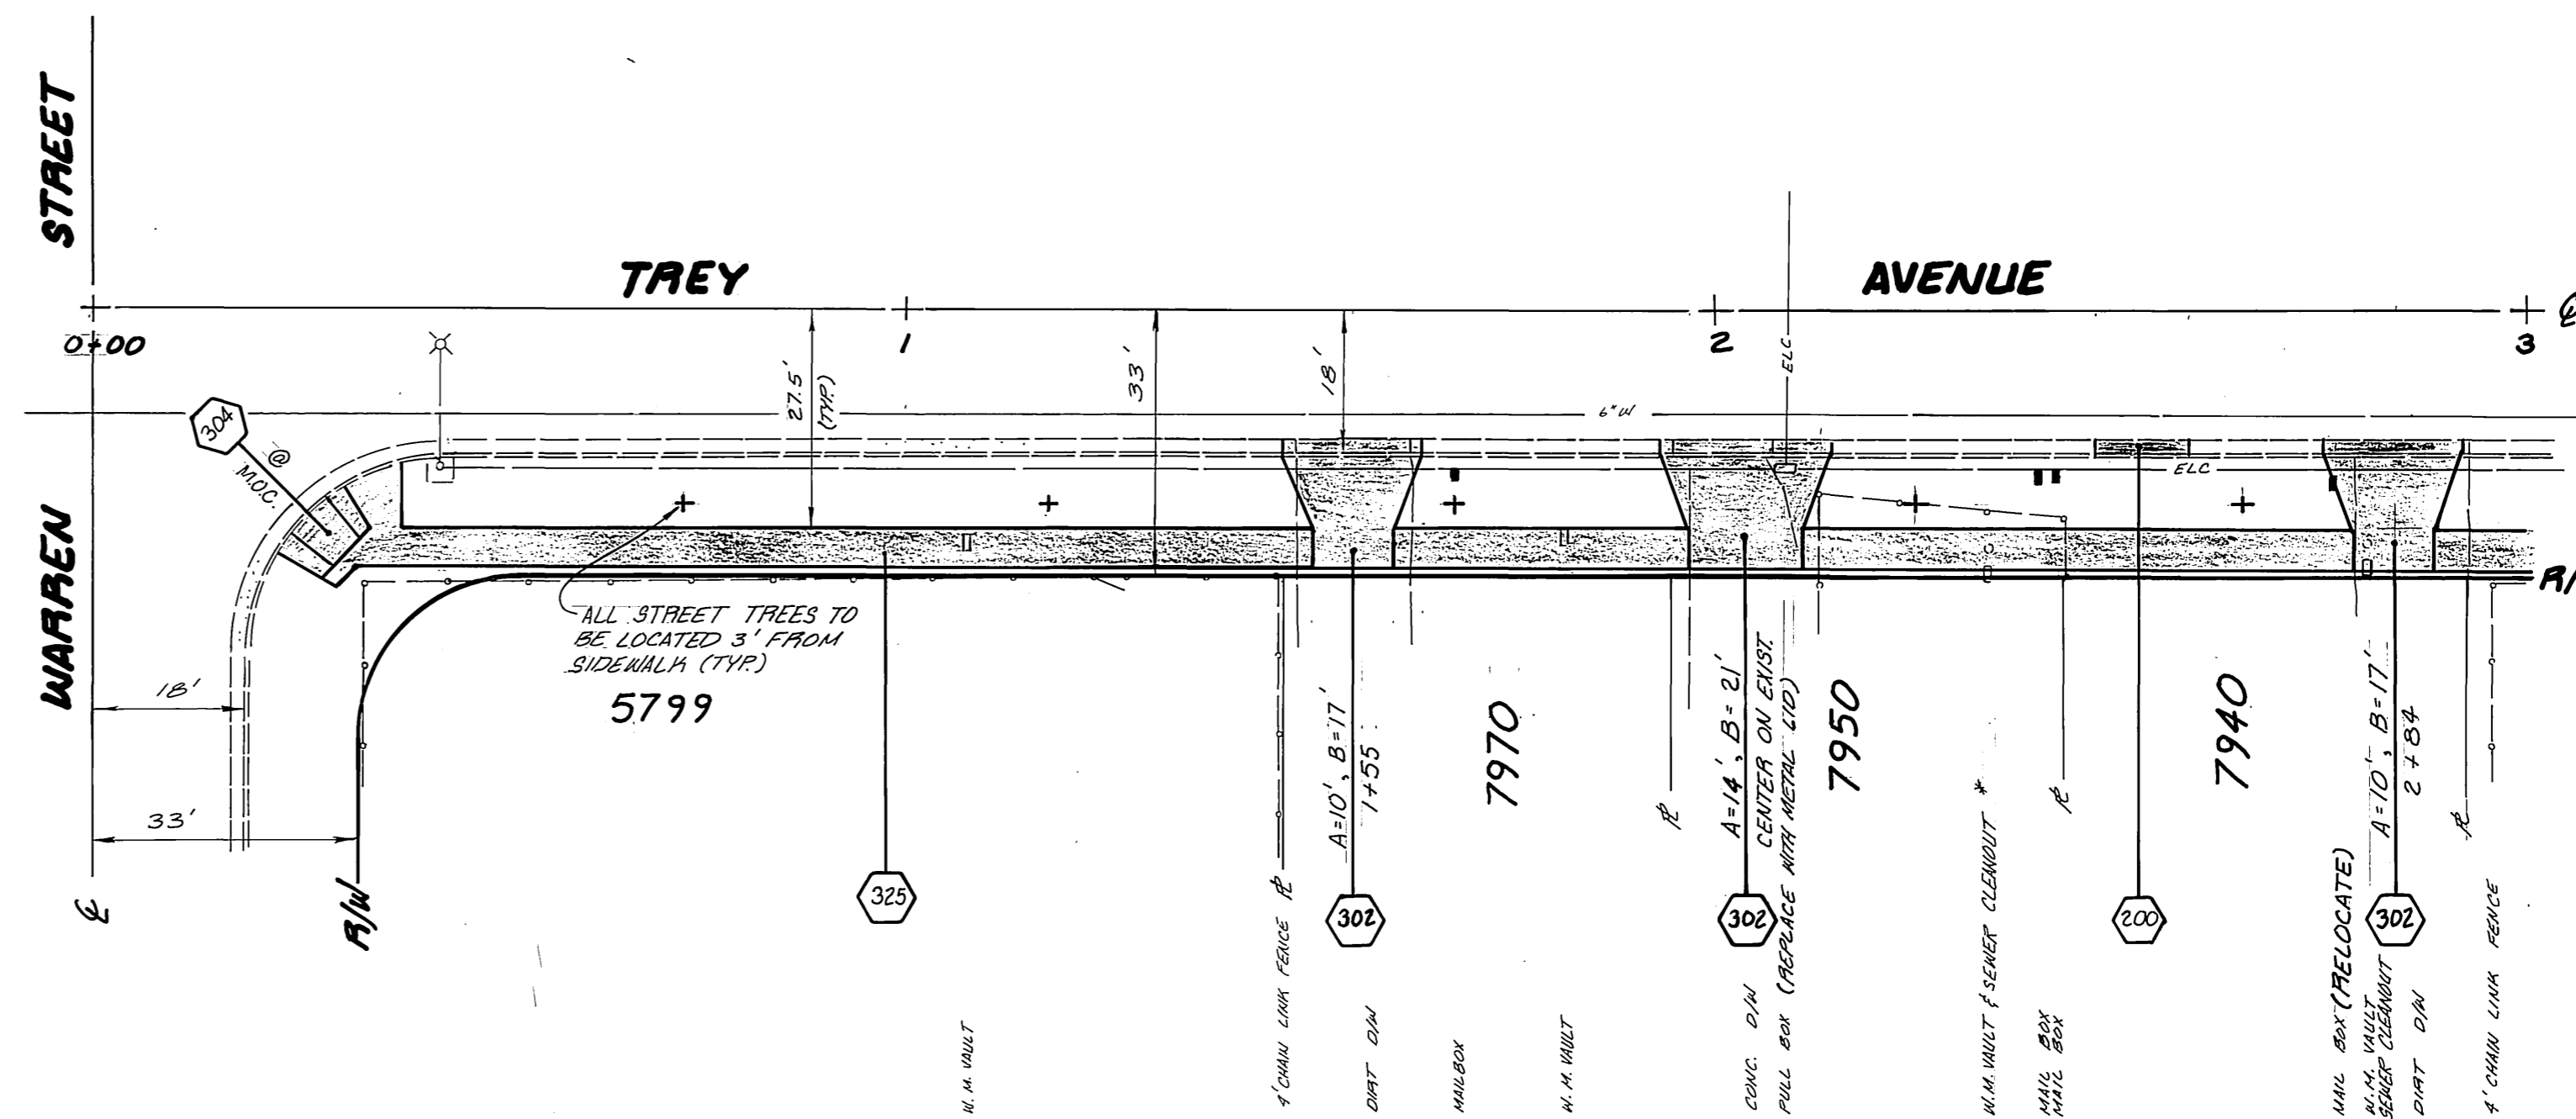

* As built 9-6-85 76

CITY OF RIVERSIDE PUBLIC WORKS DEPARTMENT		TREY AVENUE SIDEWALK (HUD FUNDED)		ACCOUNT NO. 15-550-559-2 R-2668
APPROVED BY PRINCIPAL ENGINEER PARK DEPARTMENT TRAFFIC DIVISION CHIEF P. W. ENGINEER	DATE 3/15/85	APPROVED BY PUBLIC WORKS DIRECTOR	DATE 3/19/85	SHEET 1 OF 1
DESIGNED BY: <i>blm</i> DRAWN BY: <i>js</i> CHECKED BY:		HORIZ. SCALE: 1" = 20' VERT. SCALE: 1" =		