



Monroe St. Br. No. 15.3 Revised 11/22/94
Anchor. Pla. Layout Diagram Using \pm Track as baseline.

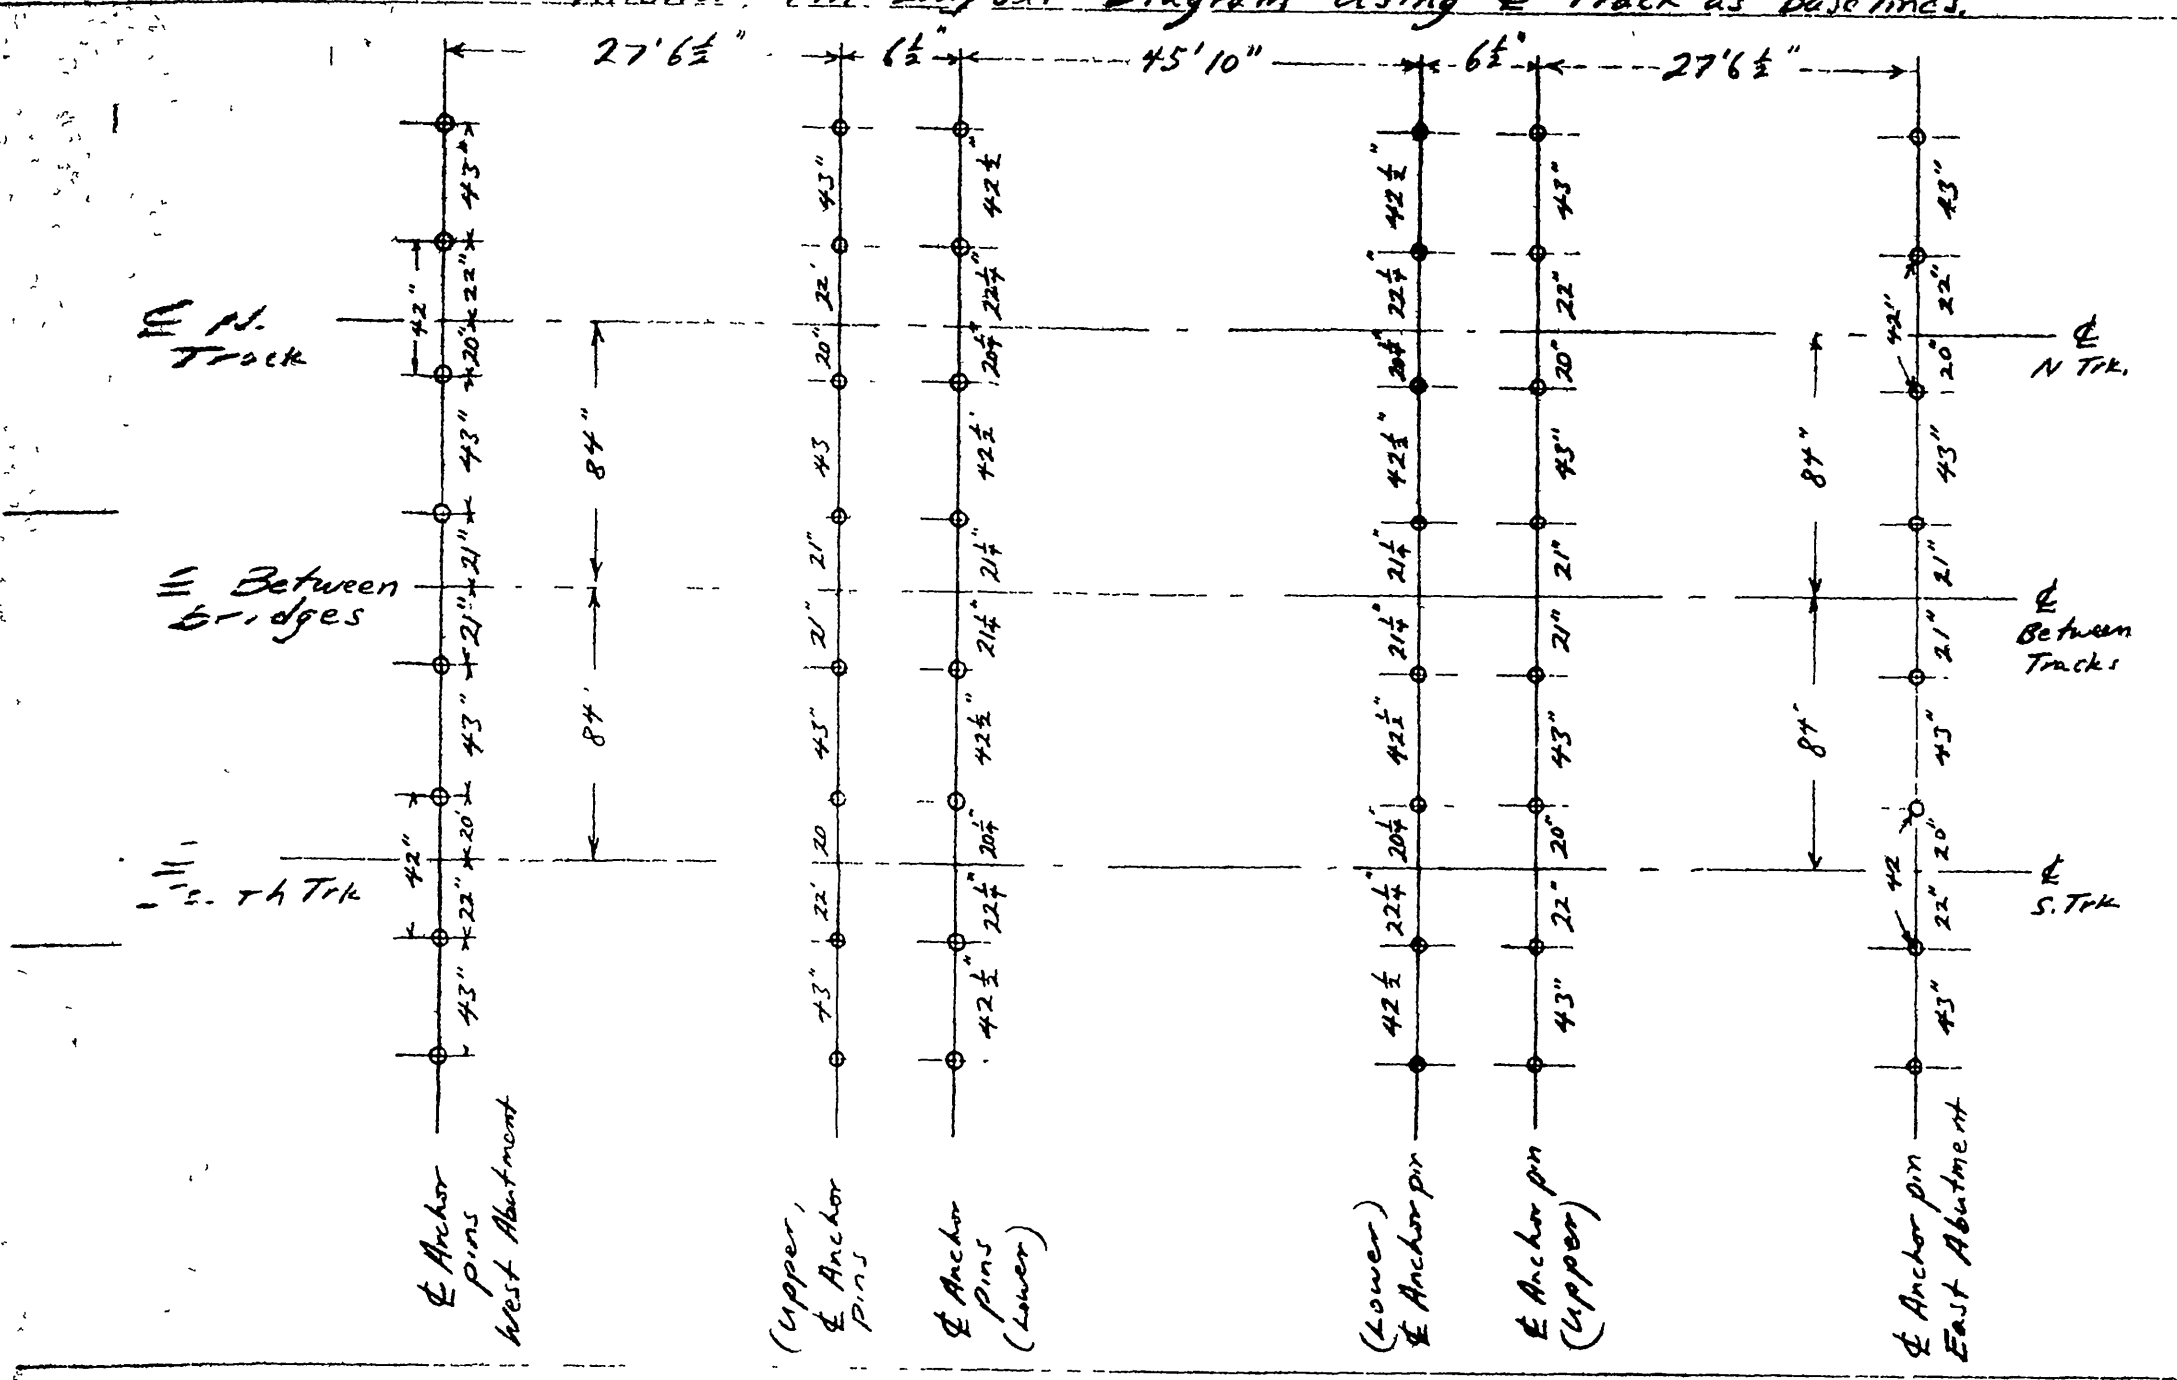

Note: centerline of piles is not the same as centerline of the cap. See plans.

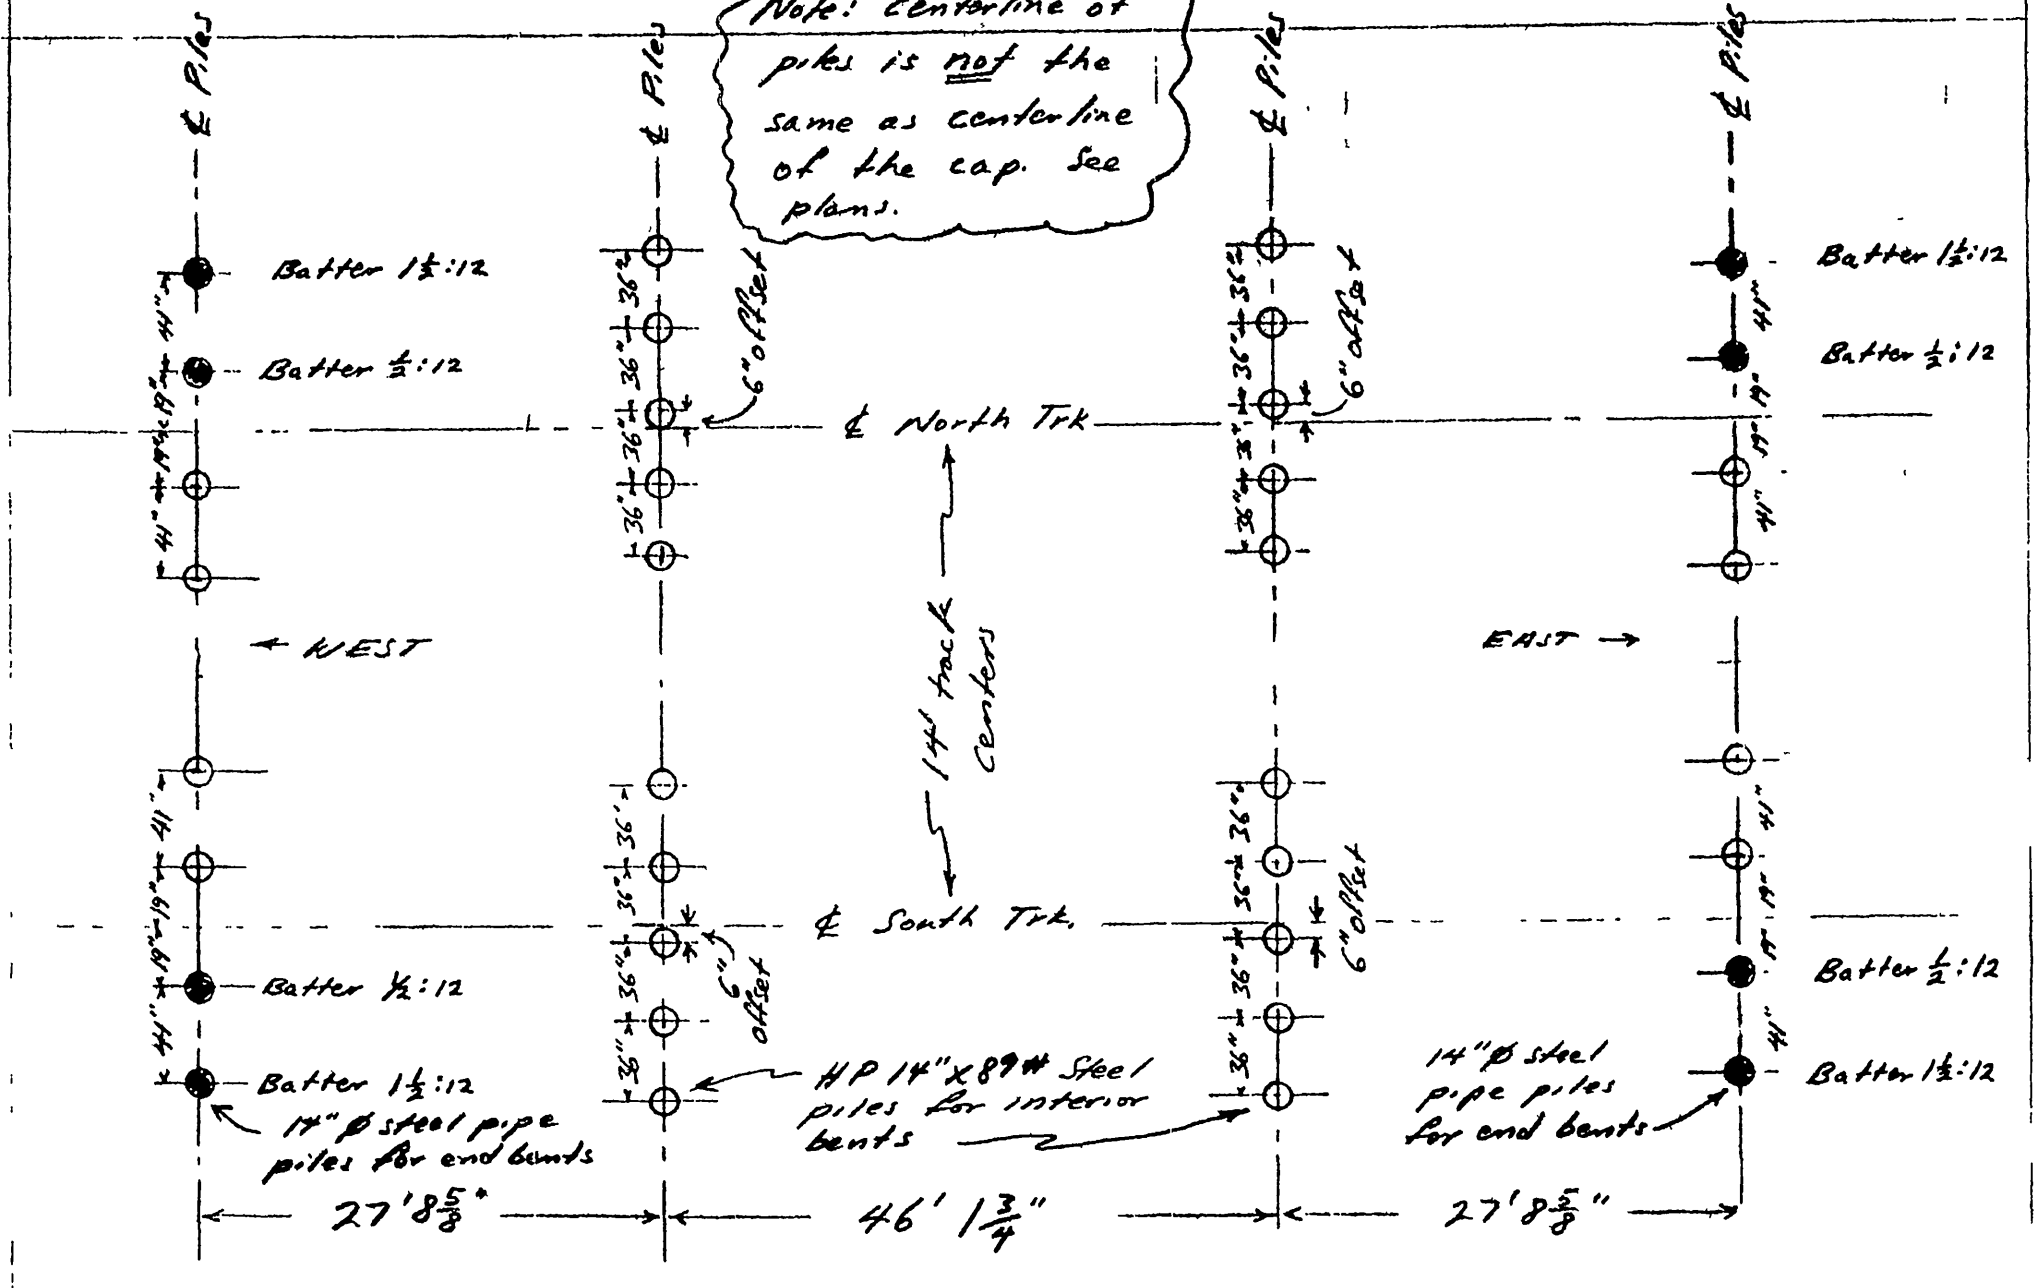

Schematic for pile layout (@ cutoff elevation) Revised 10/20/94


walkway	walkway	walkway
PB 27.83-W	46'2" B.E.S. 2082 curb & walkway	PB 27.83-W
PB 27.83-C	46'2" B.E.S. 2082	PB 27.83-C
PB 27.83-C	46'2" B.E.S. 2082 curb	PB 27.83-C
PB 27.83-W	46'2" B.E.S. 2082	PB 27.83-W
walkway	walkway	walkway

Monroe St. Br. No. 15.3 - Beam layout schematic
1/6 scale Revised 10/20/94 11/22/94

Note: All beams to be recessed to accommodate waterproof membrane materials and steel deck plates. See attached detail sheets.



AS BUILT DRAWINGS

Monroe St. Br. No. 15.3 - RECESS DETAIL Revised 11/22/93

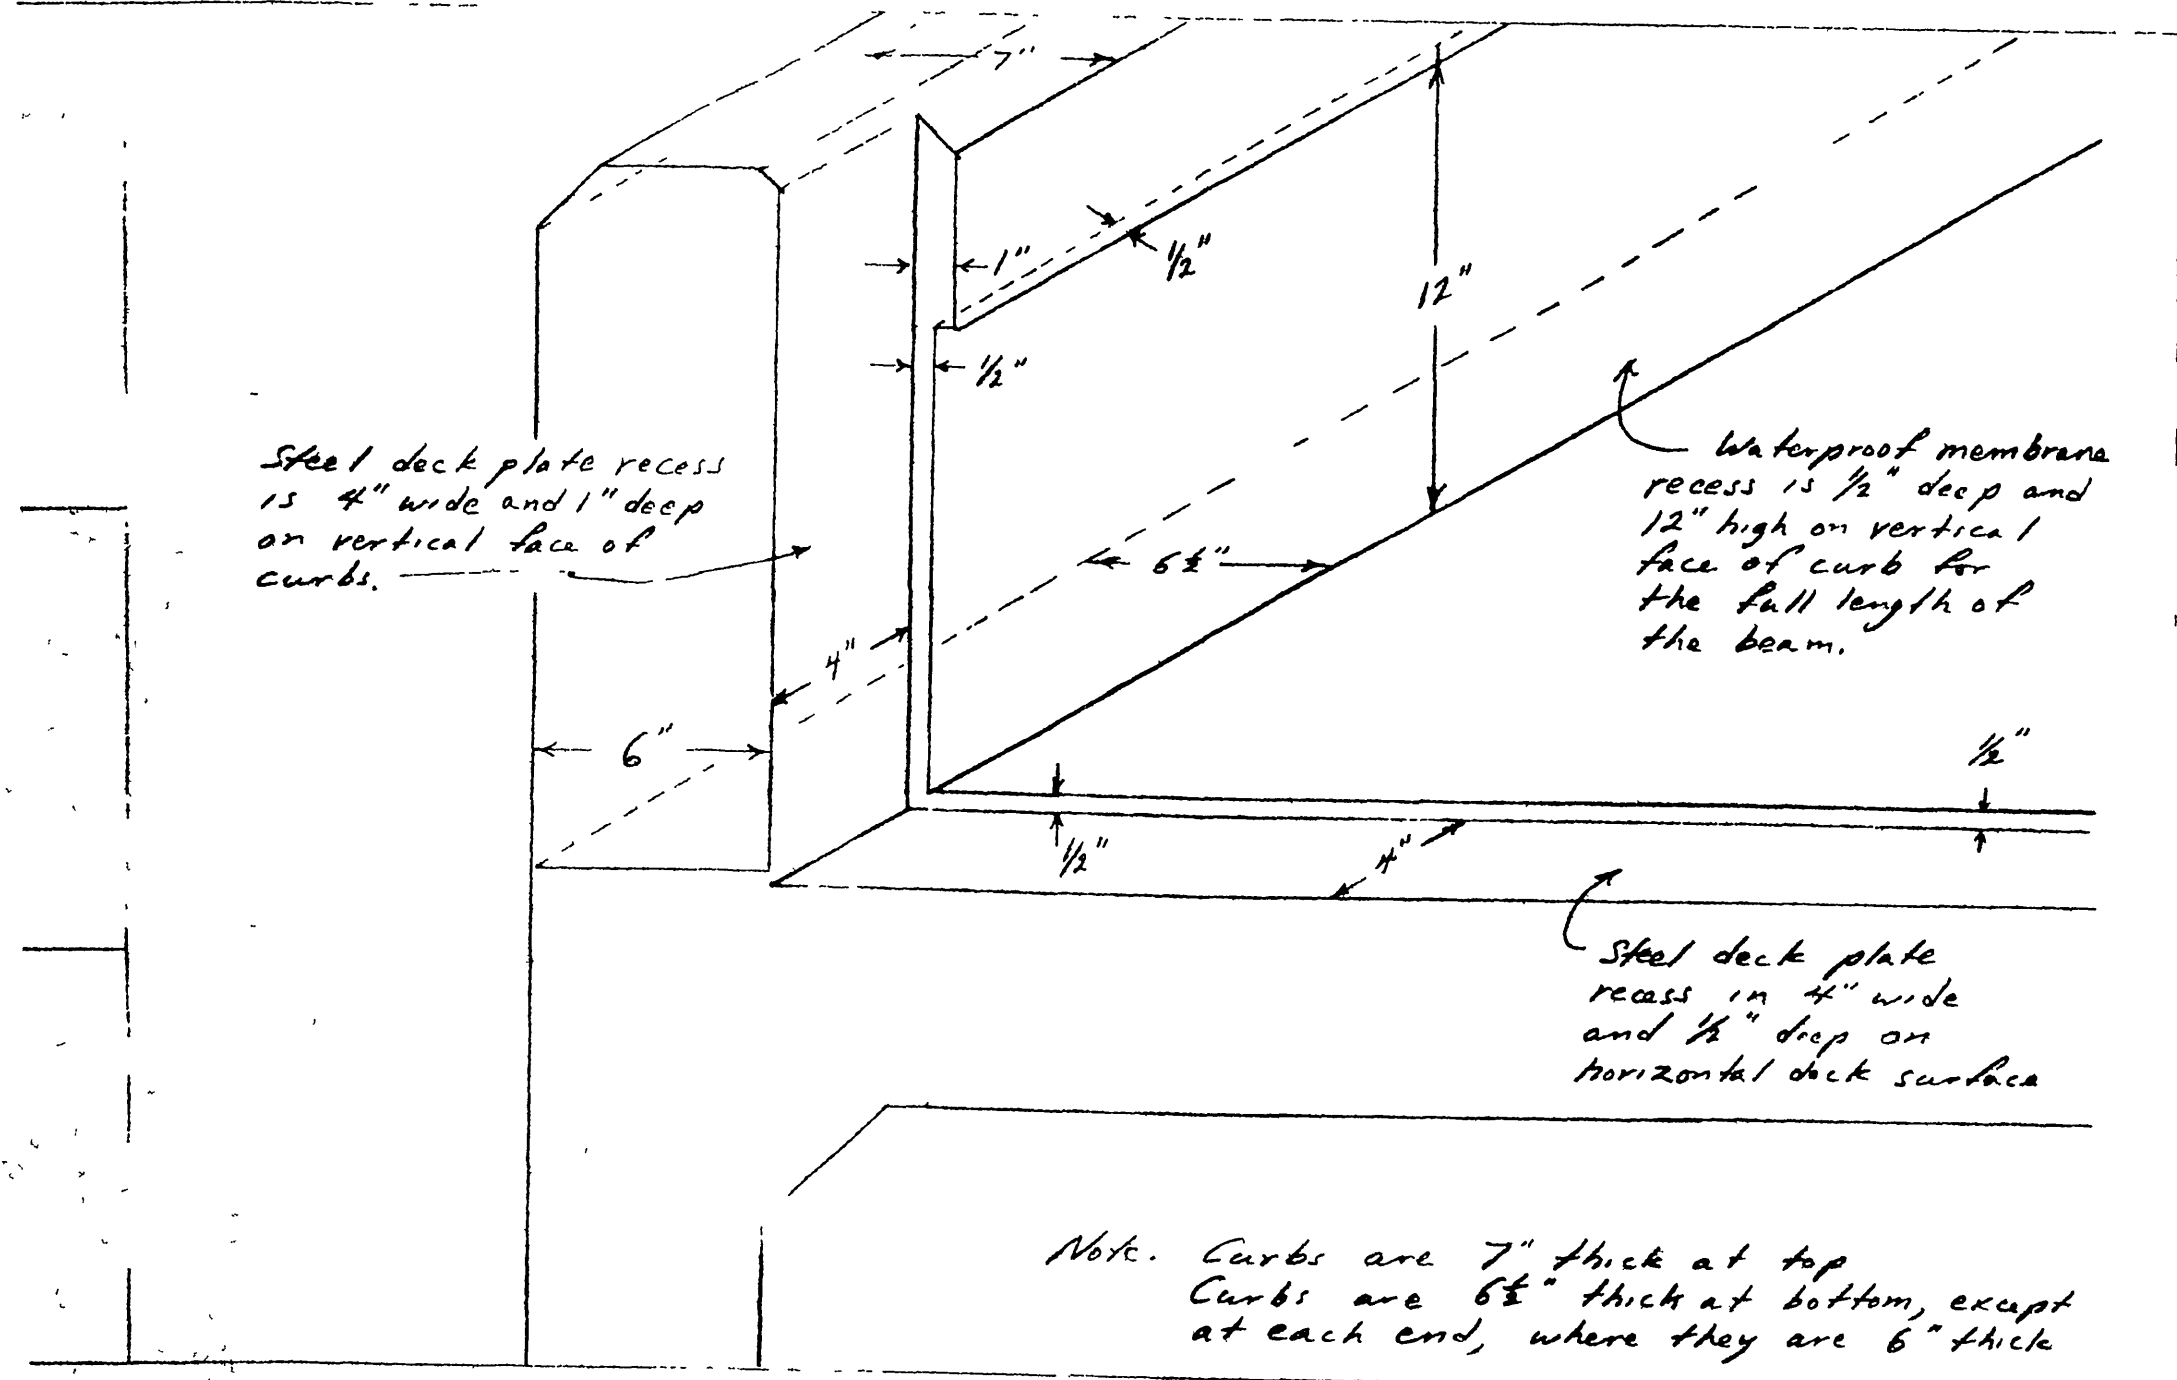

Note: Curbs are 7" thick at top. Curbs are 6" thick at bottom, except at each end, where they are 6" thick.

Monroe St. Br. No. 15.3 - Recess for deck plates & waterproofing Revised 10/20/94 11/22/94

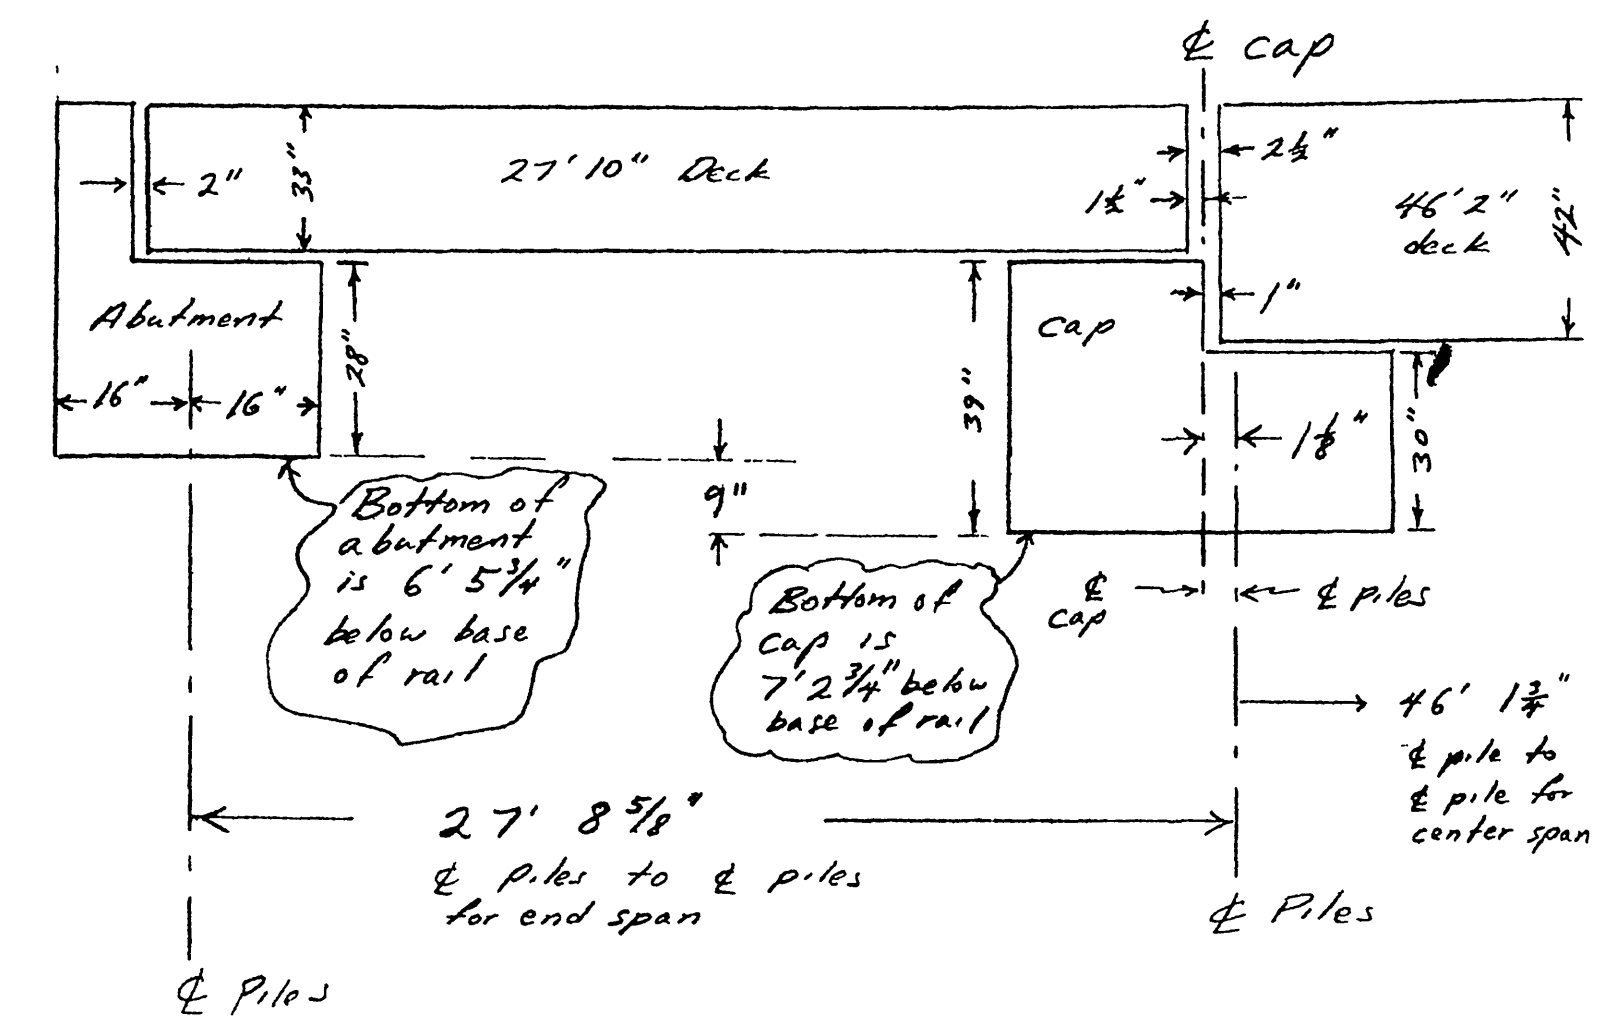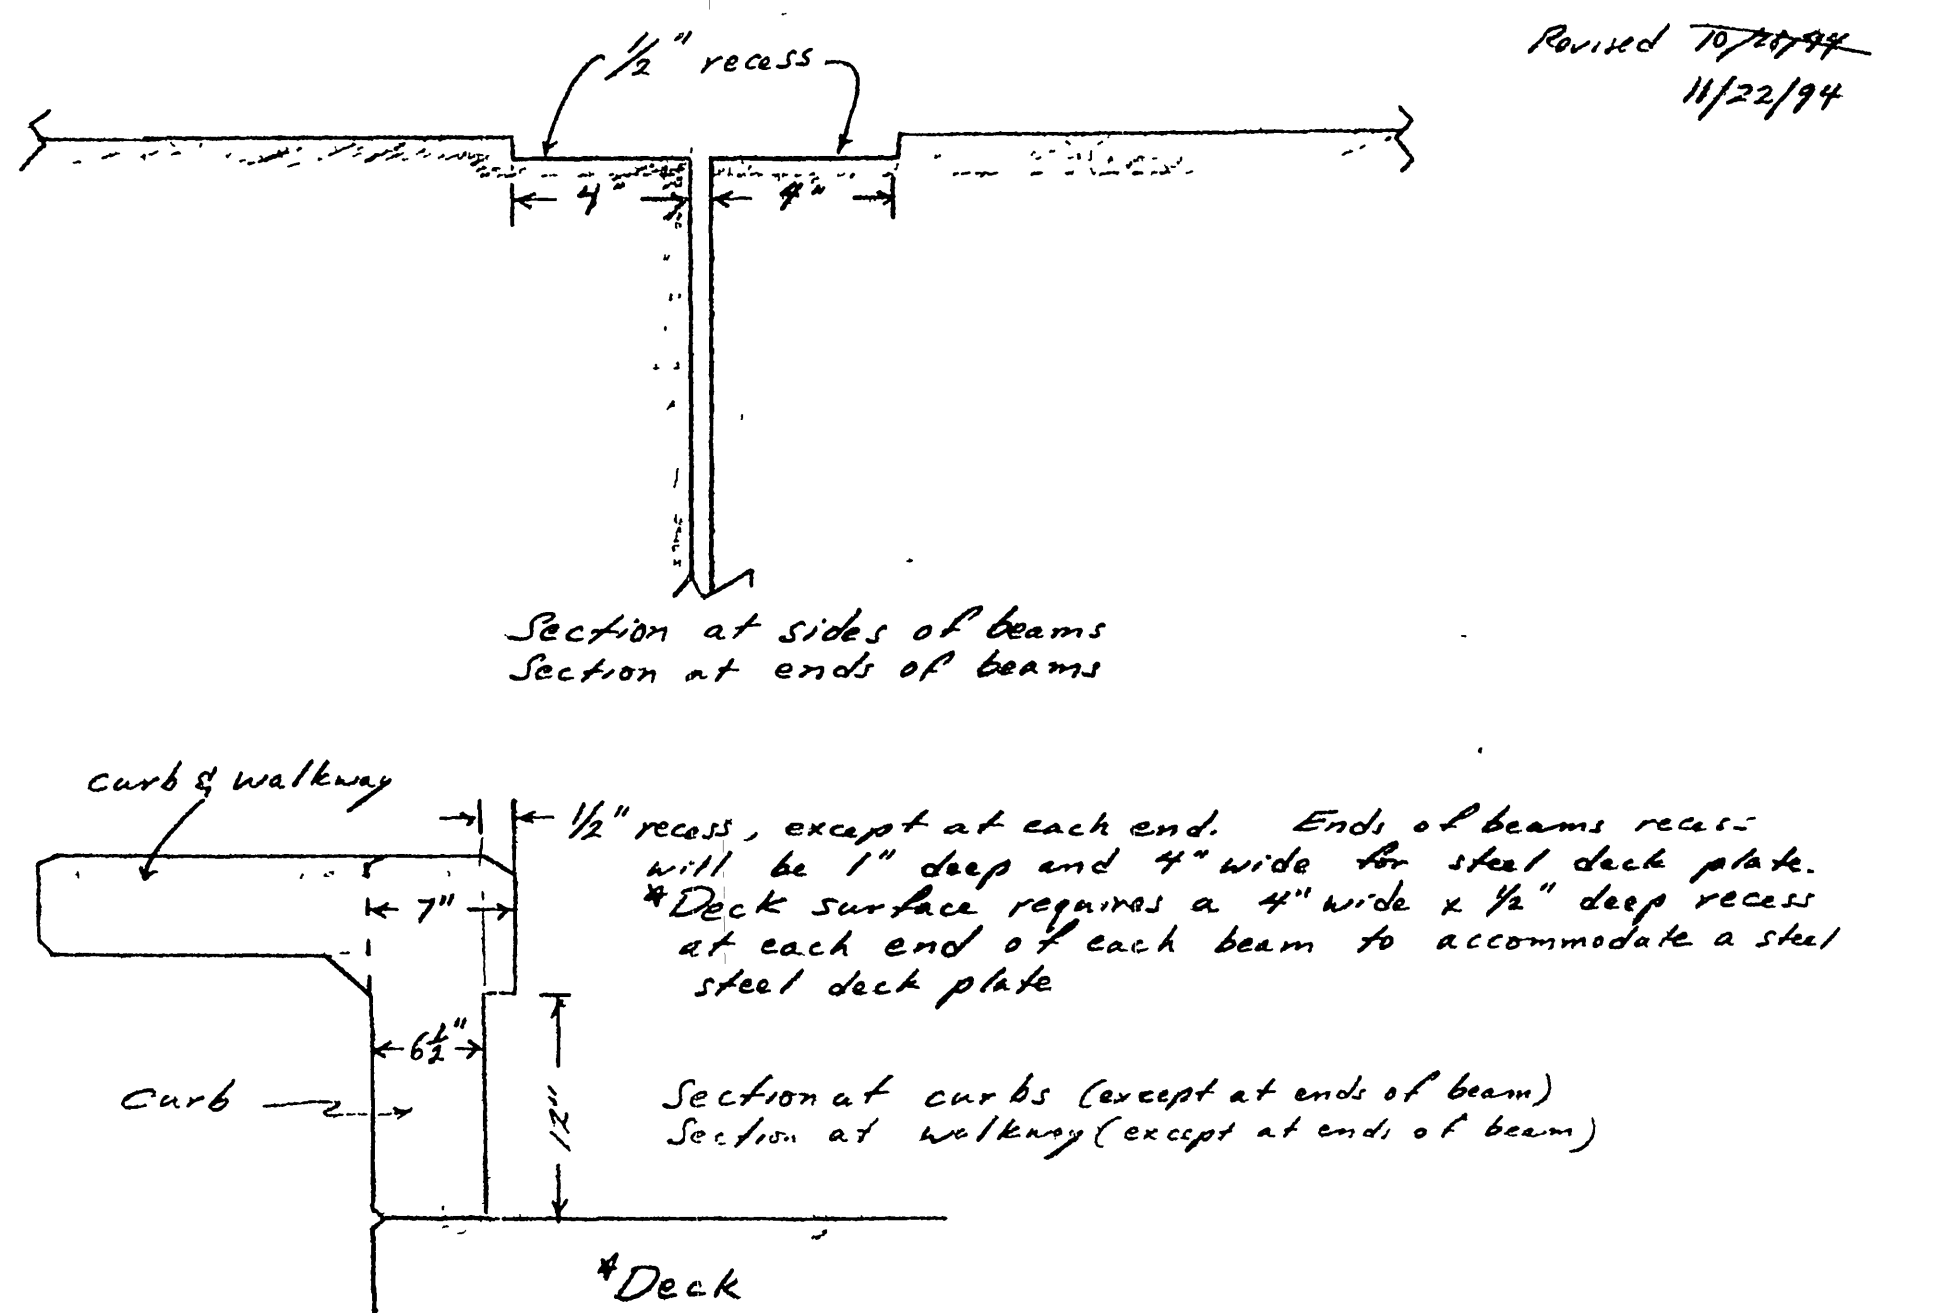

Schematic of bent layout Monroe St. Br. No. 15.3 Revised 10/20/94

MONROE STREET AT A.T. & S.F.

R-3594

INDEXED 8-8-2000 LFT