

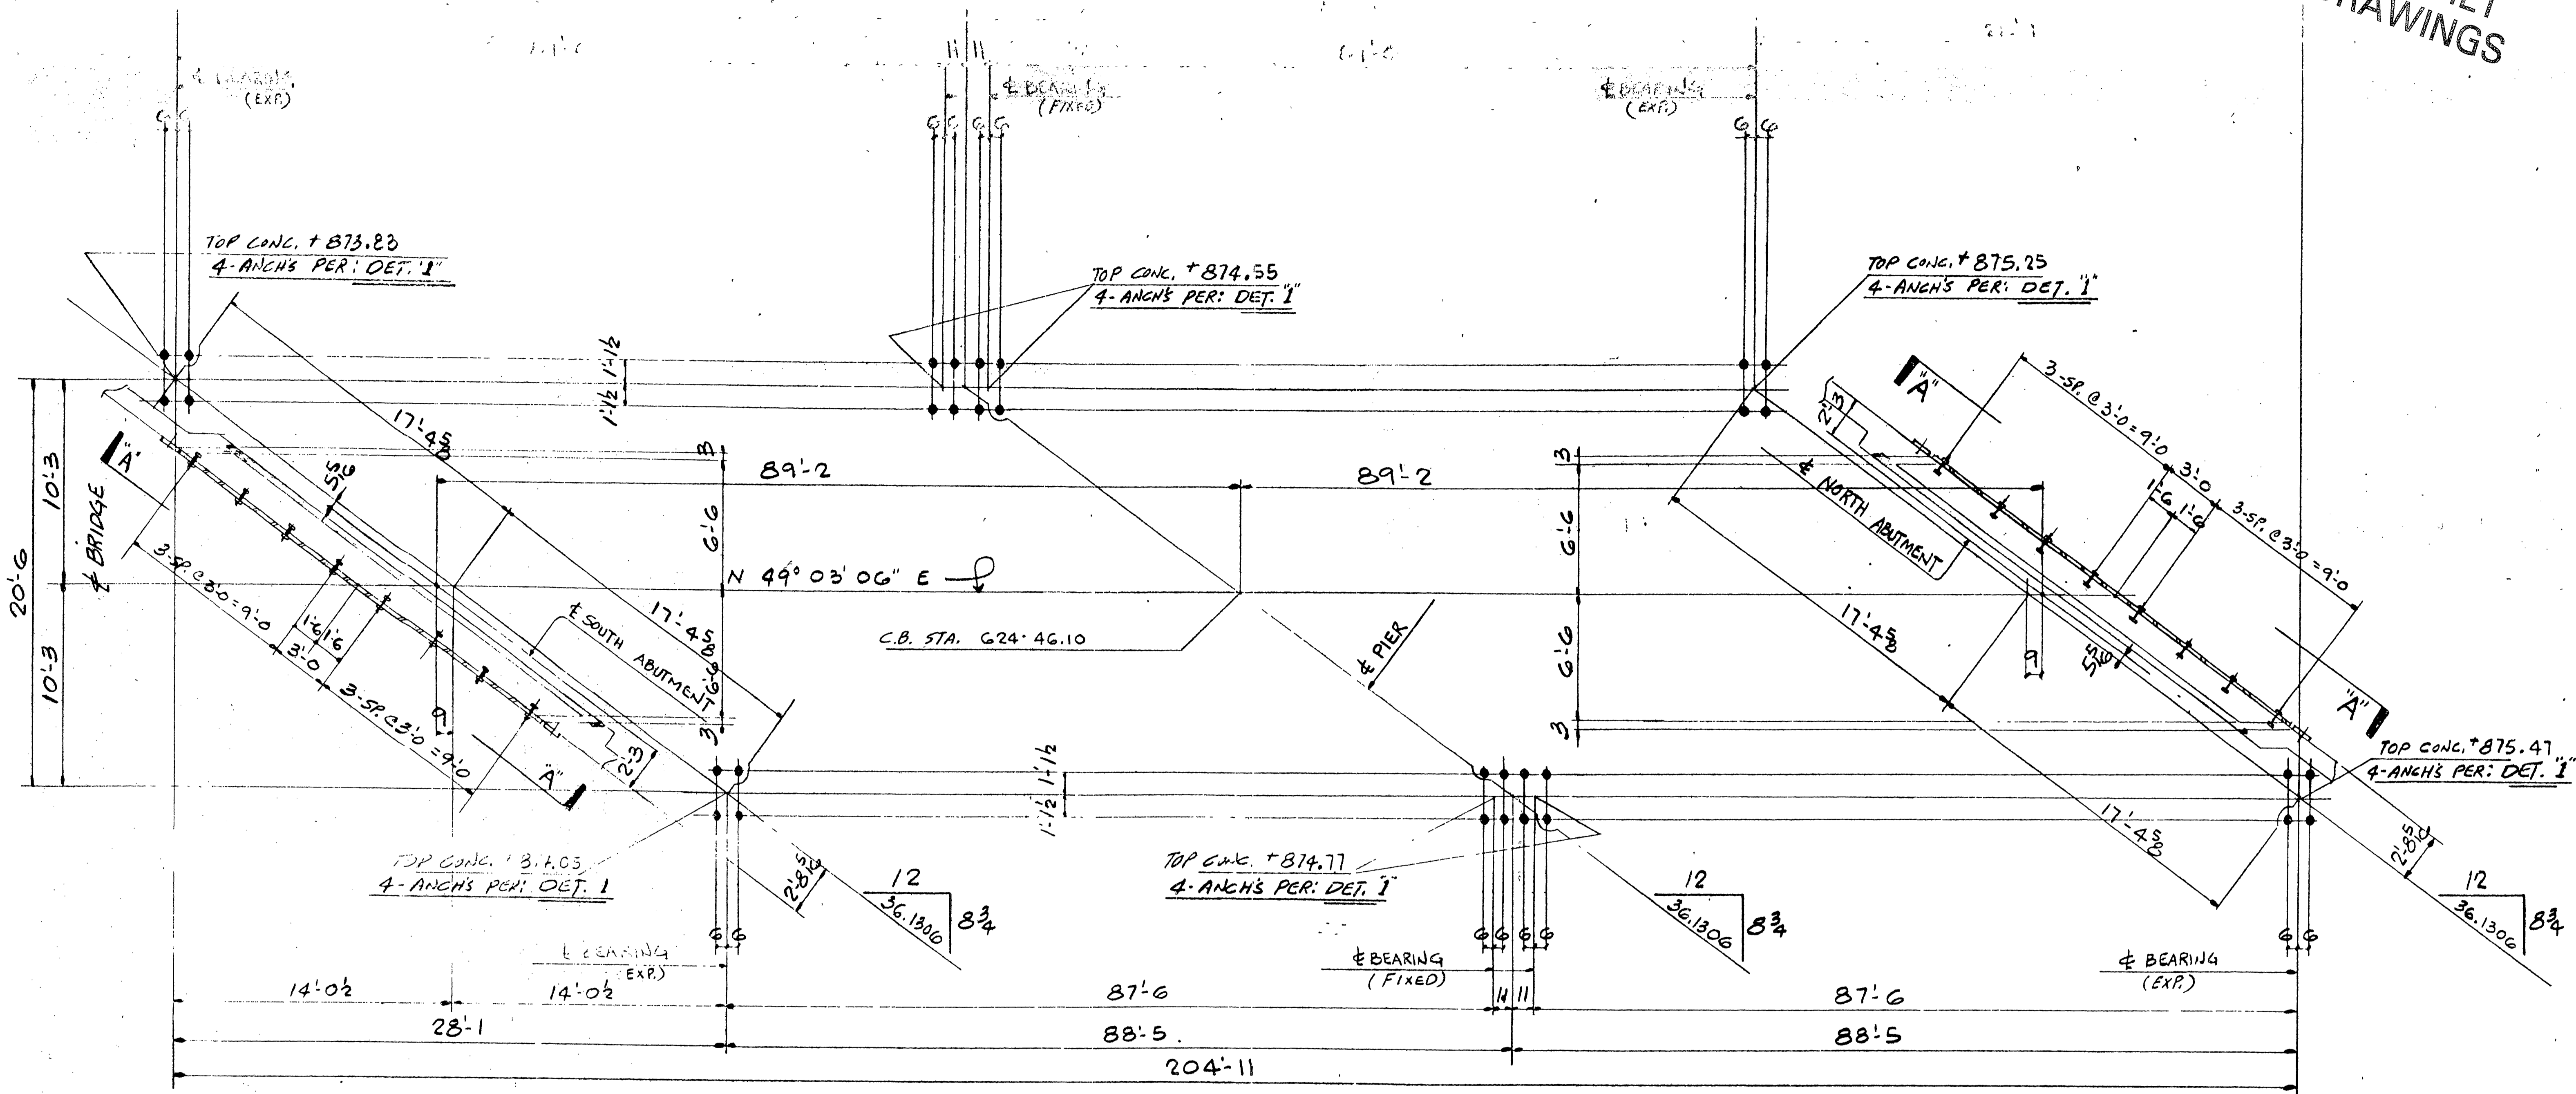


AS BUILT
DRAWINGS

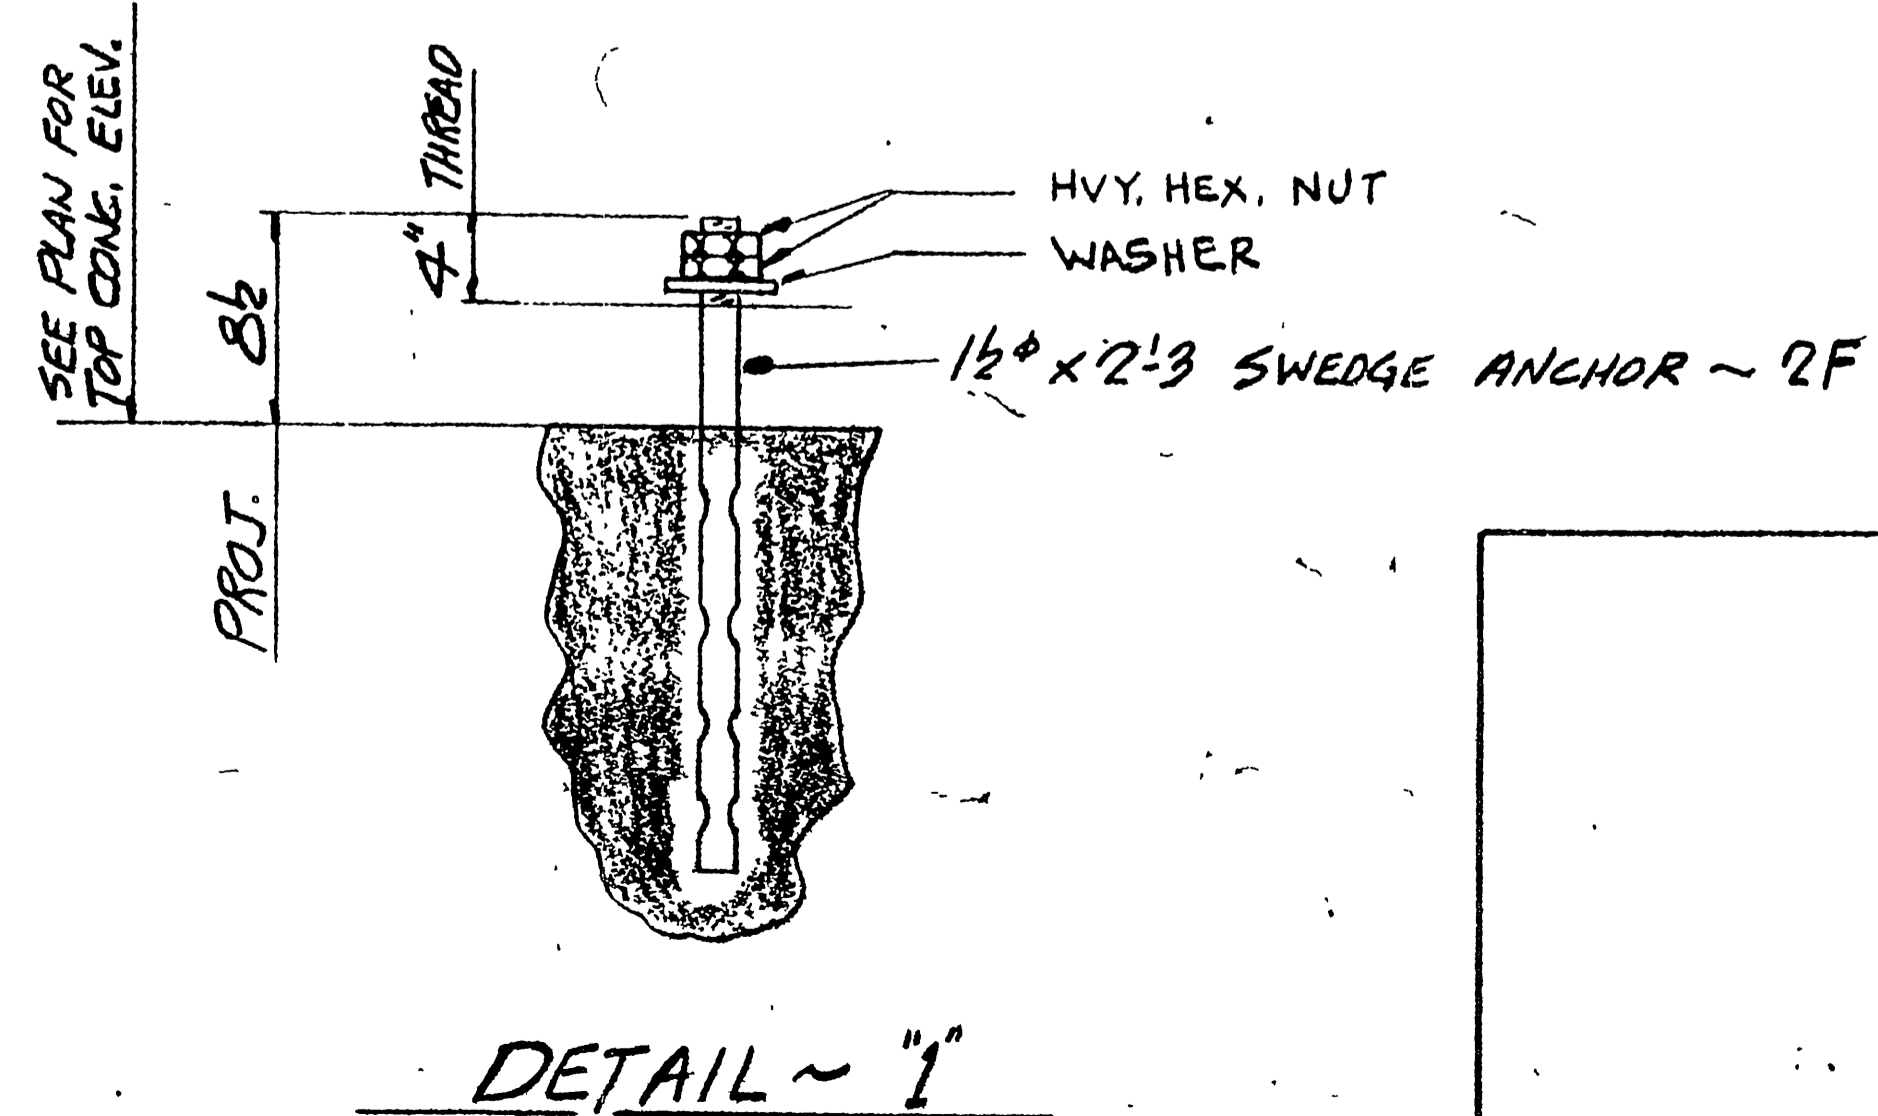

ANCHOR BOLT PLAN

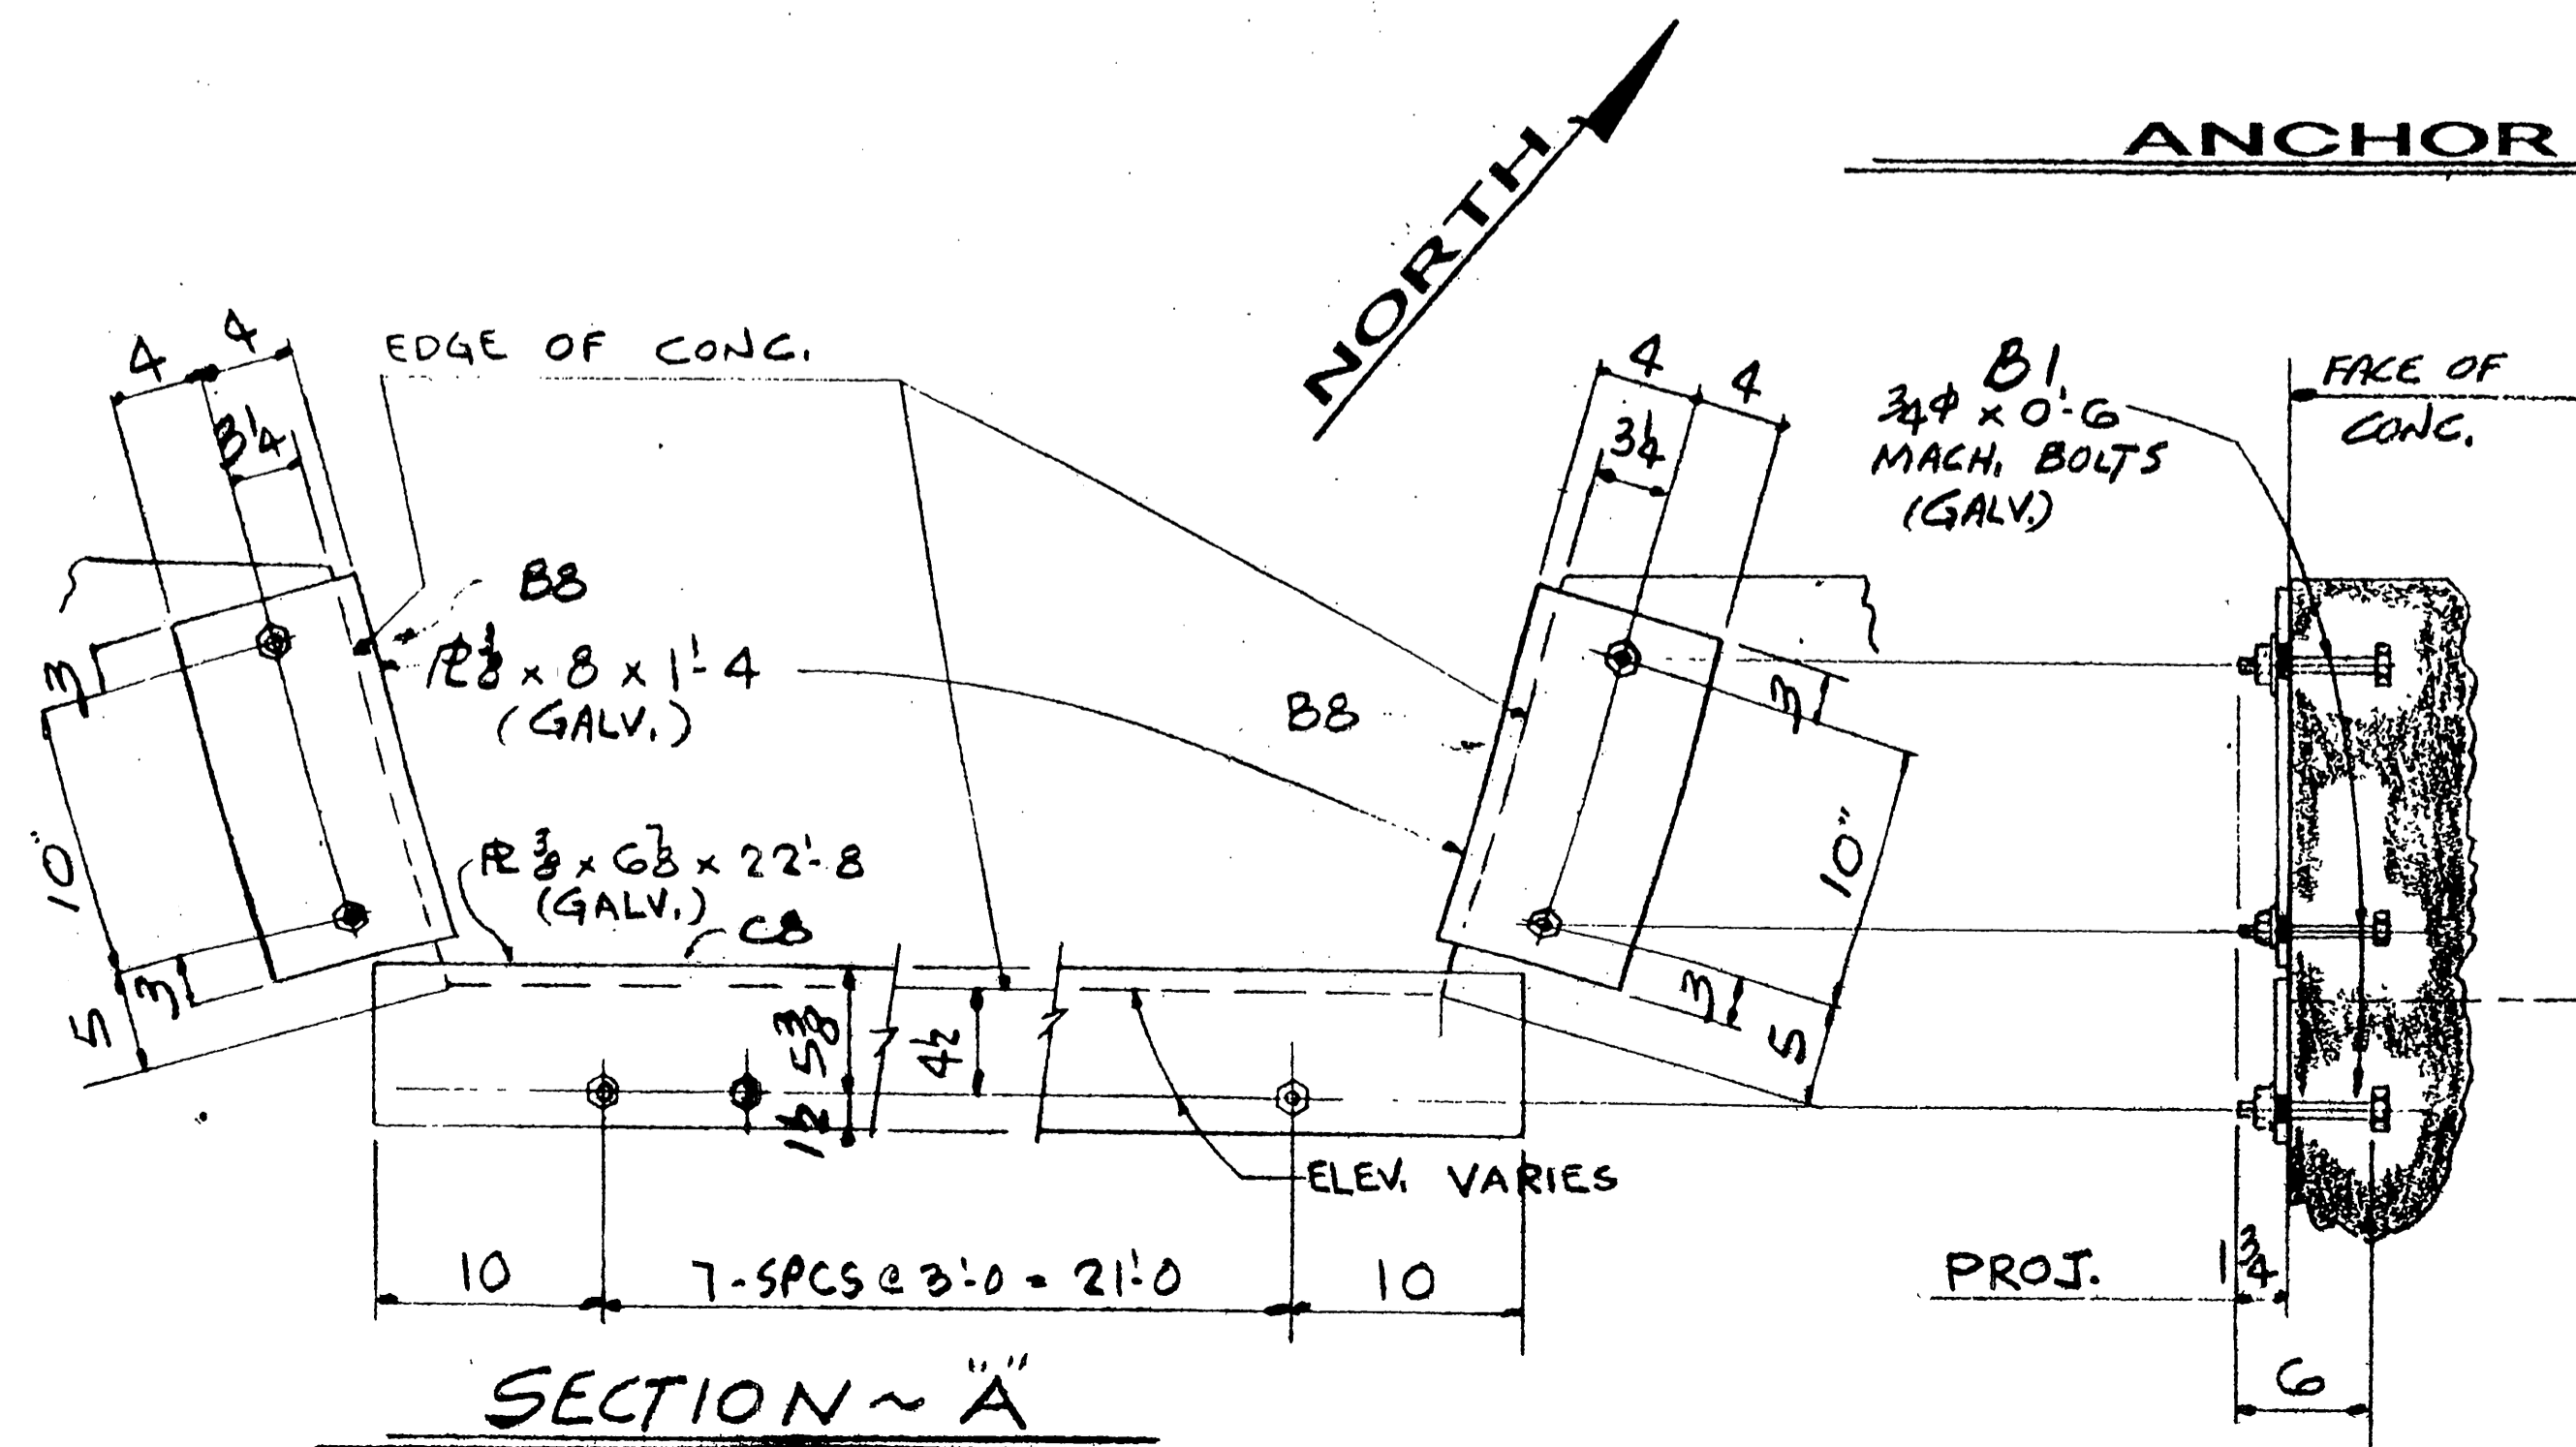

INDEXED 8-8-2000 LPH

HOLES	UNLESS NOTED	REF
SURFACE PREP		
SHOP PAINT		
DESCRIPTION:	ANCHOR BOLT PLAN	
STRUCTURE:	A.T.S.P. CENTRAL AVE UNDERPASS, BRIDGE 11.82	
PROJECT:	08791 SOUTHERN CA. COMMUTER PROJECT	
LOCATION:	RIVERSIDE, CA.	
CUSTOMER:	ATCHISON, TOPEKA & SANTA FE RAILWAY	
ARCHITECT:	HDR ENGINEERING, INC.	
Grand Junction Steel GRAND JUNCTION, COLORADO R-3595		
DRAWN BY:	AEP.	DATE: 3-95
CHECKED BY:	ZRA	DATE: 3-95
APPROVED BY:		DATE:
NO.	BY	DATE
W.O. 10082		SHEET NO. 83
REV.		