STREET IMPROVEMENT PLAN NORWOOD PLACE PARCEL MAP 33112

VICINITY MAP

ARLINGTON

CONSTRUCTION NOTES

BASE PER SOIL'S REPORT

(6) REMOVE EXISTING CHAIN LINK FENCE

WATER METER. BY CITY FORCES

(11) CONSTRUCT VARIABLE A.C. OVERLAY

CITY STD. DWG. 562A

—— 4 —— CENTERLINE

-X--- EXISTING FENCE

----(XX.XX)----- EXIST. CONTOUR LINE

LEGEND

D/W

(1) CONSTRUCT 6" CURB & GUTTER PER CITY STD. 200

(3) CONSTRUCT CONCRETE SIDEWALK PER CITY STD. 325

(8) RELOCATE EXISTING POWER POLE AND GUY ANCHOR

STD. DWG. CWD-600 BY CITY FORCES

 $-\pi$ — π — EXISTING EDGE OF PAVEMENT

SEWER MANHOLE

WATER VALVE

TOP OF CURB

WATER METER

FIRE HYDRANT

FINISHED SURFACE

PROPOSED A.C. PAVING

PROPOSED CONCRETE PAVING

FLOW LINE

EXISTING SPOT ELEVATION

PROPOSED SPOT ELEVATION

POWER POLE & GUY ANCHOR

STREET LIGHT ON POWER POLE

(2) CONSTRUCT ____" A.C. PAVEMENT OVER ____" COMPACTED

(4) CONSTRUCT DRIVEWAY PER CITY STD. 302, A=18', B=25'

(5) SAWCUT EXISTING A.C. PAVEMENT TO FORM SMOOTH JOINT

7) CUT & PLUG EXISTING WATER SERVICE AND RELOCATE EXISTING

(9) CONSTRUCT 4" VCP SEWER LATERAL WITH CLEAN-OUT PER

(10) CONSTRUCT 1" WATER SERVICE WITH 3/4" METER PER CITY

300 L.F.

1,951 S.F.

1,950 S.F.

3 EA.

350 L.F.

300 L.F.

1 EA.

2 EA.

114 L.F.

3 EA.

3 EA.

PW 14-0334

(951) 788-8092

ALL REVISIONS MARKED /1

7177 BROCKTON AVE., # 339 RIVERSIDE, CA 92506

20 Avs. 2014

AND

APPROVED BY

ROBINSON

GENERAL NOTES

- 1. IT SHALL BE THE RESPONSIBILITY OF THE CONTRACTOR TO CLEAR THE RIGHT-OF-WAY IN ACCORDANCE WITH THE PROVISIONS OF LAW AS IT AFFECTS EACH UTILITY INCLUDING IRRIGATION LINES AND APPURTENANCES AND AT NO COST TO THE CITY.
- 2. CONSTRUCTION SHALL BE ACCORDANCE WITH THE CITY OF RIVERSIDE DEPARTMENT OF PUBLIC WORKS, STD. DWGS, ITS SUPPLEMENTAL NOTES AND THE STANDARD SPECIFICATIONS FOR PUBLIC WORKS CONSTRUCTION, CURRENT EDITION,
- 3. THE PRIVATE ENGINEER SIGNING THESE PLANS IS RESPONSIBLE FOR ASSURING THE ACCURACY AND ACCEPTABILITY OF THE WORK HEREON. IN THE EVENT OF DISCREPANCIES ARISING DURING CONSTRUCTION, THE PRIVATE ENGINEER SHALL BE RESPONSIBLE FOR DETERMINING AN ACCEPTABLE SOLUTION AND REVISING THE PLANS FOR APPROVAL BY THE CITY.
- 4. QUANTITIES SHOWN ARE FOR INFORMATION ONLY AND THE CITY OF RIVERSIDE IS NOT RESPONSIBLE FOR THEIR ACCURACY
- 5. THE DEVELOPER SHALL BE RESPONSIBLE FOR PRESERVING OR REESTABLISHING AND REFERENCING SURVEY MONUMENTS DESTROYED, DISTURBED OR BURIED AS A RESULT OF CONSTRUCTION SHOWN HEREON.
- 6. SEE CITY OF RIVERSIDE STREET LIGHTING DWG. FOR QUANTITY AND LOCATION OF REQUIRED STREET LIGHTS.
- 7. ALL FLAGGED ELEVATIONS SHALL BE STAKED IN THE FIELD BY THE PRIVATE ENGINEER.
- 8. TRIM EDGE OF EXISTING PAVEMENT WHERE NEW PAVEMENT JOINS TO A SMOOTH, STRAIGHT LINE. CONSTRUCT MATCH-UP PAVING AS SHOWN ON PLAN AND OVERLAY PAVING AS DIRECTED IN THE FIELD TO PRODUCE A SMOOTH SECTION.
- 9 IN PAVEMENT OVERLAY AREAS, DISTRESSED EXISTING PAVEMENT SHALL BE REMOVED AND REPLACED AS DIRECTED BY THE INSPECTOR PRIOR TO OVERLAYING WITH A.C. PAVING.
- 10. HOURS OF OPERATION ARE 8:30 A.M. TO 3:30 P.M. MONDAY THROUGH FRIDAY. DUST SHALL BE CONTROLLED BY WATERING OR OTHER APPROVED METHODS.
- 11. FINAL STRIPING FOR TRAFFIC CONTROL AND/OR PAVEMENT MARKING TO BE THE RESPONSIBILITY OF THE CONTRACTOR.
- 12. NO PERSON SHALL PERFORM ANY CONSTRUCTION ACTIVITY OR INSTALL ANY OBJECTS WITHIN THE PUBLIC RIGHTS-OF-WAY OR EASEMENTS OF THE CITY OF RIVERSIDE WITHOUT A VALID CONSTRUCTION PERMIT OR, A STREET OPENING PERMIT OR AN ENCROACHMENT PERMIT ISSUED BY THE CITY'S PUBLIC WORKS DEPARTMENT.
- 13. ON ALL AREAS WITHIN PUBLIC RIGHT-OF-WAY WHERE THE FILL IS ONE (1) FOOT OR GREATER, A LETTER WILL BE REQUIRED FROM THE SOILS ENGINEER, CERTIFYING THE COMPACTION OF THE FILL BELOW SUBGRADE, PRIOR TO ISSUANCE OF THE CONSTRUCTION PERMIT/CUT SHEETS.
- 14. ALL TRAFFIC SIGNS SHALL BE INSTALLED PRIOR TO OPENING THE STREETS TO TRAFFIC.
- 15. THE CONTRACTOR SHALL COORDINATE TRENCHING FOR CABLE TELEVISION WITH OTHER TRENCHING WITHIN THE PROJECT.
- 16. ANY TRAFFIC CONTROL STRIPING OBLITERATED AND/OR BADLY WORN DURING CONSTRUCTION SHALL BE RESTORED BY THE CONTRACTOR WITHIN FIVE DAYS AFTER NOTIFICATION FRO THE CITY INSPECTORS.
- 17. THE CONTRACTOR SHALL CALL IN A LOCATION REQUEST TO UNDERGROUND SERVICE ALERT (USA), PHONE NO. 1-800-227-2600, TWO WORKING DAYS BEFORE DIGGING. NO CONSTRUCTION PERMIT WILL BE ISSUED BY THE PUBLIC WORKS DEPARTMENT INVOLVING EXCAVATION FOR UNDERGROUND FACILITIES UNLESS THE APPLICANT HAS BEEN PROVIDED AN INQUIRY IDENTIFICATION NUMBER BY USA.
- 18. ALL STATIONING REFERS TO CENTERLINE OF CONSTRUCTION UNLESS OTHERWISE NOTED. STATIONING FOR LATERALS AND CONNECTOR PIPES REFER TO THE CENTERLINE - CENTERLINE INTERSECTION.
- 19. ALL CROSS SECTIONS ARE TAKEN LOOKING UPSTREAM.
- 20. STREET IMPROVEMENT WORK THAT WILL CAUSE DAMAGE TO THE DETECTOR LOOP(S) SHALL NOT BE PERFORMED UNTIL COUNTY TRAFFIC SIGNAL MAINTENANCE PERSONNEL HAVE BEEN NOTIFIED AND THE NECESSARY TIMING ADJUSTMENTS ARE MADE TO MAINTAIN SIGNAL OPERATION.
- 21. STREET OPENING PERMIT FOR CONSTRUCTION AND/OR MODIFICATION OF TRAFFIC SIGNAL FACILITIES IS REQUIRED.

(OVERHEAD FACILITY RELOCATIONS)

OVERHEAD POWER FACILITIES SHALL BE RELOCATED BY CITY OF RIVERSIDE AT PEVELOPER'S EXPENSE. CONTACT RIVERSIDE PUBLIC UTILITIES 90 DAYS IN ADVANCE OF CONSTRUCTION FOR RELOCATION OF OVERHEAD POWER FACILITIES.

CONTACT: VAHID BAZEL, P.E.

PHNO, 951-926-5830 3900 MAIN ST., 4th FLEOR RIVERSIDE, GA 92522

CONTACT RIVERSIDE PUBLIC UTILITIES 90 PAYS IN ADVANCE OF CONSTRUCTION FOR RELOCATION OF OVERHEAD POWER POLE FACILITIES, CONTACT VAHID BAZEL P.E. SEE ABOVE TEL. AND ADDRESS.

	PUBLIC UTILITIES DEPARTMENT WATER DIVISION PUW 05 - 0414		PUBLIC UTILITIES DEPARTMENT ELECTRIC DIVISION	
	MW MULL APPROVED BY	8/24/06	Voada C	8/30/06
	APPROVED BY	DATE	APPROVED BY	DATE
POR UTT THE METER ALOTE PREMIUM				144014 00

MPORTANT NOTICE CALL TOLL FREE 48 HOURS BEFORE YOU DIG NDERGROUND SERVICE ALERT -800-227-2600

PRIVATE ENGINEER NOTE CONSTRUCTION CONTRACTOR AGREES THAT IN ACCORDANCE WITH GENERALLY ACCEPTED CONSTRUCTION PRACTICES, CONSTRUCTION CONTRACTOR WILL BE REQUIRED TO ASSUME SOLE AND COMPLETE RESPONSIBILITY FOR JOB SITE CONDITIONS DURING THE COURSE OF CONSTRUCTION OF THE PROJECT, INCLUDING CAPETY OF AN EXPERIENCE AND REPORTERY. THAT THE SAFETY OF ALL PERSONS AND PROPERTY; THAT THIS REQUIREMENT SHALL BE MADE TO APPLY CONTINUOUSLY AND NOT BE LIMITED TO NORMAL WORKING HOURS, AND CONSTRUCTION CONTRACTOR FURTHER AGREES TO DEFEND, INDEMNIFY AND HOLD DESIGN PROFESSIONAL HARMLESS FROM ANY AND ALL LIABILITY, REAL OR ALLEGED, IN CONNECTION WITH THE PERFORMANCE OF WORK ON THIS PROJECT, EXCEPTING LIABILITY ARISING FROM THE SOLE NEGLIGENCE OF DESIGN

BENCHMARK: G2-13 RR SPIKE IN POLE (NO NUMBER) @ N.W. CORNER OF CAMPBELL AVE. AND NORWOOD AVE.

ELEVATION: 771.650'



SANDERSON-GUTIERREZ CIVIL ENGINEERS & LAND SURVEYORS, INC 10050-A 6 TH STREET, RANCHO CUCAMONGA, CA 91730 (909) 980-1211 J.N. 04-074 CITY OF RIVERSIDE BUSINESS TAX CERTIFACTE #73574, EXP. 1/1/07

LOUIS T. GUTIERREZ R.C.E. NO. 28501 EXP. DATE: 3/31/08

MEX CITY OVERLAY REQ'S GRIND, OL. RAISED TO FOR DRAINAGE RIZ **REVISIONS** DESIGNED BY EBB DRAWN BY CAT CHECKED BY LTG

EXISTING UNDERGROUND STRUCTURES

THE EXISTENCE AND APPROXIMATE LOCATION OF ANY UNDERGROUND UTILITIES OR STRUCTURES SHOWN ON THESE PLANS ARE OBTAINED BY A SEARCH OF THE AVAILABLE RECORDS. TO THE BEST OF OUR KNOWLEDGE, THERE ARE NO EXISTING UTILITIES OR STRUCTURES EXCEPT AS SHOWN ON THESE PLANS. THE ENGINEER ASSUMES NO LIABILITY AS TO THE EXACT LOCATION OF SAID LINES NOR FOR UTILITIES OR IRRIGATION LINES WHOSE LOCATIONS ARE NOT SHOWN. THE CONTRACTOR SHALL BE RESPONSIBLE FOR NOTIFYING ALL UTILITY AND IRRIGATION COMPANIES PRIOR TO WORK OR EXCAVATION TO DETERMINE EXACT LOCATION OF ALL LINES AFFECTING THIS WORK, WHETHER OR NOT SHOWN HERON, AND FOR ANY DAMAGE OR PROTECTION OF THESE LINES.

SURVEY MONUMENT NOTE

SURVEY MONUMENTS THAT EXIST AS SHOWN ON RECORDED MAPS, HIGHWAY MAPS OR POINTS THAT PROVIDE SURVEY CONTROL WITHIN THE CONSTRUCTION AREA, SHALL BE LOCATED AND REFERENCED OUT BY A LICENSED LAND SURVEYOR OR REGISTERED CIVIL ENGINEER (AUTHORIZED TO PRACTICE LAND SURVEYING), AND CORNER RECORDS SHALL BE FILED WITH THE COUNTY SURVEYOR PRIOR TO THE START OF CONSTRUCTION. THESE CORNER RECORDS SHALL DESCRIBE THE MONUMENTS FOUND WITH TIE DISTANCES TO REFERENCE POINTS FOR RESETTING OF THE SURVEY MONUMENT. WHEN CONSTRUCTION IS COMPLETED, MONUMENTS SHALL BE SET AND CORNER RECORDS SHALL BE FILED WITH THE COUNTY SURVEYOR SHOWING THE NEW MONUMENTS.


HOLD HARMLESS INDEMNIFICTION CLAUSE

CONSTRUCTION CONTRACTOR AGREES THAT IN ACCORDANCE WITH GENERALLY ACCEPTED CONSTRUCTION PRACTICES. CONSTRUCTION CONTRACTOR WILL BE REQUIRED TO ASSUME SOLE AND COMPLETE RESPONSIBILITY FOR JOB SITE CONDITIONS DURING THE COURSE OF CONSTRUCTION OF THE PROJECT, INCLUDING SAFETY OF ALL PERSONS AND PROPERTY; THAT THIS REQUIREMENT SHALL BE MADE TO APPLY CONTINUOUSLY AND NOT BE LIMITED TO NORMAL WORKING HOURS, AND CONSTRUCTION CONTRACTOR FURTHER AGREES TO DEFEND, INDEMNIFY AND HOLD THE OWNER, THE ENGINEER AND THE CITY OF UPLAND HARMLESS FROM ANY AND ALL LIABILITY. REAL OR ALLEGED. IN CONNECTION WITH THE PERFORMANCE OF WORK ON THIS PROJECT. EXCEPTING FOR LIABILITY ARISING FROM THE SOLE

ALL CONTRACTORS AND SUBCONTRACTORS PERFORMING WORK SHOWN ON OR RELATED TO THESE PLANS SHALL CONDUCT THEIR OPERATIONS SO THAT EMPLOYEES ARE PROVIDED A SAFE PLACE TO WORK AND THE PUBLIC IS PROTECTED. ALL CONTRACTORS AND SUBCONTRACTORS SHALL COMPLY WITH THE "OCCUPATIONAL SAFETY AND HEALTH REGULATIONS: OF THE U.S. DEPARTMENT OF LABOR AND WITH THE STATE OF CALIFORNIA DEPARTMENT OF INDUSTRIAL RELATIONS "CONSTRUCTION SAFETY ORDERS". THE CIVIL ENGINEER SHALL NOT BE RESPONSIBLE IN ANY WAY FOR THE CONTRACTOR OR SUBCONTRACTORS COMPLIANCE WITH SAID REGULATIONS AND ORDERS.

NOTICE TO CONTRACTOR

CONTRACTOR SHALL VERIFY ALL CONDITIONS AND DIMENSIONS AND SHALL REPORT ALL DESCREPANCIES TOTHE ENGINEER PRIOR TO THE COMMENCEMENT OF WORK.

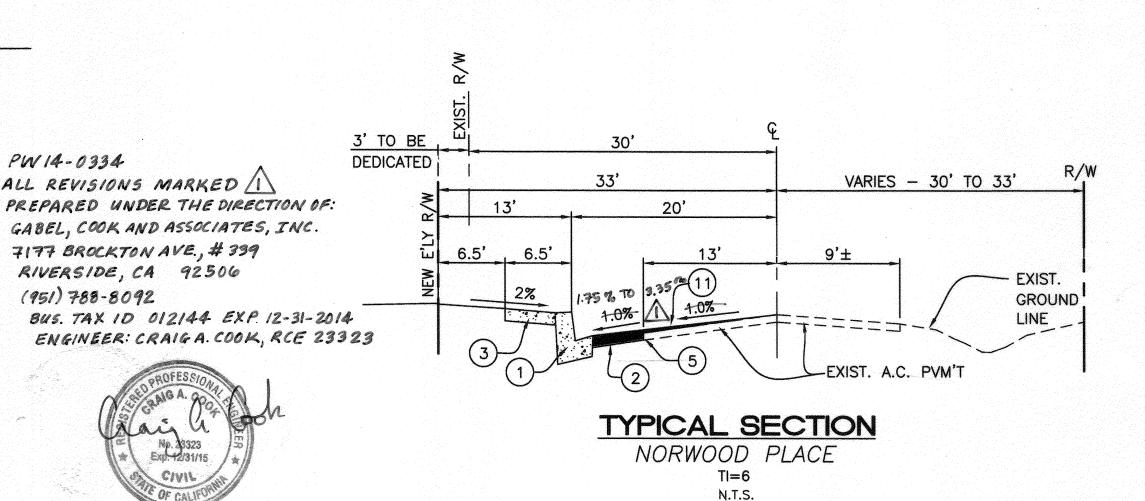

WDID# 833C332609 PW05 - 1032

STREET IMPROVEMENTS PARCEL MAP 33112 WEST SIDE NORWOOD PLACE

SHEET 1 OF 2

FROM STA. 3+12.00 TO STA. 6+12.00 HORIZONTAL SCALE: NONE VERTICAL SCALE: NONE

INDEXED 9-27-06 Litt

CITY OF RIVERSIDE, CALIFORNIA

PUBLIC WORKS DEPARTMENT

BY DATE APPROVED BY

MA 9-15-06 CITY ENGINEER

9/20/06

DATE_

144 1215-01

