



- LEGEND:**
- DIRECTION OF DETOUR TRAFFIC DURING CONSTRUCTION
 - PORTION OF COLUMBIA AVENUE CLOSED TO THROUGH TRAFFIC (LOCAL ACCESS ONLY)
 - DETOUR SIGN
 - CHANGEABLE MESSAGE SIGN, PLACE 2-WEEKS IN ADVANCE OF COMMENCEMENT OF WORK

- NOTE:**
1. CONTRACTOR SHALL MODIFY TRAFFIC SIGNALS ACCORDINGLY TO ENSURE CONFLICTING MOVEMENTS ARE ELIMINATED. CONTRACTOR SHALL CONTACT THE TRAFFIC SIGNAL MAINTENANCE DEPT. AT 951-453-7826 TO COORDINATE TRAFFIC SIGNAL WORK TWO WEEKS IN ADVANCE OF COMMENCEMENT OF WORK.
 2. ALL CONFLICTING TRAFFIC SIGNAL STRIPING SHALL BE REMOVED BY SAND BLASTING METHOD, BLACK-OUT IS NOT PERMITTED. CONTRACTOR SHALL PROVIDE DETAILED TRAFFIC CONTROL PLANS SHOWING TEMPORARY STRIPING AND TRAFFIC SIGNAL MODIFICATIONS REQUIRED TO PROVIDE DETOUR PLAN AS SHOWN.

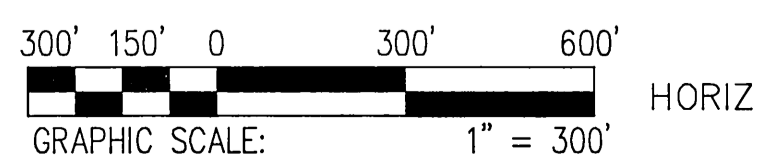

AS BUILT
DATE 9-14-10

DMJM HARRIS | AECOM
800 NORTH HAVEN, SUITE 410
ONTARIO, CA 91764
T (909)291-8150 F (909)291-8166

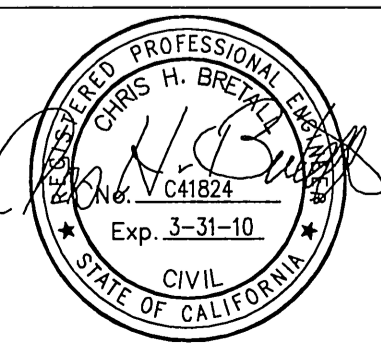

MARK	REVISIONS	APPR.	DATE

DESIGNED BY SA DRAWN BY SA CHECKED BY CB

COLUMBIA AVENUE OVERPASS AT BNSF RAILROAD
TRAFFIC DETOUR PLAN
SCALE: 1" = 300'

ACCT. NO. -
R-4036
DE-01
SHEET 30 OF 103

FILE: I:\P\16000423 Columbia Crd. Sep\CAD\Drawings\Sheet\DE-01.dwg PLOTTED: Sep 15, 2008 11:59am BY: empires PLOT SCALE: 1"=1