



- CONSTRUCTION NOTES**
- 1. CONSTRUCT P.C.C. CURB & GUTTER PER DETAIL HEREON
 - 2. INSTALL 6" RIVER ROCK PAD AT END OF C&G
 - 3. HAND GRADE EXIST. GROUND AS NECESSARY TO PROVIDE 0.1' FINISH GRADE ABOVE EDGE OF GUTTER

GENERAL NOTES
CONSTRUCTION SHALL BE IN ACCORDANCE WITH THE CITY OF RIVERSIDE DEPARTMENT OF PUBLIC WORKS STANDARD DRAWINGS, ITS SUPPLEMENTAL NOTES AND THE STANDARD SPECIFICATIONS FOR PUBLIC WORKS CONSTRUCTION, CURRENT EDITION.

RECEIVED

DEC 07 2009

City of Riverside
Public Works Department

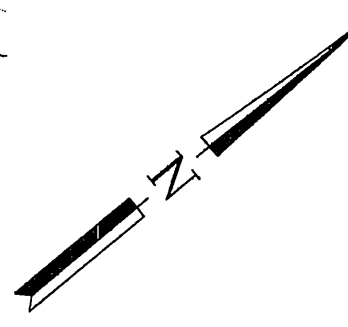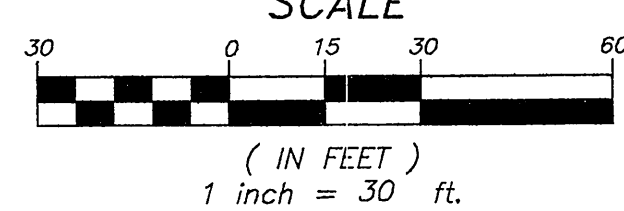

Underground Service Alert
Call: TOLL FREE
1-800
227-2600
TWO WORKING DAYS
BEFORE YOU DIG

BASIS OF BEARINGS:
THE BASIS OF BEARINGS FOR THIS SURVEY IS THE CENTERLINE OF VICTORIA AVENUE PER TRACT NO. 30627 M.B. 334/74-75
BEING N28°59'00"E

BENCH MARK:
RIVERSIDE COUNTY BENCH MARK NO. G6-B2
BRASS DISK IN MONUMENT WELL AT THE INTERSECTION OF VICTORIA AVE. AND MARY ST.
ELEV. 944.502

PREPARED BY:
GFB-FRIEDRICH & ASSOC., INC.
CONSULTING CIVIL ENGINEERS
6529 RIVERSIDE AVENUE, STE. 230
RIVERSIDE, CA 92506
951-791-0812 gfb@pfpcbell.net
R.E. 27861 EXP. 3-31-10 DATE 12-07-09

DESIGNED BY: DRAWN BY: G.R.W. CHECKED BY: APPROVED BY: DATE 5/5/10

CITY OF RIVERSIDE
PUBLIC WORKS DEPARTMENT
APPROVED BY: DATE 5/5/10

IN THE CITY OF RIVERSIDE
2635 ANNA STREET
DRAINAGE IMPROVEMENT PLAN
FOR: JACQUES YEAGER

R-4165
SHEET 1 OF 1

As BUILT 1/21/11