


RIVERSIDE

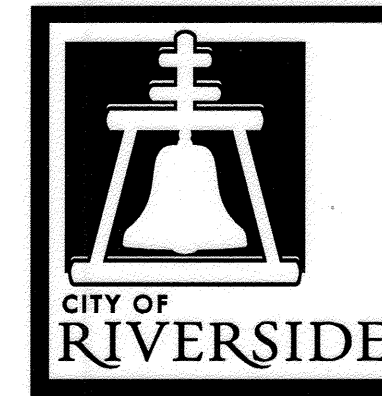

CALIFORNIA

PUBLIC WORKS DEPARTMENT

2014-2015 CDBG - WARD 2

STREET IMPROVEMENTS FOR


TWELFTH STREET, THIRTEENTH STREET,
HOWARD AVENUE AND PARK AVENUE
A HUD FUNDED PROJECT

GENERAL CONSTRUCTION NOTES:

1. THE CONTRACTOR SHALL PROVIDE AND MAINTAIN TRAFFIC AS INDICATED IN THE ASSOCIATED PROJECT SPECIAL PROVISIONS.
2. CONSTRUCTION SHALL BE IN ACCORDANCE WITH THE CITY OF RIVERSIDE STANDARD DRAWINGS AND STANDARD SPECIFICATIONS FOR PUBLIC WORKS CONSTRUCTION, 2012 EDITION.
3. EXISTING UTILITIES SHOWN ON THIS PLAN ARE PLOTTED FROM UTILITY RECORDS. THE CONTRACTOR IS REQUIRED TO TAKE DUE PRECAUTIONARY MEASURES TO LOCATE AND PROTECT ALL UTILITIES WHETHER OR NOT SHOWN ON THIS PLAN.
4. CONFLICTING UTILITIES SHOWN WITHIN CONSTRUCTION AREA WILL BE RELOCATED PRIOR TO CONSTRUCTION.
5. ALL STREET PULL BOXES, AFFECTED BY CONSTRUCTION, SHALL BE ADJUSTED TO THE PROPOSED GRADE.
6. PRIME CONTRACTOR BIDDING THIS WORK SHALL HAVE A CLASS "A" OR "C-8".
7. THE SEAM BETWEEN PASSES OF THE AC OVERLAY SHALL COINCIDE, AS CLOSE AS POSSIBLE, TO THE LANE LINES.
8. COLD MILLING SHALL BE AS DESCRIBED ON THE PLANS AND SPECIAL PROVISIONS OR AS DIRECTED BY THE ENGINEER.
9. ANY DISTRESSED EXISTING PAVEMENT SHALL BE REMOVED AND REPLACED AS DIRECTED BY THE ENGINEERING AFTER COLD-MILLING AND PRIOR TO PLACEMENT OF DGAC.
10. CONTRACTOR SHALL REMOVE ALL VEGETATION WITHIN ALL SIDEWALK PANELS WITHIN THE PROJECT LIMITS.
11. ALL EXISTING IMPROVEMENTS SHOWN HEREON SHALL BE PROTECTED IN PLACE UNLESS OTHERWISE NOTED.
12. EXISTING IRRIGATION SHALL BE PROTECTED OR MODIFIED AS NECESSARY TO CONSTRUCT NEW CONCRETE IMPROVEMENTS.
13. ALL FENCE POSTS SHALL BE PROTECTED OR MODIFIED AS NECESSARY IF POST FOUNDATION IS WITHIN A SIDEWALK PANEL THAT HAS BEEN CALLED OUT FOR REPLACEMENT.

CONSTRUCTION NOTES:

- NUMBERS ABOVE 100 IN A HEXAGON ON THE PLAN REFER TO THE RESPECTIVE STANDARD DRAWING AND SHALL BE CONSTRUCTED ACCORDINGLY. UNLESS MODIFICATIONS ARE NOTED ON THE PLAN OR COVER SHEET. ANY NUMBER SHOWN BELOW THE STANDARD DRAWING NUMBER INDICATES THE SPECIFIC ALTERNATE TO BE CONSTRUCTED.
- ADJ XX ADJUST TO GRADE, DESCRIPTION PER PLAN. (MH) SEWER OR STORM DRAIN. (GV) GATE VALVE. (ETS) ELECTRIC TEST STATION
- CM1 XX PROVIDE VARIABLE DEPTH COLDMILLING TO TRANSITION FROM 0.15' AT GUTTER LIP/JOINT TO 0' DEPTH AT THE MILL WIDTH INDICATED. (XX) = WIDTH OF LINEAR COLD MILL AS INDICATED ON PLANS.
- CM2 XX COLD MILL EXISTING AC PAVEMENT. (XX) = DEPTH OF COLD MILL AS INDICATED ON PLANS.
- DC 0.19 OVERLAY EXISTING PAVEMENT WITH DGAC PAVEMENT. (XX) = DEPTH OF PAVEMENT AS INDICATED ON PLANS.
- 325 MOD CONSTRUCT NEW PCC SIDEWALK PER CITY STANDARD 325, THICKNESS SHALL BE 6".

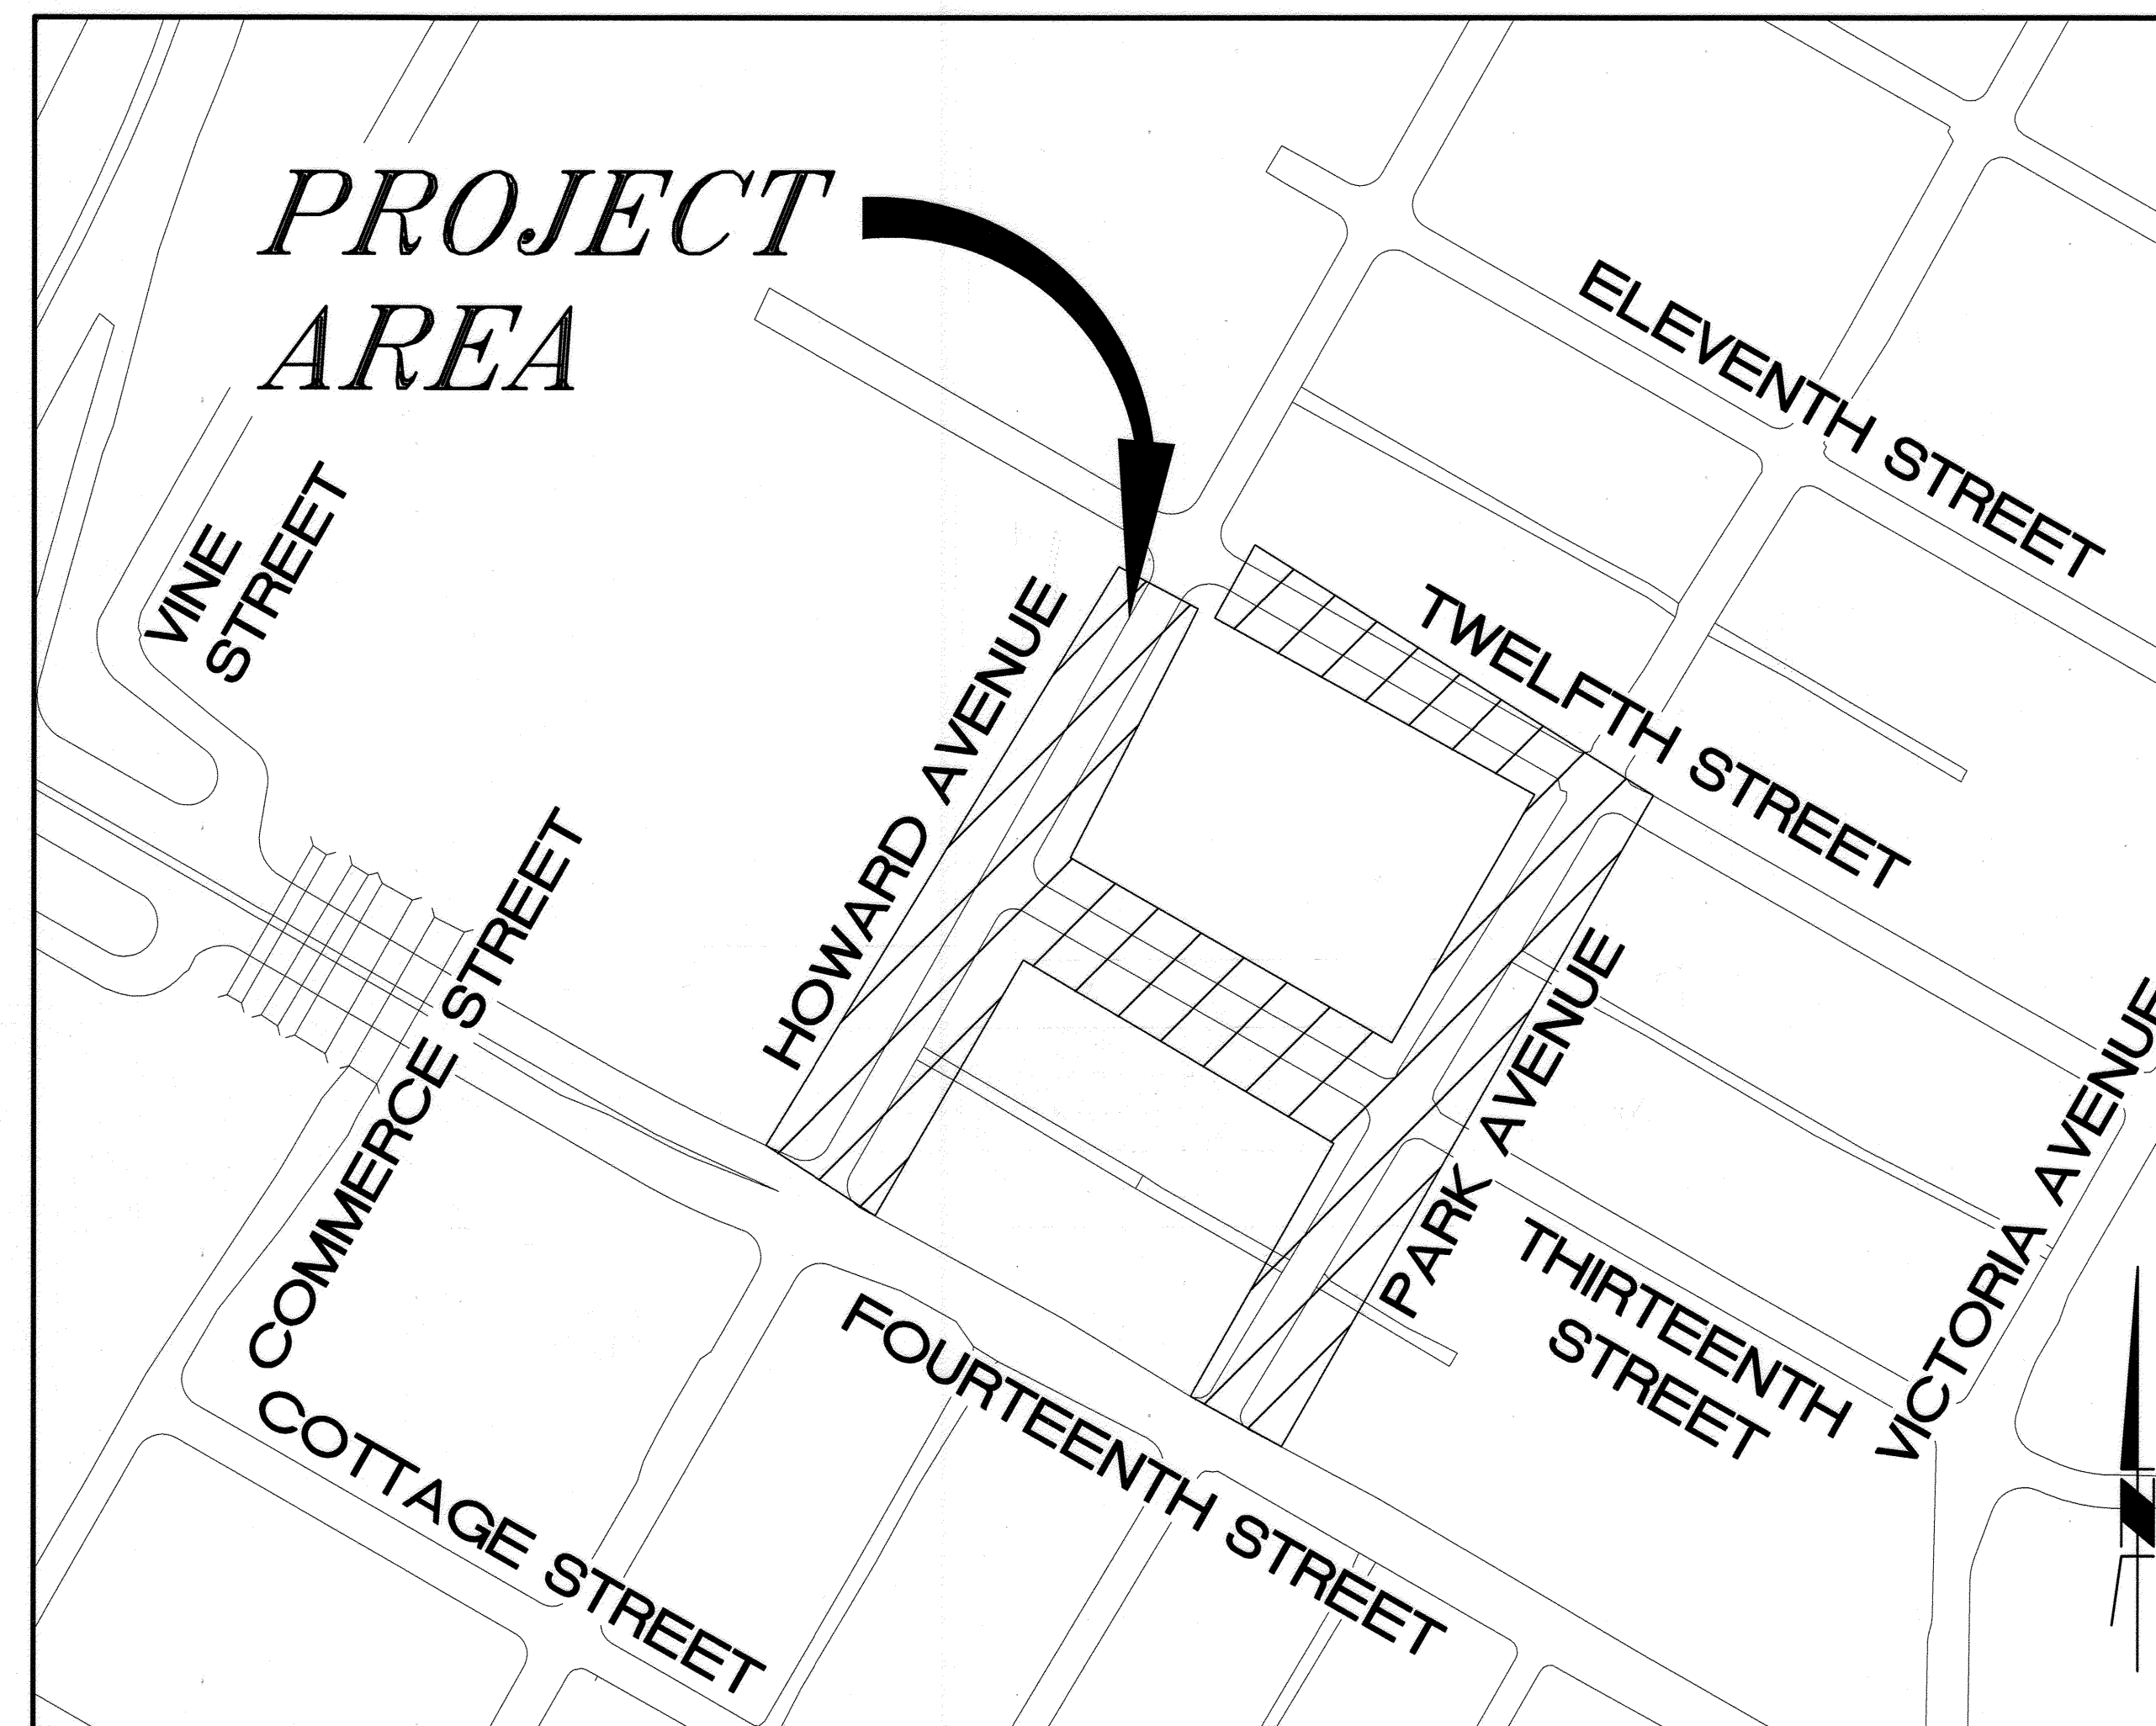

LOCATION MAP

NTS

EXISTING TOPOGRAPHY:

- | | |
|-----------------------|---------------------------------|
| Ⓢ SANITARY SEWER M.H. | Ⓢ GATE VALVE |
| Ⓢ STORM DRAIN M.H. | Ⓢ ELECTRICAL TEST STATION (GAS) |
| Ⓢ ELECTRIC M.H. | Ⓢ FIRE HYDRANT |
| Ⓢ WATER M.H. | |



LEGEND:

- | | |
|----------|--------------|
| CM1 + OL | PROPOSED PCC |
| CM2 + OL | |

SHEET INDEX: STREET IMPROVEMENTS

SHEET NO.	DESCRIPTION
1	TITLE SHEET
2	MAINTENANCE PLAN

	ENGINEER IN RESPONSIBLE CHARGE Christopher P. Scully R.C.E. No. 83144 EXPIRES 3-31-17 DATE 9-16-15		CITY OF RIVERSIDE, CALIFORNIA DEPARTMENT OF PUBLIC WORKS				STREET IMPROVEMENTS		2014-2015 CDBG - WARD 2 STREET IMPROVEMENTS FOR TWELFTH STREET, THIRTEENTH STREET HOWARD AVENUE AND PARK AVENUE		R-4339	
			APPROVED BY ENGINEERING MANAGER CONSTRUCTION ADMIN. TRAFFIC DIVISION STREETS SERVICES SURVEYOR	BY DATE 9/18/15 9-18-15 9-22-15 9/22/15	APPROVED BY CITY ENGINEER DATE 9/23/2015	TITLE SHEET		SHEET 1 OF 2				
DESIGNED BY CS DRAWN BY DC/CS CHECKED BY CS			HORIZ. SCALE: N/A		VERT. SCALE: N/A		FILE NAME: R4339-1.DWG		AS-BUILT 7-20-19 DESIGN WORK ORDER NO. 1520055 CONSTR. WORK ORDER NO. 1604703			

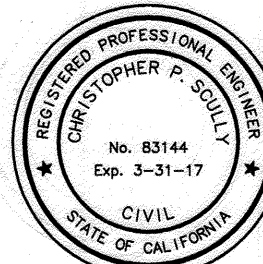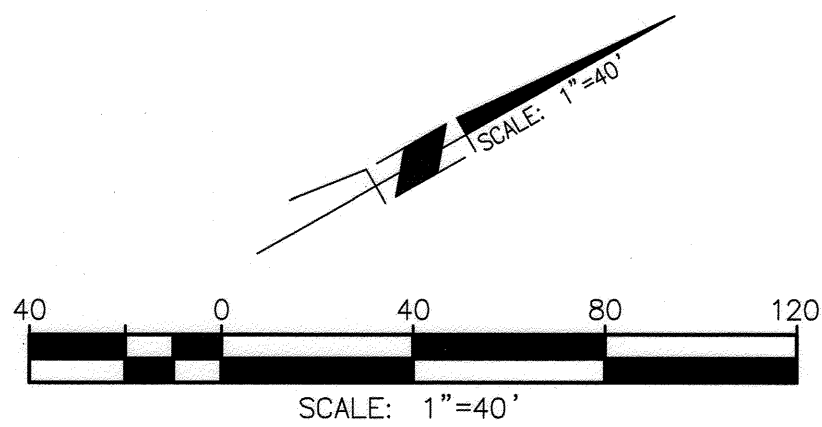[illegible]