#### GENERAL CONSTRUCTION NOTES:

- THE CONTRACTOR SHALL PROVIDE AND MAINTAIN TRAFFIC CONTROL AS INDICATED IN THE ASSOCIATED PROJECT SPECIAL PROVISIONS.
- CONSTRUCTION SHALL BE IN ACCORDANCE WITH THE CITY OF RIVERSIDE STANDARD DRAWINGS AND STANDARD SPECIFICATIONS FOR PUBLIC WORKS CONSTRUCTION, 2012
- EXISTING UTILITIES SHOWN ON THIS PLAN ARE PLOTTED FROM UTILITY RECORDS. THE CONTRACTOR IS REQUIRED TO TAKE DUE PRECAUTIONARY MEASURES TO LOCATE AND PROTECT ALL UTILITIES WHETHER OR NOT SHOWN ON THIS PLAN.
- CONFLICTING UTILITIES SHOWN WITHIN CONSTRUCTION AREA WILL BE RELOCATED PRIOR TO CONSTRUCTION.
- ALL STREET PULL BOXES, AFFECTED BY CONSTRUCTION, SHALL BE ADJUSTED TO THE
- PRIME CONTRACTOR BIDDING THIS WORK SHALL HAVE A CLASS "A"
- THE SEAM BETWEEN PASSES OF THE AC OVERLAY SHALL COINCIDE. AS CLOSE AS
- 8. COLD MILLING SHALL BE AS DESCRIBED ON THE PLANS AND SPECIAL PROVISIONS OR AS DIRECTED BY THE ENGINEER
- 9. ANY DISTRESSED EXISTING PAVEMENT SHALL BE REMOVED AND REPLACED AS DIRECTED BY THE ENGINEER AFTER COLD-MILLING AND PRIOR TO PLACEMENT OF DGAC.
- 10. CONTRACTOR SHALL REMOVE ALL VEGETATION WITHIN ALL SIDEWALK PANELS WITHIN
- 11. ALL EXISTING IMPROVEMENTS SHOWN HEREON SHALL BE PROTECTED IN PLACE UNLESS
- 12. EXISTING IRRIGATION SHALL BE PROTECTED OR MODIFIED AS NECESSARY TO CONSTRUCT NEW CONCRETE IMPROVEMENTS.
- 13. ALL FENCE POSTS SHALL BE PROTECTED OR MODIFIED AS NECESSARY IF POST FOUNDATION IS WITHIN A SIDEWALK PANEL THAT HAS BEEN CALLED OUT FOR

### CONSTRUCTION NOTES:

- REMOVE AND REPLACE IN KIND EXISTING FACILITY, NUMBERS ABOVE 100 IN A HEXAGON ON THE PLAN REFER TO THE RESPECTIVE STANDARD DRAWING AND SHALL BE CONSTRUCTED SPECIFIC TYPE, ACTION, OR MODIFICATION TO BE CONSTRUCTED. WHERE NO MODIFICATION OR TYPE IS INDICATED, THE DIMENSIONS OF NEW FACILITY SHALL BE MODIFIED AS NECESSARY, EXCLUDING ADA REQUIREMENTS, TO MATCH EXISTING FACILITY REMOVED.
- PROTECT IN PLACE EXISTING FACILITY. DESCRIPTION (XX) PER PLAN. (PB)=PULLBOX; (CB)=CATCH BASIN; (MH)=MANHOLE; (GV)=GATE VALVE; (CD)=CURB DRAIN; (TS)=TRAFFIC STRIPE/LEGEND
- ADJUST TO GRADE, DESCRIPTION (XX) PER PLAN. (MH)=SEWER OR STORM DRAIN (GV)=GATE VALVE; (CO)=CLEANOUT
- PROVIDE VARIABLE DEPTH COLDMILLING TO TRANSITION FROM 0.15' AT GUTTER LIP/JOINT TO 0' DEPTH AT THE MILL WIDTH INDICATED.
- PROVIDE VARIABLE DEPTH COLDMILLING TO TRANSITION FROM 0.15' AT GUTTER LIP/JOINT TO 0' DEPTH AT THE MILL WIDTH INDICATED.
- REMOVE EXISTING AC PAVEMENT, BASE OR NATIVE MATERIAL TO A DEPTH TO ACCOMMODATE THE NEW STREET SECTION
- INSTALL 5" DGAC OVER COMPACTED NATIVE
- OVERLAY AREA WITH DGAC AT A DEPTH PER PLAN.
- CONSTRUCT ASPHALT RUBBERIZED AGGREGATE MEMBRANE PRIOR TO AC PAVEMENT OVERLAY
- REMOVE AND REPLACE PCC SIDEWALK PER CITY STANDARD 325, MODIFY THICKNESS TO BE 6"
- INSTALL 12" SOLID WHITE THERMOPLASTIC LIMIT LINE AND SOLID WHITE "STOP" LEGEND. LOCATION VERIFIED BY ENGINEER
- INSTALL 170' DOUBLE YELLOW THERMOPLASTIC STRIPE, DETAIL 22, 18' FROM INNER CURB FACE, LOCATION VERIFIED BY ENGINEER
- INSTALL NEW TRAFFIC SIGN(S) ON NEW POST PER CITY STANDARD 662/664.
- REMOVE AND REPLACE EXISTING TRAFFIC SIGN POST PER CITY STANDARD DRAWING 664.
- RELOCATE EXISTING TRAFFIC SIGN ON NEW POST PER CITY STANDARD DRAWING 664.
- REMOVE AND SALVAGE EXISTING TRAFFIC SIGN TO CITY YARD.
- PROTECT IN PLACE EXISTING TRAFFIC SIGN.

#### LEGEND:



COLDMILL - CM1 (0.15') + ARAM (0.03') + DGAC PAVEMENT (0.12')




ARAM (0.03') + DGAC PAVEMENT (0.12')



PROPOSED PCC


# RIVERSIDE

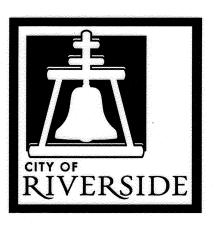

# CALIFORNIA

# **PUBLIC WORKS DEPARTMENT**

2016/2017 CDBG - WARD 5 STREET IMPROVEMENTS FOR LOS ARBOLES PLACE, LILA STREET, STELLA STREET, GLOREEN COURT AND GAY WAY A HUD FUNDED PROJECT

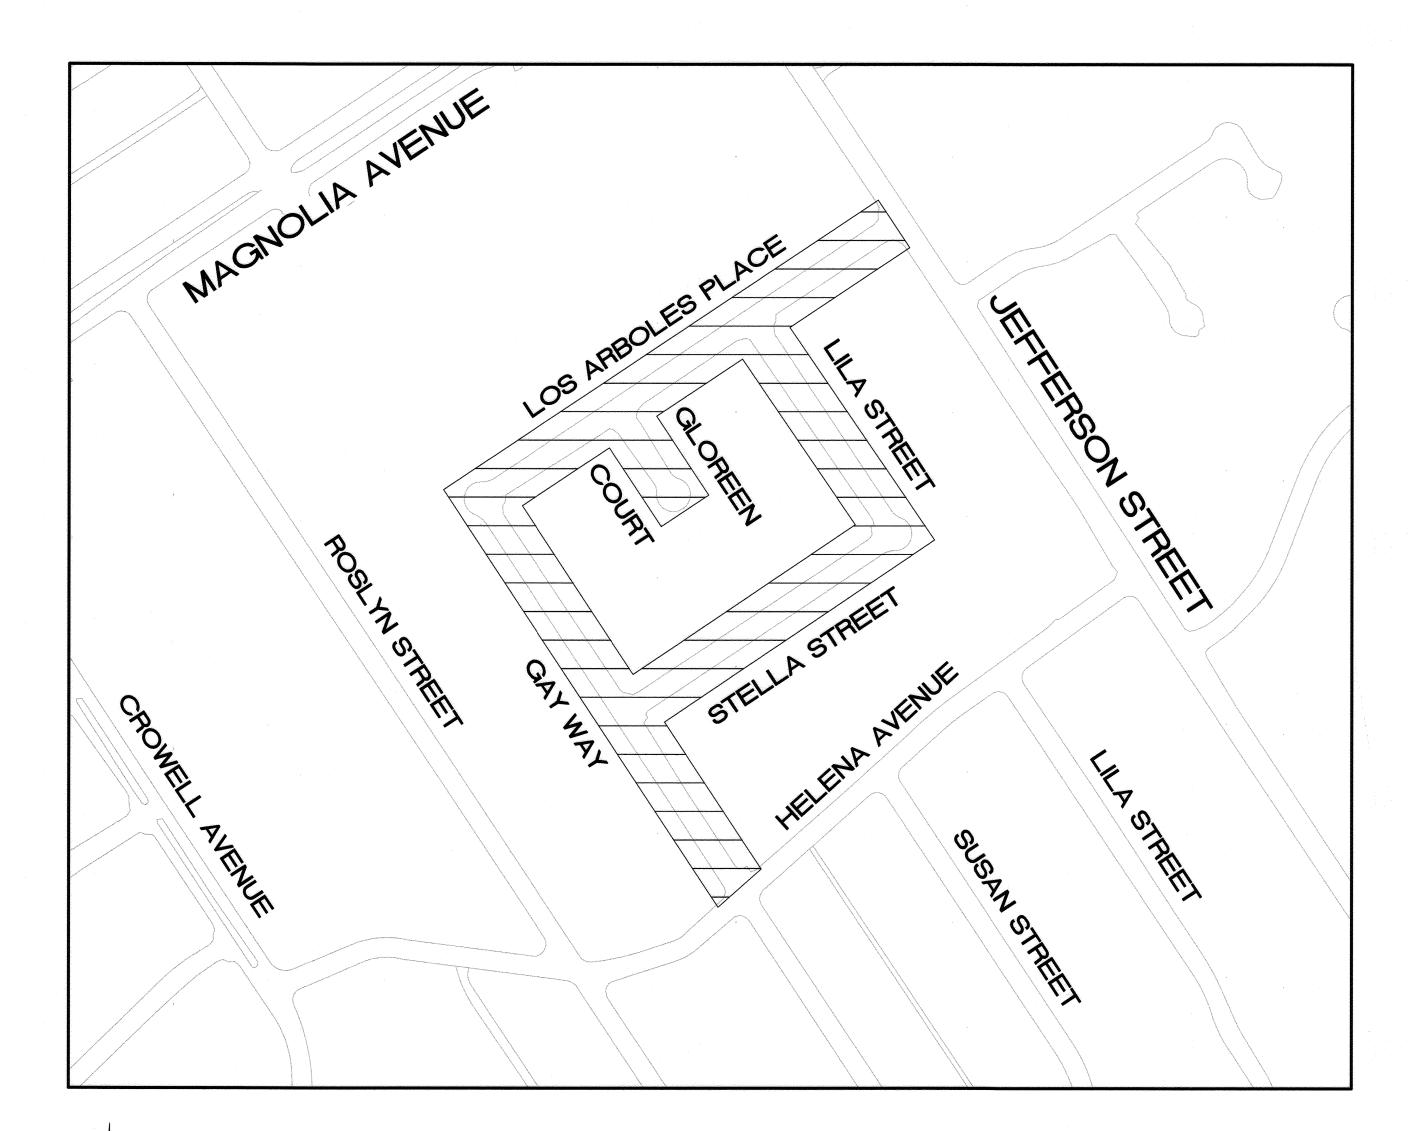

NTS

### SIGNING/STRIPING GENERAL NOTES:

- SIGNING AND STRIPING INSTALLATIONS SHALL CONFORM TO THE 2014 CALIFORNIA MANUAI ON UNIFORM TRAFFIC CONTROL DEVICES (CA MUTCD), THE STATE OF CALIFORNIA DEPARTMENT OF TRANSPORTATION (CALTRANS) STANDARD PLANS AND SPECIFICATIONS DATED 2010, AND ALL ADDENDUMS THERETO, AND THE CITY OF RIVERSIDE PUBLIC WORKS DEPARTMENT STANDARD DRAWINGS, CURRENT EDITION.
- ALL STRIPING, MARKINGS, AND LEGENDS SHALL BE REFLECTORIZED THERMOPLASTIC UNLESS OTHERWISE NOTED. THE CONTRACTOR SHALL PROVIDE AND INSTALL RAISED PAVEMENT MARKERS FOR ALL STRIPING. STRIPING. MARKINGS AND LEGENDS SHALL CONFORM TO THE LATEST CALTRANS STANDARD PLANS A20A THRU A20D AND A24A THRU A24E.
- PRIOR TO FINAL ACCEPTANCE OF STREET IMPROVEMENTS, ALL PAVEMENT STRIPING AND STENCILING WITHIN THE PERIMETER OF THE CONSTRUCTION AREA SHALL BE RESTORED TO LIKE NEW CONDITION, IN A MANNER MEETING THE APPROVAL OF THE CITY OF RIVERSIDE.
- THE CONTRACTOR SHALL RE-STRIPE EXISTING STRIPING AND CURB MARKINGS OBLITERATED
- SHALL PAINT THE NEW CURB AS SHOWN ON THE PLANS WITHIN 10 WORKING DAYS OF CURB CONSTRUCTION OR AS DIRECTED BY ENGINEER. THE PAINT SHALL BE WATER-BASED WITH 2-YEAR GUARANTEE AGAINST COLOR FADING. PRIOR TO THE START OF CONSTRUCTION, THE
- ALL NEW STRIPING SHALL BE "CAT TRACKED" AND APPROVED BY THE ENGINEER PRIOR TO FINAL INSTALLATION. THE CONTRACTOR SHALL NOTIFY THE ENGINEER AFTER COMPLETING LAYOUT AND AT LEAST 3 WORKING DAYS BEFORE COMMENCING INSTALLATION OF STRIPING, MARKINGS AND MARKERS.
- TRAFFIC SIGN FACE SHALL BE 3M DIAMOND GRADE DG3 REFLECTIVE SHEETING (ASTM XI) OR APPROVED EQUAL WITH PROTECTIVE GRAFFITI OVERLAY FILM OR AS OTHERWISE NOTED.
- 8. SIGNS SHALL BE STANDARD SIZE UNLESS NOTED OTHERWISE. PRIOR TO INSTALLATION, NEW SIGNS SHALL BE APPROVED BY THE CITY OF RIVERSIDE. EXACT LOCATIONS OF SIGNS SHALL BE DETERMINED BY THE CITY ENGINEER.
- 9. ALL EXISTING SIGNS AND POSTS TO BE REMOVED SHALL BE DELIVERED TO THE CITY OF
- 10. STRIPING SHALL BE APPLIED WITHIN 48 HOURS OF SURFACE COURSE REPLACEMENT ON STREETS OPEN TO THE PUBLIC. IN NO CASE SHALL A NEWLY PAVED STREET OPEN TO THE PUBLIC BE LEFT UNSTRIPED OVER A WEEKEND OR HOLIDAY.
- 11. CONTRACTOR SHALL INSTALL NEW SIGN(S) AND/OR POST(S) PER CITY OF RIVERSIDE STANDARD DRAWING No. 664, SEE SPECIFICATIONS.
- 12. CONTRACTOR SHALL INSTALL NEW STREET NAME SIGNS AND POST PER CITY OF RIVERSIDE STANDARD DRAWING No. 662, SEE SPECIFICATIONS.
- 13. ALL CONFLICTING STRIPING, PAVEMENT MARKINGS, LEGENDS, AND RAISED PAVEMENT MARKERS SHALL BE REMOVED EVEN IF NOT SHOWN ON PLANS. REMOVALS OF PAINTED STRIPING, PAVEMENT MARKINGS AND LEGENDS SHALL BE DONE BY WET SANDBLASTING. REMOVALS OF THERMOPLASTIC STRIPING, PAVEMENT MARKINGS AND LEGENDS SHALL BE REMOVED BY WET SANDBLASTING, GRINDING OR OTHER APPROVED METHOD AND SHALL NOT DAMAGE THE PAVEMENT. "BLACK OUT" OF EXISTING DELINEATION IS NOT PERMITTED. ALL DAMAGED PAVEMENT DUE TO REMOVALS SHALL BE REPAIRED AS NECESSARY TO MAINTAIN A SMOOTH AND UNIFORM SURFACE OR AS DIRECTED BY THE ENGINEER. ALL STRIPING REMOVALS AND LEGENDS SHALL BE "FOG SEALED".

### EXISTING TOPOGRAPHY:

SANITARY SEWER M.H.

STORM DRAIN M.H. © ELECTRIC M.H.

ETS ELECTRICAL TEST STATION (GAS)

W WATER M.H.

MM WATER METER

් FIRE HYDRANT

## SHEET INDEX: STREET IMPROVEMENTS

SHEET NO. DESCRIPTION

TITLE SHEET


MAINTENANCE PLAN

AS-BUILT 8-10-18 CITY OF RIVERSIDE. CALIFORNIA ONSTR. WORK ORDER NO.: 1718926

STREET IMPROVEMENTS 2016/2017 CDBG - WARD 5

R-4392 LOS ARBOLES PL, LILA ST, STELLA ST,

TITLE SHEET HORIZ. SCALE: N/A VERT. SCALE: N/A

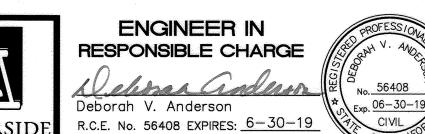

DATE 9/24/2017

DESIGNED BY \_\_\_\_\_DC \_\_\_\_DRAWN BY \_\_\_DC \_\_\_\_CHECKED BY \_\_\_\_DA

NGINEERING MANAGER E. L. 9.26.17 ONSTRUCTION ADMIN. 9126117 RAFFIC DIVISION TREETS SERVICES

URVEYOR

CITY ENGINEER DATE 9/27/17

DEPARTMENT OF PUBLIC WORKS

GAY WAY AND GLOREEN CT

SHEET 1 OF 2 FILE NAME: R4392-1.DWG

