


RIVERSIDE

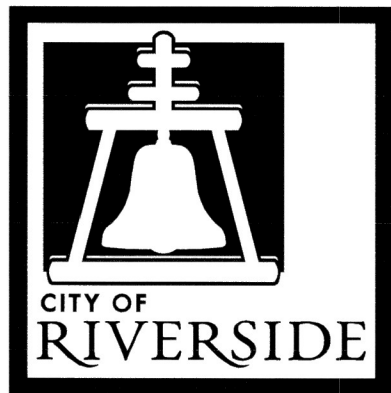

CALIFORNIA

GENERAL CONSTRUCTION NOTES:

1. THE CONTRACTOR SHALL PROVIDE AND MAINTAIN TRAFFIC CONTROL AS INDICATED IN THE ASSOCIATED PROJECT SPECIAL PROVISIONS.
2. CONSTRUCTION SHALL BE IN ACCORDANCE WITH THE CITY OF RIVERSIDE STANDARD DRAWINGS AND STANDARD SPECIFICATIONS FOR PUBLIC WORKS CONSTRUCTION, 2012 EDITION.
3. EXISTING UTILITIES SHOWN ON THIS PLAN ARE PLOTTED FROM UTILITY RECORDS. THE CONTRACTOR IS REQUIRED TO TAKE DUE PRECAUTIONARY MEASURES TO LOCATE AND PROTECT ALL UTILITIES WHETHER OR NOT SHOWN ON THIS PLAN.
4. CONFLICTING UTILITIES SHOWN WITHIN CONSTRUCTION AREA WILL BE RELOCATED PRIOR TO CONSTRUCTION.
5. ALL STREET PULL BOXES, AFFECTED BY CONSTRUCTION, SHALL BE ADJUSTED TO THE PROPOSED GRADE.
6. THE SEAM BETWEEN PASSES OF THE AC OVERLAY SHALL COINCIDE, AS CLOSE AS POSSIBLE, TO THE LANE LINES.
7. COLD MILLING SHALL BE AS DESCRIBED ON THE PLANS AND SPECIAL PROVISIONS OR AS DIRECTED BY THE ENGINEER.
8. ANY DISTRESSED EXISTING PAVEMENT SHALL BE REMOVED AND REPLACED AS DIRECTED BY THE ENGINEER AFTER COLD-MILLING AND PRIOR TO PLACEMENT OF DGAC.
9. CONTRACTOR SHALL REMOVE ALL VEGETATION WITHIN ALL SIDEWALK PANELS WITHIN THE PROJECT LIMITS.
10. ALL EXISTING IMPROVEMENTS SHOWN HEREON SHALL BE PROTECTED IN PLACE UNLESS OTHERWISE NOTED.
11. EXISTING IRRIGATION SHALL BE PROTECTED OR MODIFIED AS NECESSARY TO CONSTRUCT NEW CONCRETE IMPROVEMENTS.
12. ALL FENCE POSTS SHALL BE PROTECTED OR MODIFIED AS NECESSARY IF POST FOUNDATION IS WITHIN A SIDEWALK PANEL THAT HAS BEEN CALLED OUT FOR REPLACEMENT.

CONSTRUCTION NOTES:

- REMOVE AND REPLACE IN KIND EXISTING FACILITY, NUMBERS ABOVE 100 IN A HEXAGON ON THE PLAN REFER TO THE RESPECTIVE STANDARD DRAWING AND SHALL BE CONSTRUCTED ACCORDINGLY. ANY NOTE SHOWN BELOW THE STANDARD DRAWING NUMBER INDICATES THE SPECIFIC TYPE, ACTION, OR MODIFICATION TO BE CONSTRUCTED, WHERE NO MODIFICATION OR TYPE IS INDICATED, THE DIMENSIONS OF NEW FACILITY SHALL BE MODIFIED AS NECESSARY, EXCLUDING ADA REQUIREMENTS, TO MATCH EXISTING FACILITY REMOVED.
- PROTECT IN PLACE EXISTING FACILITY/EQUIPMENT, DESCRIPTION PER PLAN. (SGN)=TRAFFIC SIGN(S); (PST)=TRAFFIC SIGN POST; (ETS)=ELECTRIC TEST STATION.
- ADJUST TO GRADE, DESCRIPTION PER PLAN. (MH)=SEWER OR STORM DRAIN MANHOLE; (GV)=GATE VALVE; (ETS)=ELECTRIC TEST STATION; (WM)=WATER METER, REPLACE BOX AND LID AS NECESSARY.
- COLDMILL EXISTING AC TO A DEPTH OF 0.15' AT A WIDTH OF 10'.
- REMOVE AC TO A MINIMUM DEPTH OF 0.25' FROM GUTTER LIP TO A WIDTH OF 5'. REMOVAL OF BASE MAY BE NECESSARY TO PROVIDE 0.25' OF DGAC OVER EXISTING COMPACTED BASE.
- OVERLAY FROM GUTTER LIP TO GUTTER LIP WITH DGAC AT A DEPTH PER PLAN AFTER THE INSTALLATION OF THE ARAM MATERIAL.
- CONSTRUCT ASPHALT RUBBERIZED AGGREGATE MEMBRANE PRIOR TO AC PAVEMENT OVERLAY
- CONSTRUCT DGAC PAVEMENT AT A DEPTH PER PLAN AFTER THE FULL REMOVAL OF EXISTING AC TO PROVIDE A FINAL DEPTH OF A 3" PAVEMENT SECTION AFTER FINAL AC CAP.
- "M1" = CONSTRUCT NEW CONCRETE DRIVEWAY APPROACH PER CITY STANDARD 302 TYPE C-I, MODIFIED WITH 3" @ 14% FROM BACK OF CURB FOR THE APPROACH, NEXT 4' @ 2% FOR THE SIDEWALK TO THE R.O.W., FINALLY 14% TO MATCH CONCRETE DRIVEWAY AT THE EXISTING FACE OF STEEL GATES.
- "M2" = REMOVE HALF OF THE EXISTING DRIVEWAY APPROACH THAT IS DAMAGED AND REPLACE IN KIND.
- CONSTRUCT SIDEWALK PER CITY STANDARD 325, WITH A DEPTH OF 6".
- CONSTRUCT CONCRETE SIDEWALK PER CITY STANDARD WITHIN THE AREA REMOVED FROM THE PEDESTRIAN RAMP TO THE FULL HEIGHT CURB
- REMOVE EXISTING PEDESTRIAN RAMP AND CURB DEPRESSION.

EXISTING TOPOGRAPHY:

- |   |                     |   |                               |
|---|---------------------|---|-------------------------------|
| ⊙ | SANITARY SEWER M.H. | ⊙ | GATE VALVE                    |
| ⊙ | STORM DRAIN M.H.    | ⊙ | ELECTRICAL TEST STATION (GAS) |
| ⊙ | ELECTRIC M.H.       | ⊙ | FIRE HYDRANT                  |
| ⊙ | WATER M.H.          | ⊙ | WATER METER                   |

PUBLIC WORKS DEPARTMENT  
2018/2019 CDBG - WARD 5  
STREET IMPROVEMENTS FOR  
HAYES STREET FROM MYERS STREET TO ROOSEVELT STREET  
AND TAFT STREET/MYERS STREET  
FROM HAYES STREET TO MAGNOLIA AVENUE  
A HUD FUNDED PROJECT



LOCATION MAP

NTS

SIGNING/STRIPING GENERAL NOTES:

1. SIGNING AND STRIPING INSTALLATIONS SHALL CONFORM TO THE 2014 CALIFORNIA MANUAL ON UNIFORM TRAFFIC CONTROL DEVICES (CA MUTCD), THE STATE OF CALIFORNIA DEPARTMENT OF TRANSPORTATION (CALTRANS) STANDARD PLANS AND SPECIFICATIONS DATED 2018, AND ALL ADDENDUMS THERETO, AND THE CITY OF RIVERSIDE PUBLIC WORKS DEPARTMENT STANDARD DRAWINGS, CURRENT EDITION.
2. ALL STRIPING, MARKINGS, AND LEGENDS SHALL BE REFLECTORIZED THERMOPLASTIC UNLESS OTHERWISE NOTED. THE CONTRACTOR SHALL PROVIDE AND INSTALL RAISED PAVEMENT MARKERS FOR ALL STRIPING. STRIPING, MARKINGS AND LEGENDS SHALL CONFORM TO THE LATEST CALTRANS STANDARD PLANS A20A THRU A20D AND A24A THRU A24E.
3. PRIOR TO FINAL ACCEPTANCE OF STREET IMPROVEMENTS, ALL PAVEMENT STRIPING AND STENCILING WITHIN THE PERIMETER OF THE CONSTRUCTION AREA SHALL BE RESTORED TO LIKE NEW CONDITION, IN A MANNER MEETING THE APPROVAL OF THE CITY OF RIVERSIDE.
4. THE CONTRACTOR SHALL RE-STRIPE EXISTING STRIPING AND CURB MARKINGS OBLITERATED BY NEW CONSTRUCTION, WHETHER OR NOT SHOWN ON THE PLANS FOR REPLACEMENT, AT NO COST TO THE CITY.
5. AT LOCATIONS WHERE EXISTING PAINTED CURB IS TO BE RECONSTRUCTED, THE CONTRACTOR SHALL PAINT THE NEW CURB AS SHOWN ON THE PLANS WITHIN 10 WORKING DAYS OF CURB CONSTRUCTION OR AS DIRECTED BY ENGINEER. THE PAINT SHALL BE WATER-BASED WITH 2-YEAR GUARANTEE AGAINST COLOR FADING. PRIOR TO THE START OF CONSTRUCTION, THE CONTRACTOR SHALL SUBMIT TO THE CITY WRITTEN PROOF OF THE MANUFACTURER'S 2-YEAR GUARANTEE.
6. ALL NEW STRIPING SHALL BE "CAT TRACKED" AND APPROVED BY THE ENGINEER PRIOR TO FINAL INSTALLATION. THE CONTRACTOR SHALL NOTIFY THE ENGINEER AFTER COMPLETING LAYOUT AND AT LEAST 3 WORKING DAYS BEFORE COMMENCING INSTALLATION OF STRIPING, MARKINGS AND MARKERS.
7. TRAFFIC SIGN FACE SHALL BE 3M DIAMOND GRADE DG3 REFLECTIVE SHEETING (ASTM XI) OR APPROVED EQUAL WITH PROTECTIVE GRAFFITI OVERLAY FILM OR AS OTHERWISE NOTED.
8. SIGNS SHALL BE STANDARD SIZE UNLESS NOTED OTHERWISE. PRIOR TO INSTALLATION, NEW SIGNS SHALL BE APPROVED BY THE CITY OF RIVERSIDE. EXACT LOCATIONS OF SIGNS SHALL BE DETERMINED BY THE CITY ENGINEER.
9. ALL EXISTING SIGNS AND POSTS TO BE REMOVED SHALL BE DELIVERED TO THE CITY OF RIVERSIDE SIGN DEPARTMENT.
10. STRIPING SHALL BE APPLIED WITHIN 48 HOURS OF SURFACE COURSE REPLACEMENT ON STREETS OPEN TO THE PUBLIC. IN NO CASE SHALL A NEWLY PAVED STREET OPEN TO THE PUBLIC BE LEFT UNSTRIPED OVER A WEEKEND OR HOLIDAY.
11. CONTRACTOR SHALL INSTALL NEW SIGN(S) AND/OR POST(S) PER CITY OF RIVERSIDE STANDARD DRAWING No. 664, SEE SPECIFICATIONS.
12. CONTRACTOR SHALL INSTALL NEW STREET NAME SIGNS AND POST PER CITY OF RIVERSIDE STANDARD DRAWING No. 662, SEE SPECIFICATIONS.
13. ALL CONFLICTING STRIPING, PAVEMENT MARKINGS, LEGENDS, AND RAISED PAVEMENT MARKERS SHALL BE REMOVED EVEN IF NOT SHOWN ON PLANS. REMOVALS OF PAINTED STRIPING, PAVEMENT MARKINGS AND LEGENDS SHALL BE DONE BY WET SANDBLASTING. REMOVALS OF THERMOPLASTIC STRIPING, PAVEMENT MARKINGS AND LEGENDS SHALL BE REMOVED BY WET SANDBLASTING, GRINDING OR OTHER APPROVED METHOD AND SHALL NOT DAMAGE THE PAVEMENT. "BLACK OUT" OF EXISTING DELINEATION IS NOT PERMITTED. ALL DAMAGED PAVEMENT DUE TO REMOVALS SHALL BE REPAIRED AS NECESSARY TO MAINTAIN A SMOOTH AND UNIFORM SURFACE OR AS DIRECTED BY THE ENGINEER. ALL STRIPING REMOVALS AND LEGENDS SHALL BE "FOG SEALED".

LEGEND:


- |   |                                     |
|---|-------------------------------------|
| COLDMILL - CM1 (0.15') + ARAM (0.03') + DGAC PAVEMENT (0.12')                                       | ARAM (0.03') + FINAL AC CAP (0.12') |
| FULL DEPTH REMOVAL - CM3 (0.25' MIN.) + DGAC PAVEMENT (0.10') + ARAM (0.03') + FINAL AC CAP (0.12') | PROPOSED PCC                        |

SHEET INDEX:




SHEET NO.	DESCRIPTION
1	TITLE SHEET/LOCATION MAP
2	MAINTENANCE PLAN
3	SIGNING/STRIPING PLAN

	ENGINEER IN RESPONSIBLE CHARGE Edward Lara R.C.E. No. 63753 EXPIRES: 9-30-20 DATE: July 24, 2020		CITY OF RIVERSIDE, CALIFORNIA DEPARTMENT OF PUBLIC WORKS				STREET IMPROVEMENTS 2018/2019 CDBG - WARD 5 HAYES STREET FROM MYERS STREET TO ROOSEVELT STREET AND TAFT STREET/MYERS STREET FROM HAYES STREET TO MAGNOLIA AVENUE TITLE SHEET		DESIGN WORK ORDER NO.: 2028062 CONSTR. WORK ORDER NO.: 2028072
			APPROVED BY ENGINEERING MANAGER CONSTRUCTION ADMIN. TRAFFIC DIVISION STREETS SERVICES SURVEYOR	BY JN JC NM CS	DATE 8/7/20 8-6-20 8/6/20 8/6/20	APPROVED BY CITY ENGINEER DATE August 6, 2020	HORIZ. SCALE: N/A VERT. SCALE: N/A	R-4513 SHEET 1 OF 3 FILE NAME: R4513-1.DWG	




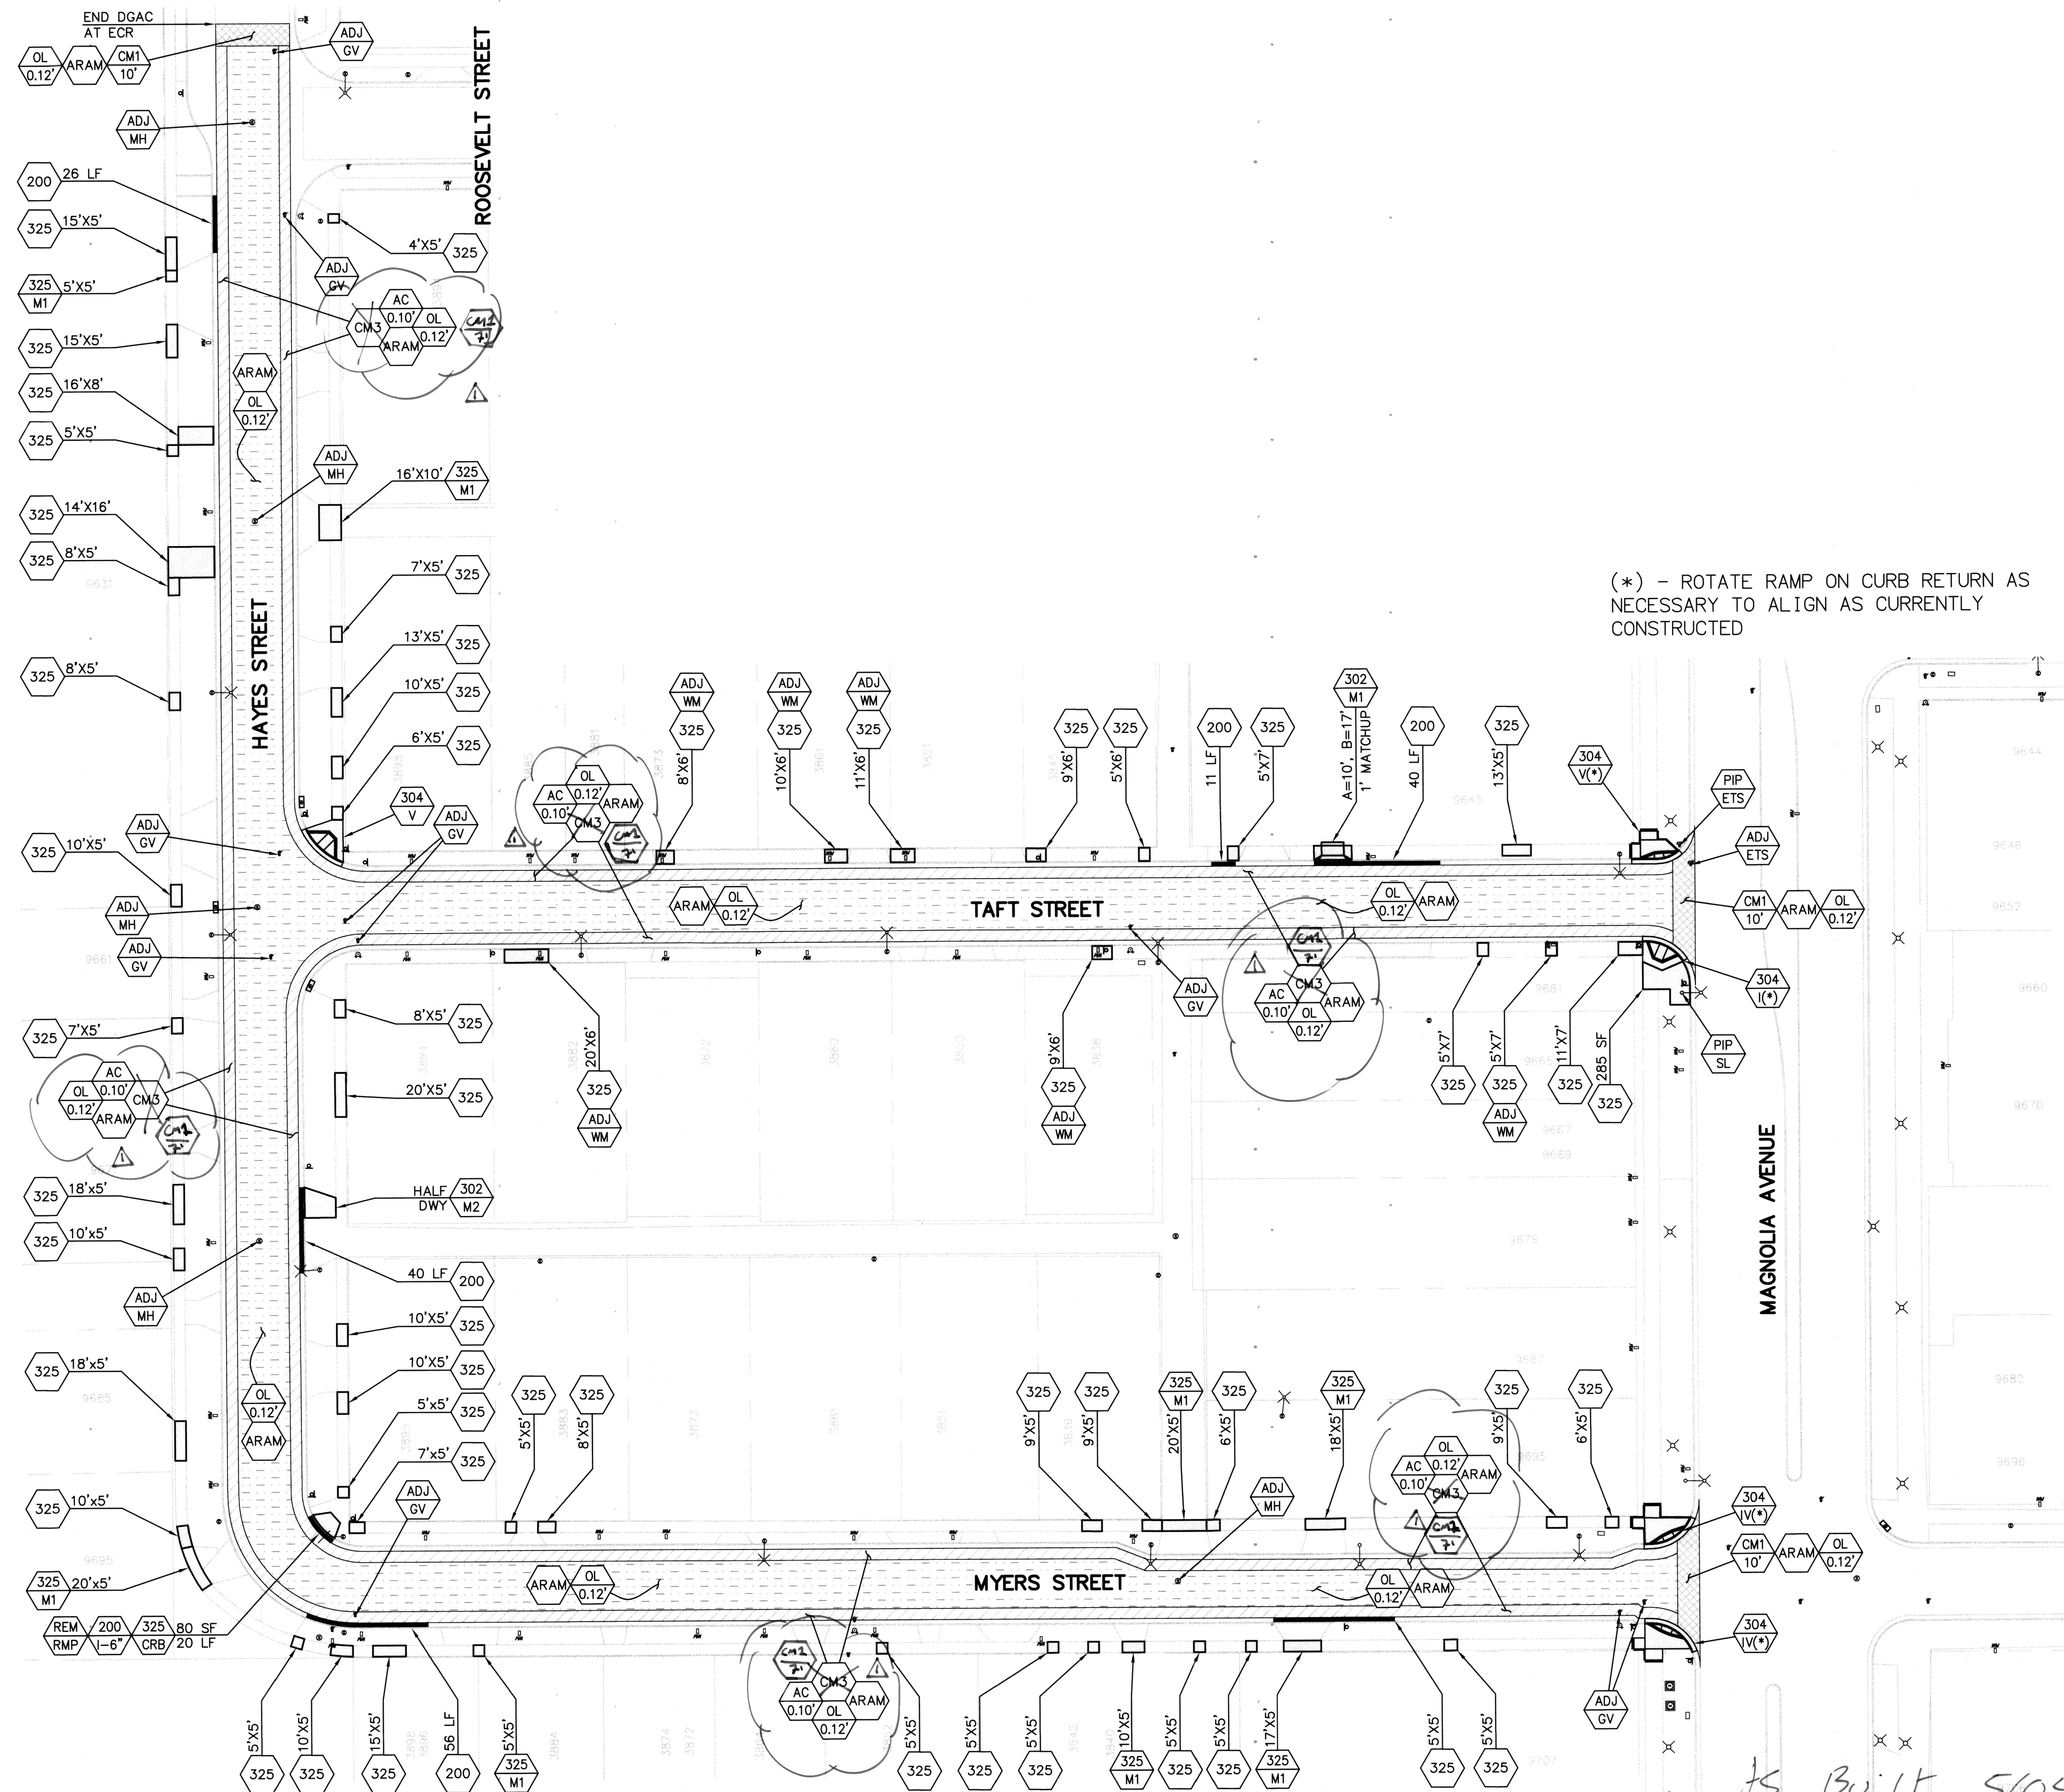

(\*) - ROTATE RAMP ON CURB RETURN AS NECESSARY TO ALIGN AS CURRENTLY CONSTRUCTED

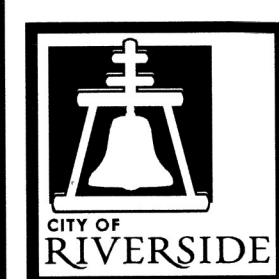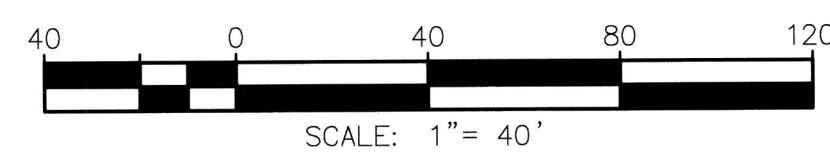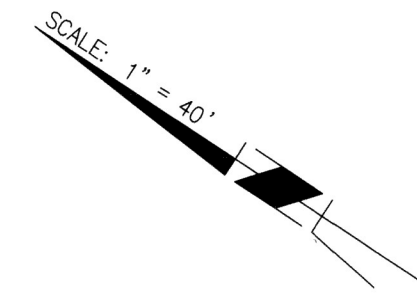

**ENGINEER IN RESPONSIBLE CHARGE**  
*Edward Lara*  
Edward Lara  
R.C.E. No. 63753 EXPIRES: 9-30-20  
DATE: July 24, 2020

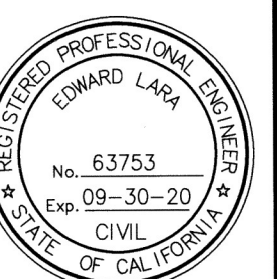


DESIGNED BY	DC	DRAWN BY	DC	CHECKED BY	EL
APPROVED BY	CONSTRUCTION ADMIN.	DATE	8/16/20	APPR.	DATE
TRAFFIC DIVISION	STREETS SERVICES	SURVEYOR	CS	DATE	8/16/20

**CITY OF RIVERSIDE, CALIFORNIA**  
**DEPARTMENT OF PUBLIC WORKS**  
APPROVED BY: *FM* BY: *DC* DATE: 8/17/20  
CONSTRUCTION ADMIN. *DC* DATE: 8/16/20  
TRAFFIC DIVISION *NM*  
STREETS SERVICES *CS* DATE: 8/16/20  
SURVEYOR

**STREET IMPROVEMENTS**  
**2018/2019 CDBG - WARD 5**  
HAYES STREET  
FROM MYERS STREET TO ROOSEVELT STREET  
AND TAFT STREET/MYERS STREET  
FROM HAYES STREET TO MAGNOLIA AVENUE  
**MAINTENANCE PLAN**  
HORIZ. SCALE: 1"=40' VERT. SCALE: N/A




DESIGN WORK ORDER NO.: 2028062  
CONSTR. WORK ORDER NO.: 2028072  
**R-4513**  
SHEET 2 OF 3  
FILE NAME: R4513-2.DWG



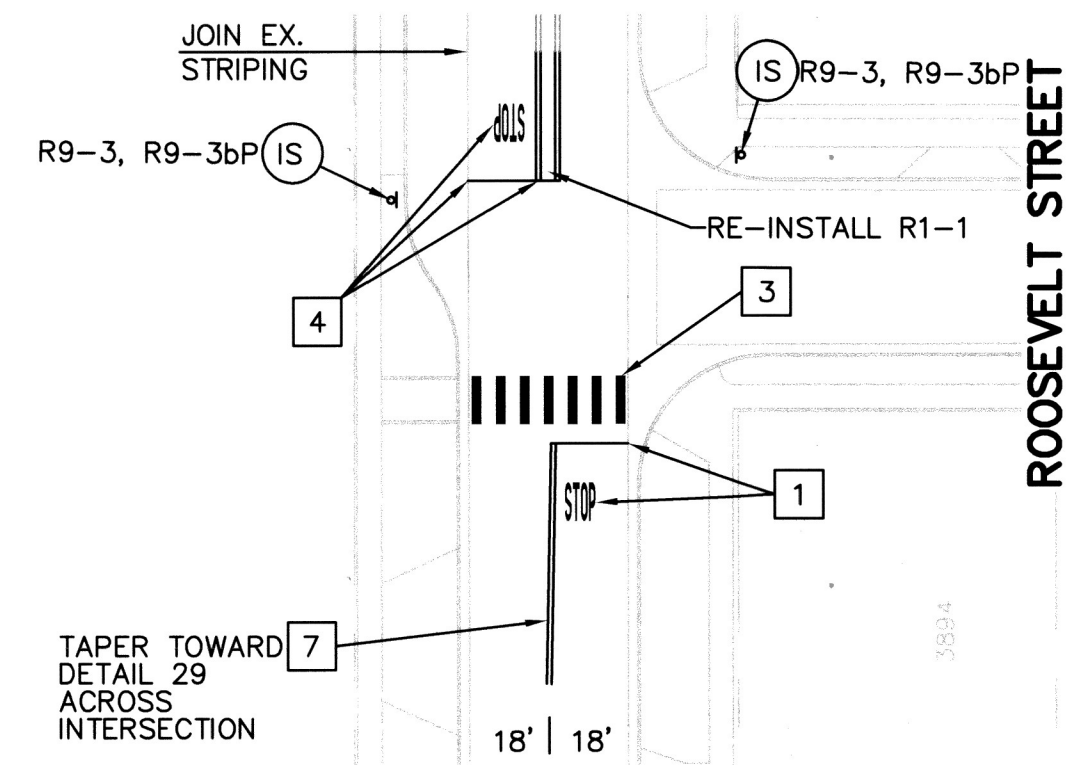

# SIGNING/STRIPING NOTES:

- (IS) INSTALL NEW TRAFFIC SIGN(S) ON NEW POST PER CITY STANDARD 662/664. NEW SIGNS TO BE MOUNTED ON EXISTING STREET LIGHTS SHALL BE STRAP MOUNTED (SUPPLIED BY CONTRACTOR)
- (RS) REMOVE AND SALVAGE EXISTING TRAFFIC SIGN TO CITY YARD.
- (RR) REMOVE AND REPLACE TRAFFIC SIGN POST ONLY, REUSE EXISTING SIGNAGE.
- (RL) RELOCATE TRAFFIC SIGN(S) AND INSTALL NEW POST.
- 1 INSTALL 12" SOLID WHITE LIMIT LINE AND "STOP" LEGEND, LOCATION VERIFIED BY ENGINEER
- 2 INSTALL DETAIL 2 ALONG THE STREET CENTERLINE
- 3 INSTALL YELLOW CONTINENTAL CROSSWALK, TO ALIGN WITH BOTH PEDESTRIAN RAMPS. SEE DETAIL.
- 4 INSTALL 12" SOLID WHITE LIMIT LINE AND "STOP" LEGEND, AND DETAIL 29 (MATCH EXISTING WIDTH)
- 5 INSTALL DETAIL 22, EQUIDISTANT FOR 150' TO BCR ON MYERS STREET, THEN TRANSITION TO 18' FROM CURB FACE ON THE INSIDE OF THE ELBOW, AND TRANSITION BACK EQUIDISTANT ON HAYES STREET TO TERMINATE AT THE MOC AT TAFT STREET.
- 6 INSTALL SOLID YELLOW "SCHOOL" LEGEND ADJACENT TO SCHOOL SIGNAGE
- 7 INSTALL 50' DETAIL 22
- 8 INSTALL DETAIL 2, BEGINNING AT NOTE #5, EQUIDISTANT ON TAFT STREET, TRANSITIONING WITH THE STREET WIDTH.
- PIP XX PROTECT IN PLACE EXISTING EQUIPMENT, DESCRIPTION PER PLAN. (SGN)=TRAFFIC SIGN(S); (PST)=TRAFFIC SIGN POST.

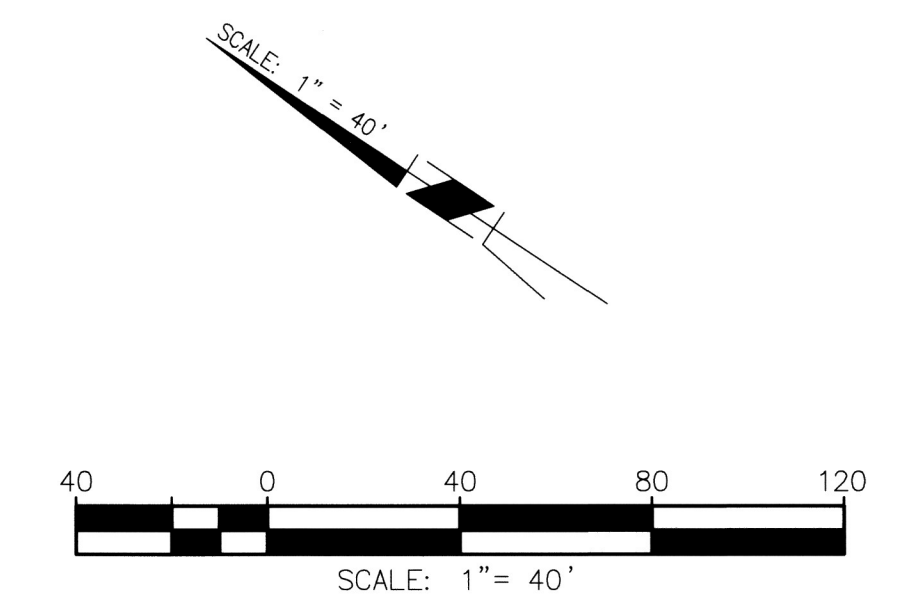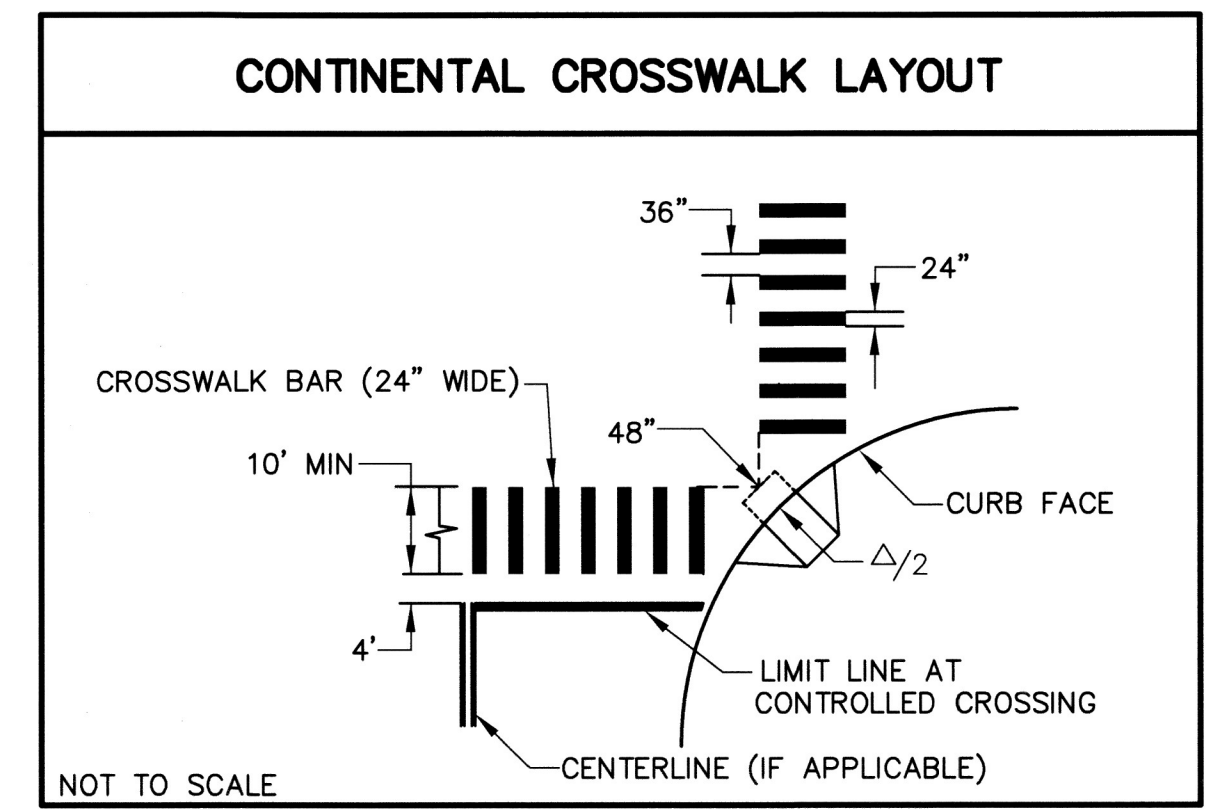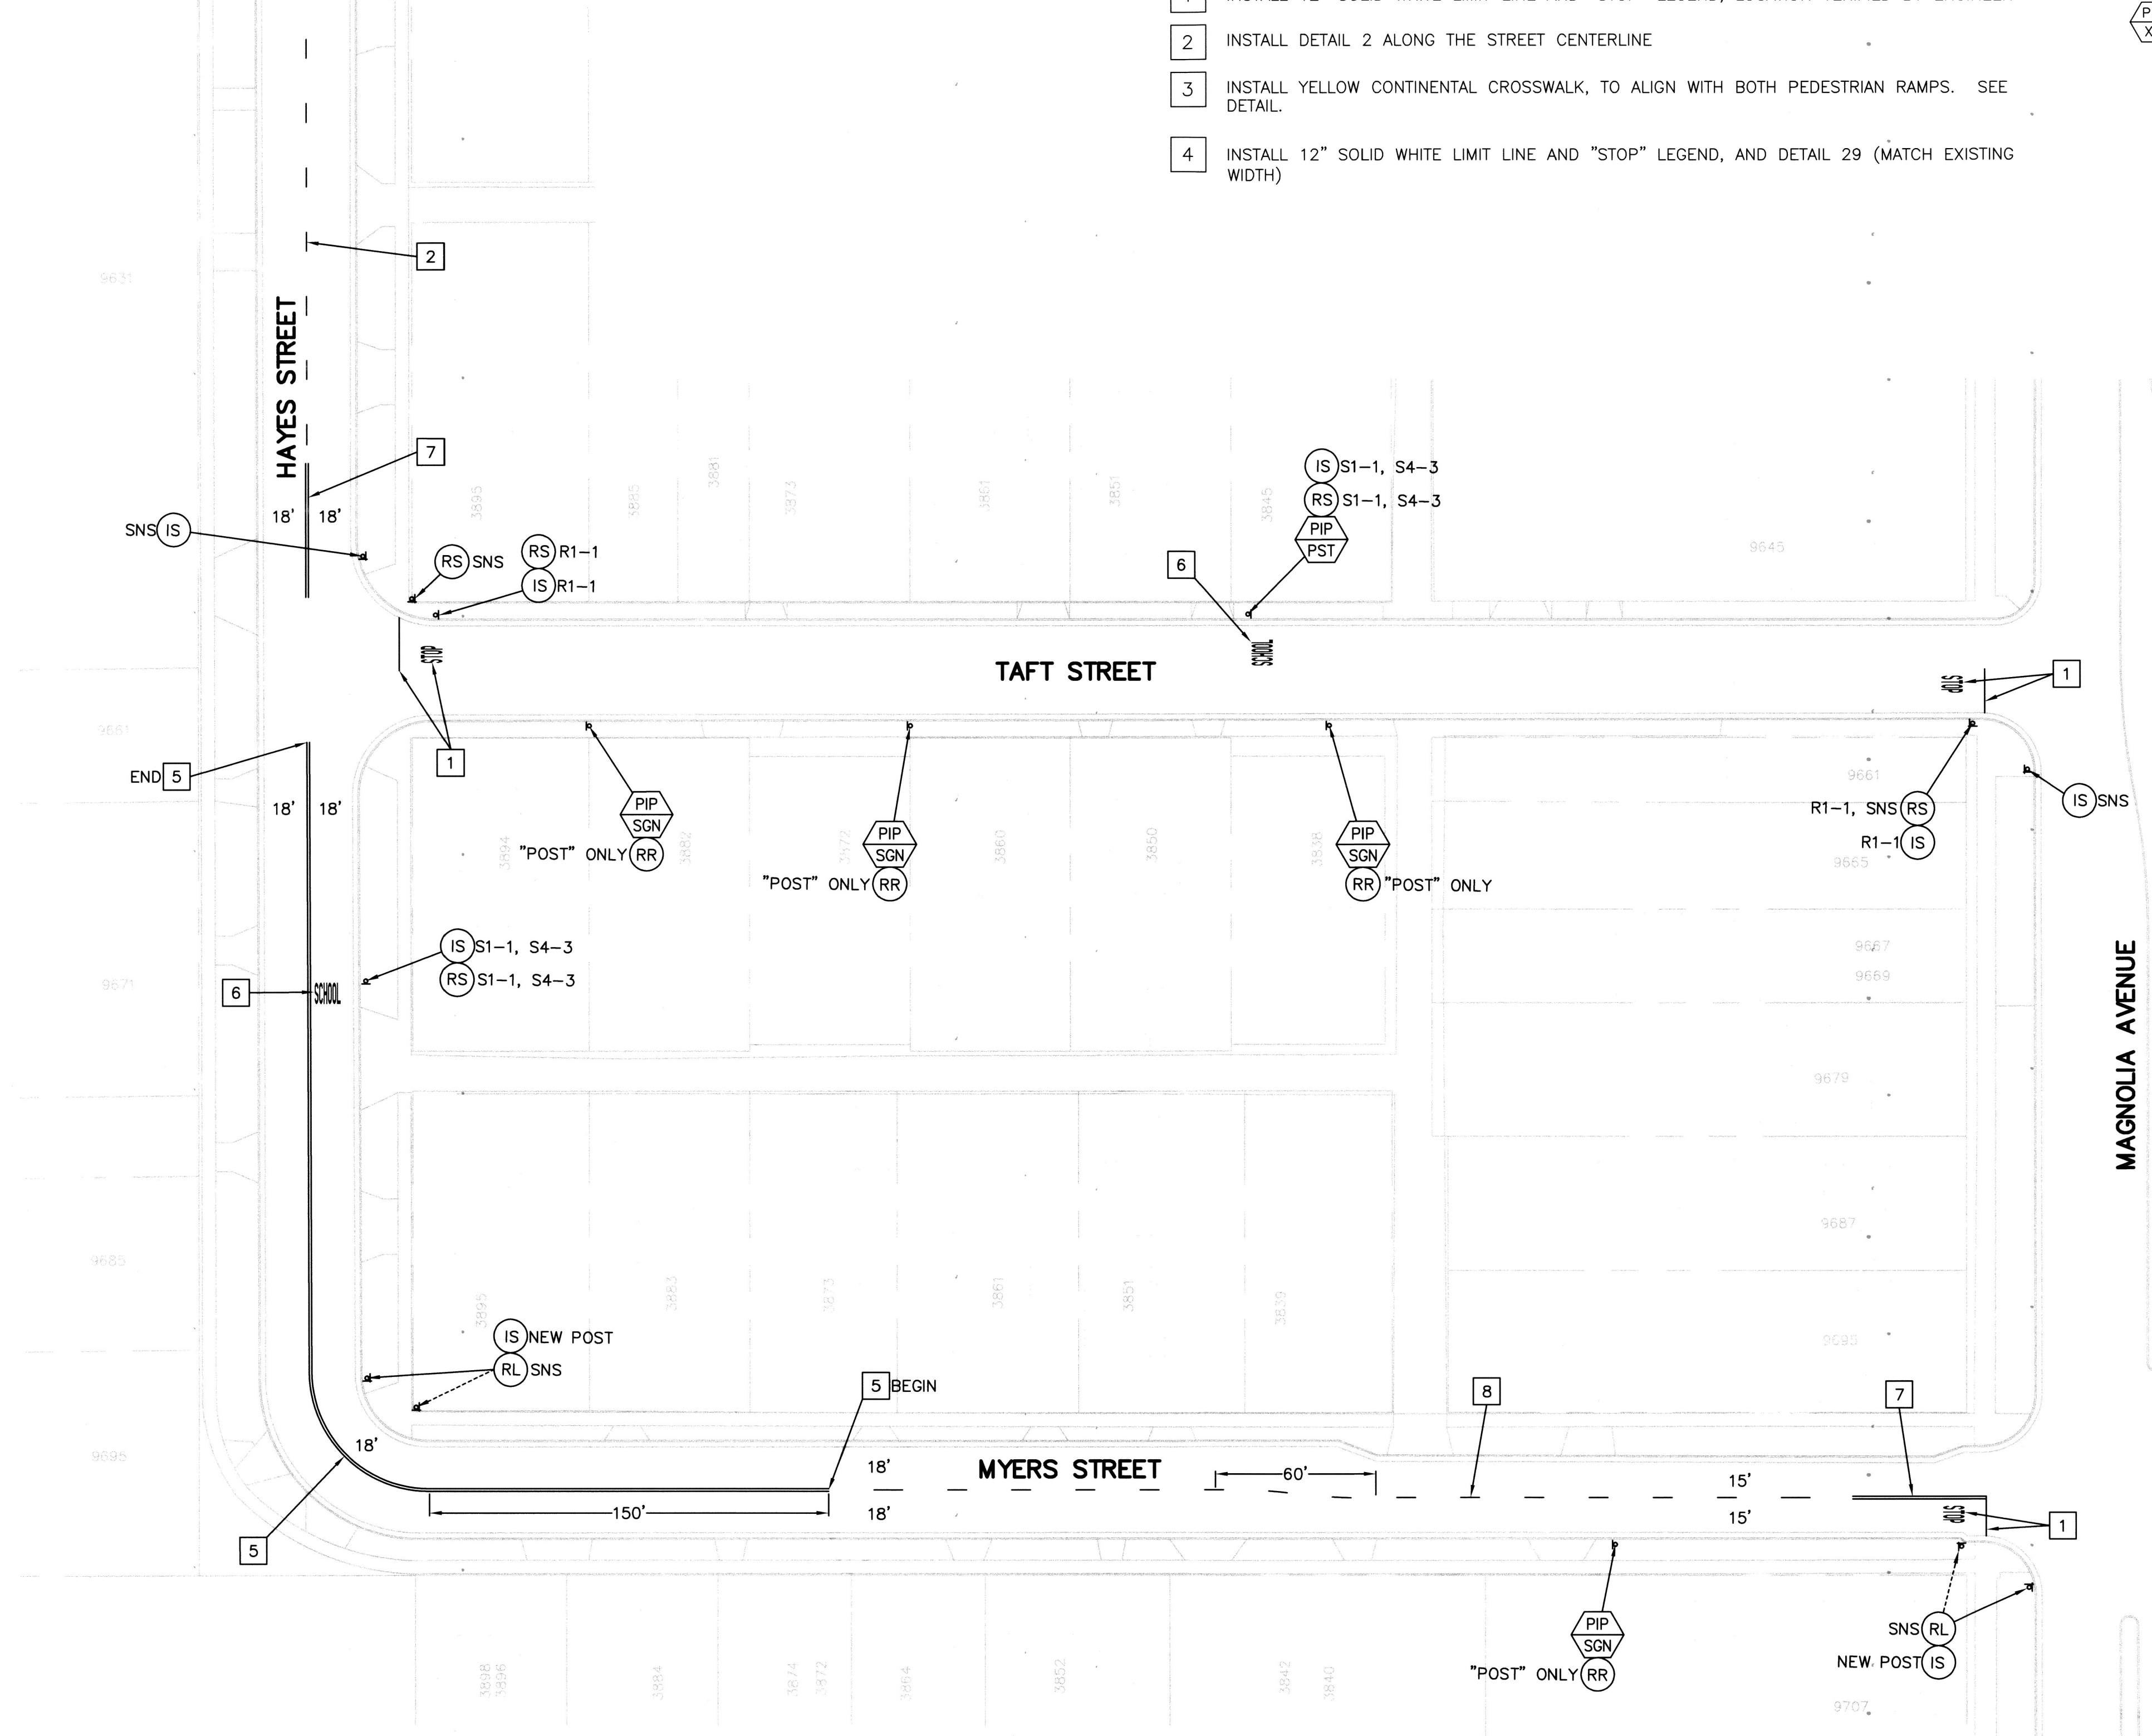

AS BUILT 5/04/23 B.O

<b>ENGINEER IN RESPONSIBLE CHARGE</b> Nathan Mustafa R.C.E. No. 83654 EXPIRES: 3-31-21 DATE 8-6-2020		<b>CITY OF RIVERSIDE, CALIFORNIA</b> <b>DEPARTMENT OF PUBLIC WORKS</b>				<b>STREET IMPROVEMENTS</b> <b>2018/2019 CDBG - WARD 5</b> <b>HAYES STREET</b> <b>FROM MYERS STREET TO ROOSEVELT STREET</b> <b>AND TAFT STREET/MYERS STREET</b> <b>FROM HAYES STREET TO MAGNOLIA AVENUE</b> <b>SIGNING/STRIPING PLAN</b>		DESIGN WORK ORDER NO.: 2028062 CONSTR. WORK ORDER NO.: 2028072
		APPROVED BY	BY	DATE	APPROVED BY	DATE	<b>R-4513</b> SHEET <b>3</b> OF <b>3</b> FILE NAME: R4513-3.DWG	
		ENGINEERING MANAGER	FM	8/7/20	CITY ENGINEER	8/6/20		
		CONSTRUCTION ADMIN.	DC	8/6/20				
		TRAFFIC DIVISION	NM	8/6/20				
STREETS SERVICES	CS	8/6/20						
DESIGNED BY: DC DRAWN BY: DC CHECKED BY: NM		DATE: August 4, 2020		HORIZ. SCALE: 1"=40' VERT. SCALE: N/A				