
RIVERSIDE

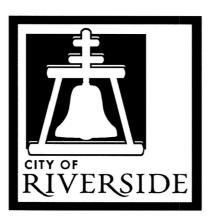

PUBLIC WORKS DEPARTMENT

2019/2020 CDBG - WARD 7

STREET IMPROVEMENTS FOR

CALIFORNIA

GENERAL CONSTRUCTION NOTES:

- THE CONTRACTOR SHALL PROVIDE AND MAINTAIN TRAFFIC CONTROL AS INDICATED THE ASSOCIATED PROJECT SPECIAL PROVISIONS.
- CONSTRUCTION SHALL BE IN ACCORDANCE WITH THE CITY OF RIVERSIDE STANDARD DRAWINGS AND STANDARD SPECIFICATIONS FOR PUBLIC WORKS CONSTRUCTION, 2012
- EXISTING UTILITIES SHOWN ON THIS PLAN ARE PLOTTED FROM UTILITY RECORDS. THE CONTRACTOR IS REQUIRED TO TAKE DUE PRECAUTIONARY MEASURES TO LOCATE AND PROTECT ALL UTILITIES WHETHER OR NOT SHOWN ON THIS PLAN.
- CONFLICTING UTILITIES SHOWN WITHIN CONSTRUCTION AREA WILL BE RELOCATED PRIOR
- ALL STREET PULL BOXES, AFFECTED BY CONSTRUCTION, SHALL BE ADJUSTED TO THE
- THE SEAM BETWEEN PASSES OF THE AC OVERLAY SHALL COINCIDE, AS CLOSE AS POSSIBLE, TO THE LANE LINES.
- 7. COLD MILLING SHALL BE AS DESCRIBED ON THE PLANS AND SPECIAL PROVISIONS OR AS DIRECTED BY THE ENGINEER.
- ANY DISTRESSED EXISTING PAVEMENT SHALL BE REMOVED AND REPLACED AS DIRECTED BY THE ENGINEER AFTER COLD-MILLING AND PRIOR TO PLACEMENT OF DGAC
- CONTRACTOR SHALL REMOVE ALL VEGETATION WITHIN ALL SIDEWALK PANELS WITHIN THE PROJECT LIMITS.
- 10. ALL EXISTING IMPROVEMENTS SHOWN HEREON SHALL BE PROTECTED IN PLACE UNLESS
- 11. EXISTING IRRIGATION SHALL BE PROTECTED OR MODIFIED AS NECESSARY TO CONSTRUCT NEW CONCRETE IMPROVEMENTS.
- 12. ALL FENCE POSTS SHALL BE PROTECTED OR MODIFIED AS NECESSARY IF POST FOUNDATION IS WITHIN A SIDEWALK PANEL THAT HAS BEEN CALLED OUT FOR REPLACEMENT.

CONSTRUCTION NOTES:


- REMOVE AND REPLACE IN KIND EXISTING FACILITY, NUMBERS ABOVE 100 IN A HEXAGON ON THE PLAN REFER TO THE RESPECTIVE STANDARD DRAWING AND SHALL BE CONSTRUCTED ACCORDINGLY. ANY NOTE SHOWN BELOW THE STANDARD DRAWING NUMBER INDICATES THE SPECIFIC TYPE, ACTION, OR MODIFICATION TO BE CONSTRUCTED. WHERE NO MODIFICATION OR TYPE IS INDICATED, THE DIMENSIONS OF NEW FACILITY SHALL BE MODIFIED AS NECESSARY, EXCLUDING ADA REQUIREMENTS, TO MATCH EXISTING FACILITY REMOVED.
- ADJUST TO GRADE, DESCRIPTION PER PLAN. (MH)=SEWER OR STORM DRAIN MANHOLE: (GV)=GATE VALVE; (ETS)=ELECTRIC TEST STATION; (CO)=CLEAN OUT.
- PROTECT IN PLACE, DESCRIPTION PER PLAN. (PST)=TRAFFIC SIGN POST; (WM)=WATER METER;
- (CB)=CATCH BASIN; (DWY)=DRIVEWAY. PROVIDE VARIABLE DEPTH COLDMILLING TO TRANSITION FROM 0.15' AT GUTTER LIP/JOINT TO O'
- OVERLAY AREA WITH DGAC AT A DEPTH PER PLAN.

 \backslash XX/ DEPTH AT THE 5'-10' MILL WIDTH INDICATED.

- CONSTRUCT ASPHALT RUBBERIZED AGGREGATE MEMBRANE PRIOR TO AC PAVEMENT OVERLAY
- REMOVE AND REPLACE WATER METER BOX AND LID WITH A NEW CITY SUPPLIED BOX AND LID.
- INSTALL NEW TRAFFIC SIGN(S) ON NEW POST PER CITY STANDARD 662/664. NEW SIGNS TO BE MOUNTED ON EXISTING STREET LIGHTS SHALL BE STRAP MOUNTED (SUPPLIED BY CONTRACTOR)
- (RS) REMOVE AND SALVAGE EXISTING TRAFFIC SIGN TO CITY YARD.
- 1 INSTALL 12" SOLID WHITE LIMIT LINE AND "STOP" LEGEND, LOCATION VERIFIED BY ENGINEER

BREINER COURT, ORIOLE DRIVE, AND BLUE JAY DRIVE FROM LA SIERRA AVENUE TO END OF STREET; AND **NORWALK COURT** FROM CAMPBELL AVENUE TO END OF STREET

A HUD FUNDED PROJECT

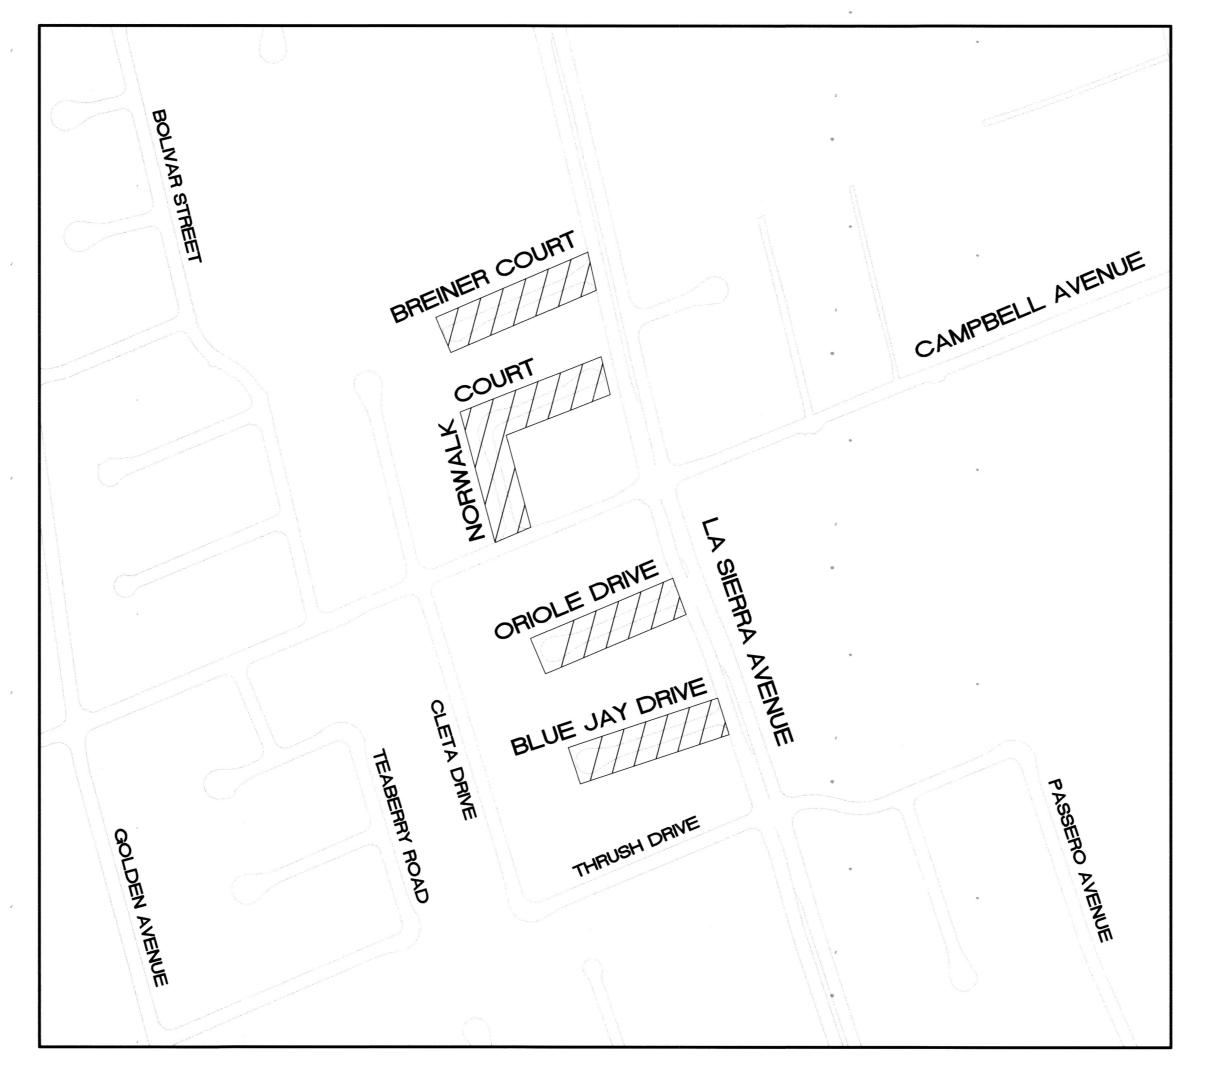

ENGINEER IN RESPONSIBLE CHARGE E_{xp} . 09 - 30 - 22Edward Lara R.C.E. No. 63753 EXPIRES: 9-30-22DATE September 11, 2010

_ DRAWN BY ___DC ____CHECKED BY ___EL SURVEYOR

CITY OF RIVERSIDE. CALIFORNIA DEPARTMENT OF PUBLIC WORKS 9.15.20 NGINEERING MANAGER ONSTRUCTION ADMIN. DC 9.14.20 RAFFIC DIVISION 9.14.20 Nh

9/17/20

DATE **550. 16, 2020**

As Built 5/10/23 B.O STREET IMPROVEMENTS 2019/2020 CDBG - WARD 7 BREINER COURT/ORIOLE DRIVE/BLUE JAY DRIVE FROM LA SIERRA AVENUE TO END OF STREET AND NORWALK COURT FROM CAMPBELL AVENUE TO END OF STREET

SIGNING/STRIPING GENERAL NOTES:

LATEST CALTRANS STANDARD PLANS A20A THRU A20D AND A24A THRU A24E

DEPARTMENT STANDARD DRAWINGS, CURRENT EDITION.

MARKINGS AND MARKERS.

BE DETERMINED BY THE CITY ENGINEER.

PUBLIC BE LEFT UNSTRIPED OVER A WEEKEND OR HOLIDAY.

COLDMILL - CM1 (0.15') + ARAM (0.03')

ARAM (0.03') + DGAC PAVEMENT (0.12')

+ DGAC PAVEMENT (0.12')

STANDARD DRAWING No. 664, SEE SPECIFICATIONS.

STANDARD DRAWING No. 662, SEE SPECIFICATIONS.

LEGENDS SHALL BE "FOG SEALED".

LEGEND:

SIGNING AND STRIPING INSTALLATIONS SHALL CONFORM TO THE 2014 CALIFORNIA MANUAL

2. ALL STRIPING, MARKINGS, AND LEGENDS SHALL BE REFLECTORIZED THERMOPLASTIC UNLESS

3. PRIOR TO FINAL ACCEPTANCE OF STREET IMPROVEMENTS, ALL PAVEMENT STRIPING AND

LIKE NEW CONDITION, IN A MANNER MEETING THE APPROVAL OF THE CITY OF RIVERSIDE.

4. THE CONTRACTOR SHALL RE-STRIPE EXISTING STRIPING AND CURB MARKINGS OBLITERATED

ON UNIFORM TRAFFIC CONTROL DEVICES (CA MUTCD), THE STATE OF CALIFORNIA

DEPARTMENT OF TRANSPORTATION (CALTRANS) STANDARD PLANS AND SPECIFICATIONS DATED 2018, AND ALL ADDENDUMS THÈRETO, AND THE CITY OF RIVERSIDE PUBLIC WORKS

OTHERWISE NOTED. THE CONTRACTOR SHALL PROVIDE AND INSTALL RAISED PAVEMENT MARKERS FOR ALL STRIPING. STRIPING, MARKINGS AND LEGENDS SHALL CONFORM TO THE

STENCILING WITHIN THE PERIMETER OF THE CONSTRUCTION AREA SHALL BE RESTORED TO

BY NEW CONSTRUCTION, WHETHER OR NOT SHOWN ON THE PLANS FOR REPLACEMENT. AT

AT LOCATIONS WHERE EXISTING PAINTED CURB IS TO BE RECONSTRUCTED, THE CONTRACTOR

SHALL PAINT THE NEW CURB AS SHOWN ON THE PLANS WITHIN 10 WORKING DAYS OF CURB

CONSTRUCTION OR AS DIRECTED BY ENGINEER. THE PAINT SHALL BE WATER-BASED WITH

2-YEAR GUARANTEE AGAINST COLOR FADING. PRIOR TO THE START OF CONSTRUCTION, THE

CONTRACTOR SHALL SUBMIT TO THE CITY WRITTEN PROOF OF THE MANUFACTURER'S 2-YEAR

FINAL INSTALLATION. THE CONTRACTOR SHALL NOTIFY THE ENGINEER AFTER COMPLETING LAYOUT AND AT LEAST 3 WORKING DAYS BEFORE COMMENCING INSTALLATION OF STRIPING.

6. ALL NEW STRIPING SHALL BE "CAT TRACKED" AND APPROVED BY THE ENGINEER PRIOR TO

7. TRAFFIC SIGN FACE SHALL BE 3M DIAMOND GRADE DG3 REFLECTIVE SHEETING (ASTM XI) OR APPROVED EQUAL WITH PROTECTIVE GRAFFITI OVERLAY FILM OR AS OTHERWISE NOTED

8. SIGNS SHALL BE STANDARD SIZE UNLESS NOTED OTHERWISE. PRIOR TO INSTALLATION. NEW

9. ALL EXISTING SIGNS AND POSTS TO BE REMOVED SHALL BE DELIVERED TO THE CITY OF

10. STRIPING SHALL BE APPLIED WITHIN 48 HOURS OF SURFACE COURSE REPLACEMENT ON

11. CONTRACTOR SHALL INSTALL NEW SIGN(S) AND/OR POST(S) PER CITY OF RIVERSIDE

12. CONTRACTOR SHALL INSTALL NEW STREET NAME SIGNS AND POST PER CITY OF RIVERSIDE

13. ALL CONFLICTING STRIPING, PAVEMENT MARKINGS, LEGENDS, AND RAISED PAVEMENT MARKERS

SHALL BE REMOVED EVEN IF NOT SHOWN ON PLANS. REMOVALS OF PAINTED STRIPING. PAVEMENT MARKINGS AND LEGENDS SHALL BE DONE BY WET SANDBLASTING. REMOVALS OF

THERMOPLASTIC STRIPING, PAVEMENT MARKINGS AND LEGENDS SHALL BE REMOVED BY WET

SANDBLASTING, GRINDING OR OTHER APPROVED METHOD AND SHALL NOT DAMAGE THE PAVEMENT. "BLACK OUT" OF EXISTING DELINEATION IS NOT PERMITTED. ALL DAMAGED

PAVEMENT DUE TO REMOVALS SHALL BE REPAIRED AS NECESSARY TO MAINTAIN A SMOOTH

AND UNIFORM SURFACE OR AS DIRECTED BY THE ENGINEER. ALL STRIPING REMOVALS AND

STREETS OPEN TO THE PUBLIC. IN NO CASE SHALL A NEWLY PAVED STREET OPEN TO THE

SIGNS SHALL BE APPROVED BY THE CITY OF RIVERSIDE. EXACT LOCATIONS OF SIGNS SHALL

R-4518 SHEET 1 OF 2

TITLE SHEET/LOCATION MAP FILE NAME: R4518-1.DWG HORIZ. SCALE: N/A VERT. SCALE: N/A

PROPOSED PCC

EXISTING TOPOGRAPHY:

© SANITARY SEWER M.H.

GATE VALVE

ELECTRICAL TEST STATION (GAS) STORM DRAIN M.H.

© ELECTRIC M.H.

FIRE HYDRANT

W WATER M.H. WATER METER

