


RIVERSIDE

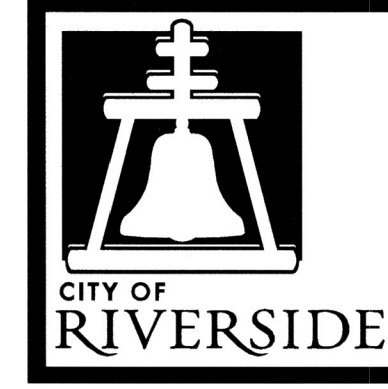


CALIFORNIA

CONSTRUCTION NOTES:

- RE** REMOVE AND REPLACE IN KIND EXISTING FACILITY. NUMBERS ABOVE 100 IN A HEXAGON ON THE PLAN REFER TO THE RESPECTIVE STANDARD DRAWING AND SHALL BE CONSTRUCTED ACCORDINGLY. ANY NOTE SHOWN BELOW THE STANDARD DRAWING NUMBER INDICATES THE SPECIFIC TYPE, ACTION, OR MODIFICATION TO BE CONSTRUCTED. DIMENSIONS OF NEW FACILITY SHALL BE MODIFIED AS NECESSARY, EXCLUDING ADA REQUIREMENTS, TO MATCH EXISTING FACILITY REMOVED.
- ADJ** ADJUST TO GRADE, DESCRIPTION PER PLAN:
(MH) MANHOLE. (GV) GATE VALVE. (WM) WATER METER, (ETS) ELECTRIC TEST STATION. (CO) CLEAN OUT. (EV) ELECTRIC VAULT. (EM) ELECTRIC MANHOLE.
- PIP** PROTECT IN PLACE, DESCRIPTION PER PLAN:
(SL) STREET LIGHT. (WM) WATER METER. (PP) POWER POLE. (CB) CATCH BASIN. (TP) TRAFFIC POLE. (GUY) GUY WIRE. (BUS) BUS PAD. (RMP) PEDESTRIAN RAMP. (FH) FIRE HYDRANT. (PED) UTILITY PEDESTAL. (CD) CURB DRAIN. (WV) WATER VAULT. (EV) ELECTRIC VAULT. (PM) PARKING METER. (UV) UTILITY VENT PIPE. (SGN) TRAFFIC SIGN. (BO) BLOW OFF. (BW) BLOCK WALL. (ETS) ELECTRIC TEST STATION. (BRM) AC BERM. (MDN) MEDIAN. (TW) TREE WELL. (TRE) TREE/PALM. (WTR) WATER UTILITY
- REM** REMOVE EXISTING, DESCRIPTION PER PLAN:
(ACP) = AC PATCH ON SIDEWALK.
(BUS) = REMOVE EXISTING REINFORCED CONCRETE BUS PAD (8" MIN.) DOWN TO EXISTING BASE MATERIAL. RE-COMPACT EXISTING BASE MATERIAL TO 90% COMPACTION. CONSTRUCT FULL DEPTH AC UP TO THE FINAL FIBER REINFORCED ASPHALT CAP.
- CM1** 0.12' MIN. DEPTH LINEAR COLD MILL OF EXISTING AC PAVEMENT OR 0.15' MIN. DEPTH WHEN USED IN CONJUNCTION WITH ARAM TREATMENT. EDGE OF MILL SHALL BE 6" AWAY FROM EXISTING BERM WHEN INDICATED.
(---) = WIDTH OF LINEAR COLD MILL AS INDICATED ON PLANS.
- CM2** VARIABLE AREA COLD MILL OF EXISTING AC PAVEMENT.
(---) = DEPTH OF VARIABLE AREA COLD MILL AS INDICATED ON PLANS.
- ARAM** CONSTRUCT ASPHALT RUBBER AGGREGATE MEMBRANE.
- FRAC** OVERLAY OR CONSTRUCT NEW FIBER REINFORCED ASPHALT CONCRETE (FRAC) PAVEMENT. REPLACEMENT DEPTH SHALL MATCH AC THICKNESS TO BE REMOVED UNLESS OTHERWISE NOTED.
- D6** OVERLAY OR CONSTRUCT NEW CONVENTIONAL DGAC PAVEMENT. REPLACEMENT DEPTH PER PLAN.
- 200** CONSTRUCT CURB AND GUTTER PER CITY STD 200 WITH THE FOLLOWING MODIFICATION (---):
(M1) = 6-INCH WIDE CURB BAND, FLUSH 0-INCH CURB HEIGHT.
- 302** CONSTRUCT DRIVEWAY PER CITY STD 302 WITH THE FOLLOWING MODIFICATION (---):
(M1) = CONSTRUCT PARTIAL DRIVEWAY PANEL OR WING TO MATCH EXISTING TYPE, DIMENSIONS, AND GRADE. PROTECT IN PLACE EXISTING C&G, SIDEWALK, AND DRIVEWAY. INCLUDES SAW CUTTING WHERE NECESSARY.
(M2) = REMOVE AND REPLACE EXISTING DRIVEWAY, MATCH EXISTING DRIVEWAY DIMENSIONS, AND GRADE.
(M3) = CONSTRUCT PARTIAL DRIVEWAY TO MATCH EXISTING TYPE, DIMENSIONS, STAMPED PATTERN, AND COLOR.
(M4) = REMOVE AND REPLACE EXISTING DRIVEWAY PER CITY STANDARD (CB-I) AND POUR THE RETAINING CURB MONOLITHICALLY WITH THE NEW DRIVEWAY. PIP EXISTING LANDSCAPE AND IRRIGATION.
- 304** CONSTRUCT PEDESTRIAN RAMP PER CITY STD 304 WITH THE FOLLOWING TYPE:
(M1) = MODIFIED TYPE IV-A, ADD WINGS AND RETAINING CURB TO WIDEN THE LANDING.
(M2) = MODIFIED TYPE I WITH RETAINING CURB ON ONE SIDE.
(M3) = MODIFIED TYPE I WITH RETAINING CURB AT THE BACK OF LANDING.
(M4) = MODIFIED TYPE II WITH RETAINING CURB ON ONE SIDE OF THE RAMP. R&R WM BOX AND LID AND PLACE IT IN THE 2% LANDING.
- 325** CONSTRUCT SIDEWALK PER CITY STD 325 WITH THE FOLLOWING MODIFICATION (---):
(M1) = REMOVE AND REPLACE EXISTING SIDEWALK INCLUDING RETAINING CURB IN KIND.
(M2) = REMOVE AND REPLACE RAMP WING WITH SCORE LINES.
(M3) = REMOVE EXISTING RAMP, ADD AND COMPACT WITH FILL DIRT AND CONSTRUCT NEW SIDEWALK.
(M4) = REMOVE AND REPLACE EXISTING STAMPED CONCRETE BAND IN KIND, MATCH PATTERN AND COLOR. IF THE BAND IS WITHIN A DRIVEWAY APPROACH, THE THICKNESS SHALL BE 6".
- 400** RECONSTRUCT TOP OF CATCH BASIN PER CITY STD 400, TYPE I, WIDTH PER PLAN. CONTRACTOR SHALL SAW CUT, REMOVE, AND DISPOSE EXISTING CATCH BASIN TOP, DOWEL AND EPOXY THE NEW CATCH BASIN TOP TO EXISTING STRUCTURE.
- 410** REMOVE EXISTING DRAIN AND CONSTRUCT PARKWAY DRAIN PER CITY STD 410, TYPE AND SIZE PER PLAN.
- BUS** CONSTRUCT 60' X 12' CONCRETE BUS PAD (BUS PAD WIDTH MEASURED FROM MONOLITHIC CURB FACE), UNLESS OTHERWISE INDICATED ON PLANS. BASE OR SUBGRADE SHALL BE REMOVED AND COMPACTED AS NECESSARY TO INSTALL BUS PAD PER DETAIL IN PART 10 OF THE SPECIFICATIONS. ENGINEER SHALL BE NOTIFIED PRIOR TO POURING NEW CONCRETE. CONTRACTOR TO REMOVE AND REINSTALL ALL BENCHES, TRASH RECEPTACLES, BUS STOP SIGN, IF NECESSARY.
- R&R** REMOVE AND REPLACE EXISTING IMPROVEMENT PER PLAN (---):
(CUL) = CONTRACTOR SHALL REMOVE EXISTING PARKWAY CULVERT. REMOVE ANY INTERFERING ROOT SYSTEM, AND VERIFY IF AN EXISTING DRAINAGE FACILITY IS CONNECTED AT THE BACK OF WALK. IF AN EXISTING DRAINAGE CONNECTION EXISTS, RECONSTRUCT THE PARKWAY CULVERT PER CITY STANDARD 410 TO MATCH THE EXISTING OPENING WIDTH. IF NO DRAINAGE CONNECTION EXISTS, RECONSTRUCT THE CURB/GUTTER AND SIDEWALK PER CITY STANDARD.
(WM) = REMOVE AND REPLACE CONCRETE WATER METER BOX AND LID. THE CITY WILL SUPPLY THE CONTRACTOR THE NEW BOX AND LID.
(CD) = REMOVE AND REPLACE EXISTING CURB DRAIN PIPE WITH THE SIDEWALK REPAIR.
(PB) = REMOVE AND REPLACE EXISTING TRAFFIC SIGNAL OR STREET LIGHT PULL BOX WITH A NEW PULL BOX. PULL BOXES LOCATED IN DRIVEWAY APPROACHES SHALL HAVE A TRAFFIC RATED LID.
(LIP) = GRIND LIP OF THE EXISTING PEDESTRIAN RAMP DOWN TO FLOW LINE.
(STM) = REMOVE AND REPLACE EXISTING STAMPED CONCRETE IN KIND. CONTRACTOR SHALL MATCH EXISTING PATTERN AND COLOR.
- AC INL** REMOVE AND REPLACE EXISTING AC INLET APRON, SEE DETAIL ON SHEET 10.
- MOD LS** FILL AREA WITH DIRT, SOD AND MODIFY IRRIGATION AS NECESSARY.
- RTA** CONTRACTOR SHALL COORDINATE WITH SAM WATTANACHINDA (swattana@riversidetransit.com) (951)565-5122 AT THE RIVERSIDE TRANSIT AUTHORITY FOR THE REMOVAL AND DELIVERY OF ALL BUS STOP EQUIPMENT.

PUBLIC WORKS DEPARTMENT

2020/2021 SB-1 STREET MAINTENANCE IMPROVEMENTS

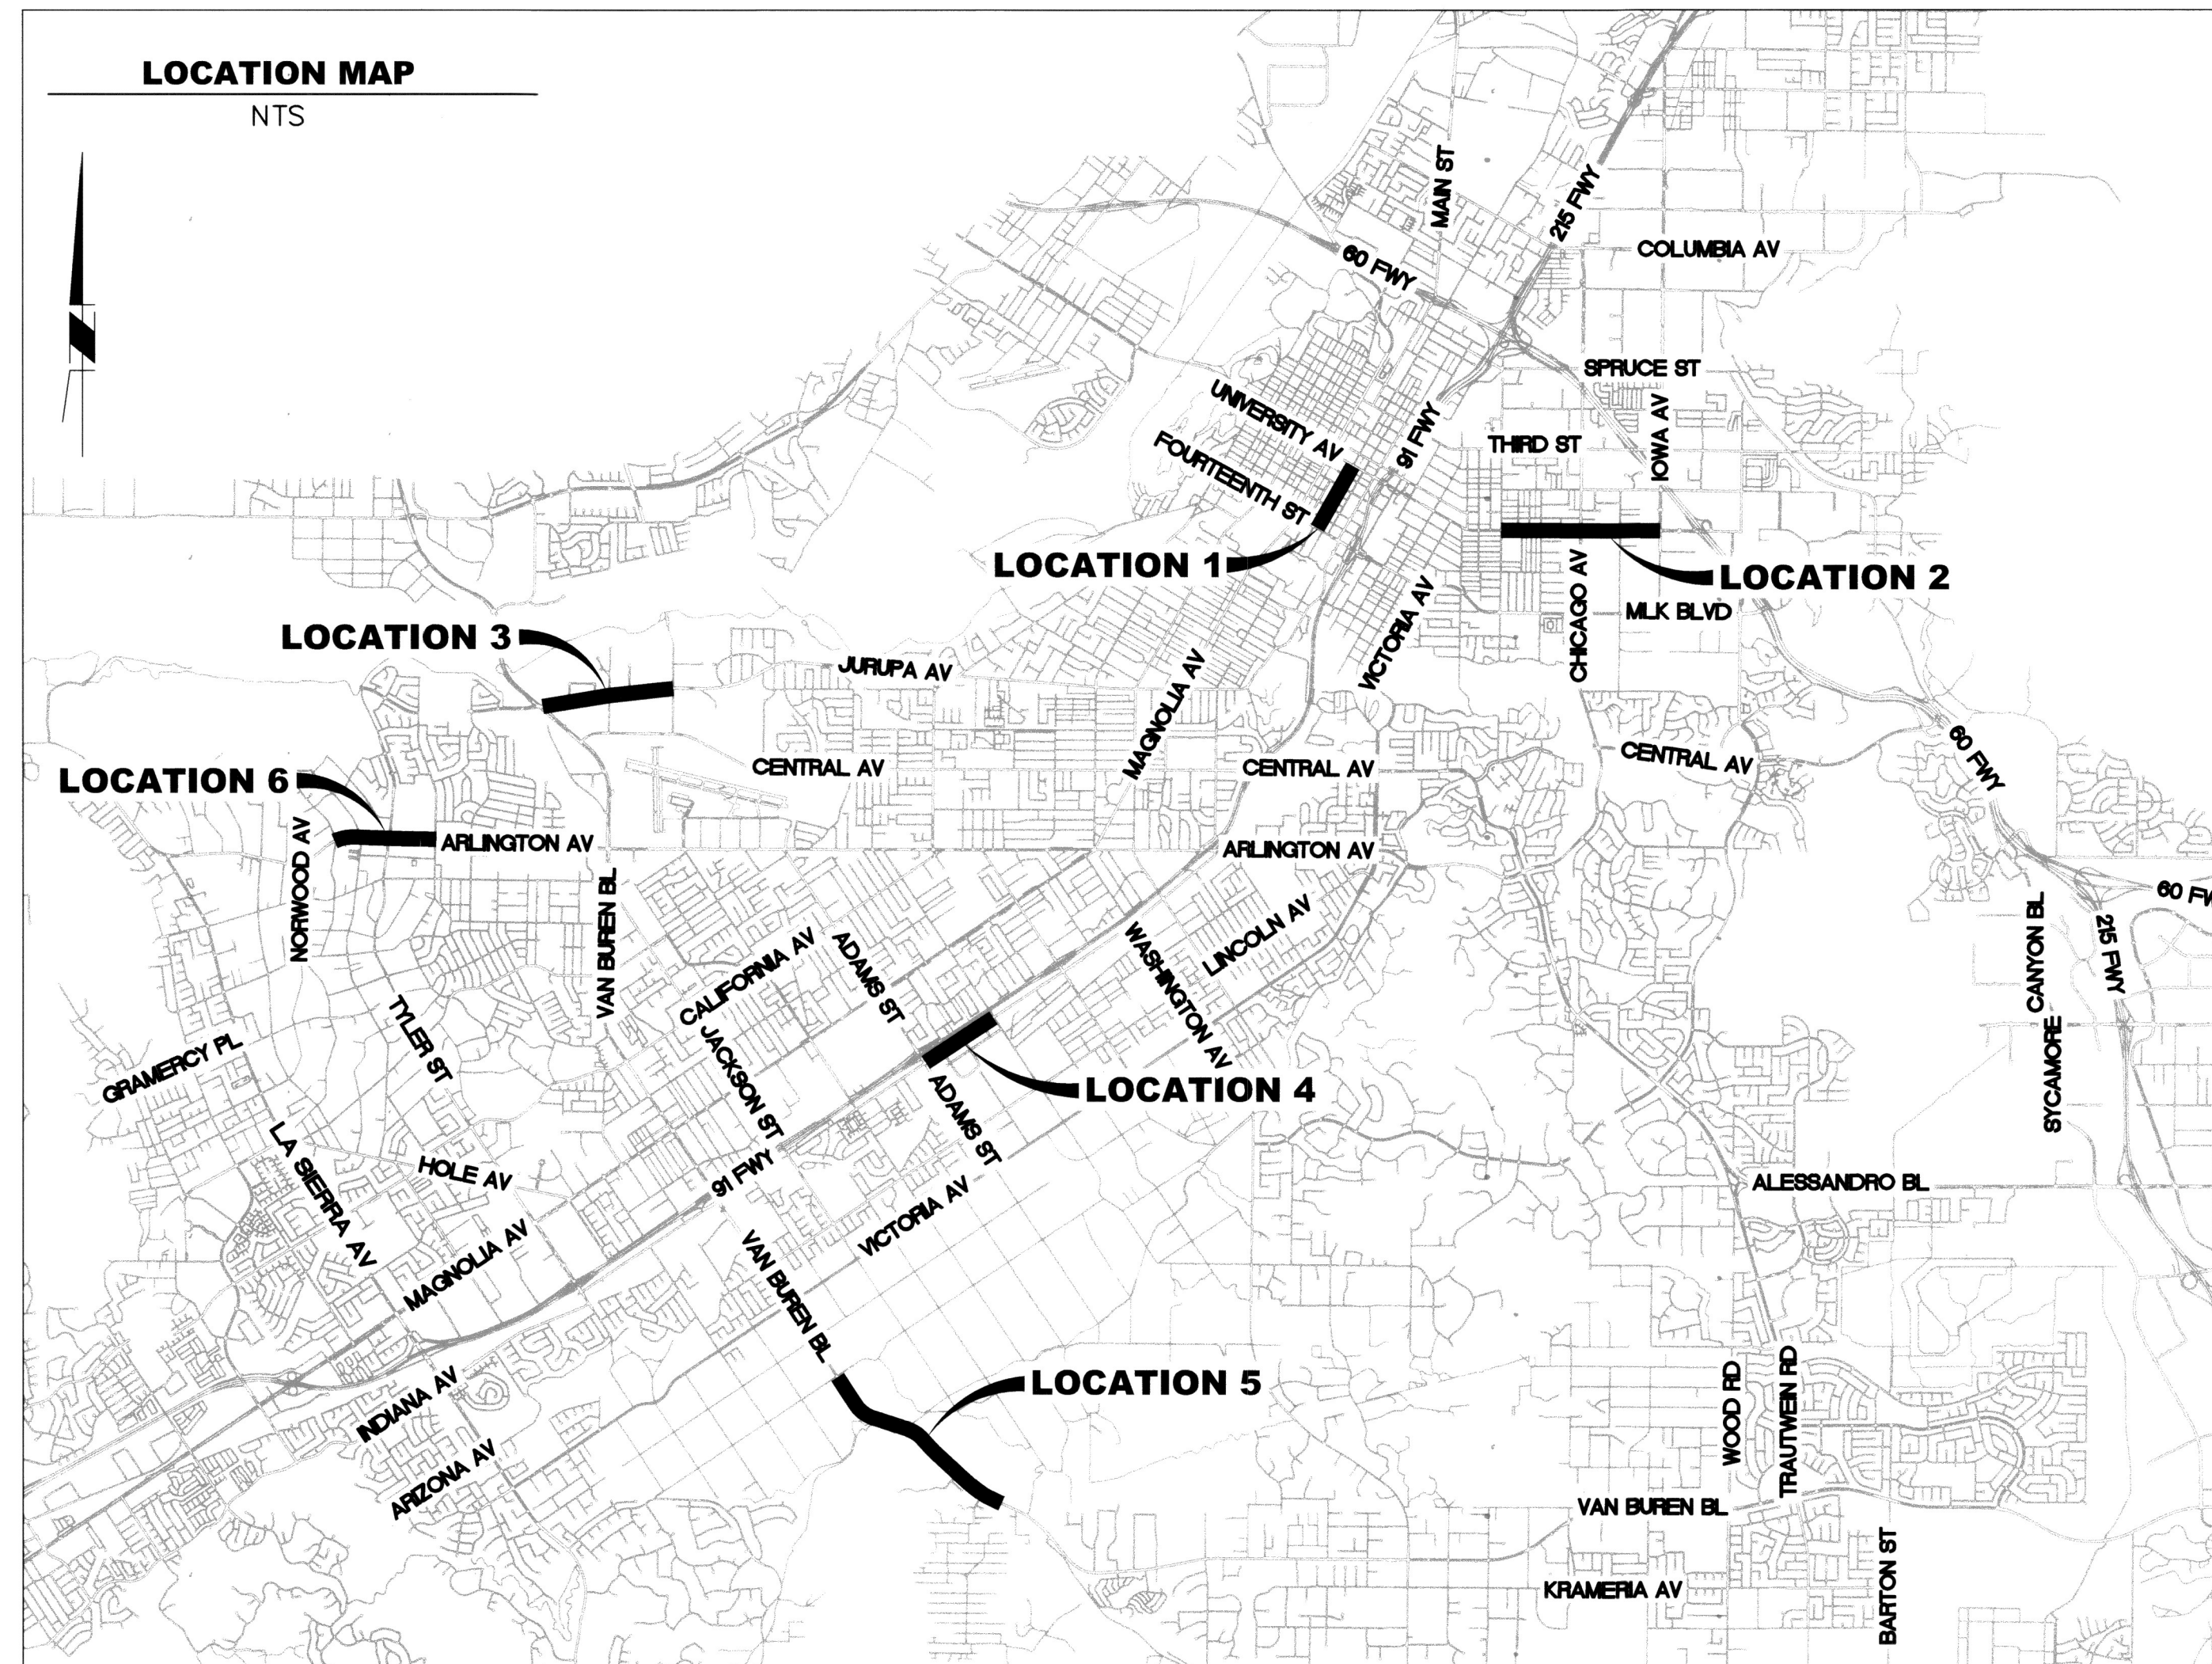

EXISTING TOPOGRAPHY:

- ⊙ SANITARY SEWER M.H. ⚙ GATE VALVE
⊙ STORM DRAIN M.H. ⚙ ELECTRICAL TEST STATION (GAS)
⊙ ELECTRIC M.H. ⚙ BLOW OFF VALVE
⊙ WATER M.H. ⚙ POWER POLE
⚙ FIRE HYDRANT

LEGEND:

- CM1 + AC TREATMENT AS INDICATED PROPOSED PCC
- CM2 (DEPTH PER PLAN) + AC TREATMENT AS INDICATED

GENERAL CONSTRUCTION NOTES:

- THE CONTRACTOR SHALL PROVIDE AND MAINTAIN TRAFFIC AS INDICATED IN THE ASSOCIATED PROJECT SPECIAL PROVISIONS.
- CONSTRUCTION SHALL BE IN ACCORDANCE WITH THE CITY OF RIVERSIDE STANDARD DRAWINGS AND STANDARD SPECIFICATIONS FOR PUBLIC WORKS CONSTRUCTION, 2012 EDITION.
- EXISTING UTILITIES SHOWN ON THIS PLAN ARE PLOTTED FROM UTILITY RECORDS. THE CONTRACTOR IS REQUIRED TO TAKE DUE PRECAUTIONARY MEASURES TO LOCATE AND PROTECT ALL UTILITIES WHETHER OR NOT SHOWN ON THIS PLAN.
- ALL STREET PULL BOXES, AFFECTED BY CONSTRUCTION, SHALL BE ADJUSTED TO THE PROPOSED GRADE. A NEW BOX WILL BE SUPPLIED BY THE CITY IF THE PULL BOX OR WATER METER BOX IS DAMAGED OR NOT PER CURRENT CITY STANDARD SPECIFICATIONS. HOWEVER, THE CONTRACTOR IS RESPONSIBLE FOR OBTAINING THE CITY FURNISHED ITEM FROM THE CITY'S CORPORATION YARD LOCATED AT 8095 LINCOLN AVENUE.
- THE SEAM BETWEEN PASSES OF THE AC OVERLAY SHALL COINCIDE, AS CLOSE AS POSSIBLE, TO THE LANE LINES.
- COLD MILLING SHALL BE AS DESCRIBED ON THE PLANS AND SPECIAL PROVISIONS OR AS DIRECTED BY THE ENGINEER.
- ANY DISTRESSED EXISTING PAVEMENT SHALL BE REMOVED AND REPLACED AS DIRECTED BY THE ENGINEERING AFTER COLD-MILLING AND PRIOR TO PLACEMENT OF NEW AC PAVEMENT.
- CONTRACTOR SHALL REMOVE ALL VEGETATION AND CLEAR ALL DIRT WITHIN ALL SIDEWALK PANELS AND TREE WELLS WITHIN THE PROJECT LIMITS.
- ALL EXISTING IMPROVEMENTS SHOWN HEREON SHALL BE PROTECTED IN PLACE UNLESS OTHERWISE NOTED.
- EXISTING IRRIGATION SHALL BE PROTECTED OR MODIFIED AS NECESSARY TO CONSTRUCT NEW CONCRETE IMPROVEMENTS.
- ADEQUATE FLOW LINES SHALL BE MAINTAINED AT ALL LOCATIONS.
- IF EXCESS GRINDING OF TREE ROOTS IS REQUIRED, A SPECIAL INSPECTION FROM THE LANDSCAPING DIVISION IS REQUIRED FOR ANALYSIS OF POTENTIAL IMPACT.

SHEET INDEX:

STREET MAINTENANCE PLANS (R-4525):

SHEET NO.	DESCRIPTION
01	TITLE SHEET AND NOTES
02	LOCATION 1 (ORANGE STREET FROM FOURTEENTH STREET TO UNIVERSITY AVENUE)
03	LOCATION 2 (UNIVERSITY AVENUE FROM OTTAWA AVENUE TO CRANFORD AVENUE)
04	LOCATION 2 (UNIVERSITY AVENUE FROM CRANFORD AVENUE TO IOWA AVENUE)
05	LOCATION 3 (JURUPA AVENUE FROM VAN BUREN BOULEVARD TO ACORN STREET)
06	LOCATION 3 (JURUPA AVENUE FROM ACORN STREET TO WILDERNESS AVENUE)
07	LOCATION 4 (INDIANA AVENUE FROM ADAMS STREET TO MOTOR CIRCLE EAST)
08	LOCATION 4 (INDIANA AVENUE FROM MOTOR CIRCLE EAST TO JEFFERSON STREET)
09	LOCATION 5 (VAN BUREN BOULEVARD FROM DUFFERIN AVENUE TO 2200' SOUTHERLY OF DUFFERIN AVENUE)
10	LOCATION 5 (VAN BUREN BOULEVARD FROM 1500' NORTHERLY OF CITRUS HEIGHTS DRIVE TO 1000' SOUTHERLY OF CITRUS HEIGHTS DRIVE)
11	LOCATION 5 (VAN BUREN BOULEVARD FROM 500' NORTHERLY EQUESTRIAN DRIVE TO CITY LIMITS)
12	LOCATION 6 (ARLINGTON AVENUE FROM CHADBOURNE AVENUE TO 600' EASTERLY OF TYLER STREET)
13	LOCATION 6 (ARLINGTON AVENUE FROM 900' WESTERLY OF CREST AVENUE TO CREST AVENUE)


SIGNING/STRIPING PLANS:

PLAN NO.	DESCRIPTION
XL-821	LOCATION 1 (ORANGE STREET FROM FOURTEENTH STREET TO UNIVERSITY AVENUE)
XL-822	LOCATION 2 (UNIVERSITY AVENUE FROM OTTAWA AVENUE TO IOWA AVENUE)
XL-819	LOCATION 3 (JURUPA AVENUE FROM VAN BUREN BOULEVARD TO WILDERNESS AVENUE)
XL-818	LOCATION 4 (INDIANA AVENUE FROM ADAMS STREET TO JEFFERSON STREET)
XL-817	LOCATION 5 (VAN BUREN BOULEVARD FROM DUFFERIN AVENUE TO CITY LIMITS)
XL-820	LOCATION 6 (ARLINGTON AVENUE FROM CHADBOURNE AVENUE TO CREST AVENUE)


As BUILT 5/04/23 B.O



Under Ground
Service Alert
of Southern California
Call: TOLL FREE
1-800
227-2600
TWO WORKING DAYS BEFORE YOU DIG

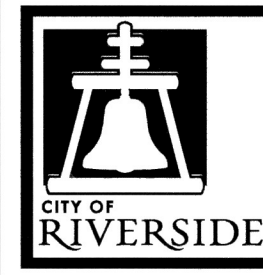

ENGINEER IN
RESPONSIBLE CHARGE
Edward Lara
Edward Lara
R.C.E. No. 63753 EXPIRES: 9-30-22
DATE June 16, 2021

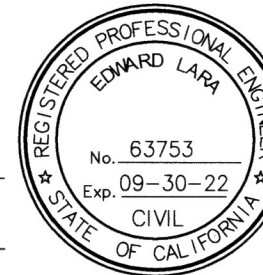


MARK	REVISIONS	APPR.	DATE

DESIGNED BY: DMC DRAWN BY: DMC CHECKED BY: EL


CITY OF RIVERSIDE, CALIFORNIA DEPARTMENT OF PUBLIC WORKS			
APPROVED BY	BY	DATE	APPROVED BY
ENGINEERING MANAGER	<i>J.L.</i>	8.2.2021	<i>[Signature]</i>
CONSTRUCTION ADMIN.	<i>DC</i>	8.2.21	CITY ENGINEER
TRAFFIC DIVISION	<i>MM</i>	7/29/21	
SURVEY			
STREETS			

STREET MAINTENANCE	
2020/2021 SB-1 STREET MAINTENANCE IMPROVEMENTS	
TITLE SHEET AND NOTES	
HORIZ. SCALE: NA	VERT. SCALE: NA
DESIGN WORK ORDER NO.: 2108424 CONSTR. WORK ORDER NO.: 2108425	R-4525
SHEET 01 OF 13	
FILE NAME: R4525-01.DWG	

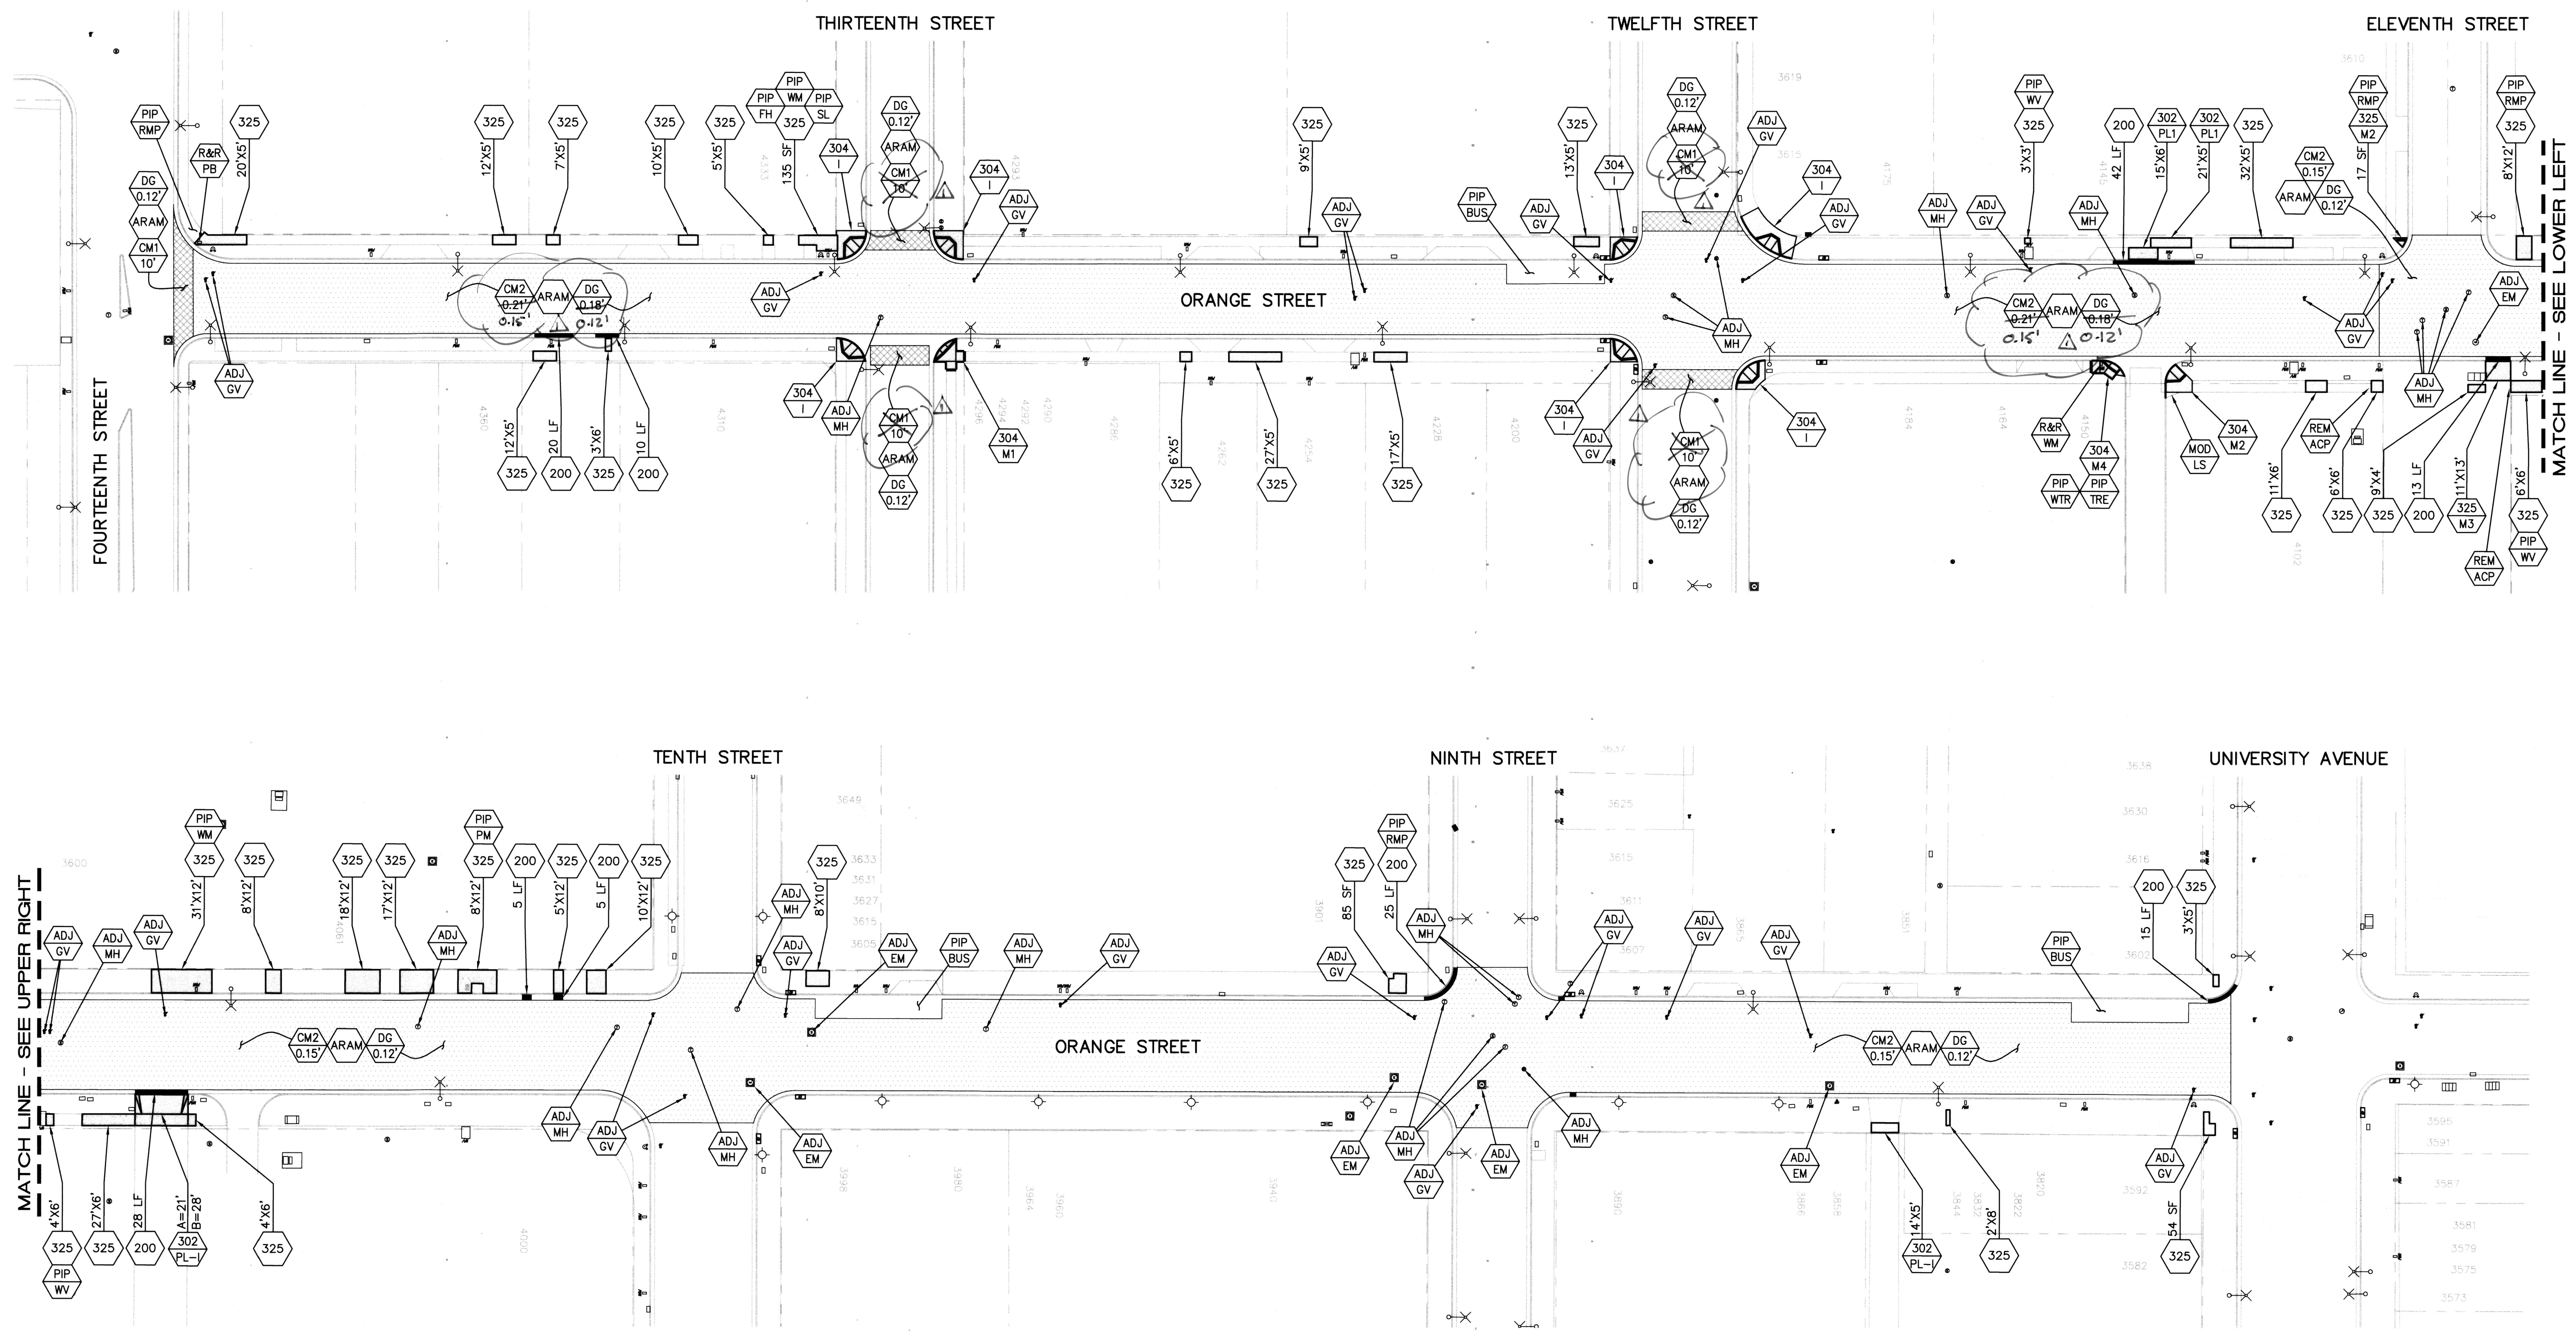
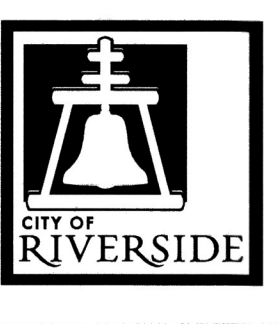
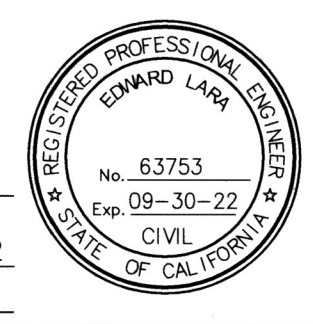



MATCH LINE - SEE UPPER RIGHT

MATCH LINE - SEE LOWER LEFT

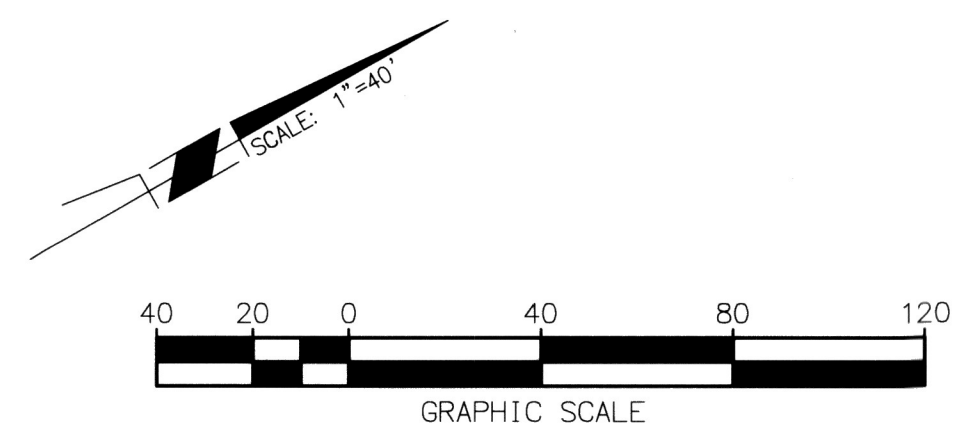

As Built 5/04/23 B.O


 Under Ground Service Alert of Southern California Call: TOLL FREE 1-800 227-2600 TWO WORKING DAYS BEFORE YOU DIG	 ENGINEER IN RESPONSIBLE CHARGE <i>Edward Lara</i> Edward Lara R.C.E. No. 63753 EXPIRES: 9-30-22 DATE <u>June 16, 2021</u>		CITY OF RIVERSIDE, CALIFORNIA DEPARTMENT OF PUBLIC WORKS				STREET MAINTENANCE		DESIGN WORK ORDER NO.: 2108424 CONSTR. WORK ORDER NO.: 2108425
			APPROVED BY: <i>[Signature]</i> DATE: <u>8-2-21</u> BY: <i>[Signature]</i> DATE: <u>7/29/21</u>	2020/2021 SB1 STREET MAINTENANCE IMPROVEMENTS		R-4525			
			REVISIONS: <u>Revised Pavement treatment</u> MARK: <u>EL</u> DESIGNED BY: <u>DMC</u> DRAWN BY: <u>DMC</u> CHECKED BY: <u>EL</u>		TRAFFIC DIVISION: <u>NM</u> SURVEY: <u>7/29/21</u> STREETS: <u>Orange Street</u>		LOCATION 1 HORIZ. SCALE: 1"=40' VERT. SCALE: N/A		SHEET <u>02</u> OF <u>13</u> FILE NAME: R4525-ALL.DWG

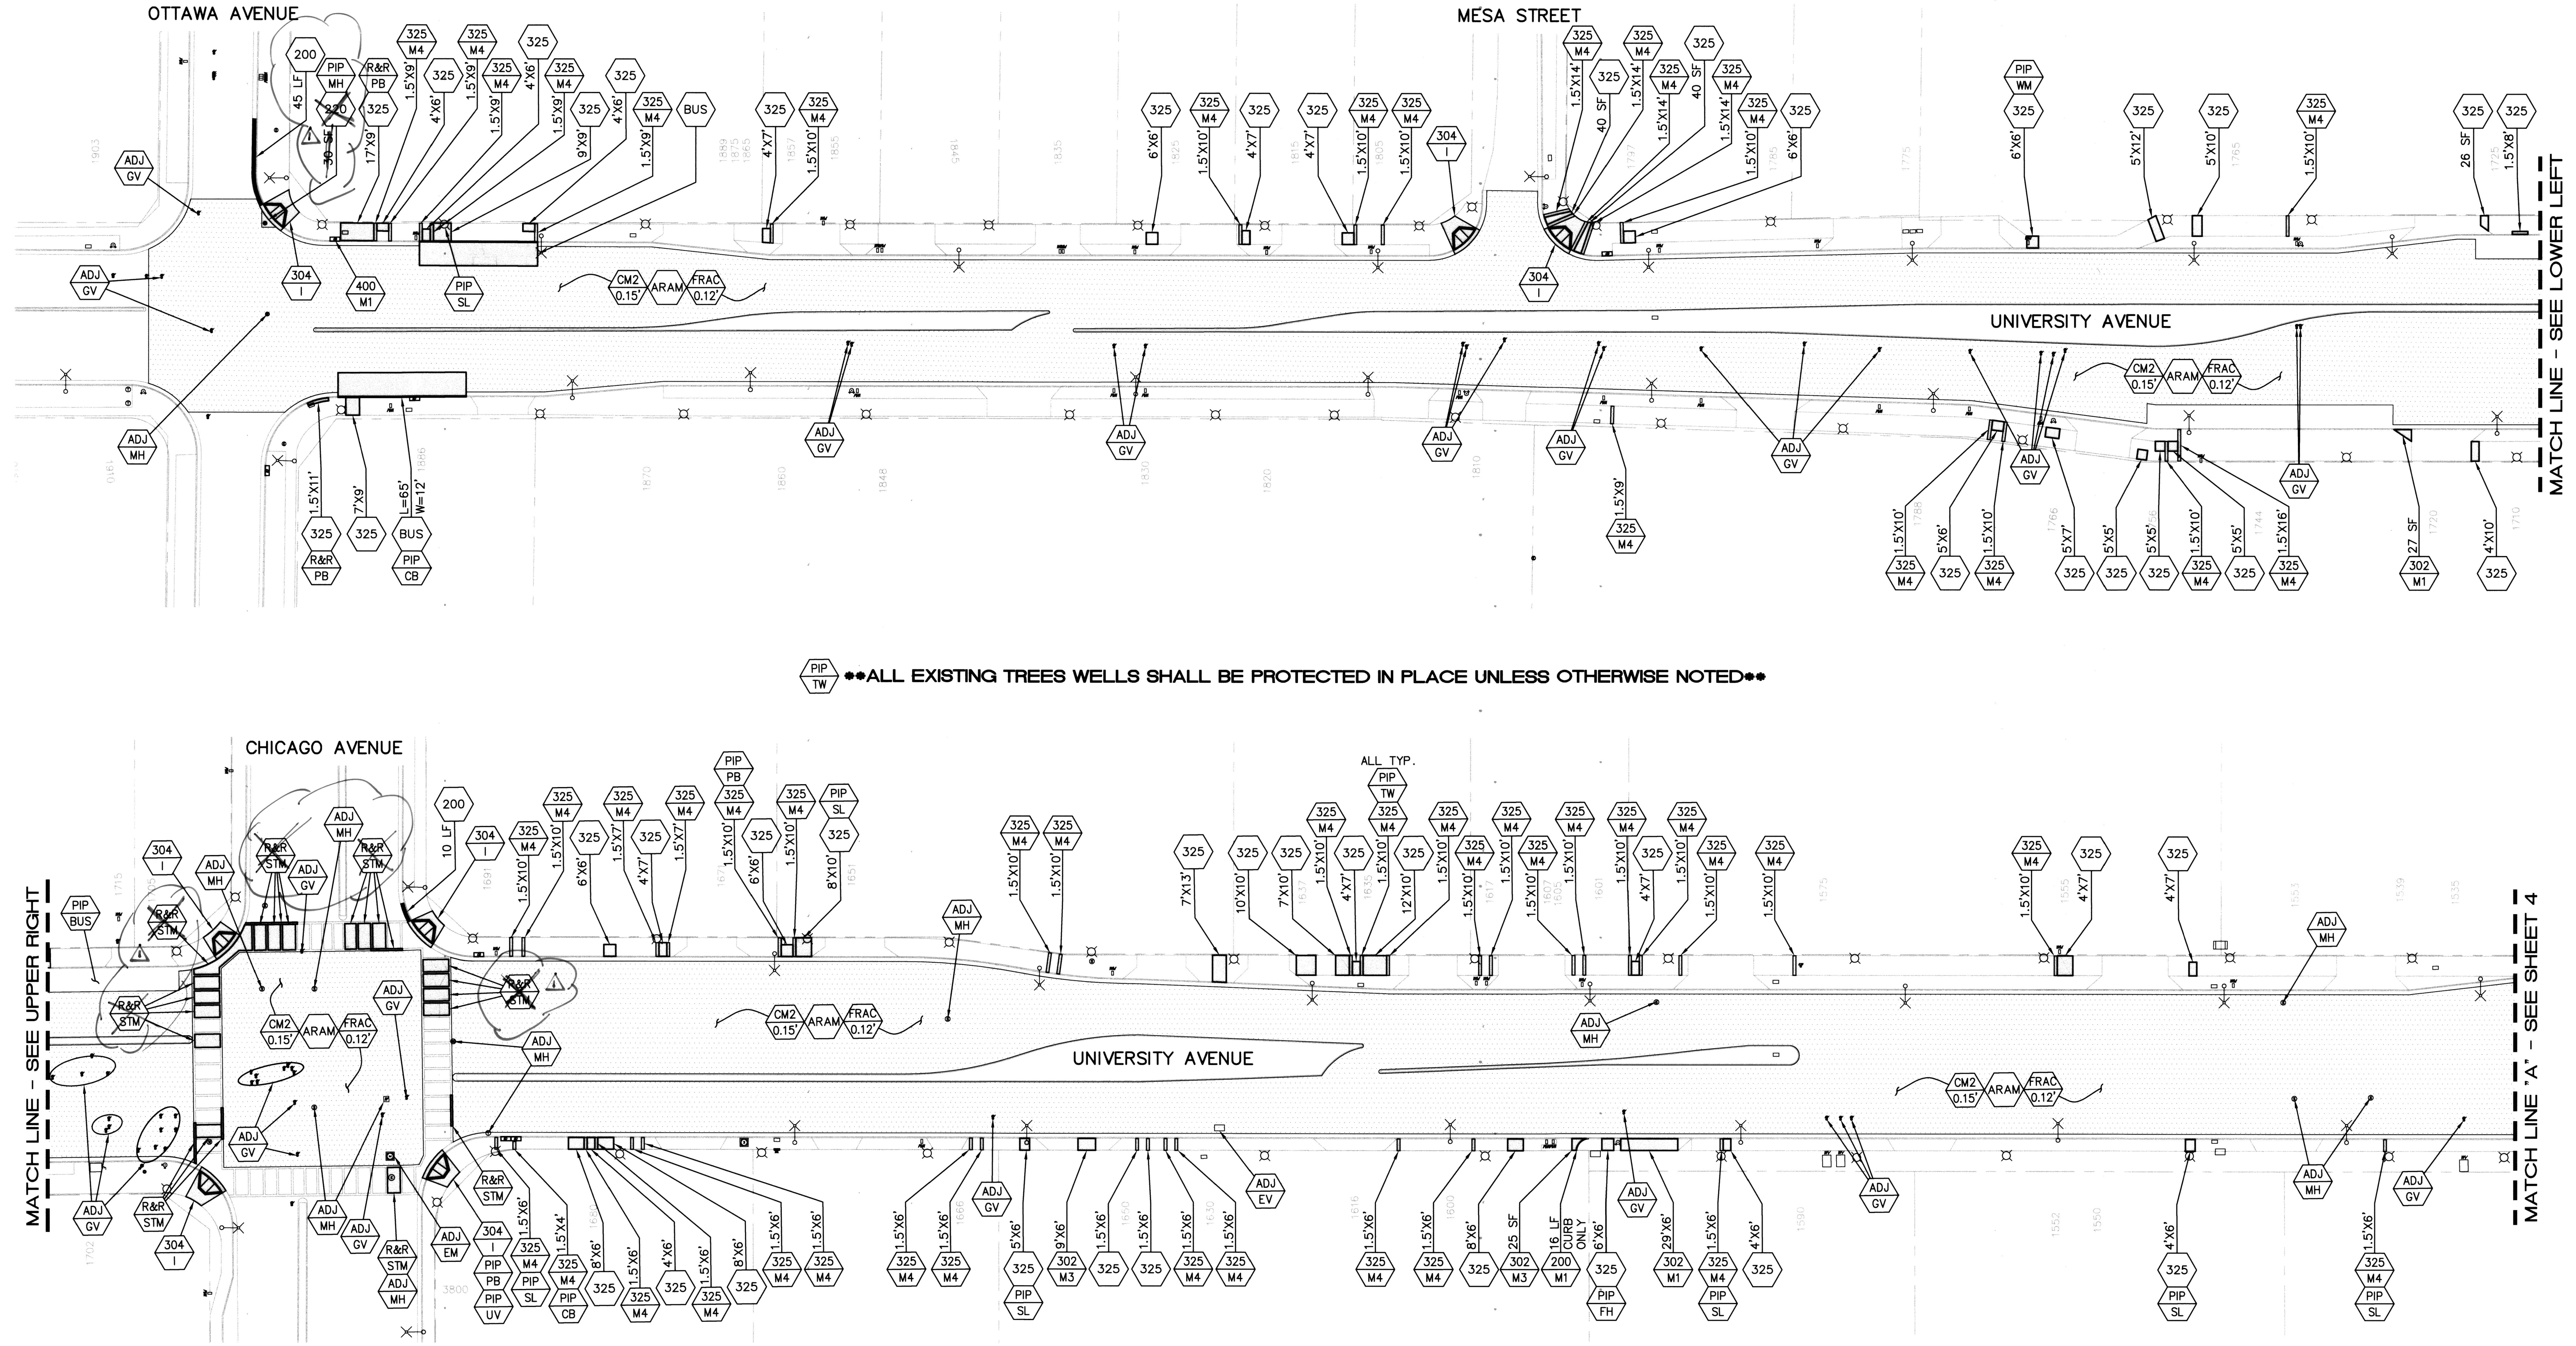


PIP TW **ALL EXISTING TREES WELLS SHALL BE PROTECTED IN PLACE UNLESS OTHERWISE NOTED**

MATCH LINE - SEE UPPER RIGHT

MATCH LINE 'A' - SEE SHEET 4

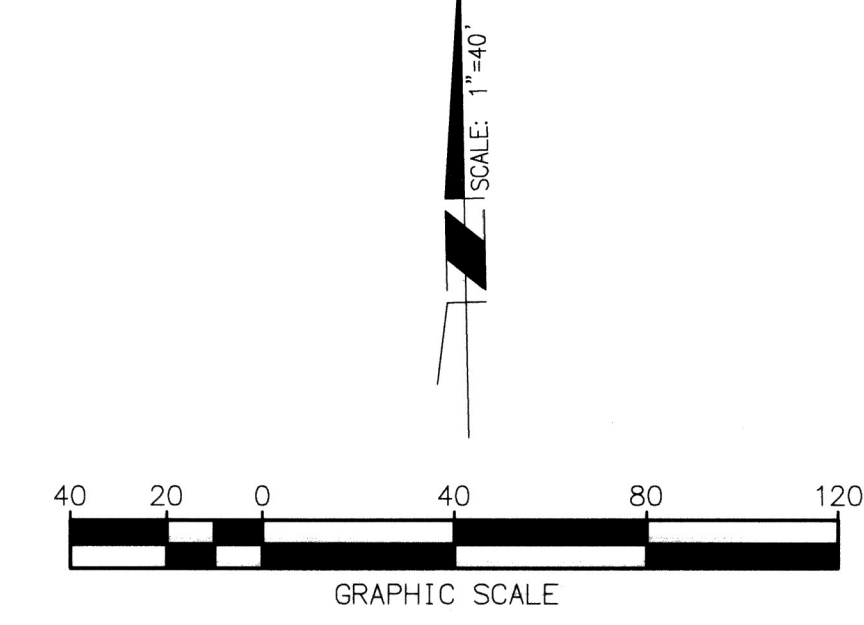

Under Ground Service Alert
Call: TOLL FREE
1-800
227-2600
TWO WORKING DAYS BEFORE YOU DIG

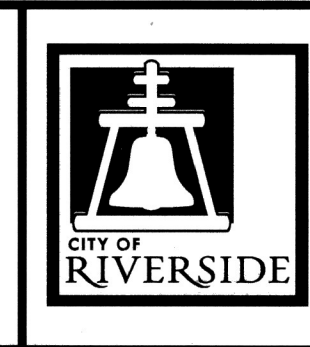

ENGINEER IN RESPONSIBLE CHARGE
Edward Lara
Edward Lara
R.C.E. No. 63753 EXPIRES: 9-30-22
DATE: June 16, 2021






DESIGNED BY	DMC	DRAWN BY	DMC	CHECKED BY	EL
-------------	-----	----------	-----	------------	----


CITY OF RIVERSIDE, CALIFORNIA DEPARTMENT OF PUBLIC WORKS			
APPROVED BY	BY	DATE	APPROVED BY
ENGINEERING MANAGER	FL	8.2.21	CITY ENGINEER
CONSTRUCTION ADMIN.	DC	8.2.21	
TRAFFIC DIVISION	WA	7/16/21	
SURVEY			
STREETS			

STREET MAINTENANCE	
2020/2021 SB1 STREET MAINTENANCE IMPROVEMENTS	
LOCATION 2	
HORIZ. SCALE: 1"=40'	VERT. SCALE: N/A

DESIGN WORK ORDER NO.: 2108424 CONSTR. WORK ORDER NO.: 2108425
R-4525
SHEET 03 OF 13
FILE NAME: R4525-ALL.DWG


As Built 8/04/23 B.O

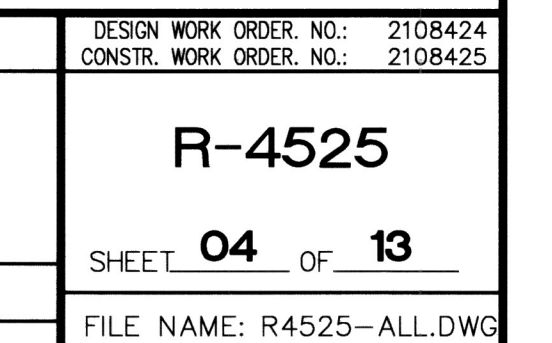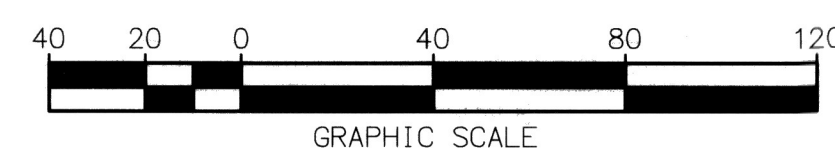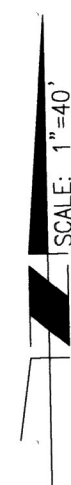

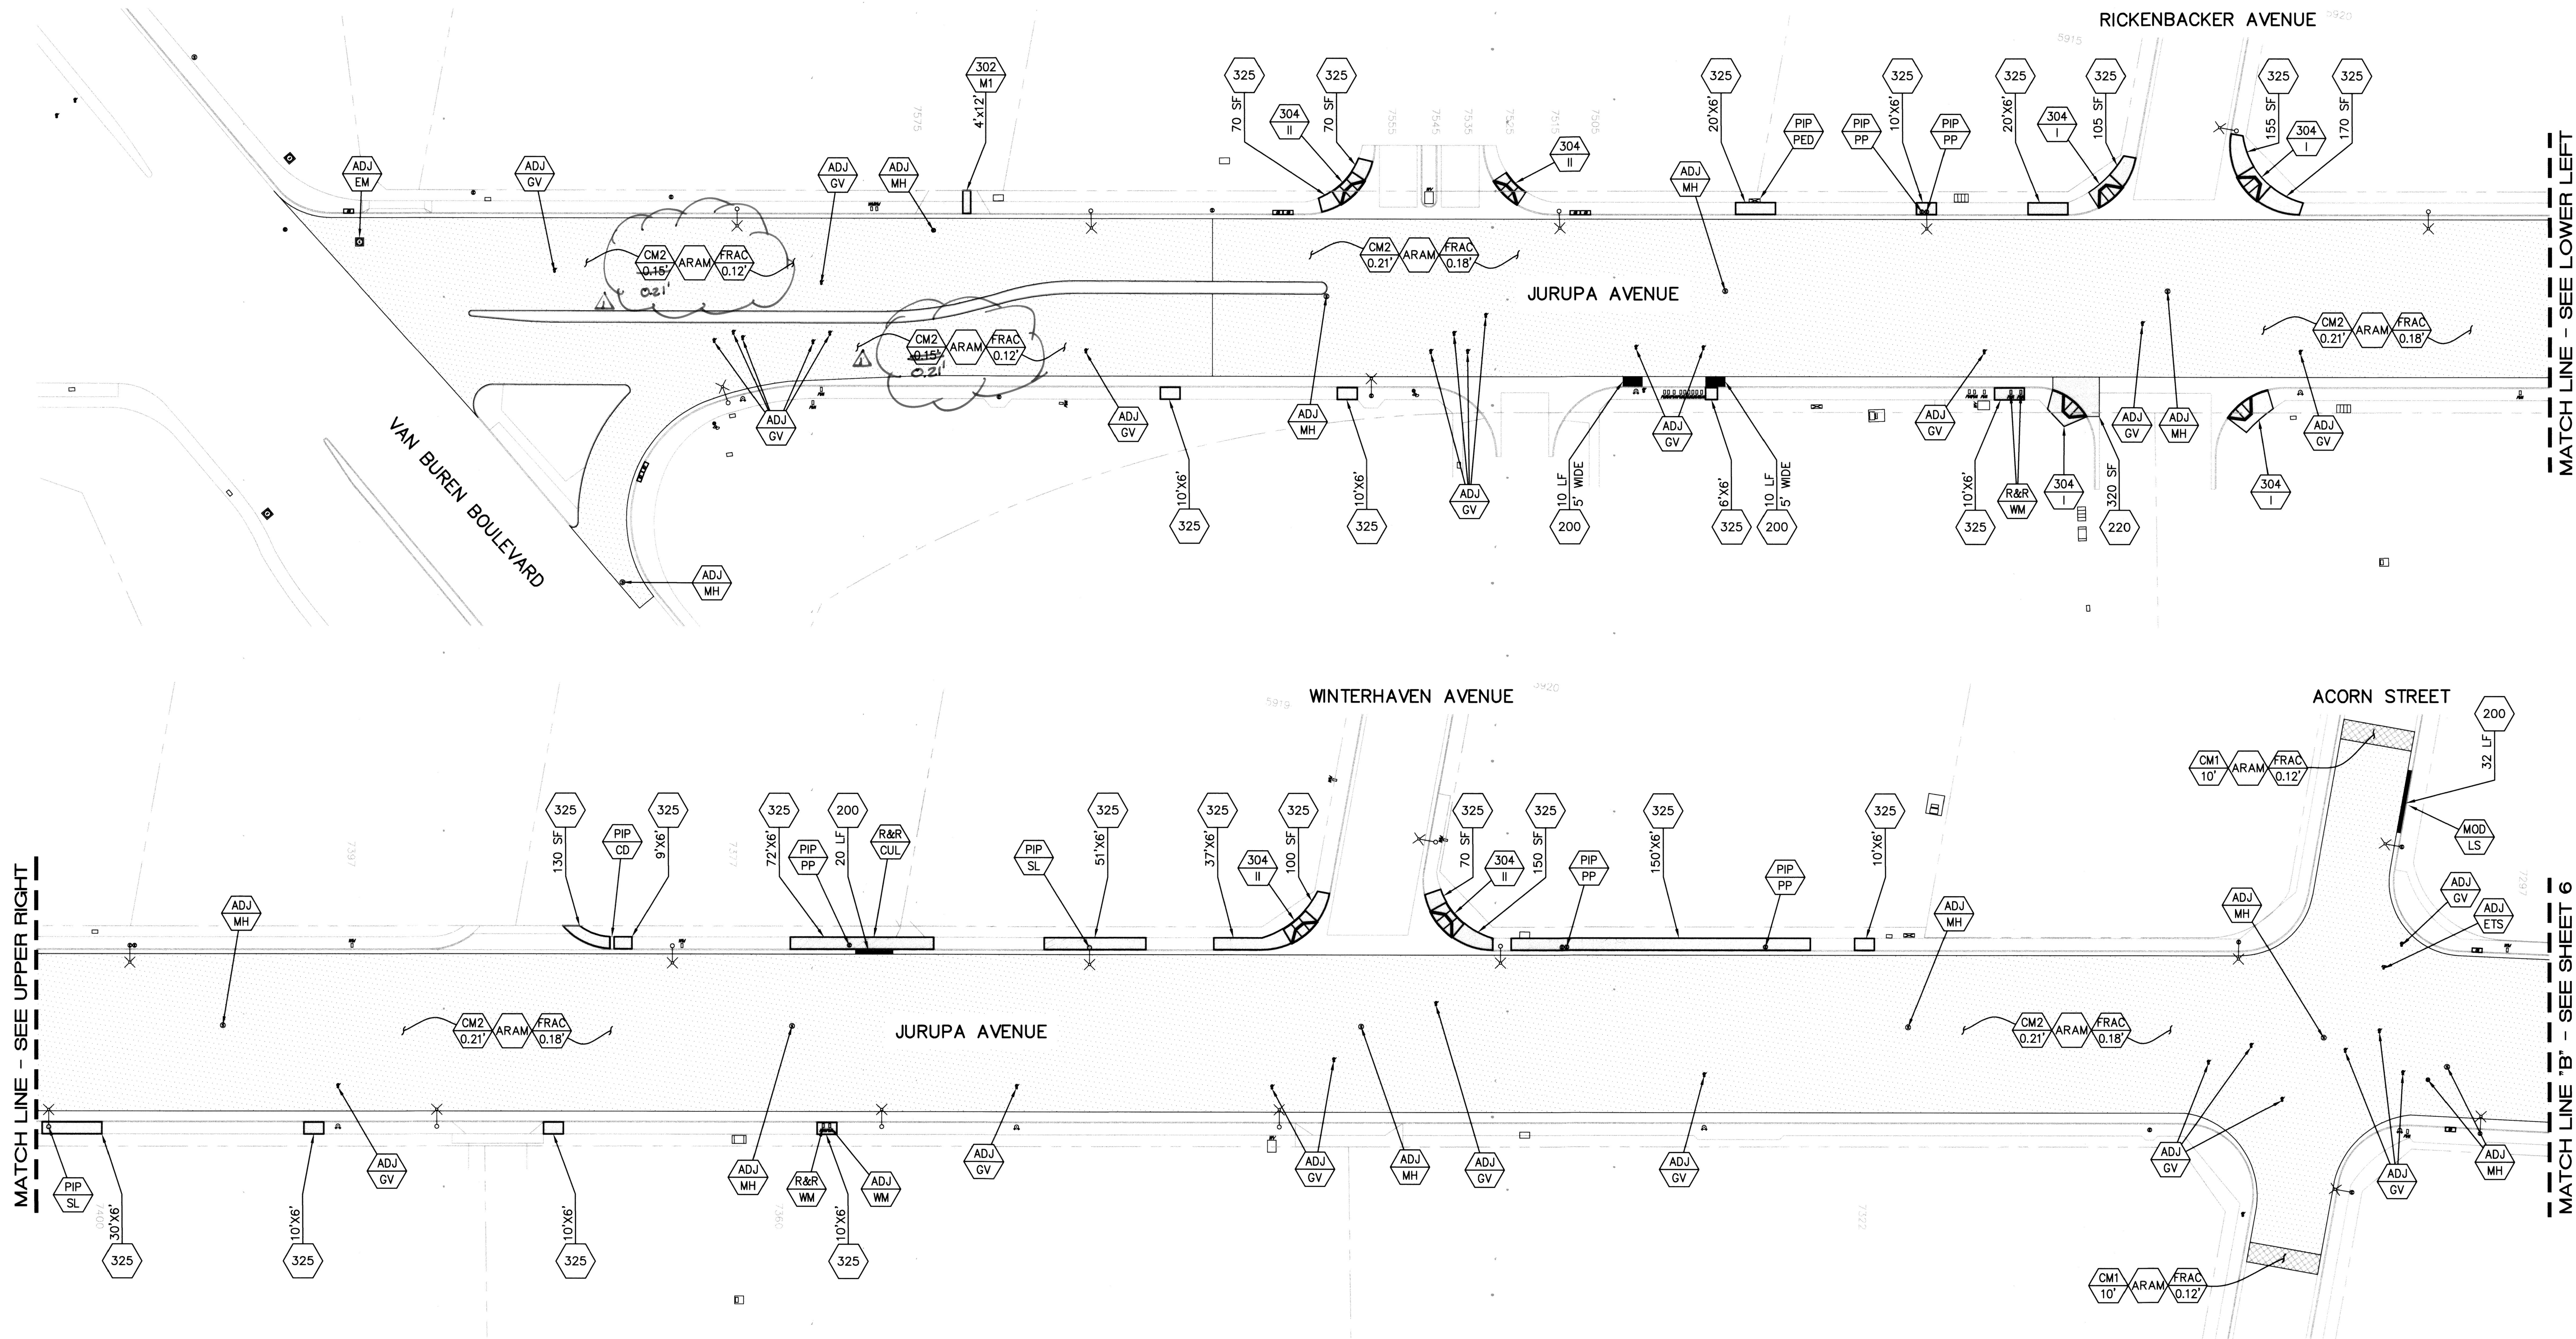
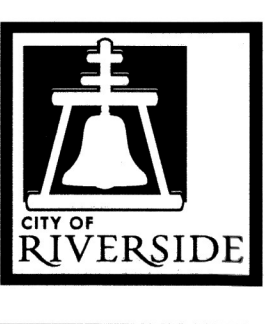
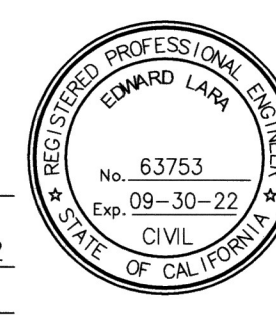





MATCH LINE - SEE UPPER RIGHT

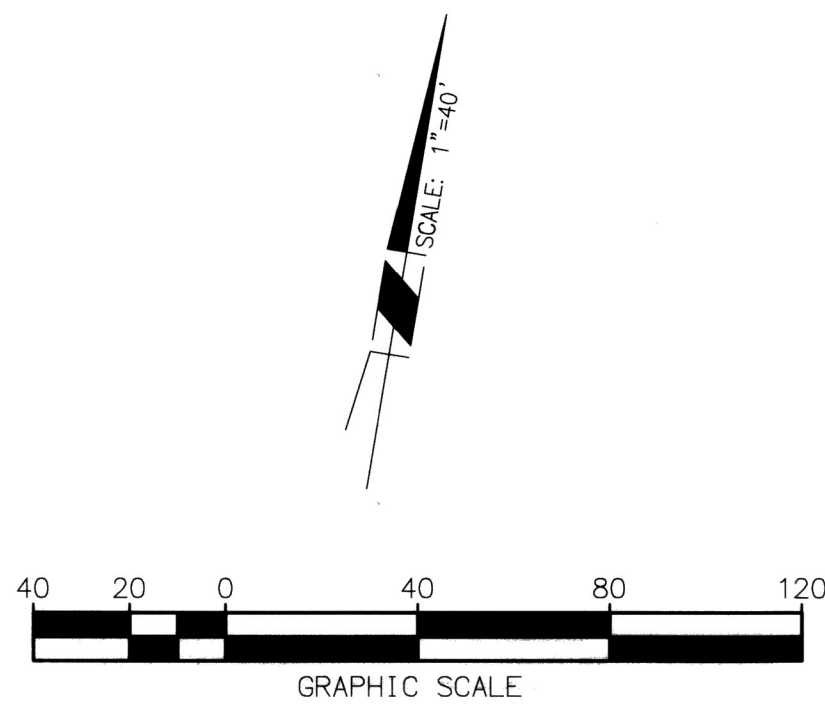


MATCH LINE - SEE SHEET 6




As Built 5/04/23 13.0

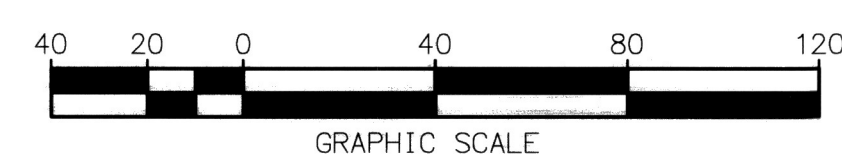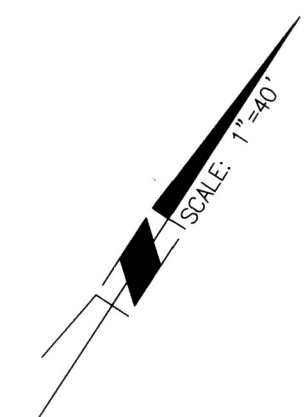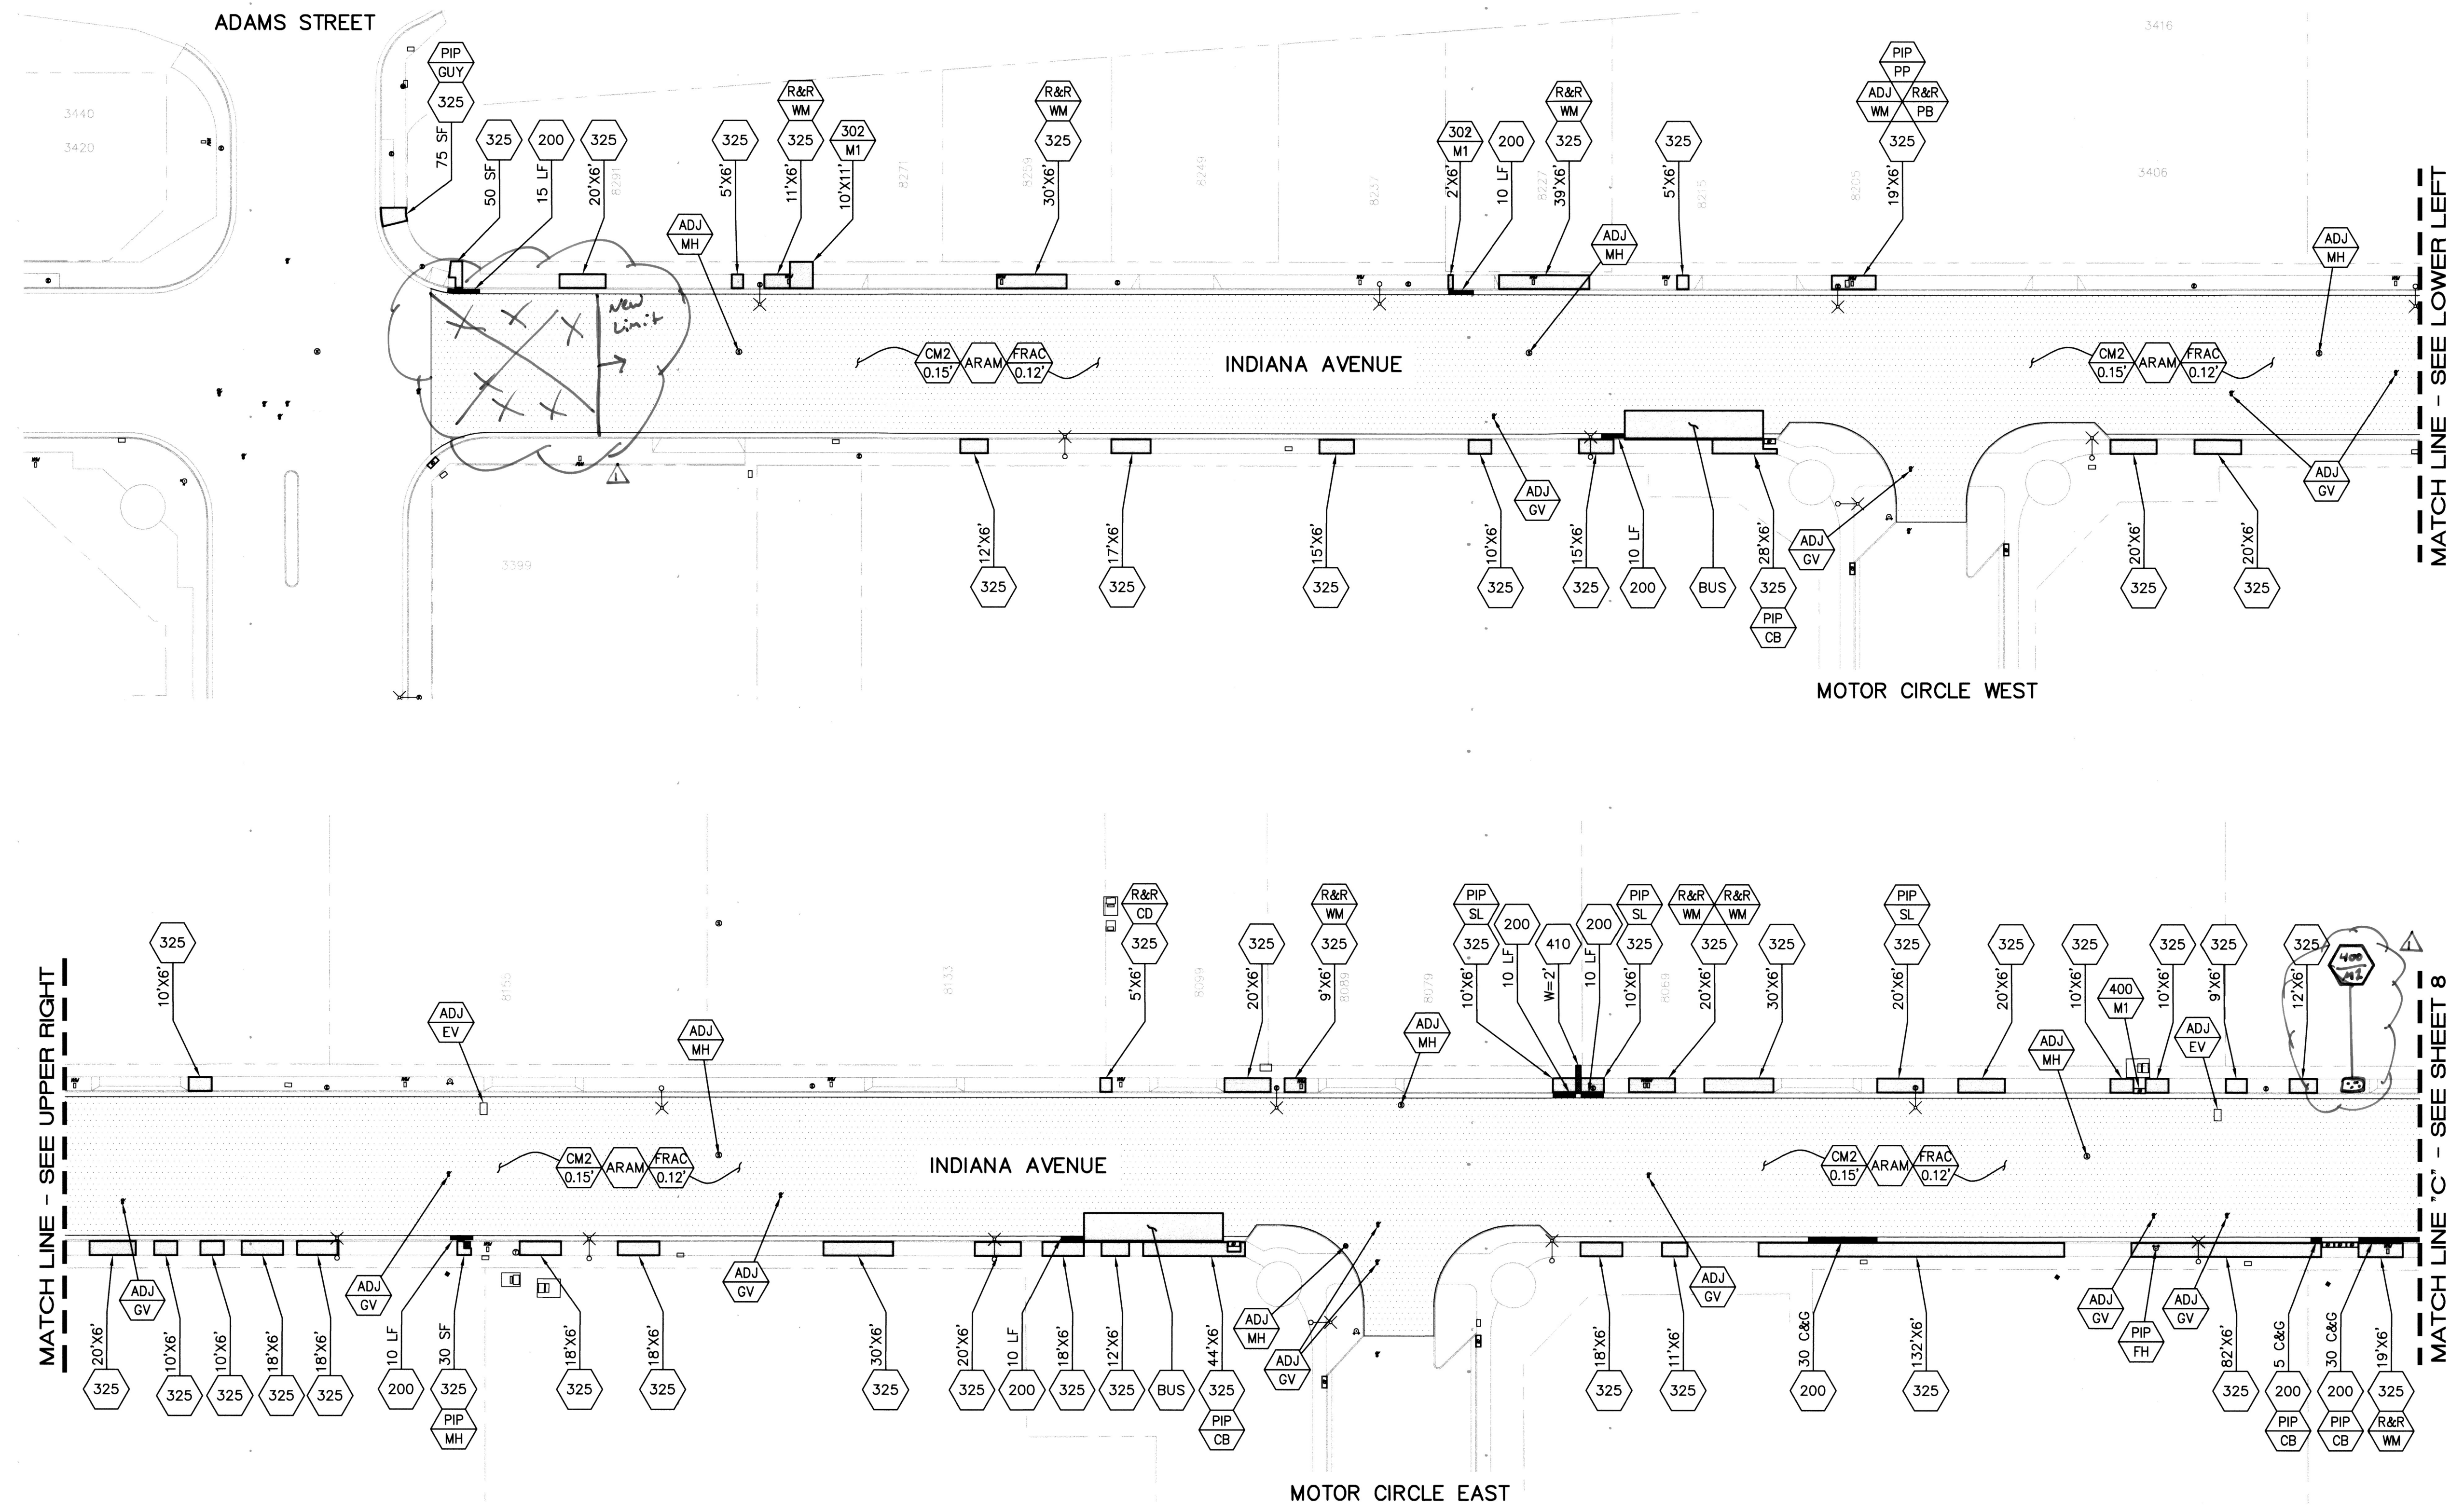 SB1 Under Ground Service Alert of Southern California Call: TOLL FREE 1-800 227-2600 TWO WORKING DAYS BEFORE YOU DIG	 ENGINEER IN RESPONSIBLE CHARGE <i>Edward Lara</i> Edward Lara R.C.E. No. 63753 EXPIRES: 9-30-22 DATE June 16, 2021		CITY OF RIVERSIDE, CALIFORNIA DEPARTMENT OF PUBLIC WORKS				STREET MAINTENANCE		DESIGN WORK ORDER NO.: 2108424 CONSTR. WORK ORDER NO.: 2108425
			APPROVED BY: <i>[Signature]</i> DATE: 8/2/21 BY: <i>[Signature]</i> DATE: 7/29/21 CONSTRUCTION ADMIN. <i>[Signature]</i> TRAFFIC DIVISION <i>[Signature]</i> SURVEY <i>[Signature]</i> STREETS <i>[Signature]</i>	2020/2021 SB1 STREET MAINTENANCE IMPROVEMENTS LOCATION 3 HORIZ. SCALE: 1"=40' VERT. SCALE: N/A		R-4525 SHEET 05 OF 13 FILE NAME: R4525-ALL.DWG			


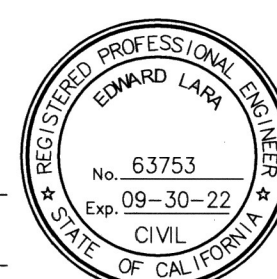


 SB1 Under Ground Service Alert of Southern California Call: TOLL FREE 1-800 227-2600 TWO WORKING DAYS BEFORE YOU DIG	 ENGINEER IN RESPONSIBLE CHARGE <i>Edward Lara</i> Edward Lara R.C.E. No. 63753 EXPIRES: 9-30-22 DATE: <i>June 16, 2021</i>		CITY OF RIVERSIDE, CALIFORNIA DEPARTMENT OF PUBLIC WORKS				STREET MAINTENANCE		DESIGN WORK ORDER NO.: 2108424 CONSTR. WORK ORDER NO.: 2108425
			APPROVED BY: <i>DC</i> ENGINEERING MANAGER CONSTRUCTION ADMIN. TRAFFIC DIVISION SURVEY STREETS	BY: <i>DC</i> DATE: <i>8/21/21</i>	APPROVED BY: <i>DC</i> CITY ENGINEER DATE: <i>Aug. 4, 2021</i>	2020/2021 SB1 STREET MAINTENANCE IMPROVEMENTS LOCATION 4 HORIZ. SCALE: 1"=40' VERT. SCALE: N/A		R-4525 SHEET 07 OF 13 FILE NAME: R4525-ALL.DWG	

As Built 5/04/23 B.O

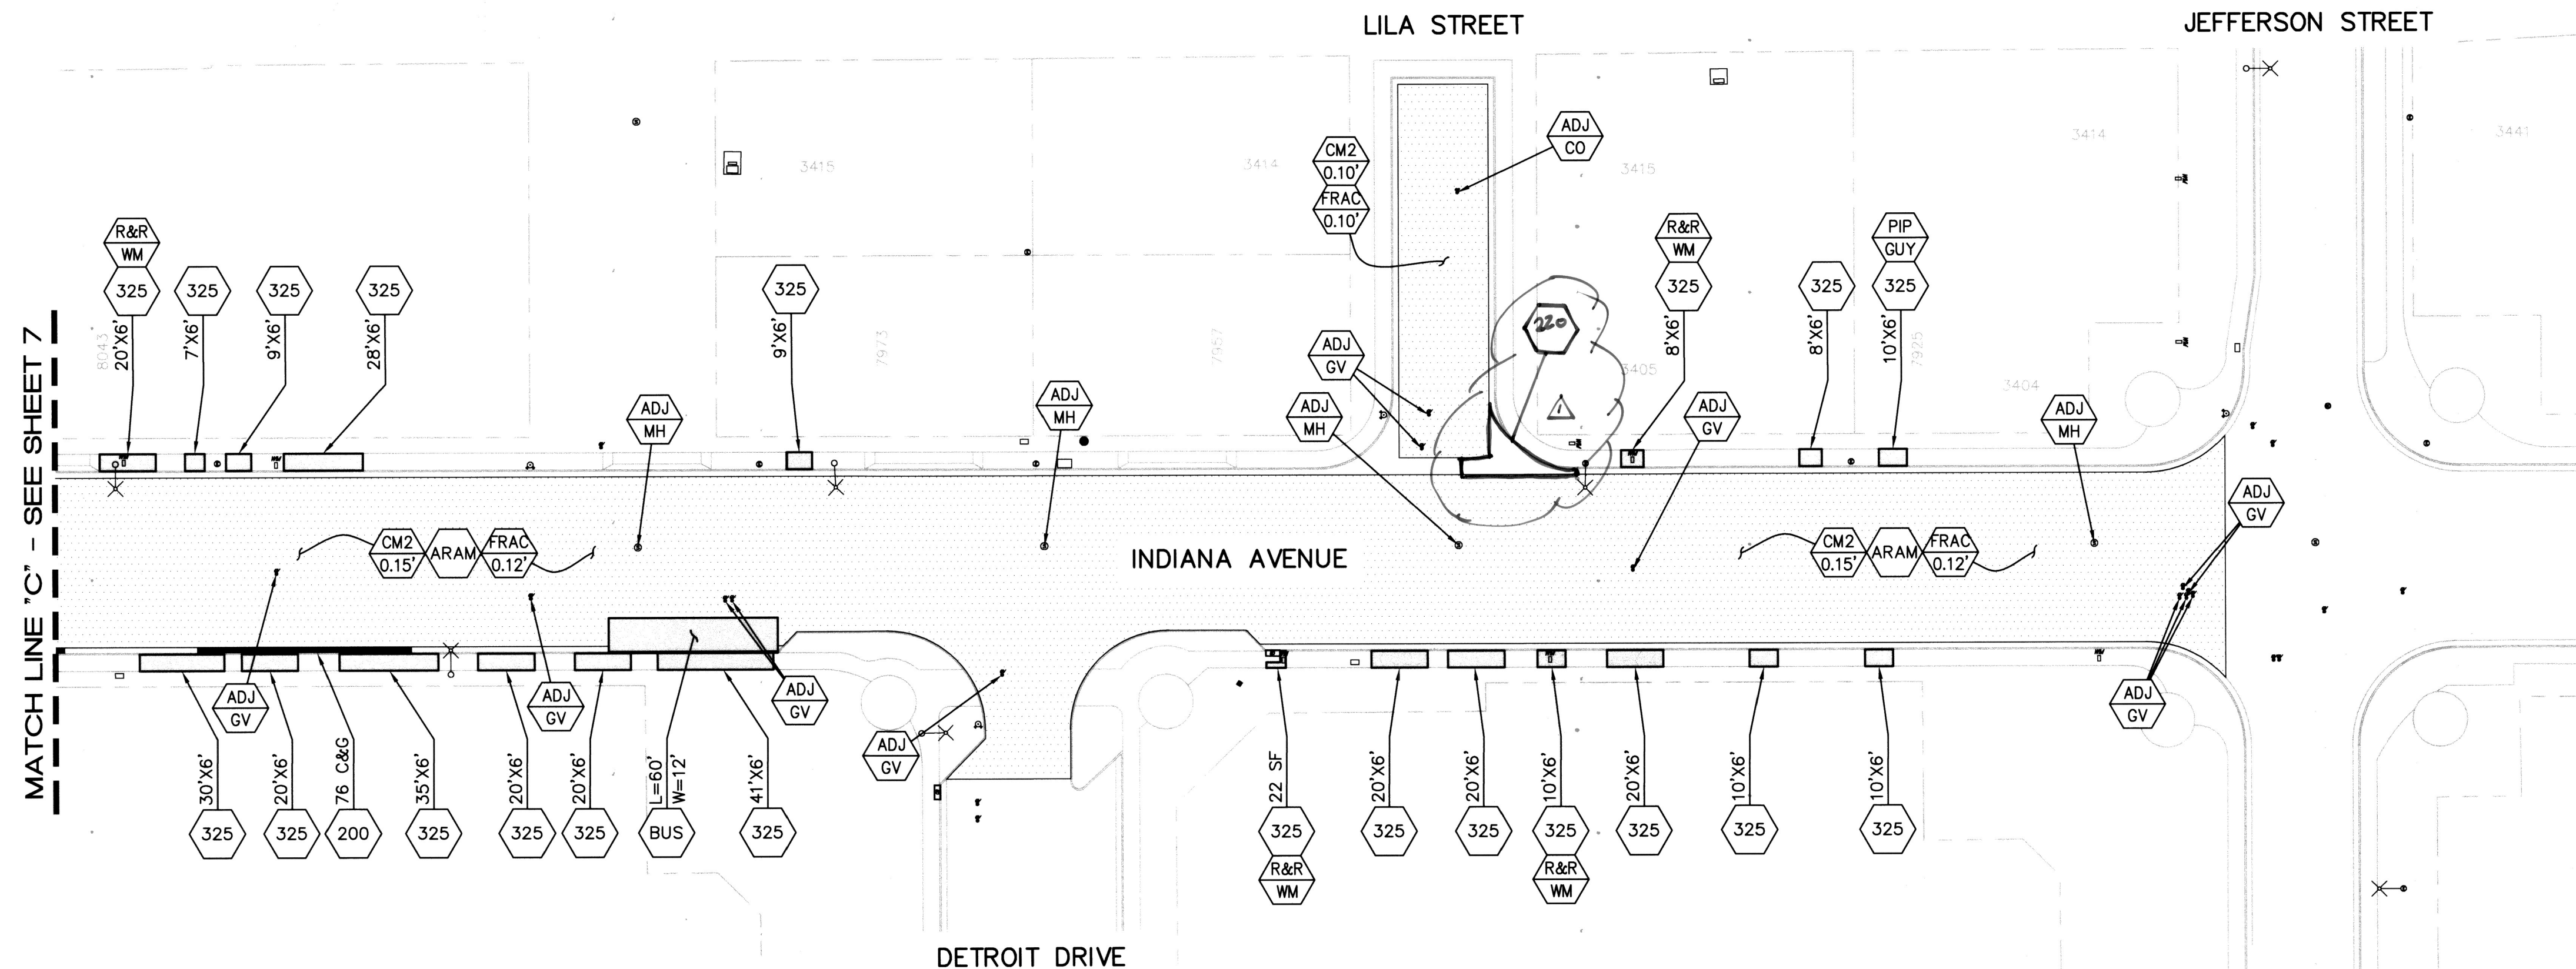


MATCH LINE 'C' - SEE SHEET 7

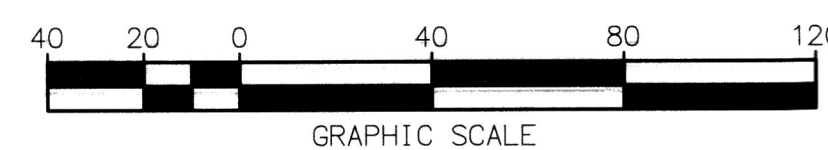
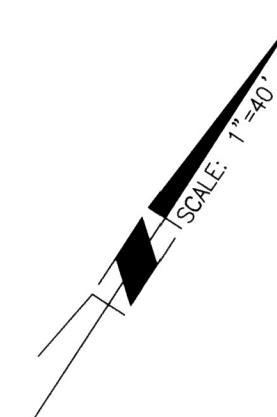


As Built 5/04/23 B.O


 Under Ground Service Alert of Southern California Call: TOLL FREE 1-800-227-2600 TWO WORKING DAYS BEFORE YOU DIG	 ENGINEER IN RESPONSIBLE CHARGE Edward Lara R.C.E. No. 63753 EXPIRES: 9-30-22 DATE <u>June 16, 2021</u>		CITY OF RIVERSIDE, CALIFORNIA DEPARTMENT OF PUBLIC WORKS				STREET MAINTENANCE		DESIGN WORK ORDER NO.: 2108424 CONSTR. WORK ORDER NO.: 2108425
			APPROVED BY: <u>EL</u> DATE: <u>8-2-2021</u> ENGINEERING MANAGER				APPROVED BY: <u>[Signature]</u> CITY ENGINEER		R-4525
			CONSTRUCTION ADMIN. <u>DL</u> TRAFFIC DIVISION <u>WM</u>				DATE: <u>Aug 4, 2021</u>		SHEET <u>08</u> OF <u>13</u>
			DESIGNED BY: <u>DMC</u> DRAWN BY: <u>DMC</u> CHECKED BY: <u>EL</u>				LOCATION 4 HORIZ. SCALE: 1"=40' VERT. SCALE: N/A		FILE NAME: R4525-ALL.DWG

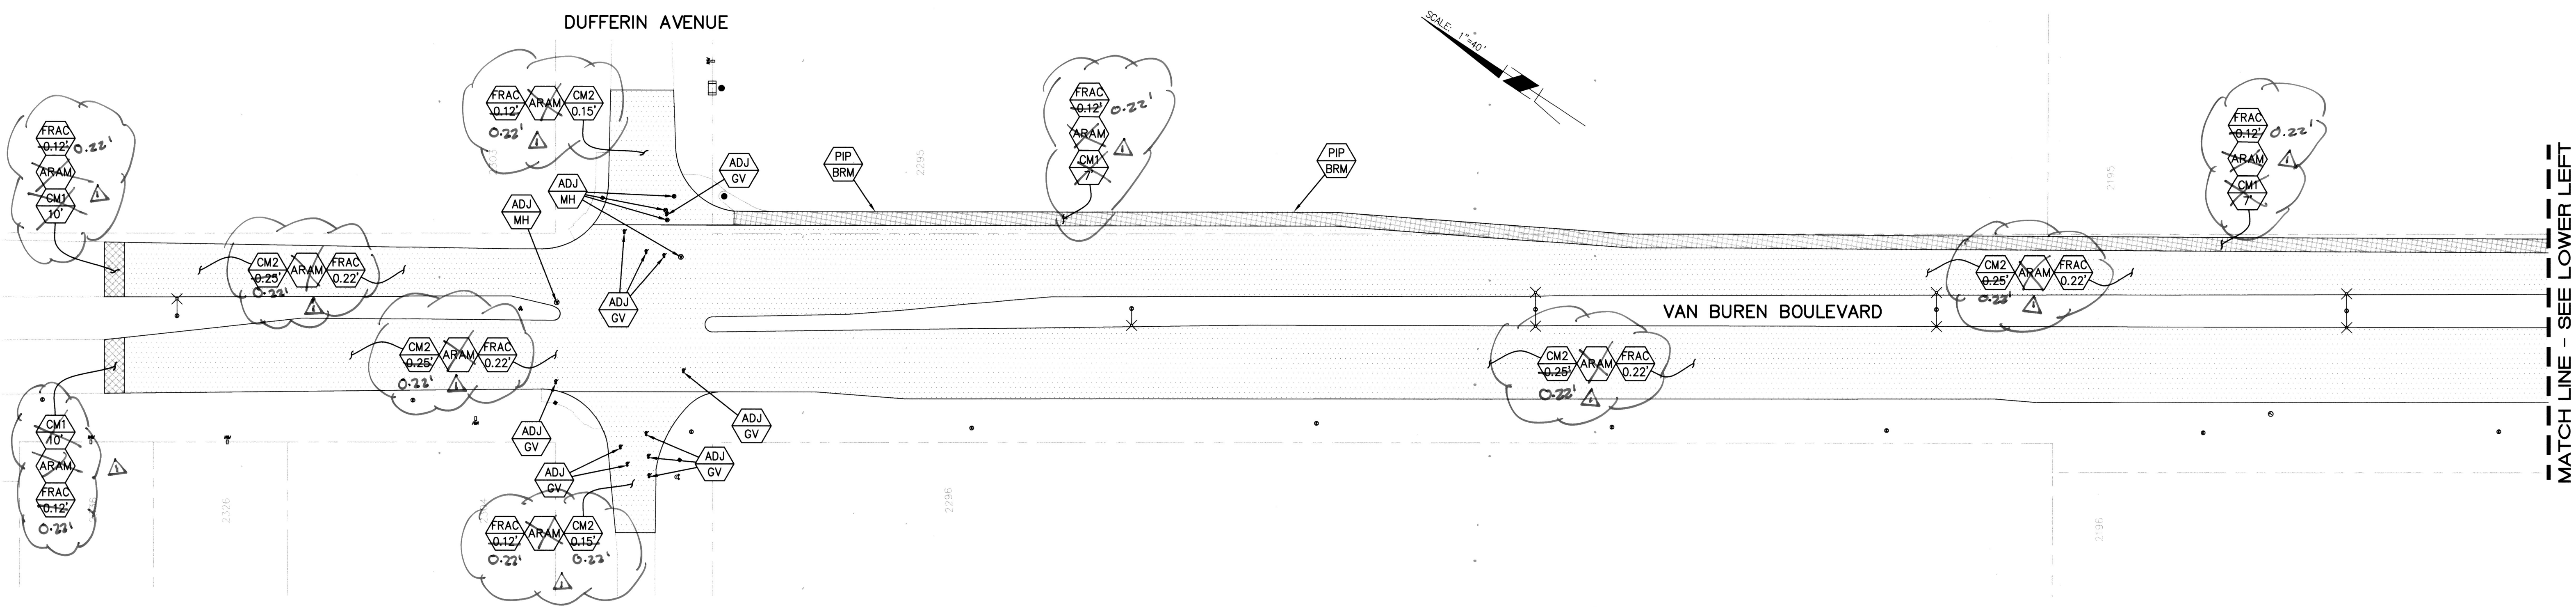


••CM1 COLDMILLING SHALL BE 6" OFF OF ALL EXISTING AC BERMS TO PROTECT THE BERMS IN PLACE••

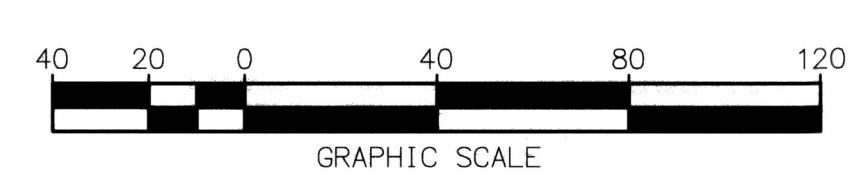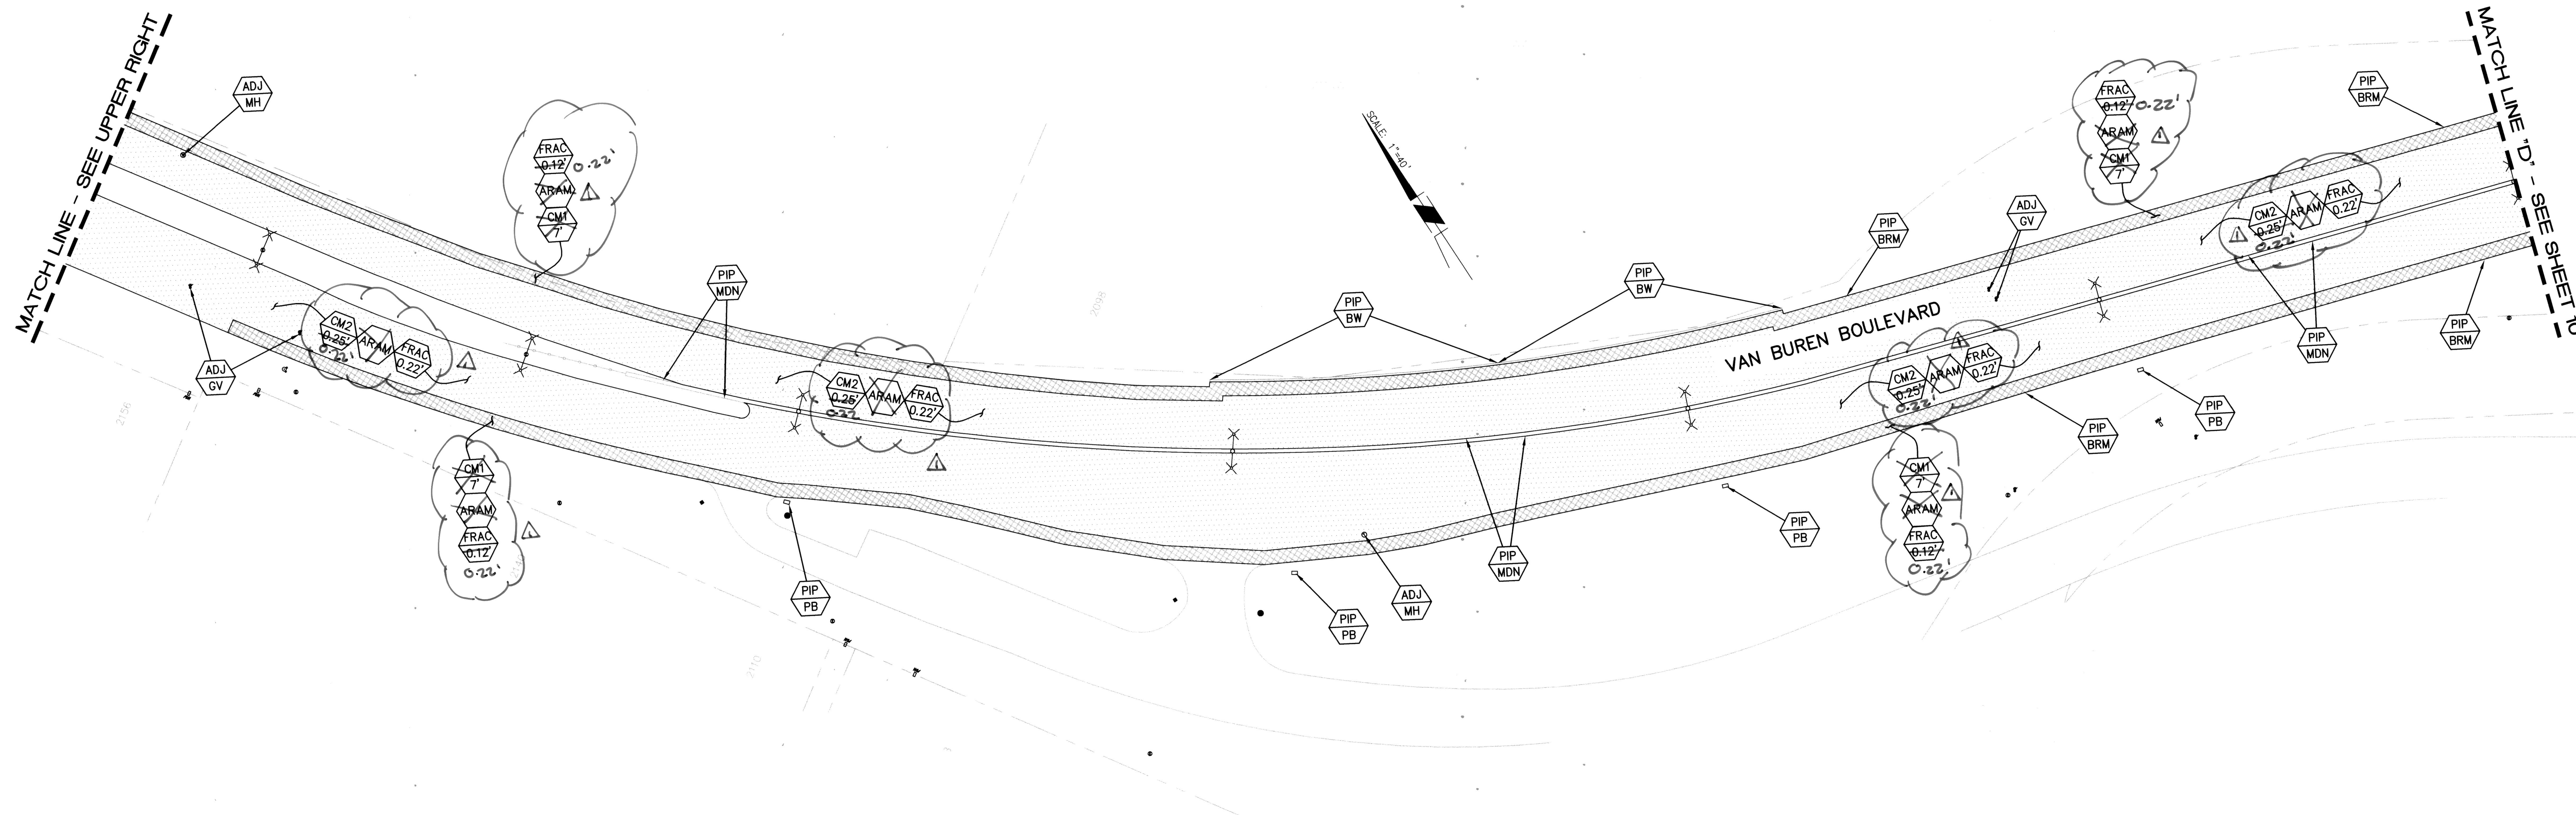

Under Ground Service Alert of Southern California
Call: TOLL FREE 1-800 227-2600
TWO WORKING DAYS BEFORE YOU DIG

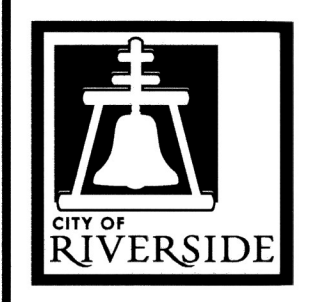

ENGINEER IN RESPONSIBLE CHARGE
Edward Lara
R.C.E. No. 63753 EXPIRES: 9-30-22
DATE June 16, 2021

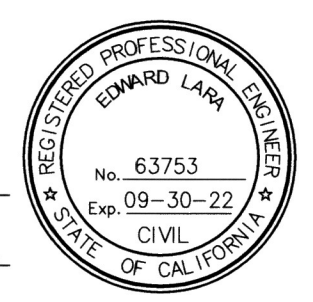

MARK	REVISIONS	APPR.	DATE
1	Pavement revision	EL	8/2/21
DESIGNED BY	DMC	DRAWN BY	DMC
CHECKED BY	EL		

CITY OF RIVERSIDE, CALIFORNIA DEPARTMENT OF PUBLIC WORKS			
APPROVED BY	BY	DATE	APPROVED BY
ENGINEERING MANAGER	EC	8/2/21	CITY ENGINEER
CONSTRUCTION ADMIN.	DC	7/29/21	
TRAFFIC DIVISION	DM		
SURVEY			
STREETS			
DATE	AUG 4, 2021		

STREET MAINTENANCE	
2020/2021 SB1 STREET MAINTENANCE IMPROVEMENTS	
LOCATION 5	
HORIZ. SCALE: 1"=40'	VERT. SCALE: N/A

DESIGN WORK ORDER NO.: 2108424	CONSTR. WORK ORDER NO.: 2108425
R-4525	
SHEET 09 OF 13	
FILE NAME: R4525-ALL.DWG	

As Built 5/04/23 B.O

MATCH LINE 'D' - SEE SHEET 9



MATCH LINE - SEE UPPER RIGHT

MATCH LINE - SEE LOWER LEFT

MATCH LINE 'E' - SEE SHEET 11



CM1 COLDMILLING SHALL BE 6" OFF OF ALL EXISTING AC BERMS TO PROTECT THE BERMS IN PLACE

AC INLET APRON DETAIL

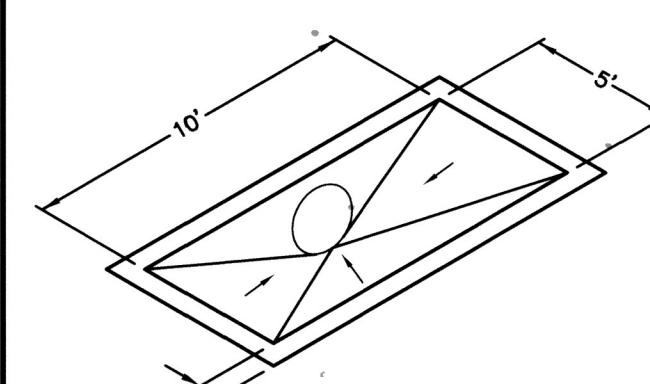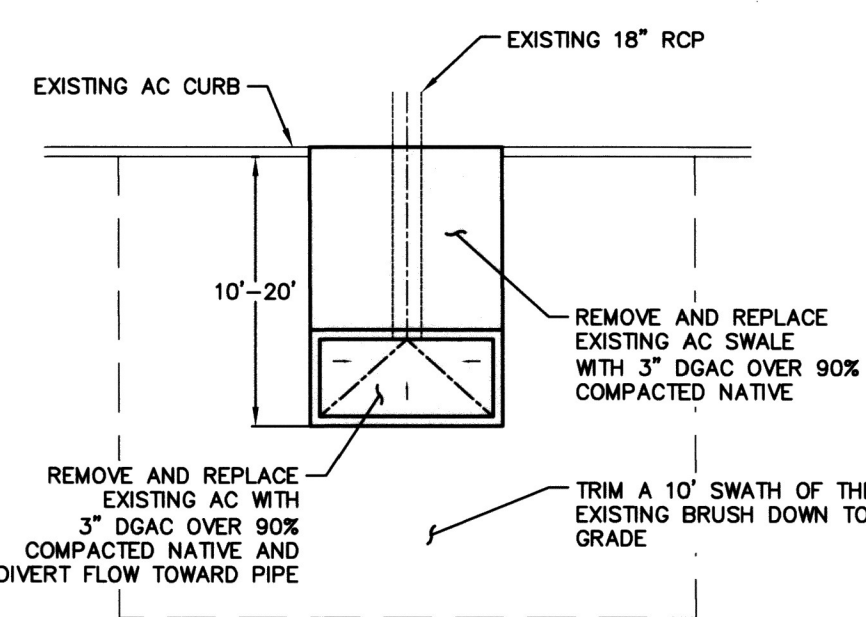


ISOMETRIC VIEW


NOT TO SCALE

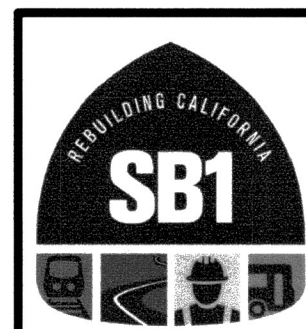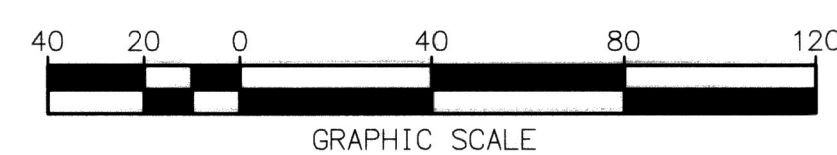

Under Ground Service Alert of Southern California
Call: TOLL FREE 1-800-227-2600
TWO WORKING DAYS BEFORE YOU DIG

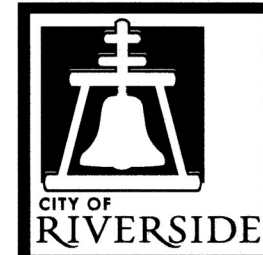

ENGINEER IN RESPONSIBLE CHARGE
Edward Lara
R.C.E. No. 63753 EXPIRES: 9-30-22
DATE June 16, 2021

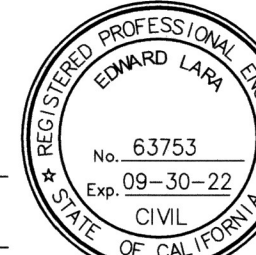

DESIGNED BY: DMC DRAWN BY: DMC CHECKED BY: EL

CITY OF RIVERSIDE, CALIFORNIA DEPARTMENT OF PUBLIC WORKS

APPROVED BY: [Signature] DATE: 8.2.21
ENGINEERING MANAGER
CONSTRUCTION ADMIN. [Signature] DATE: 7/29/21
TRAFFIC DIVISION
SURVEY
STREETS

STREET MAINTENANCE

2020/2021 SB1 STREET MAINTENANCE IMPROVEMENTS

LOCATION 5

HORIZ. SCALE: 1"=40' VERT. SCALE: N/A

DESIGN WORK ORDER NO.: 2108424
CONSTR. WORK ORDER NO.: 2108425

R-4525

SHEET 10 OF 13

FILE NAME: R4525-ALL.DWG

As Built 5/04/23 B.C

MATCH LINE 'E' - SEE SHEET 10

MATCH LINE - SEE LOWER LEFT

EQUESTRIAN DRIVE

VAN BUREN BOULEVARD


CM1 COLDMILLING SHALL BE 6" OFF OF ALL EXISTING AC BERMS TO PROTECT THE BERMS IN PLACE




VAN BUREN BOULEVARD

CANYON RIDGE DRIVE



NOTE: COUNTY OF RIVERSIDE ENCROACHMENT PERMIT REQUIRED

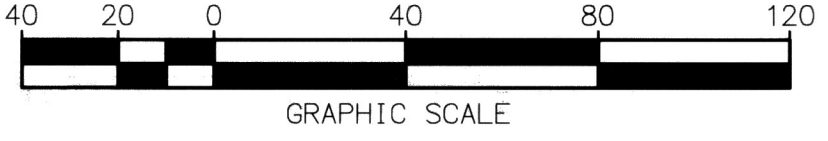CITY OF RIVERSIDE LIMITS
COUNTY OF RIVERSIDE LIMITS






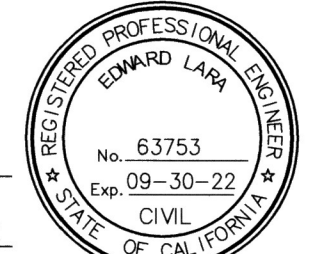


 Under Ground Service Alert Call: TOLL FREE 1-800-227-2600 TWO WORKING DAYS BEFORE YOU DIG	 ENGINEER IN RESPONSIBLE CHARGE Edward Lara R.C.E. No. 63753 EXPIRES: 9-30-22 DATE: June 16, 2021		CITY OF RIVERSIDE, CALIFORNIA DEPARTMENT OF PUBLIC WORKS				STREET MAINTENANCE		DESIGN WORK ORDER NO.: 2108424
			APPROVED BY: [Signature] ENGINEERING MANAGER CONSTRUCTION ADMIN. [Signature] TRAFFIC DIVISION [Signature] SURVEY [Signature] STREETS [Signature]	DATE: 8/21/21 DATE: 7/19/21 DATE: AUG 4, 2021	2020/2021 SB1 STREET MAINTENANCE IMPROVEMENTS		CONSTR. WORK ORDER NO.: 2108425		
			LOCATION 5		R-4525		SHEET 11 OF 13		FILE NAME: R4525-ALL.DWG



As Built 5/04/23 B.O

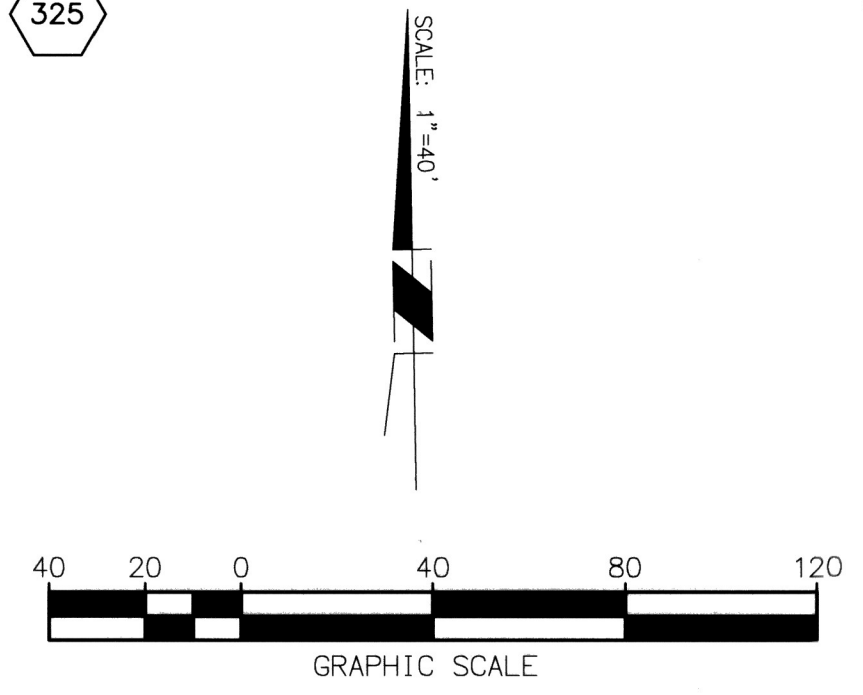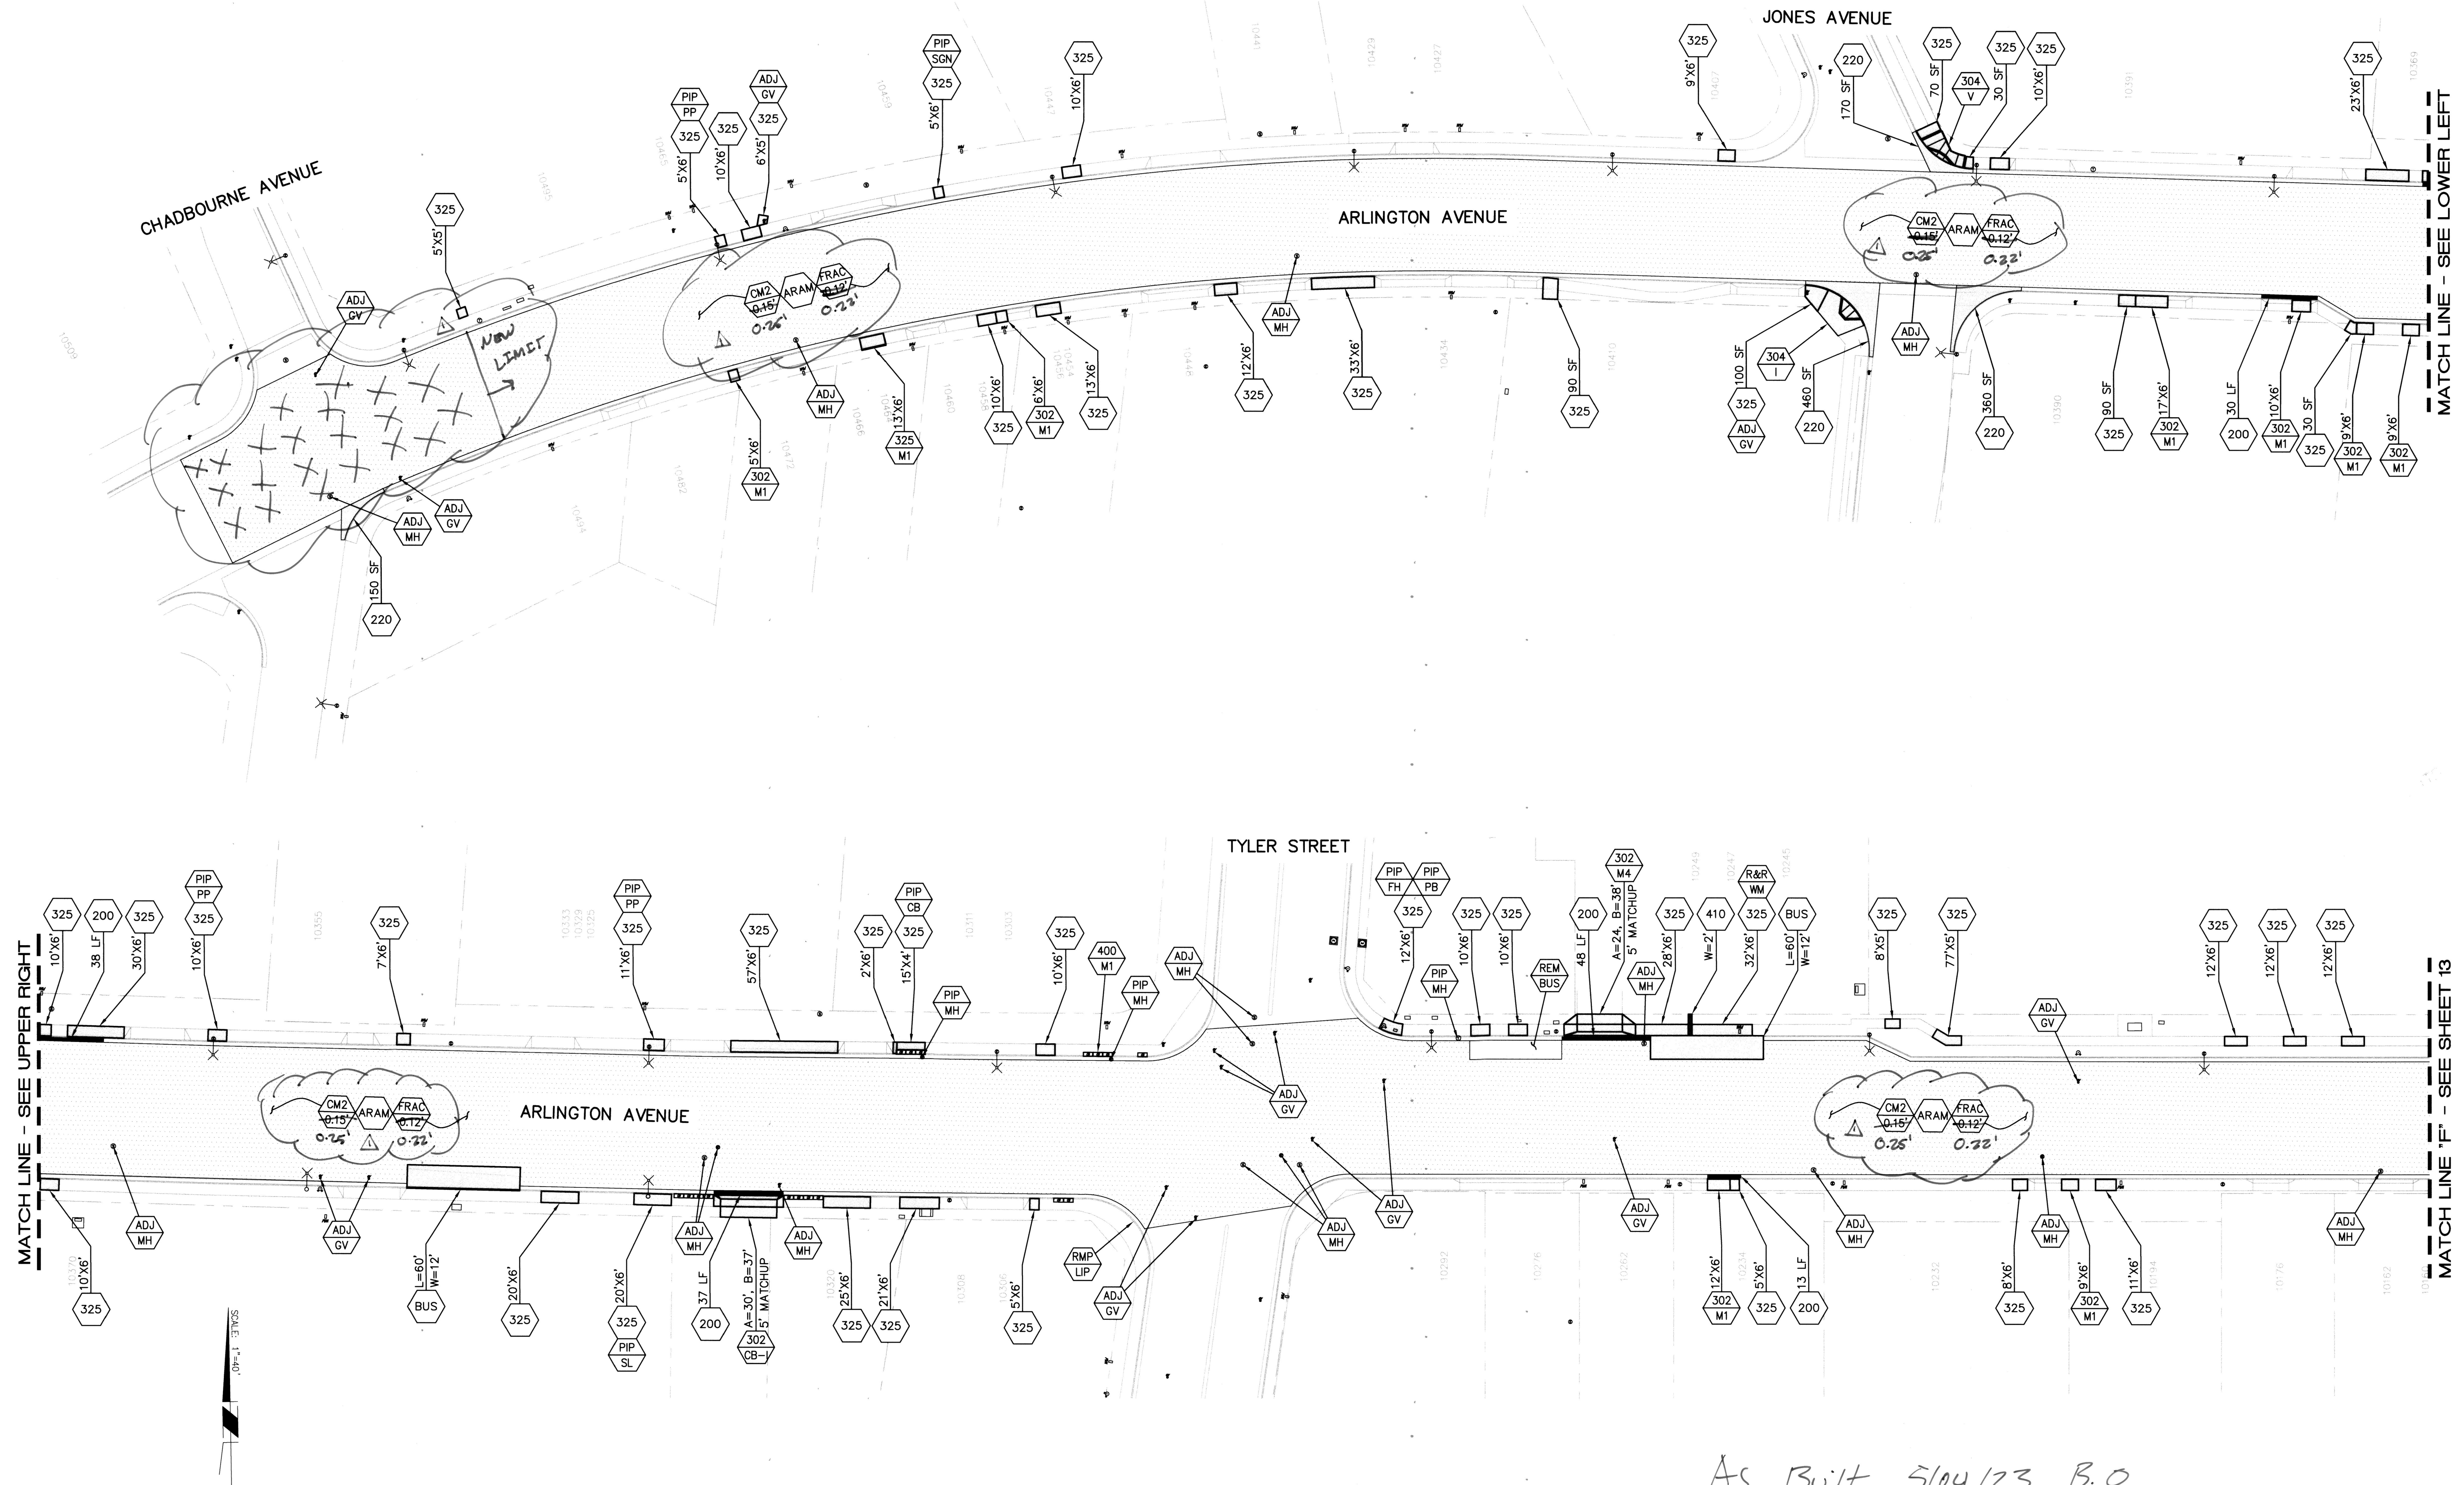

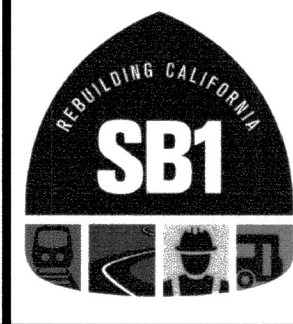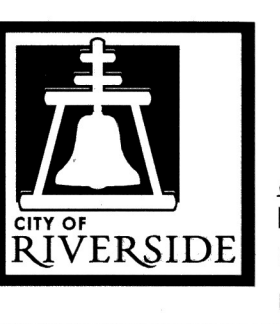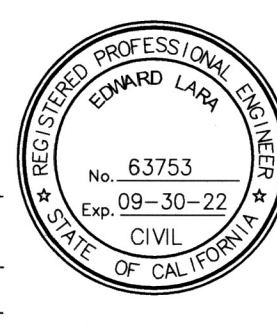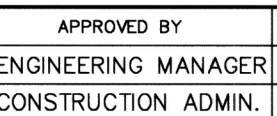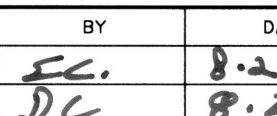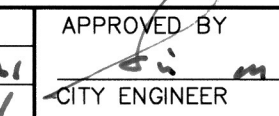


As Built 5/04/23 B.O

 Under Ground Service Alert Call: TOLL FREE 1-800-227-2600 TWO WORKING DAYS BEFORE YOU DIG	 ENGINEER IN RESPONSIBLE CHARGE Edward Lara R.C.E. No. 63753 EXPIRES: 9-30-22 DATE: June 15, 2021	 CITY OF RIVERSIDE	CITY OF RIVERSIDE, CALIFORNIA DEPARTMENT OF PUBLIC WORKS				STREET MAINTENANCE		DESIGN WORK ORDER NO.: 2108424 CONSTR. WORK ORDER NO.: 2108425
			APPROVED BY:  ENGINEERING MANAGER CONSTRUCTION ADMIN. TRAFFIC DIVISION SURVEY STREETS	BY:  DATE: 8-2-21 7/22/21	APPROVED BY:  CITY ENGINEER DATE: Aug. 4, 2021	2020/2021 SB1 STREET MAINTENANCE IMPROVEMENTS LOCATION 6 HORIZ. SCALE: 1"=40' VERT. SCALE: N/A		R-4525 SHEET 12 OF 13 FILE NAME: R4525-ALL.DWG	

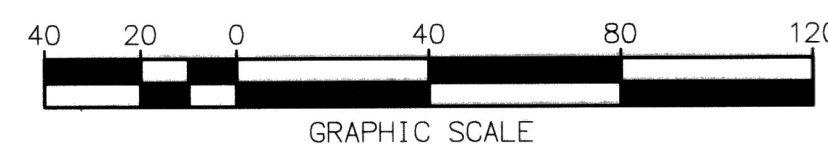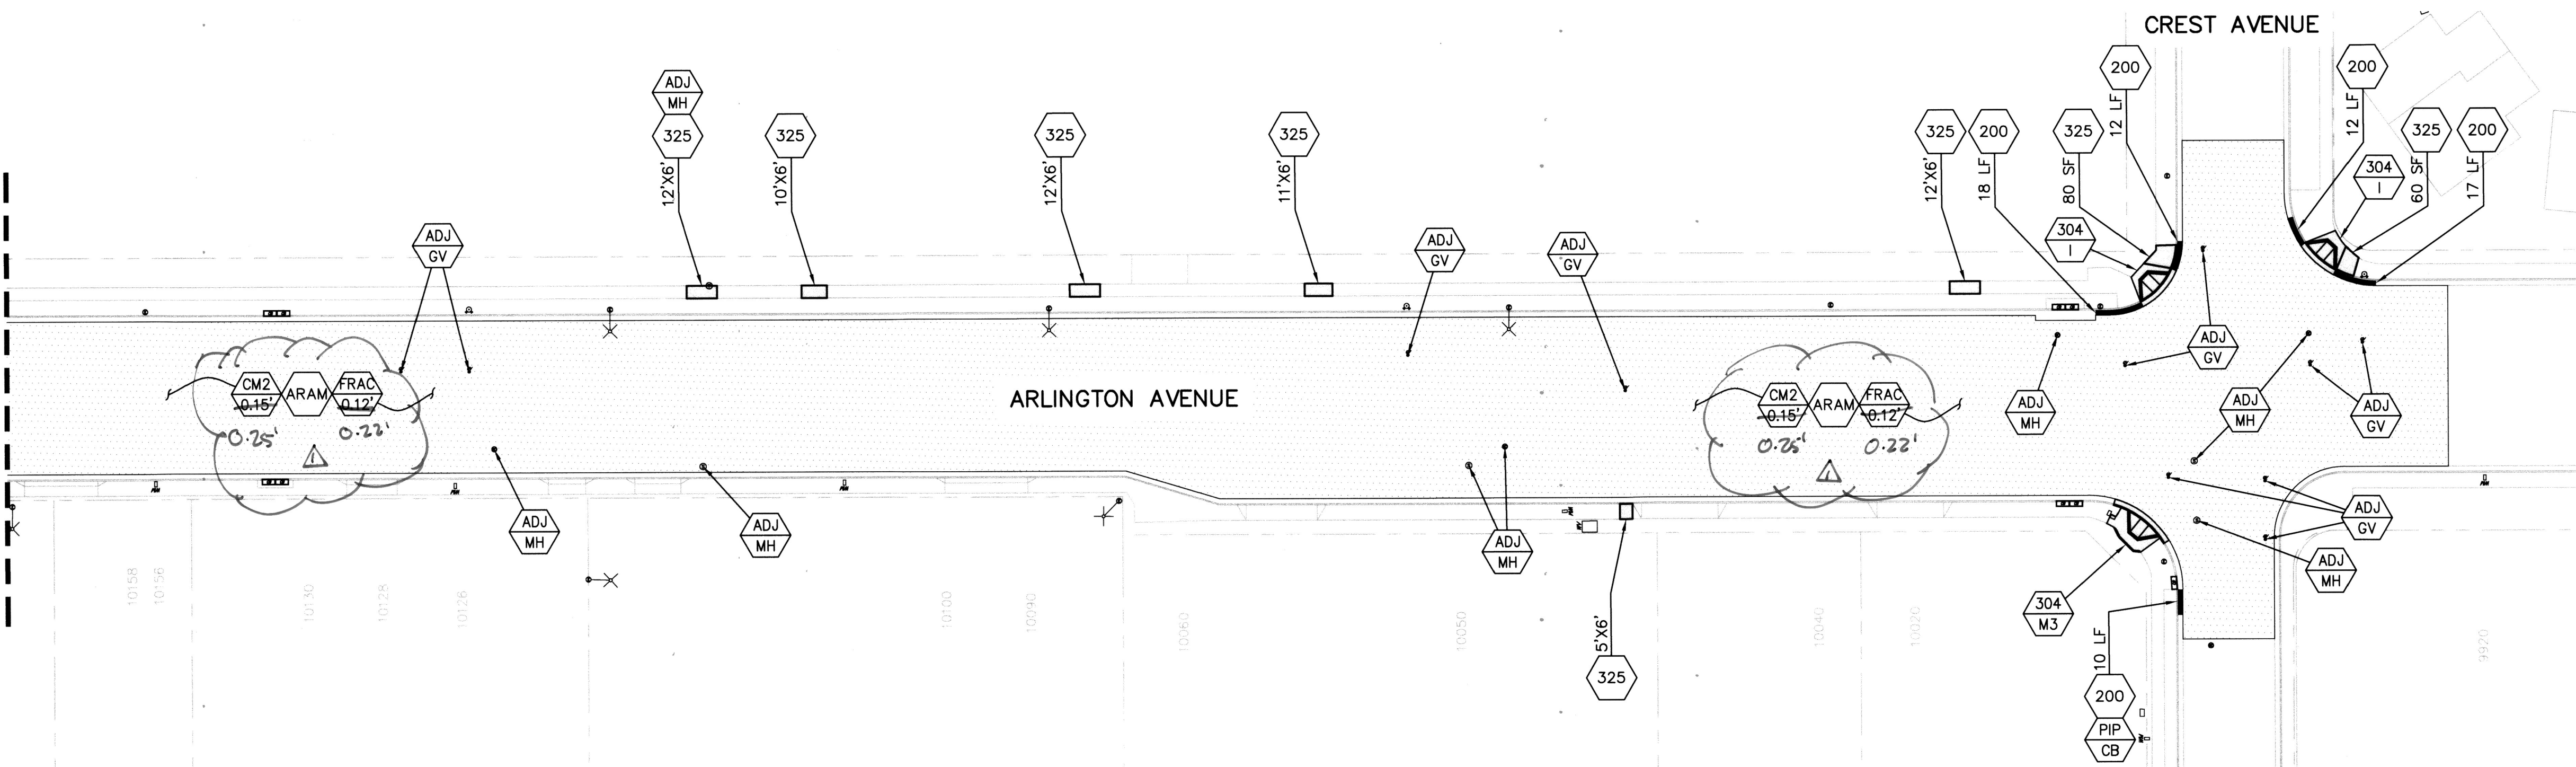MATCH LINE "F" - SEE SHEET 12



As B.O.I.T 5/04/23 B.O

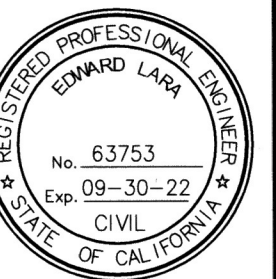 Under Ground Service Alert of Southern California Call: TOLL FREE 1-800-227-2600 TWO WORKING DAYS BEFORE YOU DIG	 ENGINEER IN RESPONSIBLE CHARGE <i>Edward Lara</i> Edward Lara R.C.E. No. 63753 EXPIRES: 9-30-22 DATE <i>June 16, 2021</i>		CITY OF RIVERSIDE, CALIFORNIA DEPARTMENT OF PUBLIC WORKS				STREET MAINTENANCE		DESIGN WORK ORDER NO.: 2108424 CONSTR. WORK ORDER NO.: 2108425
			APPROVED BY ENGINEERING MANAGER CONSTRUCTION ADMIN. TRAFFIC DIVISION SURVEY STREETS	BY <i>EL</i> <i>NM</i>	DATE <i>8-2-21</i> <i>7/29/21</i>	APPROVED BY CITY ENGINEER <i>[Signature]</i> DATE <i>Aug 4, 2021</i>	2020/2021 SB1 STREET MAINTENANCE IMPROVEMENTS LOCATION 6 HORIZ. SCALE: 1"=40' VERT. SCALE: N/A		R-4525 SHEET 13 OF 13 FILE NAME: R4525-ALL.DWG