

Street: BRADFORD


X-Street: RUTLAND

OFFICIAL USE ONLY

PROJECT NAME TR. 21138 21138-1

~~RUTLAND BRADFORD~~ ~~RUTLAND & BRADFORD~~
FIELD SURVEY RECORD ~~BRADFORD & ROSSINI~~

CHARGE CODE 7-5-88 JOB LOG NO. _____
DATE 11-30-87 PAGE _____ OF _____
CREW RB MM BOOK _____
PROJECT LIMITS 5-11-11-87-87
CHECKED BY _____

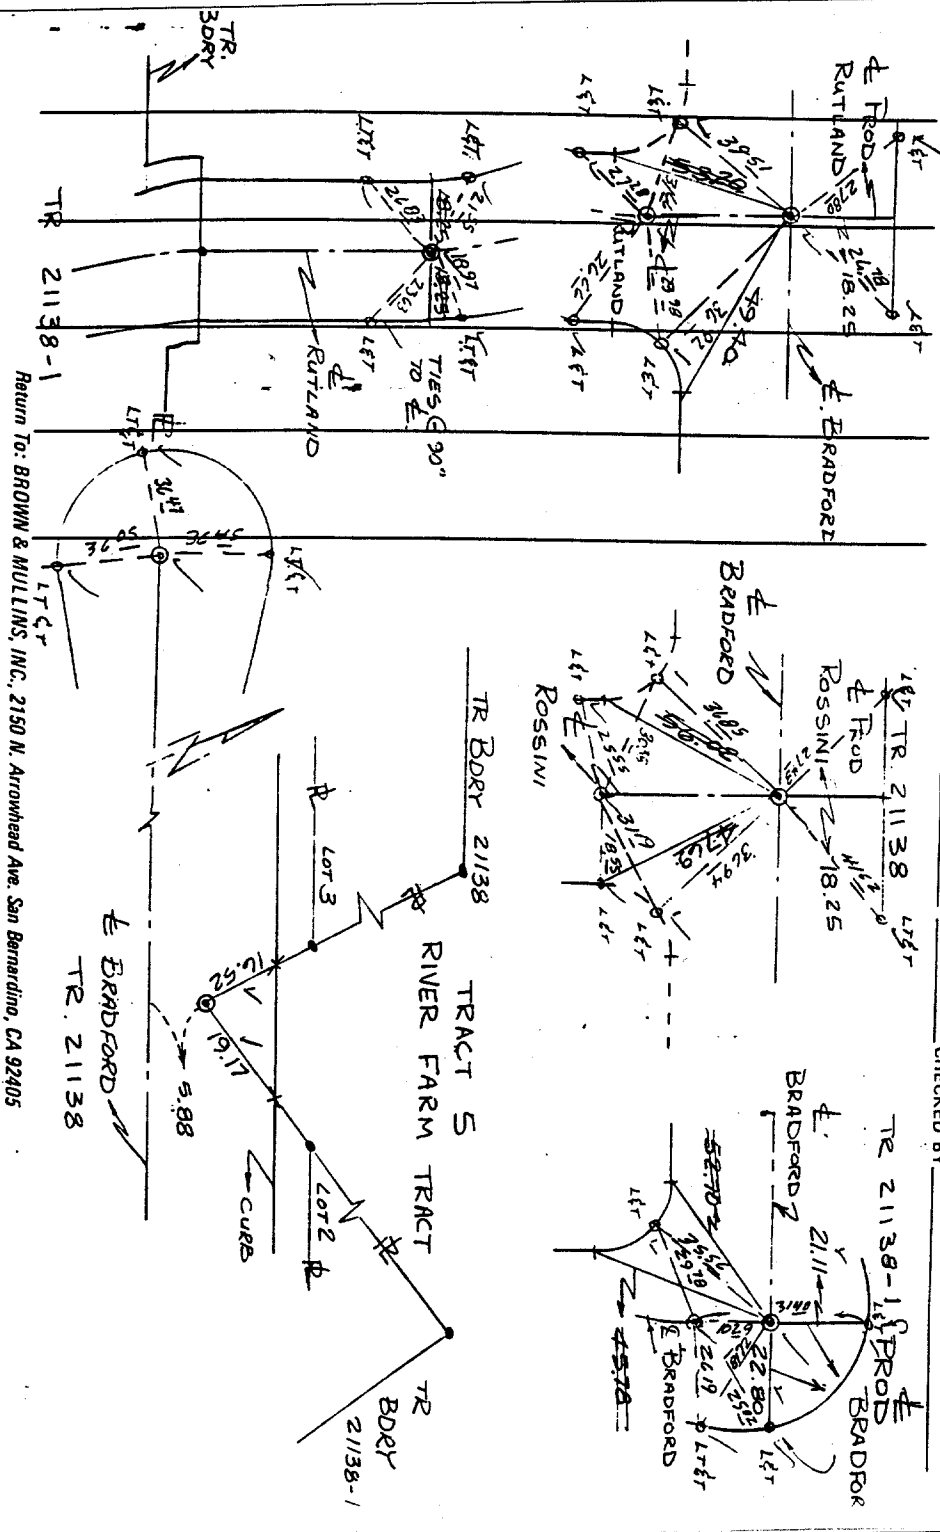

Return to: BROWN & MULLINS, INC., 2150 N. Arrowhead Ave. San Bernardino, CA 92405

112.228

- ✗ FD. Ramset Nail on T/C
- FD. LD. & TK. on T/C
- FD. "C" Nail on T/C
- Set LD. & TK. on T/C

OFFICIAL TIE PLAT

CITY OF RIVERSIDE

These ties are for the purpose of perpetuating the found monumentation. No claim is made as to the relationship of the points or lines shown hereon to true boundary locations.

Scale: _____
 Date: _____
 Drawn by: _____
 W.O.: _____
 F.B.: _____

Sheet 1 of 1
 File No.: _____