


## SIGNING AND STRIPING GENERAL NOTES:

- 1. SIGNING AND STRIPING INSTALLATIONS SHALL CONFORM TO THE CALIFORNIA MANUAL ON UNIFORM TRAFFIC CONTROL DEVICES (CA MUTCD), THE STATE OF CALIFORNIA DEPARTMENT OF TRANSPORTATION (CALTRANS) STANDARD PLANS AND SPECIFICATIONS DATED 2010, AND ALL ADDENDUMS THERETO, AND THE CITY OF RIVERSIDE PUBLIC WORKS DEPARTMENT STANDARD DRAWINGS, CURRENT EDITION.
- 2. ALL STRIPING, MARKINGS, AND LEGENDS SHALL BE REFLECTORIZED THERMOPLASTIC UNLESS OTHERWISE NOTED. THE CONTRACTOR SHALL PROVIDE AND INSTALL RAISED PAVEMENT MARKERS FOR ALL STRIPING. STRIPING, MARKINGS AND LEGENDS SHALL CONFORM TO THE LATEST CALTRANS STANDARD PLANS A20A THRU A20D AND A24A THRU A24E.
- 3. PRIOR TO FINAL ACCEPTANCE OF STREET IMPROVEMENTS, ALL PAVEMENT STRIPING AND STENCILING WITHIN THE PERIMETER OF THE CONSTRUCTION AREA SHALL BE RESTORED TO LIKE NEW CONDITION, IN A MANNER MEETING THE APPROVAL OF THE CITY OF RIVERSIDE.
- 4. THE CONTRACTOR SHALL RE-STRIPE EXISTING STRIPING AND CURB MARKINGS OBLITERATED BY NEW CONSTRUCTION, WHETHER OR NOT SHOWN ON THE PLANS FOR REPLACEMENT, AT NO COST TO THE CITY.
- 5. AT LOCATIONS WHERE EXISTING PAINTED CURB IS TO BE RECONSTRUCTED, THE CONTRACTOR SHALL PAINT THE NEW CURB AS SHOWN ON THE PLANS WITHIN 10 WORKING DAYS OF CURB CONSTRUCTION OR AS DIRECTED BY ENGINEER. THE PAINT SHALL BE WATER-BASED WITH 2-YEAR GUARANTEE AGAINST COLOR FADING. PRIOR TO THE START OF CONSTRUCTION, THE CONTRACTOR SHALL SUBMIT TO THE CITY WRITTEN PROOF OF THE MANUFACTURER'S 2-YEAR GUARANTEE.
- 6. ALL NEW STRIPING SHALL BE "CAT TRACKED" AND APPROVED BY THE ENGINEER PRIOR TO FINAL INSTALLATION. THE CONTRACTOR SHALL NOTIFY THE ENGINEER AFTER COMPLETING LAYOUT AND AT LEAST 3 WORKING DAYS BEFORE COMMENCING INSTALLATION OF STRIPING, MARKINGS AND MARKERS.
- 7. TRAFFIC SIGN FACE SHALL BE 3M DIAMOND GRADE DG3 REFLECTIVE SHEETING (ASTM XI) OR APPROVED EQUAL WITH PROTECTIVE GRAFFITI OVERLAY FILM OR AS OTHERWISE NOTED. ALL WARNING SIGNS SHALL HAVE A FLUORESCENT YELLOW BACKGROUND AND SCHOOL SIGNS NOTED SHALL HAVE A FLUORESCENT YELLOW-GREEN BACKGROUND.
- 8. SIGNS SHALL BE STANDARD SIZE UNLESS NOTED OTHERWISE. PRIOR TO INSTALLATION, NEW SIGNS SHALL BE APPROVED BY THE CITY OF RIVERSIDE. EXACT LOCATIONS OF SIGNS SHALL BE DETERMINED BY THE CITY ENGINEER.
- 9. ALL EXISTING SIGNS AND POSTS TO BE REMOVED SHALL BE DELIVERED TO THE CITY OF RIVERSIDE SIGN DEPARTMENT.
- 10. WHEN PAINT IS SPECIFIED, TRAFFIC STRIPES AND MARKINGS SHALL BE APPLIED IN TWO COATS. A MINIMUM OF SEVEN DAYS SHALL BE PROVIDED BETWEEN FIRST AND SECOND
- 11. STRIPING SHALL BE APPLIED WITHIN 48 HOURS OF SURFACE COURSE REPLACEMENT ON STREETS OPEN TO THE PUBLIC. IN NO CASE SHALL A NEWLY PAVED STREET OPEN TO THE PUBLIC BE LEFT UNSTRIPED OVER A WEEKEND OR HOLIDAY.
- 12. CONTRACTOR SHALL INSTALL NEW SIGN(S) AND/OR POST(S) PER CITY OF RIVERSIDE STANDARD DRAWING No. 664, SEE SPECIFICATIONS.
- 13. CONTRACTOR SHALL INSTALL NEW STREET NAME SIGNS AND POST PER CITY OF RIVERSIDE STANDARD DRAWING No. 662, SEE SPECIFICATIONS.
- 14. ALL CONFLICTING STRIPING, PAVEMENT MARKINGS, LEGENDS, AND RAISED PAVEMENT MARKERS SHALL BE REMOVED EVEN IF NOT SHOWN ON PLANS. REMOVALS OF PAINTED STRIPING, PAVEMENT MARKINGS AND LEGENDS SHALL BE DONE BY WET SANDBLASTING. REMOVALS OF THERMOPLASTIC STRIPING, PAVEMENT MARKINGS AND LEGENDS SHALL BE REMOVED BY WET SANDBLASTING, GRINDING OR OTHER APPROVED METHOD AND SHALL NOT DAMAGE THE PAVEMENT. "BLACK OUT" OF EXISTING DELINEATION IS NOT PERMITTED. ALL DAMAGED PAVEMENT DUE TO REMOVALS SHALL BE REPAIRED AS NECESSARY TO MAINTAIN A SMOOTH AND UNIFORM SURFACE OR AS DIRECTED BY THE ENGINEER. ALL STRIPING REMOVALS AND LEGENDS SHALL BE "FOG SEALED".
- 15. WHERE APPLICABLE, OUTBOUND LANE LINE DETAILS SHALL COMMENCE AT THE CROSSWALK,

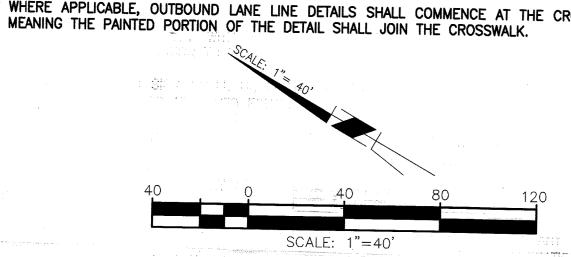

## SIGNING AND STRIPING LEGEND:


- EXISTING TO REMAIN.
- INSTALL CALTRANS STRIPING DETAIL PER NUMBER NOTED, INCLUDING INSTALLATION OF RAISED PAVEMENT MARKERS
- INSTALL PAVEMENT MARKING OR ARROW AS NOTED.
- SIGN LOCATION
- EXISTING SIGNALIZED INTERSECTION
- PROPOSED SIGN (ONE POST)
- EXISTING SIGN (ONE POST)
- EXISTING SIGN (ON STREET LIGHT)
  - EXISTING STREET NAME SIGN
  - SNS STREET NAME SIGN
  - PROPOSED WIDTH


STRIPING/SIGNAGE QUANTITIES - THIS SHEET						
ITEM	DESCRIPTION		QUANTITY	UNIT		
1	DETAIL 9		1700	LF		
2	DETAIL 22		175	LF		
3	DETAIL 25A		2740	LF		
4	DETAIL 29		20	LF		
5	DETAIL 36B	~~~	<del>~</del> 140	LF		
6	DETAIL 38	170	340	LF		
7	DETAIL "C"	,	1.	EA		
8	4" SOLID YELLOW/WHITE		150 〈	LF		
9	12" SOLID YELLOW/WHITE		310 〈	SF		
10	PAVEMENT LEGENDS/MARKINGS	4110	140	SF		
		5	1			


SIGN QUANTITIES - THIS SHEET									
SIGN NUMBER	1		INSTALL ROADSIDE SIGN(S)			INSTALL STREET NAME	RELOCATE ROADSIDE SIGN(S)		REMOVE SIGN(S)
		(IN)	NO POST	ONE POST	TW0 POST	SIGN	NO POST	ONE POST	3,0,14(3)
1-1	SNS	9				1			
1-2	R1-1	36						1	
1-3	R6-1	36X12		1					
1-4	R6-1	36X12		1					
1-5	R1-1	36						1	1
1-6	SNS	9				1		•	
	GRAND TOTAL:				0	2	0	2	1


SEE CITY OF RIVERSIDE STD DWG NO. 664 FOR ROADSIDE SIGNS SEE CITY OF RIVERSIDE STD DWG NO 662 FOR STREET NAME SIGNS


SNS = ST	REET NAME SIGN		OZ POR	SIREEI	NAME	SIGNS		~	~	
1-7	W4-2	30	Machine Lower Characters (1975)	1		The state of the s	Designation of the second of t			1
8					<u> </u>		L		*	<b>.</b>

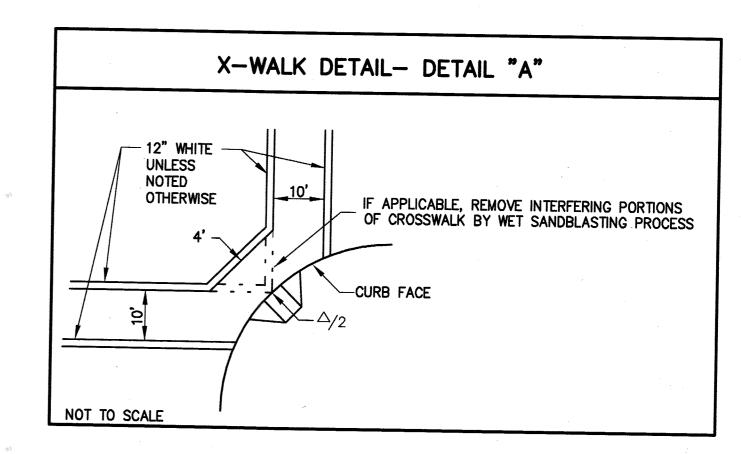

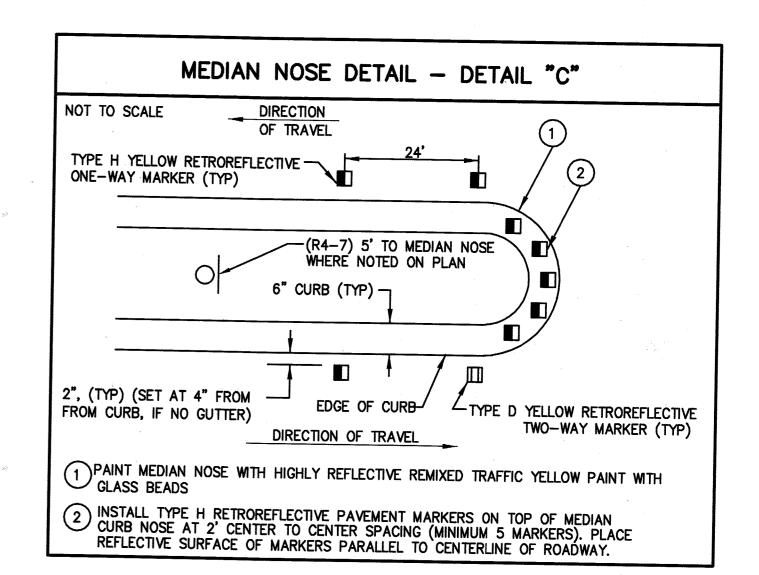

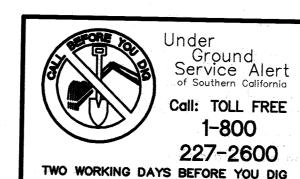

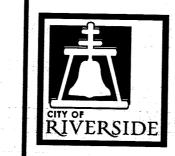

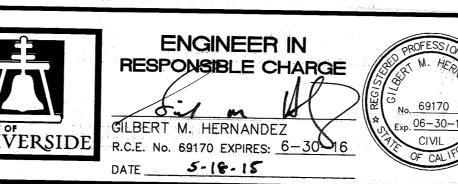

		·		
CAGINEER & F			1	╁╌
				<del>                                     </del>
		W4.2 514N		-
		MEDIAN WIDTH INCREASE, ADD	<del>                                     </del>	-
	A	STRIPING CHANGES DUB TO	l.H	8.22
	MARK	REVISIONS	APPR.	DA
	DESIGN	ED BY MAC DRAWN BY MAC CHECKED B	Y GM	IH

	CITY OF RIVERSIDE, CALIFORNIA DEPARTMENT OF PUBLIC WORKS								
	APPROVED BY	BY	DATE	APPROVED BY					
	ENGINEERING MANAGER	FM	5/21/15	Ches !					
22-14	TRAFFIC DIVISION		17773	CITY ENGINEER					
DATE	CONSTRUCTION ADMIN.	DC	5/27/15						
				DATE 5/22/2015					
		-							

SIGNING AND STRIPING PLAN TYLER STREET FROM WELLS AVENUE TO HOLE AVE SHEET 1 OF 3 SCALE: 1" = 40'FILE NAME: XL731.DWG

XL-731

