



ENCROACHMENT PERMIT
General Permit
 City of Riverside - Public Works Dept.
 951-826-5341

Issuance of this permit shall not be construed as a waiver of any other applicable permit or requirement, and is only revocable permission to use the land for the purpose described.

Owner: FREEMAN EDWIN ROBERT
Location: 3480 UNIVERSITY AV RIVE
A.P.N.: 213-311-001

Encroachment: Fence, Rail, and Door Encroachment. See attached exhibits.

The above-described encroachment being shown on Exhibit A attached hereto.

Upon issuance of this permit, I agree to comply with the attached terms and conditions.

Date: 11/8/12 By: [Signature]
 Date: _____ By: _____

Applicant
 FREEMAN EDWIN ROBERT
 C/O SHIRLEY ANN FREEMAN
 6106 PACHAPPA DR
 RIVERSIDE CA 92506-0000

Contractor/Developer

ENCROACHMENT PERMIT APPROVAL

This permit has been reviewed and approved by the Departments listed below, provided the attached terms and conditions are adhered to:

- P/W ENGINEERING
- P/W TRAFFIC
- P/U WATER
- P/U ELECTRIC
- PLANNING

FINAL APPROVAL

Date: 11/8/12

[Signature]
 City Engineer

THIS PERMIT IS NOT VALID UNTIL ISSUED AND POSTED IN CITY RECORDS

Issued By: Nicole Clark

Dated: 11/8/12




City of Riverside

The following are requirements that need to be met for your permit #PW12-0421 .

- 1: Permittee acknowledges that the area of encroachment is owned or controlled by the City of Riverside.
- 2: Permittee acknowledges that the described property could be needed for a proposed or planned public improvement and the City may revoke this permit. Upon written notice of revocation, the permittee shall, within the time prescribed by the City, remove all improvements placed, constructed or maintained. If the permittee fails to abide by the removal order of the City, the City shall have the right to remove and destroy the improvements without reimbursement to the permittee. The cost of such removal shall be paid by the permittee to the City and shall constitute a debt owed to the City.
- 3: Permittee waives the right of claim, loss, damage or action against the City resulting from revocation, termination, removal of improvements or any action of the City, its officers, agents or employees taken in accordance with the terms herein.
- 4: If the Public Works Director of the City of Riverside finds that the permittee is in default of the terms of this permit, that shall be cause for revocation.
- 5: Permittee herewith agrees to hold the City of Riverside harmless from and against all claims demands, costs, losses, damages, injuries, actions for damages and/or injuries, and liability in connection with the construction, encroachment, and/or maintenance to be done by permittee within the described property.
- 6: Prior to any construction taking place on City controlled property, permittee shall obtain a Construction Permit or Street Opening Permit from the City Public Works Department.
- 7: The permittee agrees to insure that construction of their improvements will not interfere in any way with any existing City or utility facilities.
- 8: Permittee acknowledges that existing city or utility facilities will require future maintenance, reconstruction, and revisions and that facilities may be added, any of which may result in removal or alteration of the permittee's improvements without reimbursement to the permittee.
- 9: Prior to construction, permittee shall contact Underground Service Alert to field locate existing utility lines. Any conflicts discovered will void the permit until acceptable revisions are made. It shall be Permittee's responsibility to determine the location and required clearances from all public and private utility, sewer and drainage facilities prior to drilling and shall only drill in compliance with such clearance requirements.
- 10: 10. Permittee is required to obtain all necessary permits and approvals from all City Departments and/or Agencies, City or otherwise, prior to constructing the improvements specified in this Encroachment Permit and to comply with all codes, laws, ordinances and regulations.
- 11: Permittee is required to obtain all necessary permits and approvals from all City Departments and/or Agencies, City or otherwise, prior to constructing the improvements specified in this Encroachment Permit and to comply with all codes, laws, ordinances and regulations.

E12-0421

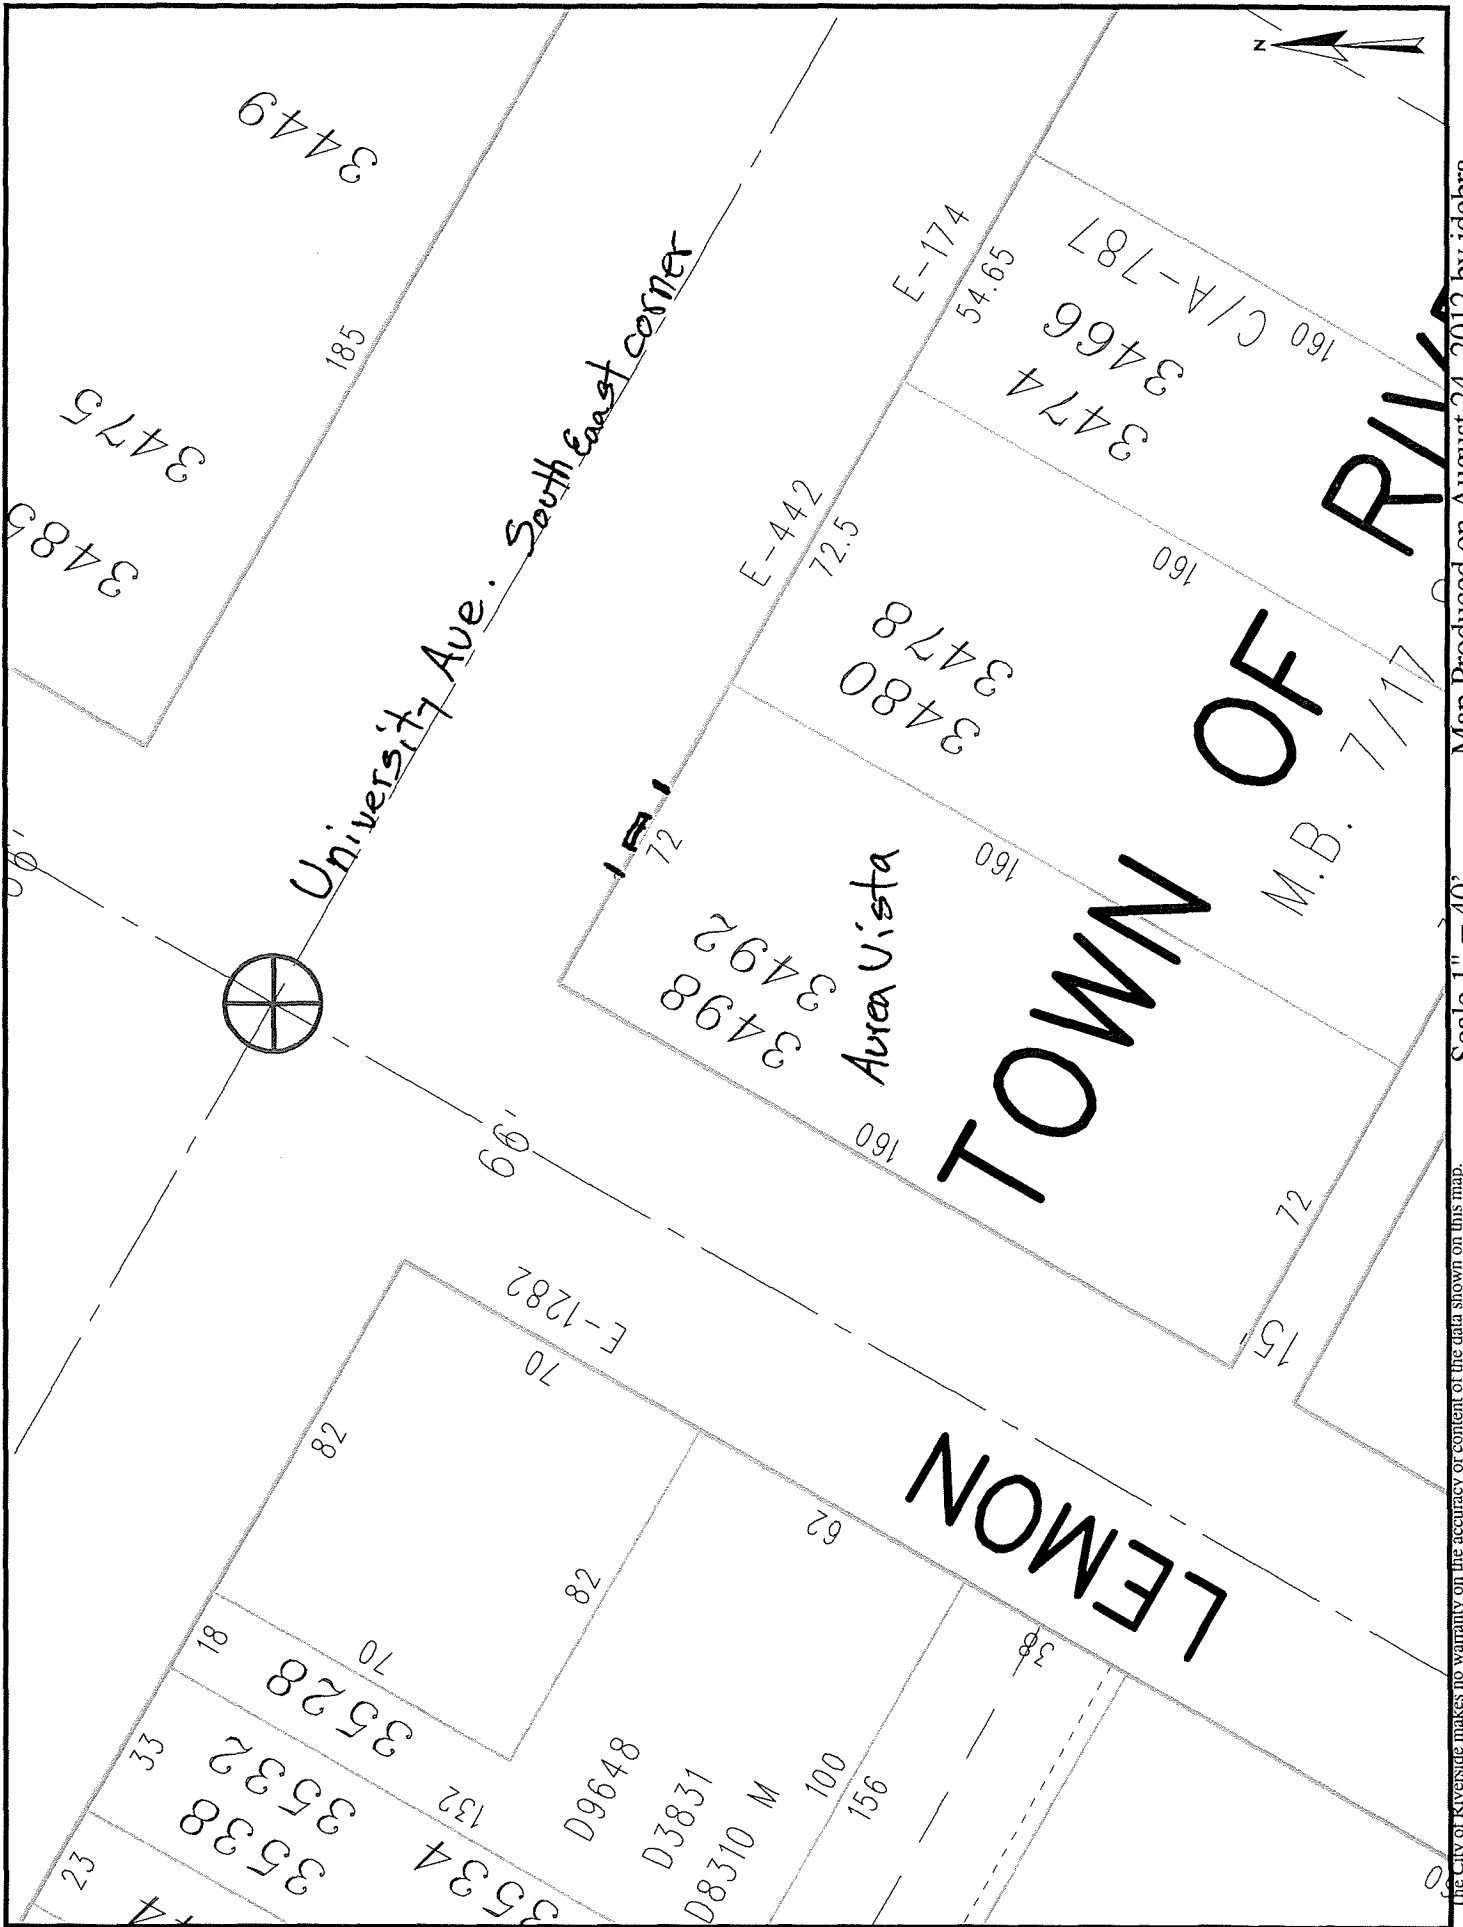


Map Produced on August 24, 2012 by idebra

Scale 1" = 40'

The City of Riverside makes no warranty on the accuracy or content of the data shown on this map. This map shall not be reproduced or distributed. © Copyright 2012, City of Riverside, California

E12-0421

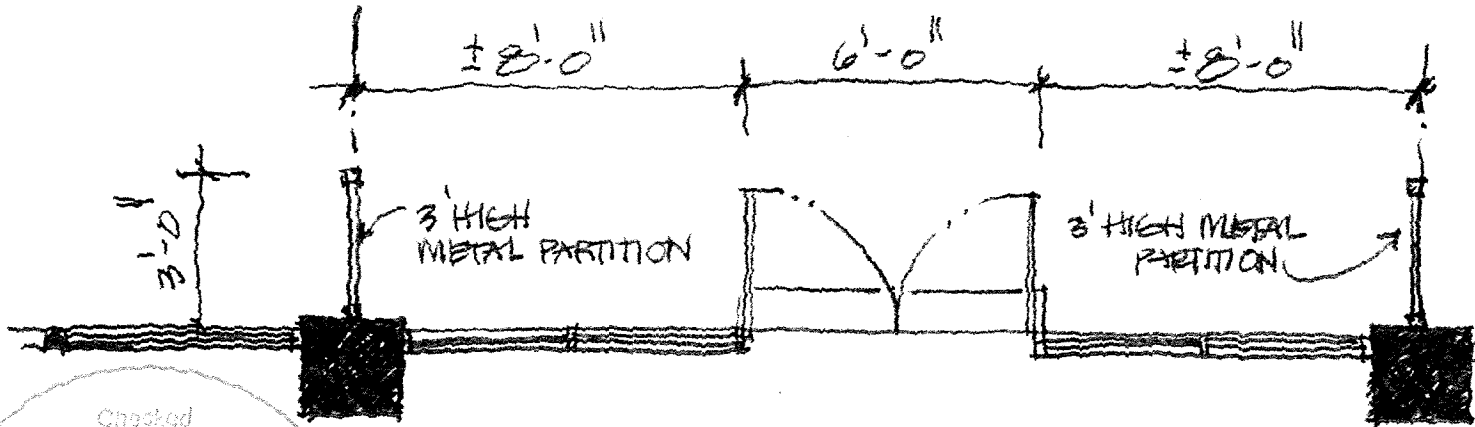

PLAN VIEW $\frac{1}{4}'' = 1'-0''$
 3'-0"


Checked for compliance with RMC Title 19
 APPROVED FOR PERMIT ISSUANCE
 Date 7/19/12 Initial JSM
 City of Riverside Planning Division

Submit to PD Enclosure permit.

$2\frac{1}{2}$ " - 3" METAL FRAME

WIRE MESH - $\frac{1}{2}$ " GRID - MONICKOLS # 688950041

MOUNTED INTO CONCRETE

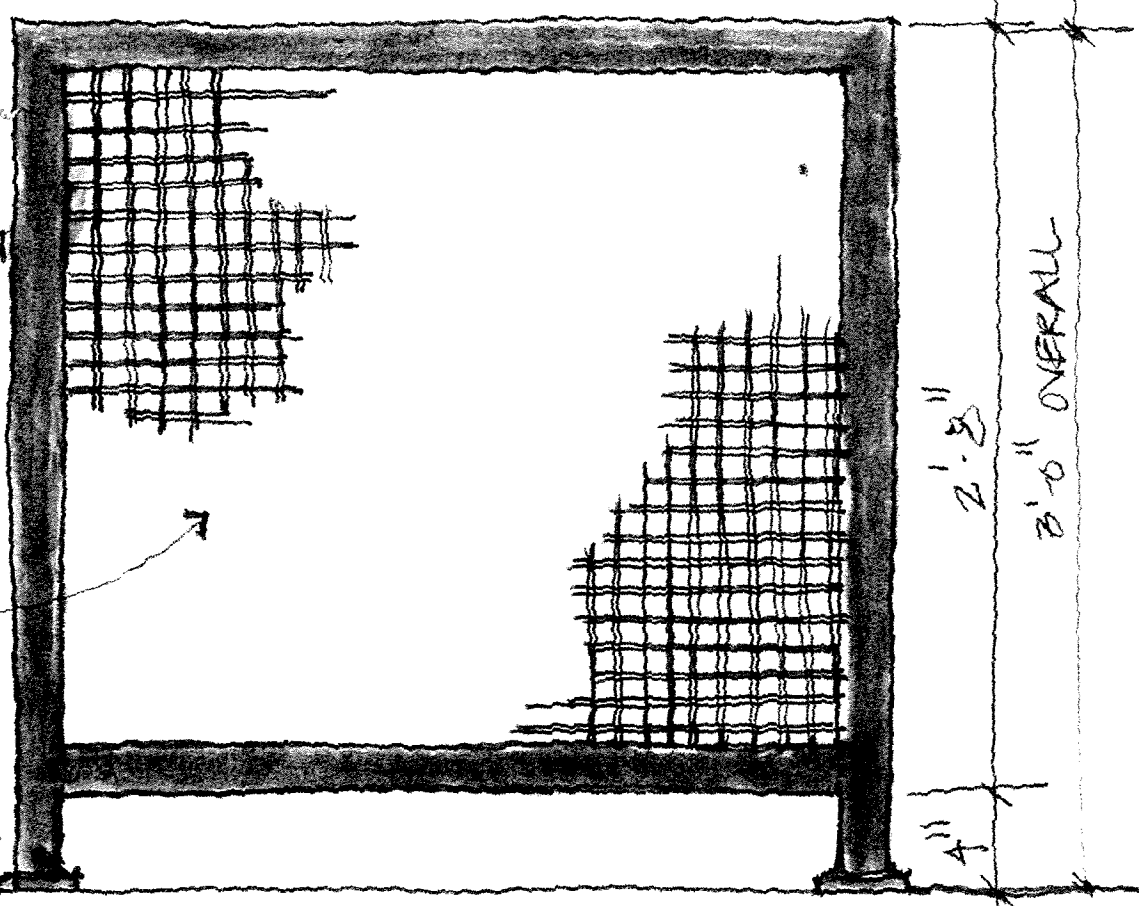

Powder Coated dark Bronze to match storefront,
 ELEVATION $\frac{1}{2}'' = 1'-0''$

3498 University P11-0618

E12-0921

CITY OF RIVERSIDE
PUBLIC WORKS DEPARTMENT
RECEIPT

Original Receipt Date:

11/08/2012

INITIALS: HNC
TYPE: Encroachment

PERMIT NUMBER:PW12-0421

Permit

SITE ADDRESS: 3480 UNIVERSITY AV

RECEIPT #:PWR1200452

TOTAL FEES: \$660.00
TOTAL ALL PAYMENTS: \$660.00
BALANCE: \$0.00

TRANS DATE: 11/08/2012 THIS PAYMENT: 660.00

TRANS LIST:

.00 Type	Method	Description	Amount
Payment	Check	3895	660.00
			TOTAL: 660.00

ACCT LIST:

Item No.	Description	Account Code	Current Pmts
16102	PW-Encroachment Permit	001014134034035100	600.00
16104	PW-Encroach Surcharge	001012787034031900	60.00
			TOTAL: 660.00

THE FREEMAN COMPANY

**Trust Account code: 0000720224200

E12-0421