

**APPLICATION FOR ENCROACHMENT PERMIT**  
(to be completed by applicant)

SCRRA, the x Owner Lessee of the property located at SCRRA Right-of-Way in the City of Riverside, Assessors Parcel No. \_\_\_\_\_ hereby requests permission to perform several drainage improvements along SCRRA right-of-way between Cridge Street and 10th Street. Also included are drainage improvements within the Riverside Station. (2 connections)

in the public right of way of the City of Riverside /or the \_\_\_\_\_ easement at the rear/ side/ front of said property. The attached drawing shows the requested encroachment. Upon issuance of this permit, I agree to comply with the attached terms and conditions.

Date 1-27-93

Ron Martin  
MGR. PUBLIC PROJECTS (SCRRA)

.....  
**ENCROACHMENT PERMIT APPROVAL**  
(to be completed by City)

This permit shall become effective upon the approval of the Departments listed below. Issuance of this permit shall not be construed as a waiver of any other applicable permit or requirement, but is only revocable permission to use the land for the purpose described.

- N/A Public Utilities Water \_\_\_\_\_
- N/A Public Utilities Electric \_\_\_\_\_
- N/A Planning \_\_\_\_\_
- N/A Parks and Recreation \_\_\_\_\_
- \_\_\_\_\_ (other) \_\_\_\_\_
- \_\_\_\_\_ (other) \_\_\_\_\_

Upon obtaining the above signatures, return this permit to the Public Works Department for final approval.

Date 3/29/93

Bing Paul  
Public Works Director

Encroachment Permit No. E-1235


### TERMS AND CONDITIONS

The following indicated terms and conditions apply to encroachment permit no. E-1235.

1. Permittee acknowledges that the area of encroachment is owned or controlled by the City of Riverside.
2. Permittee acknowledges that the described property could be needed for a proposed or planned public improvement and the City may revoke this permit. Upon written notice of revocation, the permittee shall, within the time prescribed by the City, remove all improvements placed, constructed or maintained. If the permittee fails to abide by the removal order of the City, the City shall have the right to remove and destroy the improvements without reimbursement to the permittee. The cost of such removal shall be paid by the permittee to the City and shall constitute a debt owed to the City.
3. Permittee waives the right of claim, loss, damage or action against the City resulting from revocation, termination, removal of improvements or any action of the City, its officers, agents or employees taken in accordance with the terms herein.
4. If the City Council of the City of Riverside finds that the permittee is in default of the terms of this permit, that shall be cause for revocation.
5. Permittee herewith agrees to hold the City of Riverside harmless from and against all claims demands, costs, losses, damages, injuries, actions for damages and/or injuries, and liability in connection with the construction, encroachment, and/or maintenance to be done by permittee within the described property.
6. Prior to any construction taking place on City controlled property, permittee shall obtain a Construction Permit or Street Opening Permit from the City Public Works Department.
7. The permittee agrees to insure that construction of their improvements will not interfere in any way with existing City or utility facilities. The existing facilities will require future maintenance, reconstruction and revisions and facilities may be added, any of which may result in removal or alteration of the permittee's improvements without

reimbursement to the permittee. Prior to construction, Permittee shall contact Underground Service Alert to field locate existing utility lines. Any conflicts discovered will void the permit until acceptable revisions are made.

8. Other \_\_\_\_\_  
\_\_\_\_\_  
\_\_\_\_\_  
\_\_\_\_\_

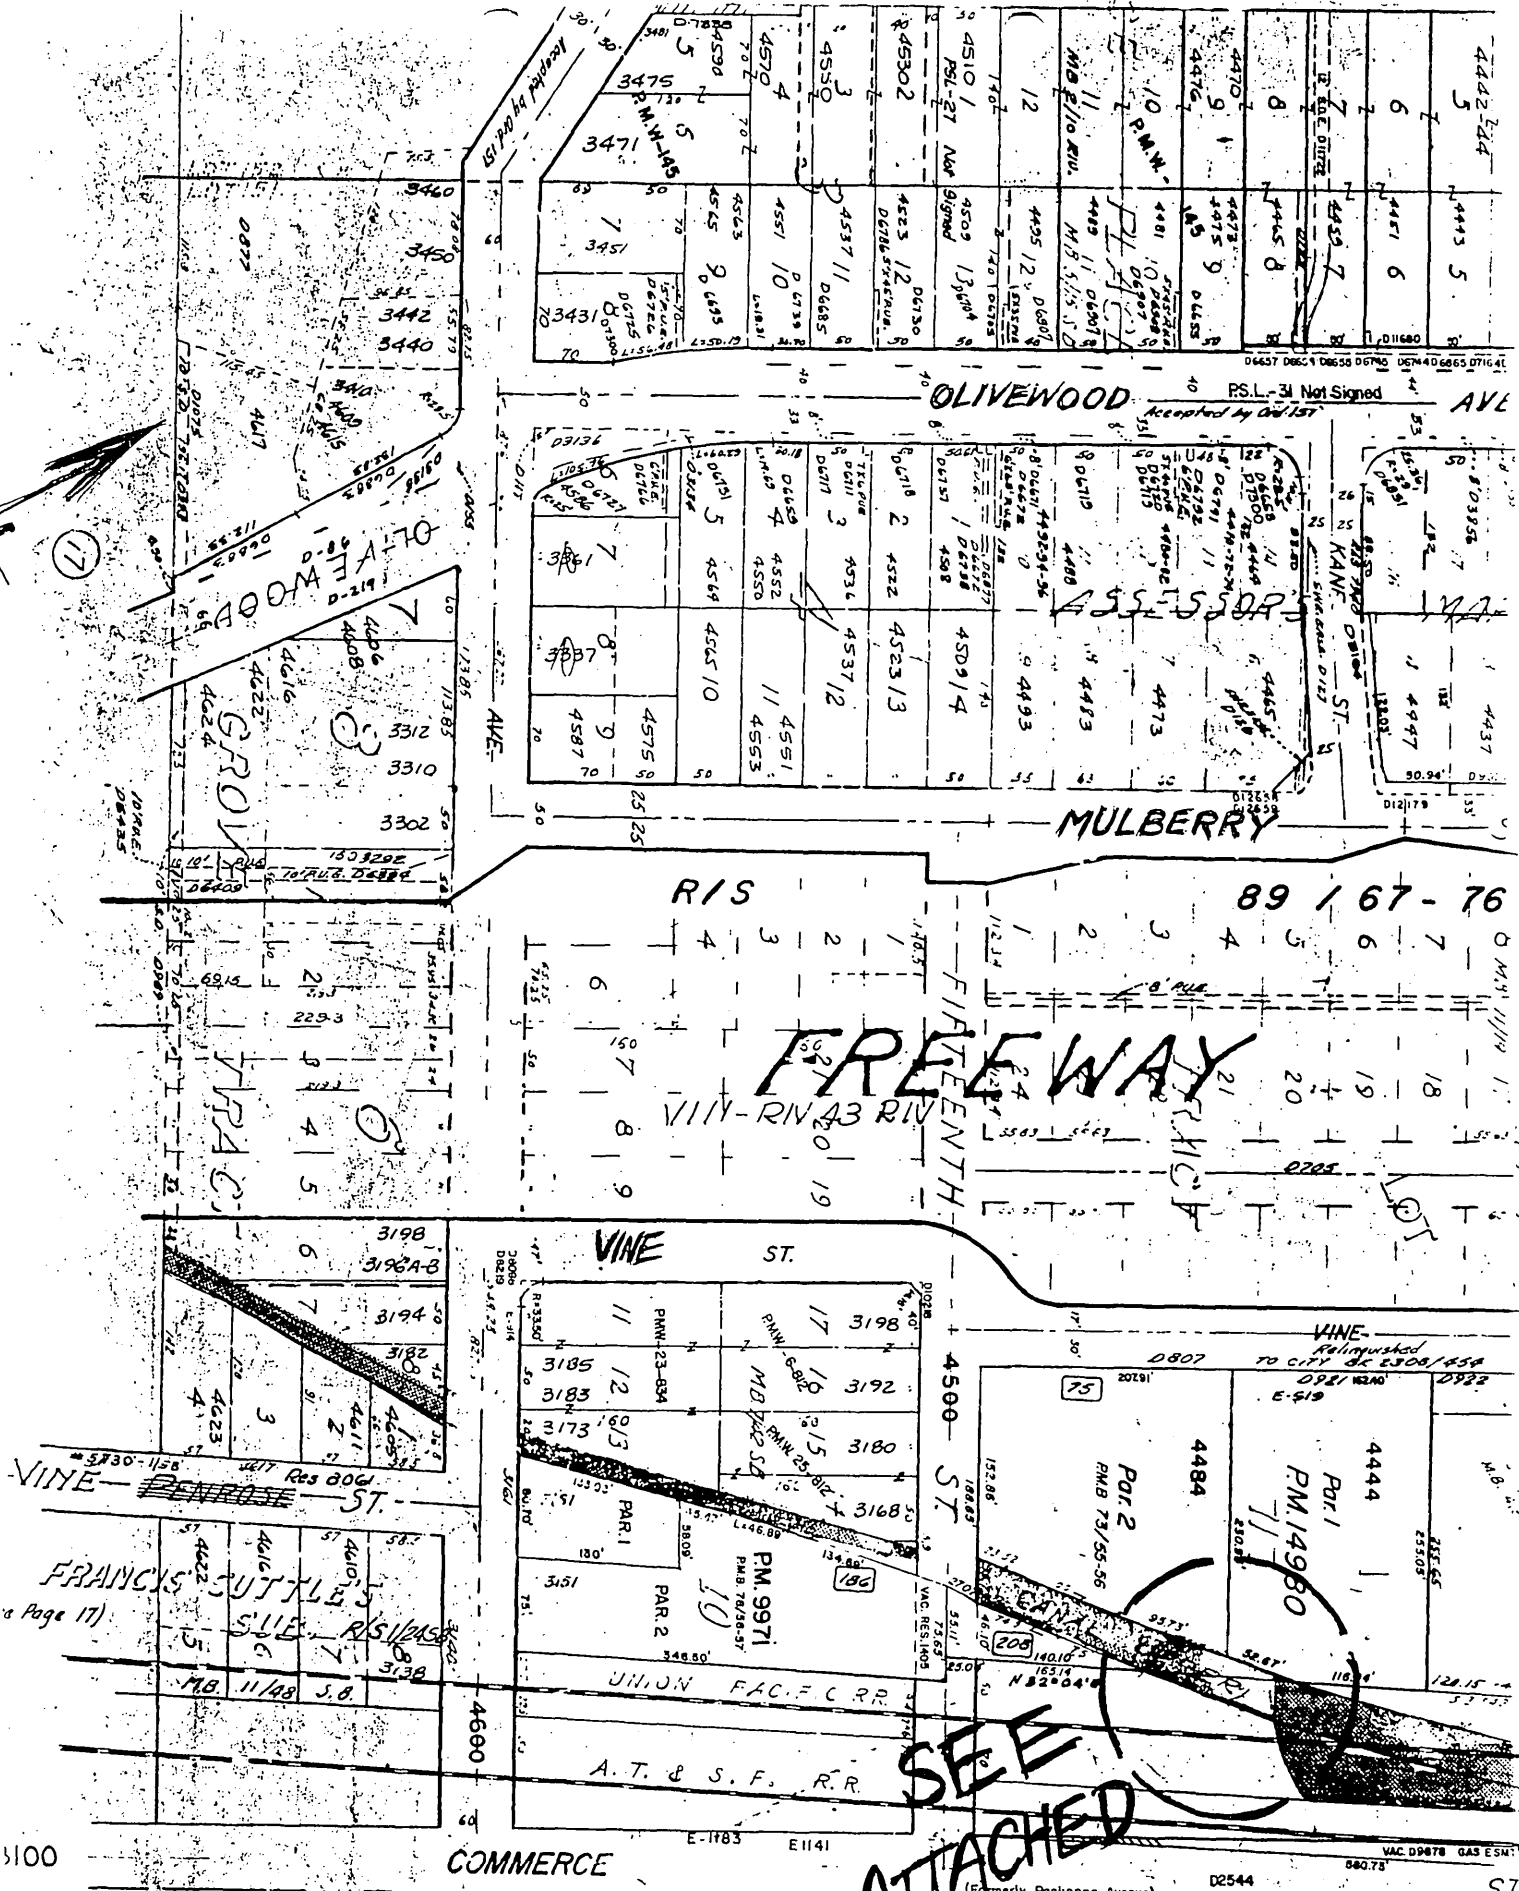

**SEE ATTACHED**

CB 2/12

5100

Page 17)

FRANCIS JUTTLE'S SUE RIS/VAH 3.38 MB 11/48 J.O.

VINE ST. Res 800

3198 3194 3185 3183 3173 4623 4622 4616 4611 4605 4600

3320 3312 3310 3302 229-3 2 3 4 5 6 7

3460 3450 3442 3440 3431 3425 3417 3406 3408 4622 4624 4624

89 / 67 - 76  
 0 1 2 3 4 5 6 7 8 9  
 10 11 12 13 14 15 16 17 18 19 20 21  
 22 23 24 100


4442 4444 4445 4446 5000




SOUTHERN CALIFORNIA REGIONAL RAIL AUTHORITY  
Engineering Department

FILE.....  
SHE.....OF.....  
DATE.....  
DESIGNED BY.....  
CHECKED BY.....

CONNECTION NO. 1 - 15" RCP TO EXISTING 24" RCP  
10' EAST OF RIVERSIDE CANAL 290' NO. OF 15<sup>TH</sup> ST.

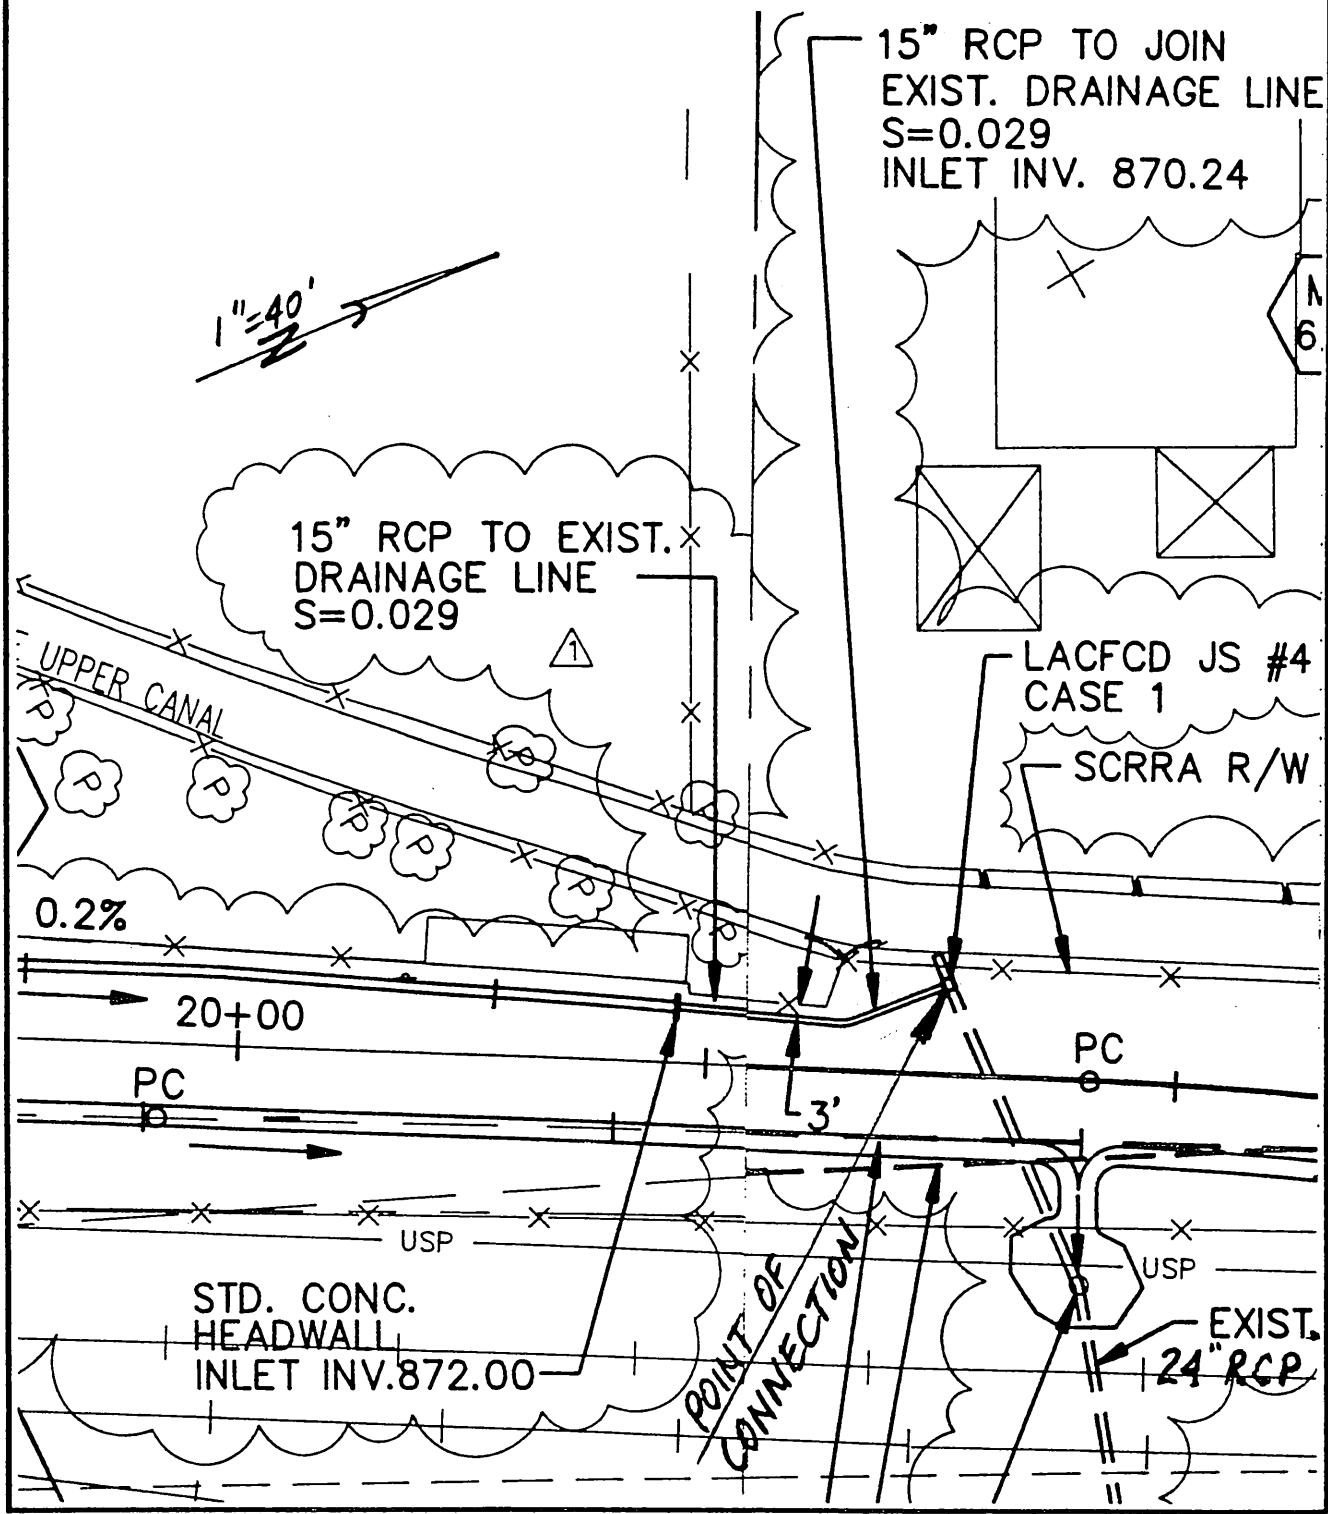

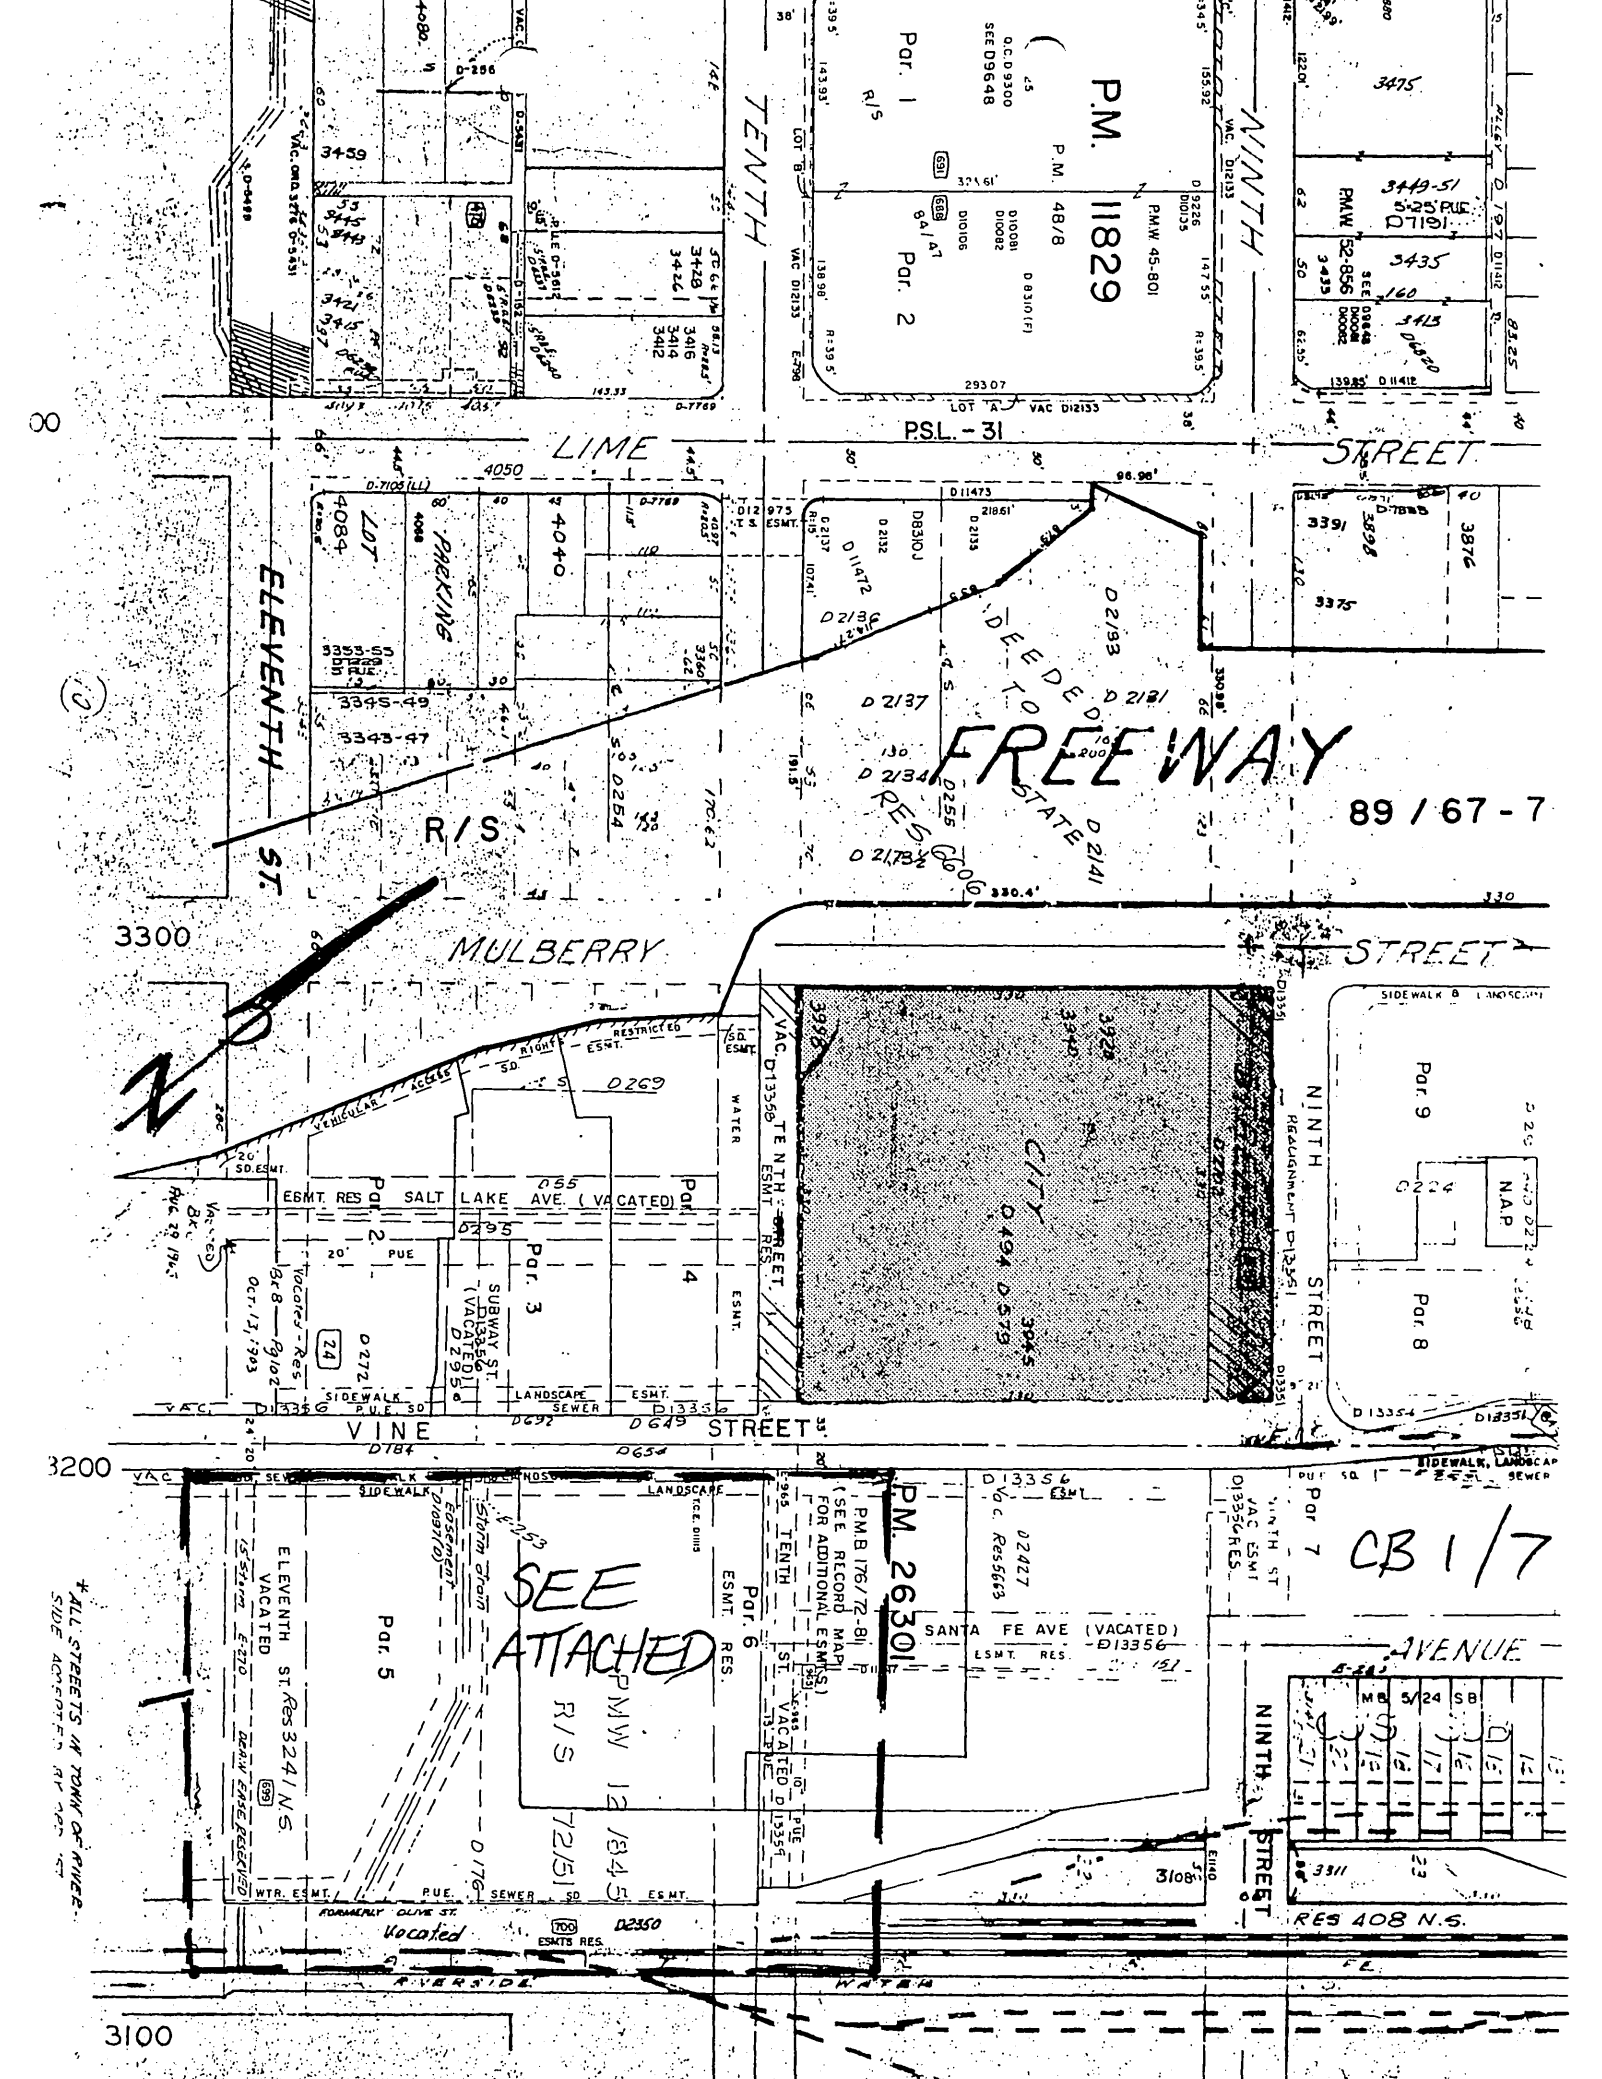

P.M. 11829

PAR. 1  
R/S

PAR. 2  
R/S

3475  
3449-51  
5-25 PUE  
D 1191  
3435  
3415  
3412  
3398  
3376  
3375

DEEDED TO STATE  
FREEWAY

89 / 67 - 7

RES 0000  
D 2137  
D 2134  
D 2132  
D 2131  
D 2130  
D 2129  
D 2128

PM 26301

SEE ATTACHED

PMW 12 / 845  
R/S 72 / 51

CB 1 / 7

13	12	11	10	9	8	7	6	5	4	3	2	1
13	12	11	10	9	8	7	6	5	4	3	2	1
\* ALL STREETS IN TOWN OF NINE  
SIDE ACRES BY 100' W

3100

CONNECTION #2

SCRRRA R/W

SANTA FE AVENUE

10TH ST.

STA 14+95.45 END TRACK "C"  
INST. BUMPING POST  
END OF CONTRACT

STA 41+66.74 END MAIN TRACK  
INST. BUMPING POST  
END OF CONTRACT

8" UNDERDRAIN  
(ITEM NO. 02600.4)

SCRRRA R/W

8" UNDERDRAIN CLOS/DROP OUTLETS  
TO JS #4, CASE 3 PER RIVERSIDE  
CITY STD. DWG. 405-00  
(TYP.)

40+80.67 END PLATFORM

PROPOSED EASEMENT

12"W & 42" SD LINES  
PROTECT IN PLACE

CONSTRUCT 12"W  
PER SHT. No 041

CONSTRUCT MH-AX  
PER RIVERSIDE CITY  
STD. DWG. NO. 430

122.95'

N29°48'18"E

36" SD LINE  
TO BE REMOVED  
BY OTHERS

CONSTRUCT 36" RCP  
PER SHT. No. 041

CONSTRUCT 36" RCP  
PER SHT. No. 041

E 5.25'

10+00

26.00'

TC

5.25'

15" RCP  
1500-D  
@ IS=0.02

8" UNDERDRAIN  
CLEANOUT  
(ITEM NO. 02600.4)

PROTECT EXIST.  
48" AND 42" RCP

36" RCP AND  
12"W LINES  
TO BE RELOCATED  
PER SHT. No. 041

PROPOSED TOP OF RAIL

NO. 041  
SHEET NO. 2

3

5

6

7


98

99

100




CONNECTION NO. 1 - 15" RCP TO EXISTING 24" RCP  
10' EAST OF RIVERSIDE CANAL 290' NO. OF 15<sup>TH</sup> ST.

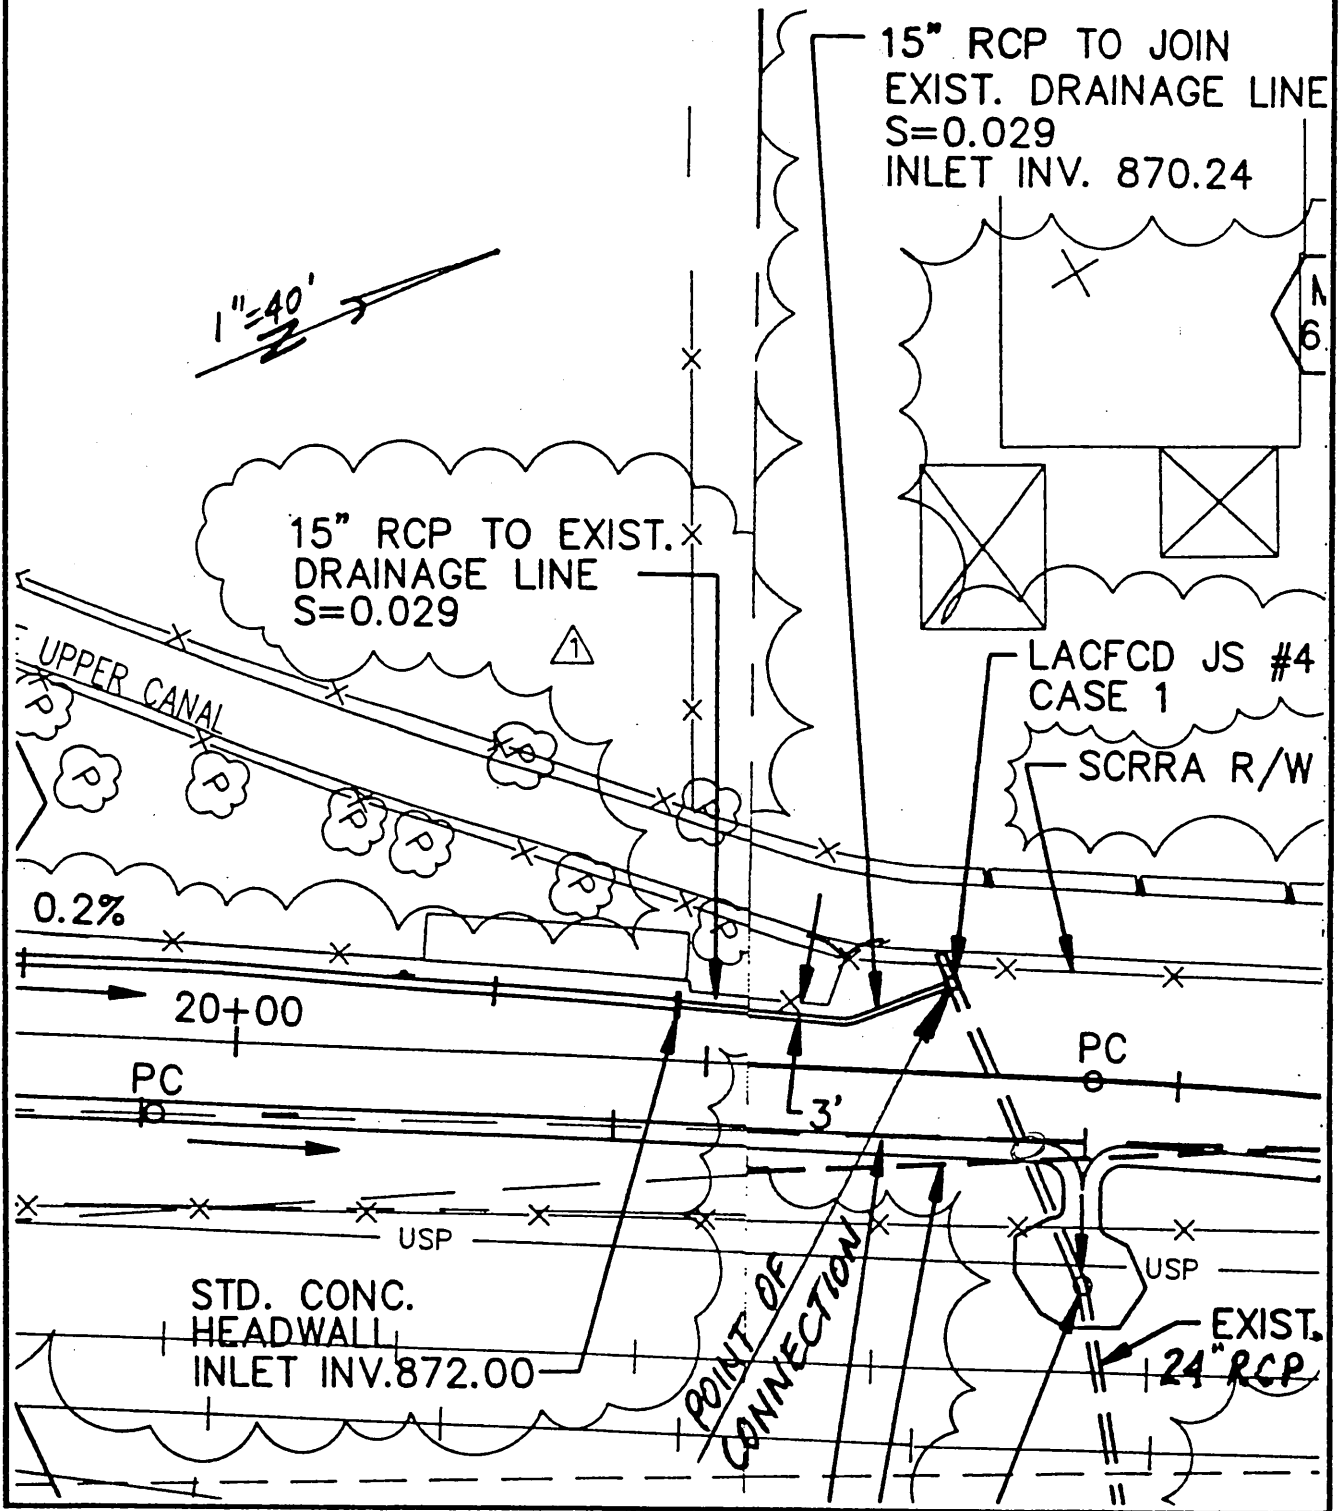






# CONNECTION NO. 1 - 15" RCP TO EXISTING 24" RCP 10' EAST OF RIVERSIDE CANAL 290' NO. OF 15<sup>TH</sup> ST.

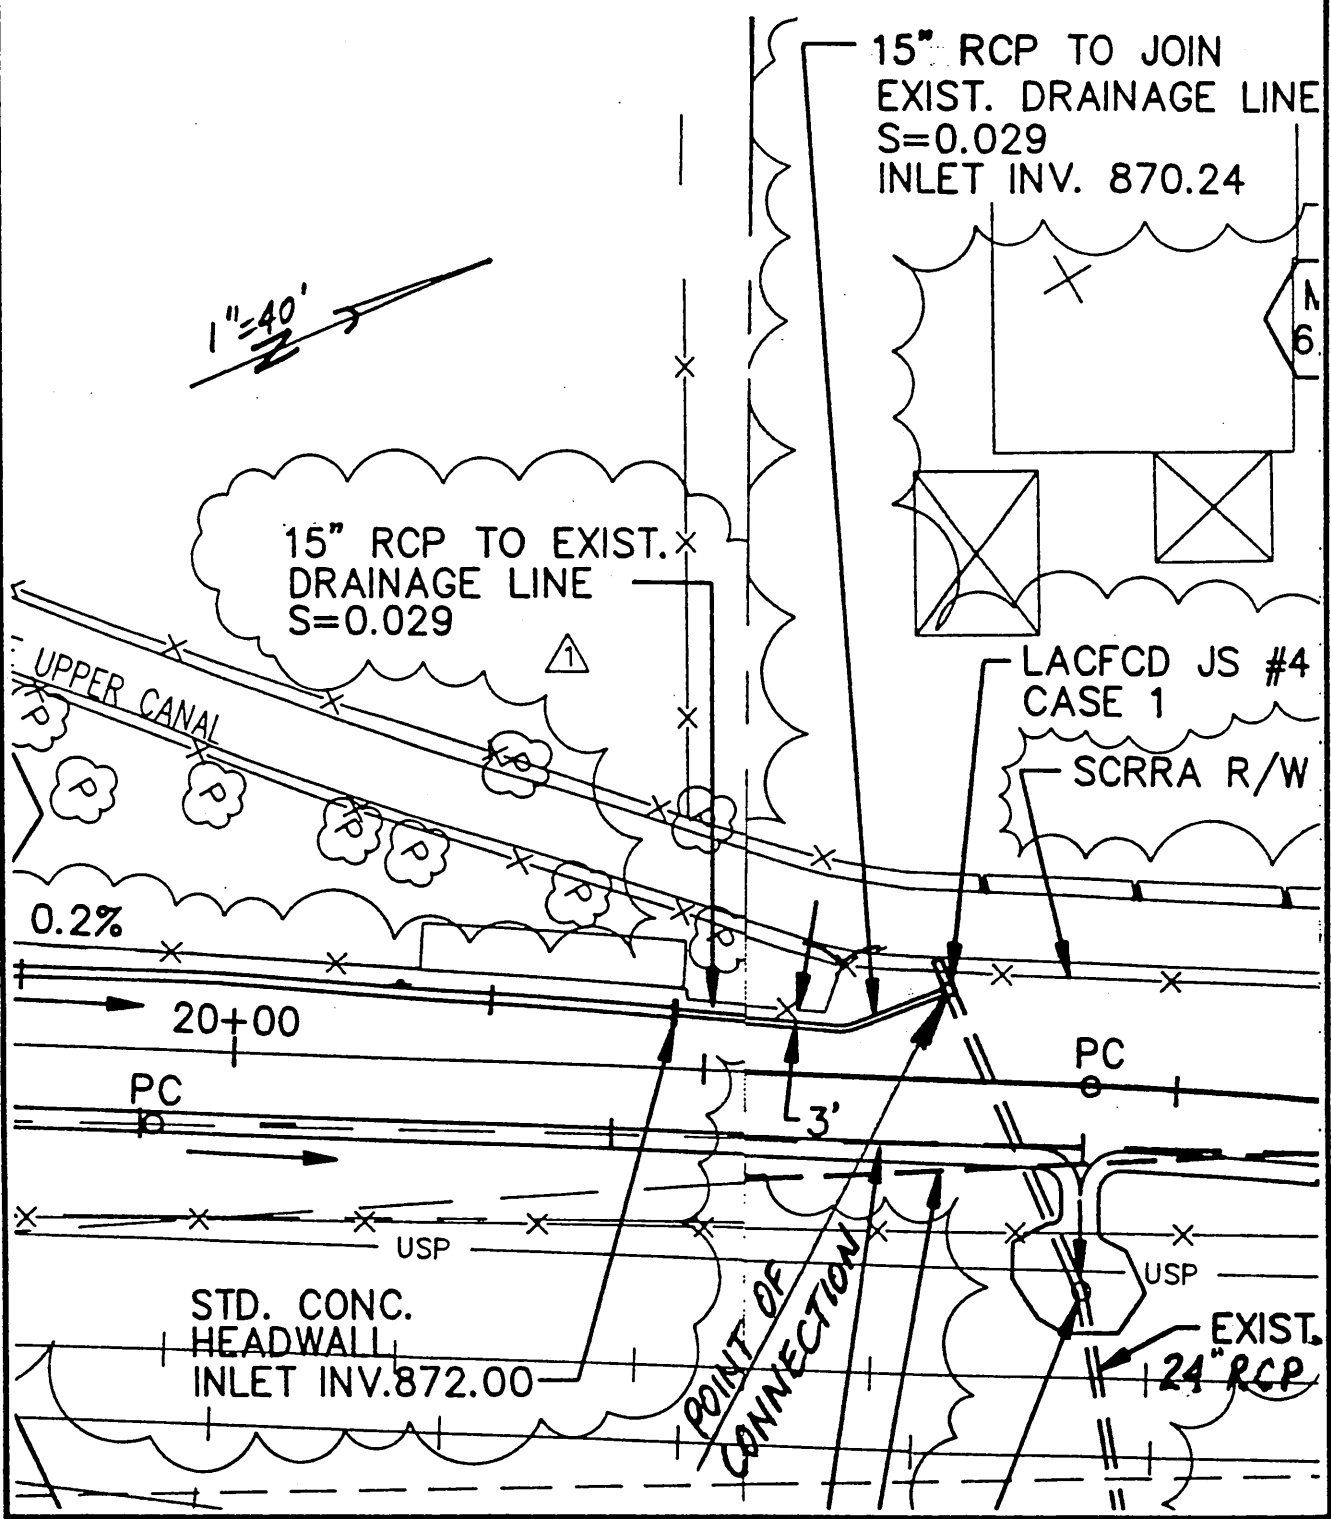

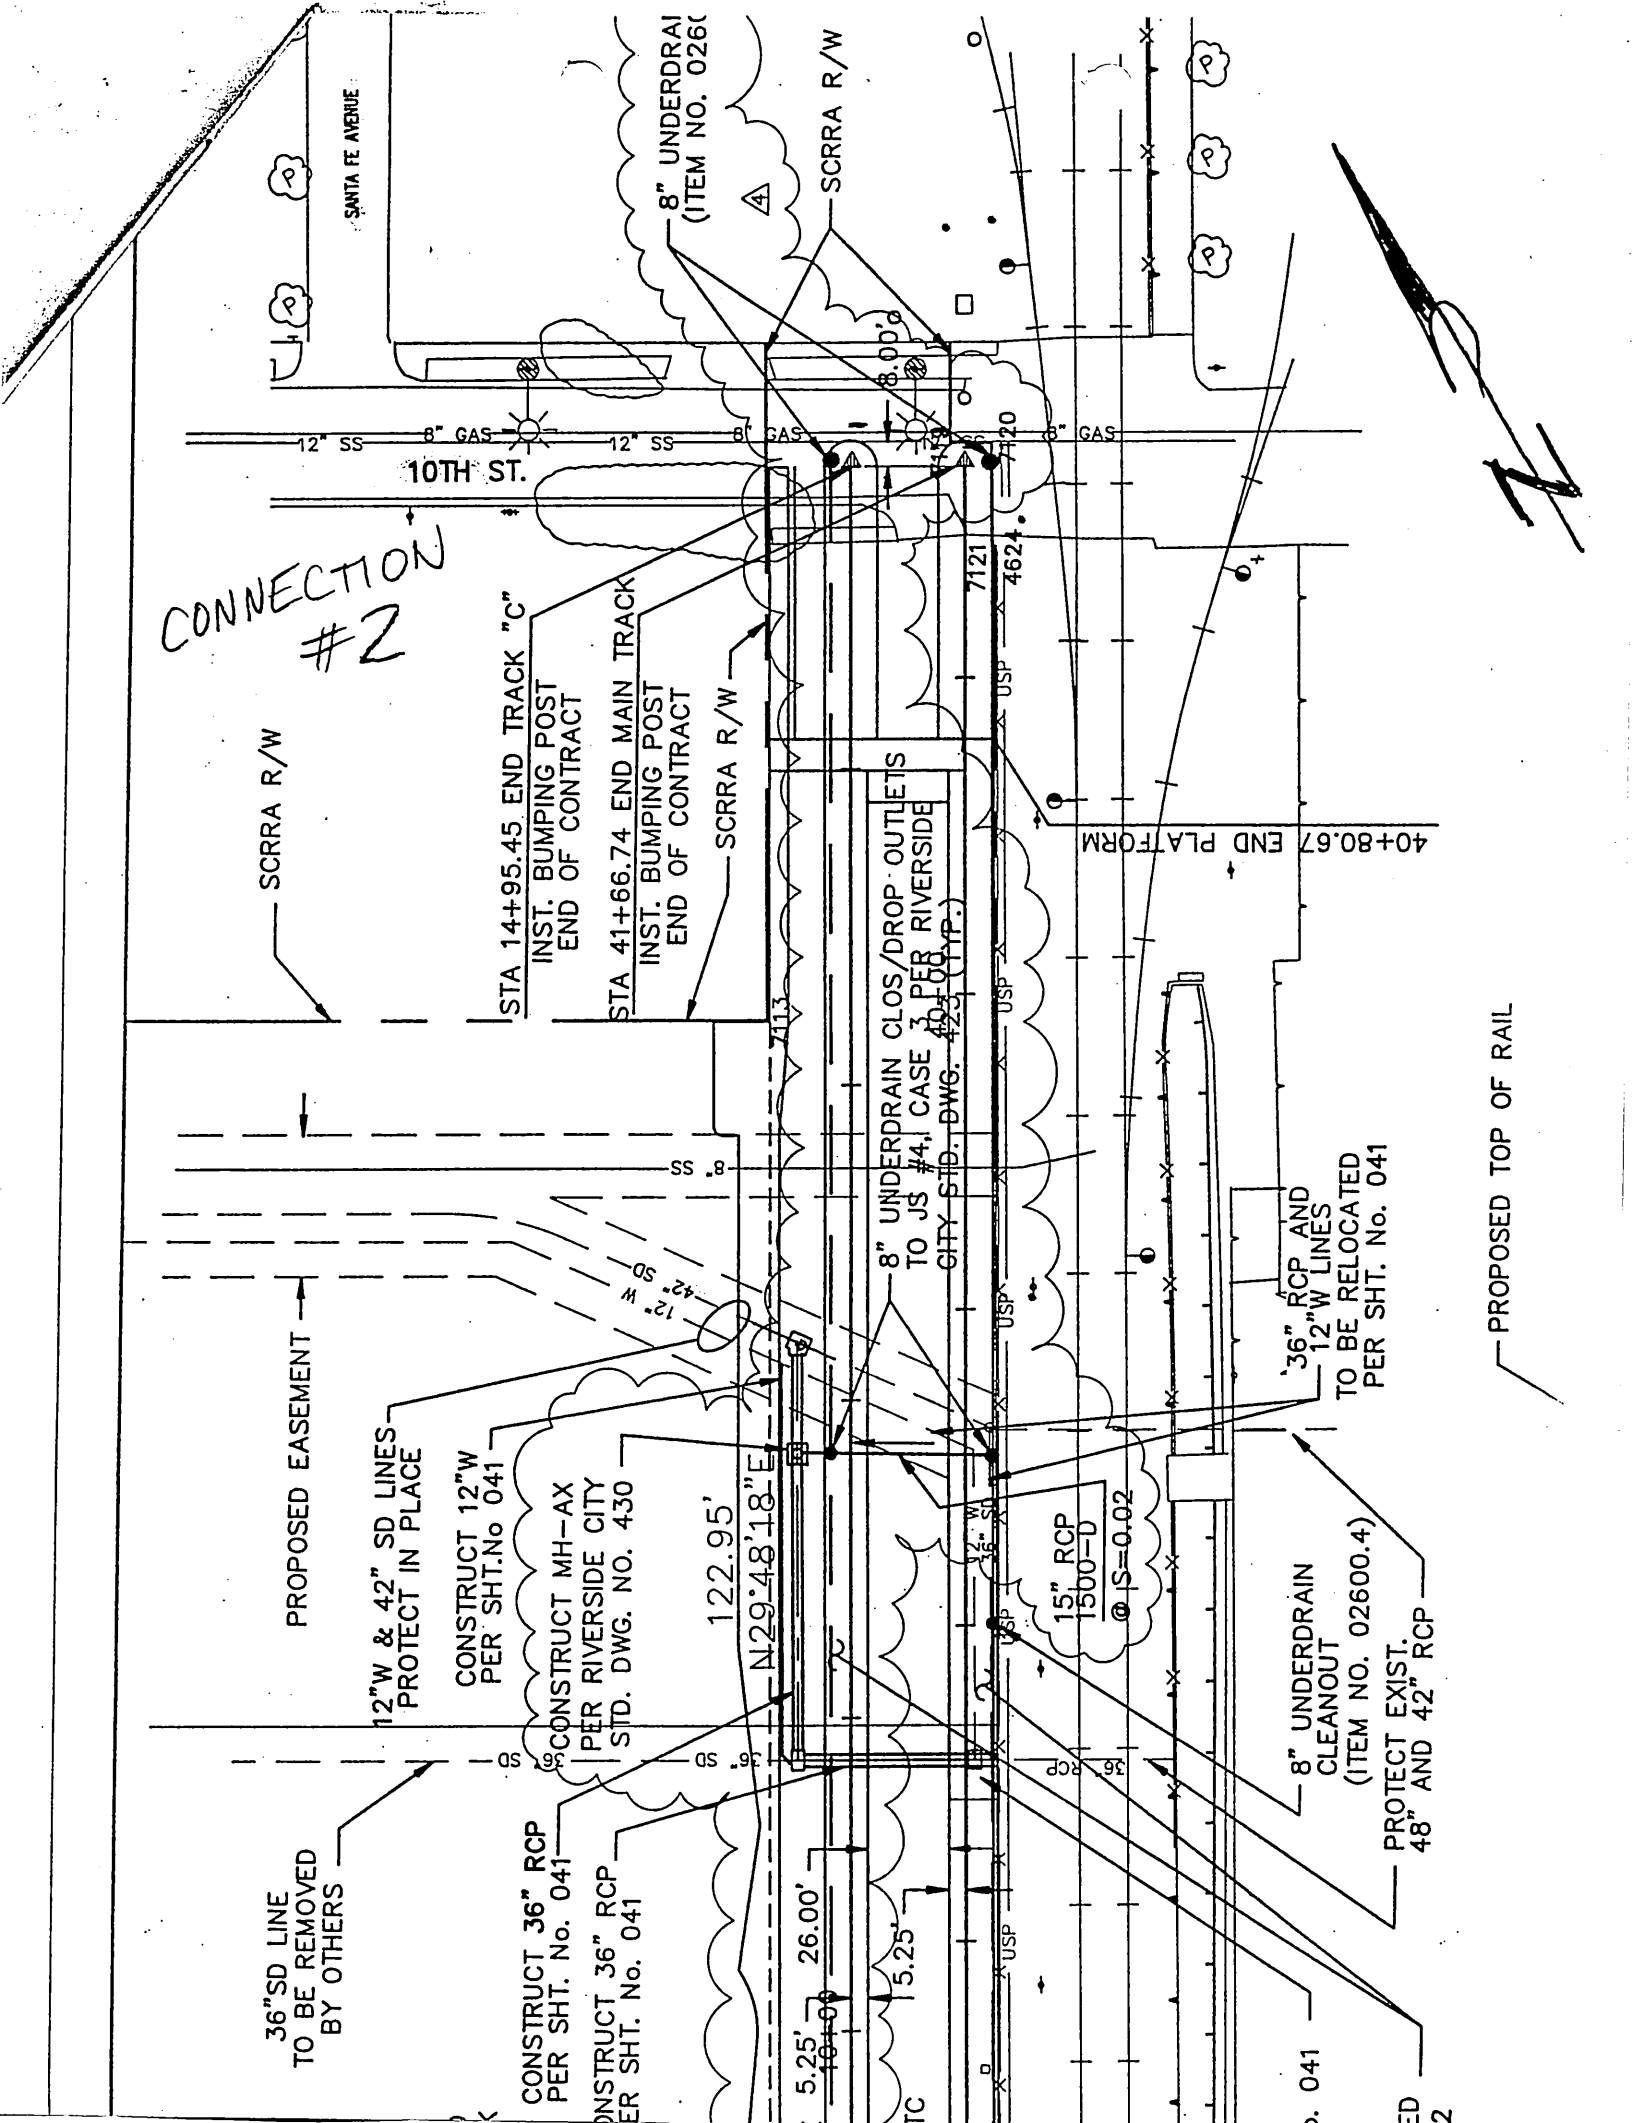

CONNECTION #2

SCRRRA R/W

STA 14+95.45 END TRACK "C"  
INST. BUMPING POST  
END OF CONTRACT

STA 41+66.74 END MAIN TRACK  
INST. BUMPING POST  
END OF CONTRACT

SCRRRA R/W

8" UNDERDRAIN CLOS/DROP OUTLETS  
TO JS #4, CASE 3 PER RIVERSIDE  
CITY STD. DWG. 423 (TYP.)

40+80.67 END PLATFORM

PROPOSED EASEMENT

12"W & 42" SD LINES  
PROTECT IN PLACE

CONSTRUCT 12"W  
PER SHT. No 041

CONSTRUCT MH-AX  
PER RIVERSIDE CITY  
STD. DWG. NO. 430

122.95'

N29°48'18"E

8" UNDERDRAIN  
CLEANOUT  
(ITEM NO. 02600.4)  
PROTECT EXIST.  
48" AND 42" RCP

15" RCP  
1500-D  
@ IS=0.02

36" RCP AND  
12"W LINES  
TO BE RELOCATED  
PER SHT. No. 041

8" UNDERDRAIN  
CLEANOUT  
(ITEM NO. 02600.4)  
PROTECT EXIST.  
48" AND 42" RCP

36" SD LINE  
TO BE REMOVED  
BY OTHERS

CONSTRUCT 36" RCP  
PER SHT. No. 041

CONSTRUCT 36" RCP  
PER SHT. No. 041

5.25'


26.00'

5.25'

SHT. No. 041

ED 2

PROPOSED TOP OF RAIL

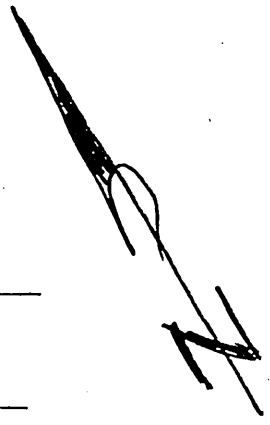

SANTA FE AVENUE

10TH ST.

8" UNDERDRAIN  
(ITEM NO. 02600.4)

SCRRRA R/W

12" SS 8" GAS 12" SS 8" GAS 12" SS 8" GAS

7120

7121

4624

USP

USP


USP

USP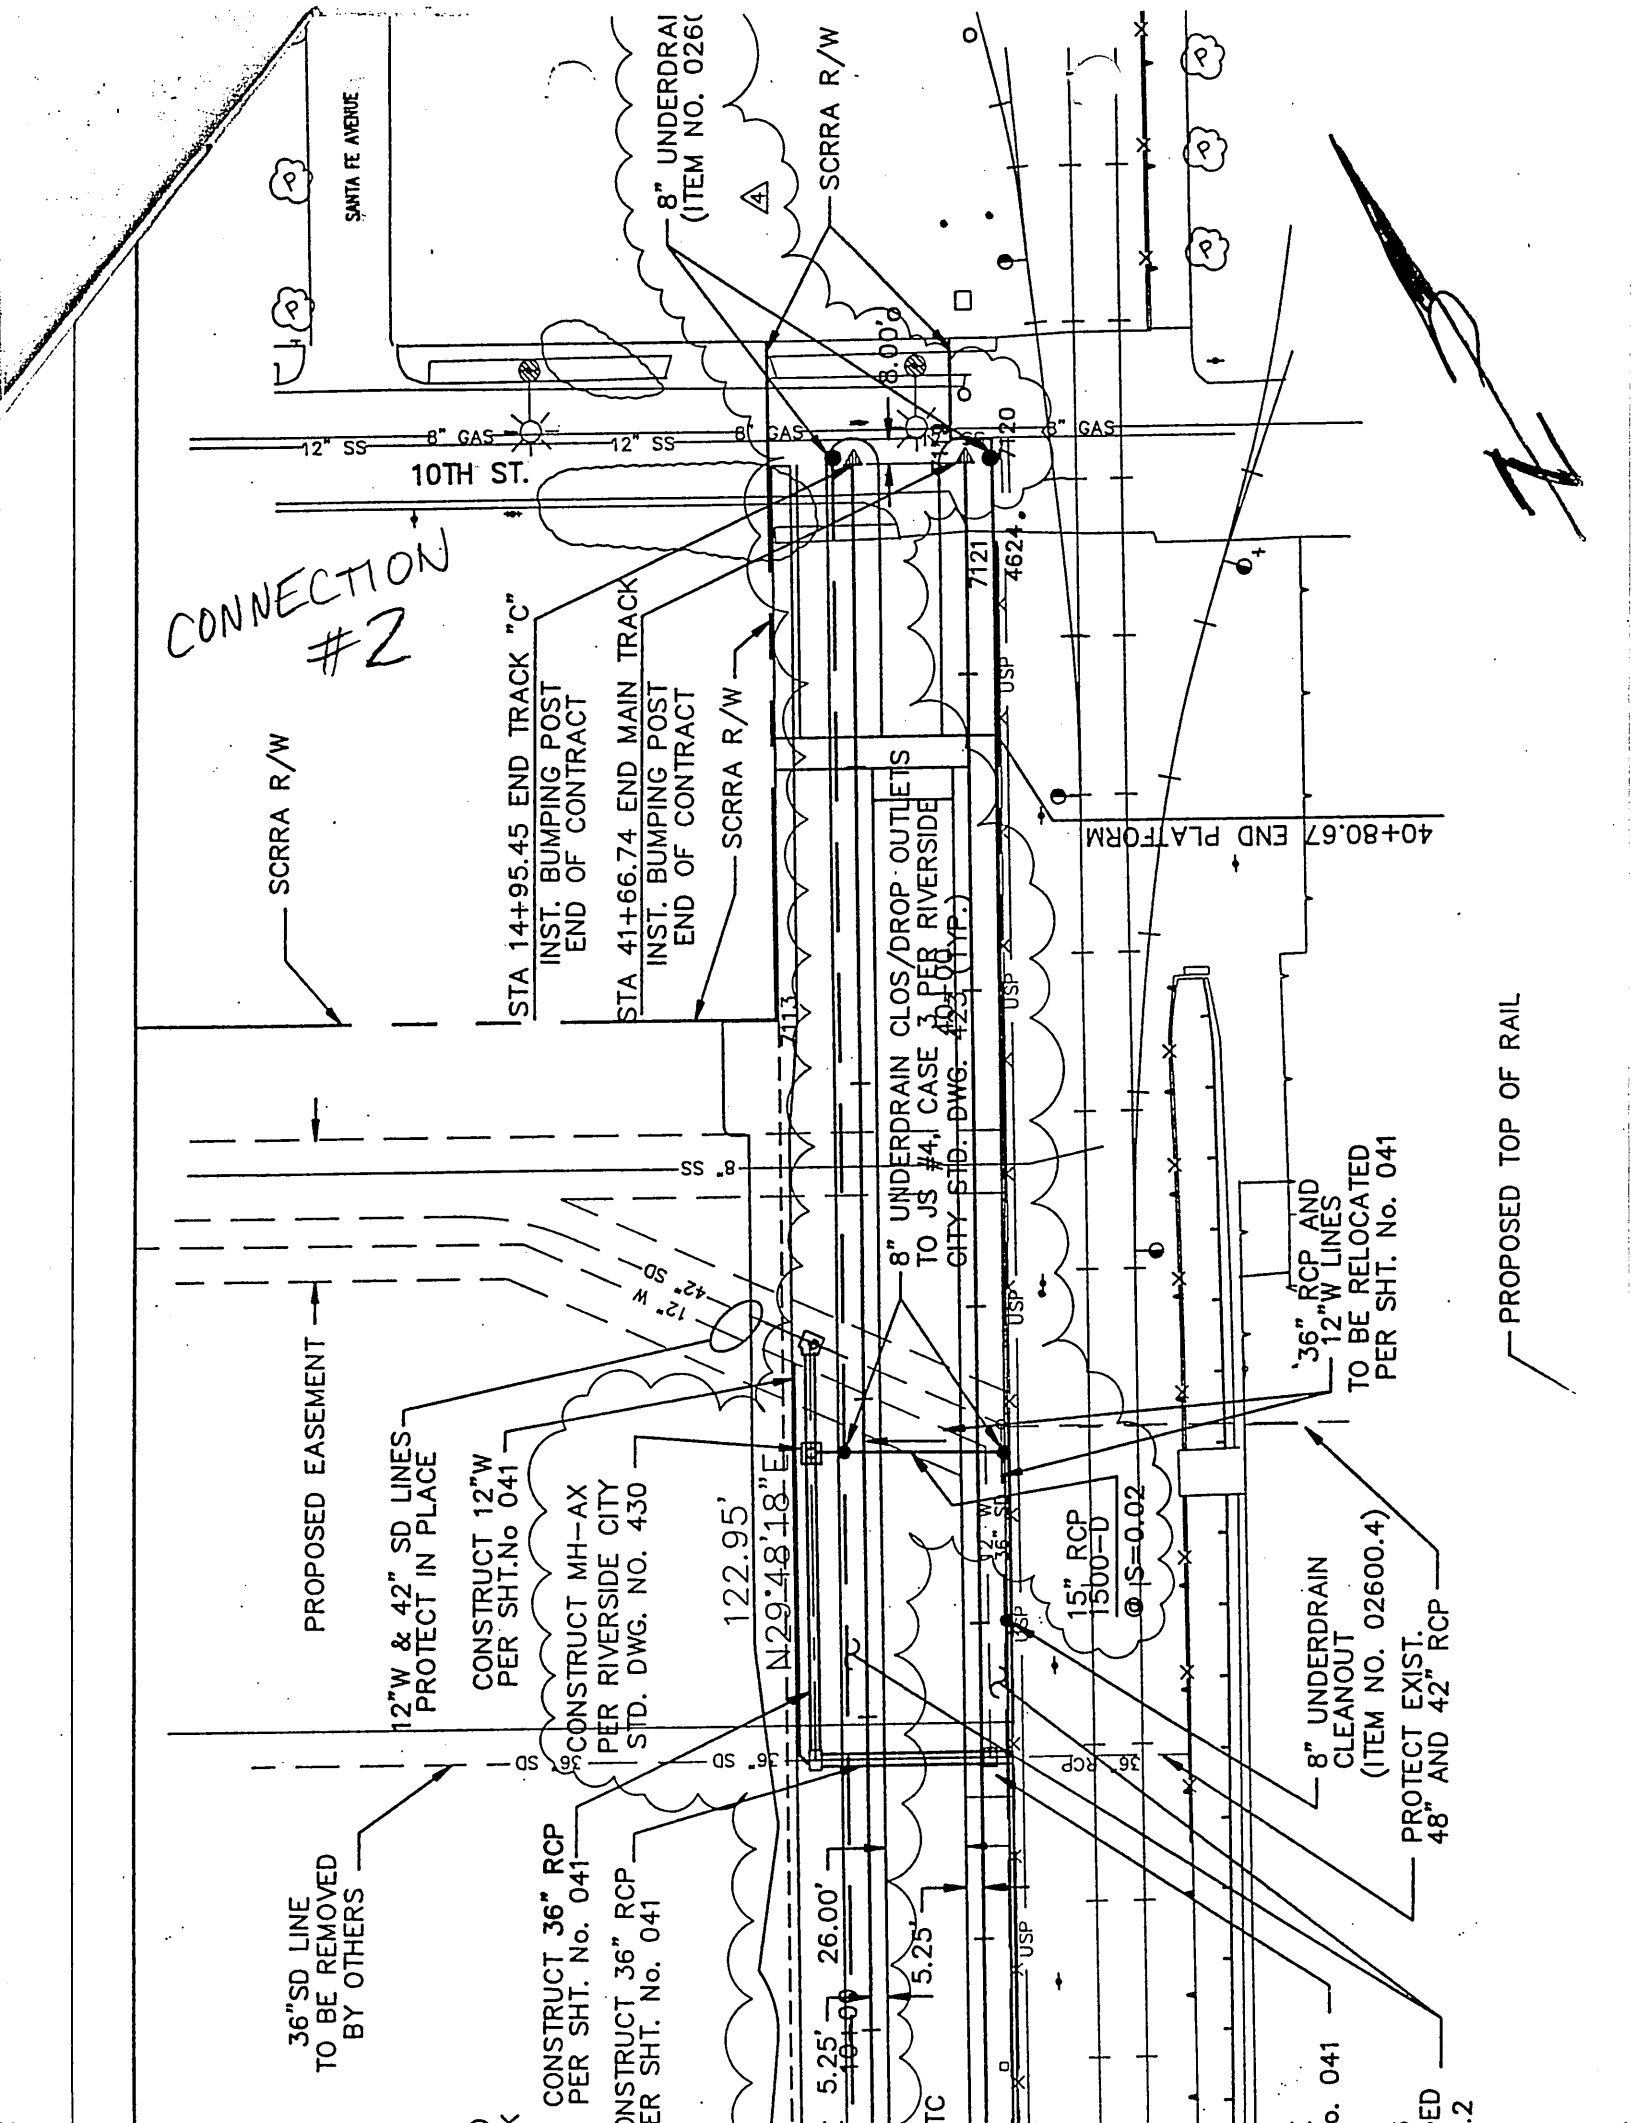

CONNECTION #2

SCRRRA R/W

STA 14+95.45 END TRACK "C"  
INST. BUMPING POST  
END OF CONTRACT

STA 41+66.74 END MAIN TRACK  
INST. BUMPING POST  
END OF CONTRACT

SCRRRA R/W

8" UNDERDRAIN CLOS/DROP-OUTLETS  
TO JS #4, CASE 3 PER RIVERSIDE  
CITY STD. DWG. 423 (L.T.P.)

40+80.67 END PLATFORM

PROPOSED EASEMENT

12"W & 42" SD LINES  
PROTECT IN PLACE

CONSTRUCT 12"W  
PER SHT. No 041

CONSTRUCT MH-AX  
PER RIVERSIDE CITY  
STD. DWG. NO. 430

122.95'

N 29° 48' 18" E

36" SD LINE  
TO BE REMOVED  
BY OTHERS

CONSTRUCT 36" RCP  
PER SHT. No. 041

CONSTRUCT 36" RCP  
PER SHT. No. 041

5.25'

26.00'

5.25'

15" RCP  
1500-D  
@ S=0.02

36" RCP AND  
12"W LINES  
TO BE RELOCATED  
PER SHT. No. 041

8" UNDERDRAIN  
CLEANOUT  
(ITEM NO. 02600.4)

PROTECT EXIST.  
48" AND 42" RCP

PROPOSED TOP OF RAIL

No. 041

ED  
2