

ENCROACHMENT PERMIT
(to be completed by applicant)

PACIFIC BELL MOBILE SERVICES, a California corporation, "Permittee," hereby requests permission to construct and maintain wireless communications facilities and conduct soil borings for preliminary geotechnical foundation investigations at **one location** encroaching in the public right-of-way as shown on the attached drawings. Upon issuance of this permit, Permittee agrees to comply with the attached terms and conditions.

Dated 8/27/96

PACIFIC BELL MOBILE SERVICES, a California corporation

By Charles Wood

Title Network Deployment Manager

ENCROACHMENT PERMIT APPROVAL
(to be completed by City)

This permit shall become effective upon the approval of the Departments listed below. Issuance of this permit shall not be construed as a waiver of any other applicable permit or requirement, but is only revocable permission to use the land for the purposes above described.

- | | | | |
|---|-------------------|---------------------------------|---|
| <input checked="" type="checkbox"/> Public Utilities Water | <u>B. Simpson</u> | <u>8/23/96</u> | <u>Property Services</u>
<u>Phillips</u>
<u>8/28/96</u> |
| <input checked="" type="checkbox"/> Public Utilities Electric | <u>Buttman</u> | <u>8.22.96</u> | |
| <input checked="" type="checkbox"/> Park and Recreation | <u>D. Jones</u> | <u>8/27/96</u> | |
| <input checked="" type="checkbox"/> Planning | <u>Cary Ann</u> | <u>8-28-96</u> <u>CM-51-956</u> | |

Upon obtaining the above signatures, return this permit to the Public Works Department for final approval.

Dated 8/28/96

Barry Beal
Public Works Director

Attachments: Terms and Conditions
Pacific Bell Mobile Services Drawings (as described above)

Encroachment Permit No. 1368

TERMS AND CONDITIONS

The following terms and conditions apply to encroachment permit number 1368

1. Permittee acknowledges that the areas of encroachment ("the areas") are owned or controlled by the City of Riverside.

2. Permittee acknowledges that the areas could at any time be needed for a proposed or planned public improvement and the City may require Permittee to relocate Permittee's facilities at Permittee's expense. City shall provide written notice of relocation to Permittee pursuant to the terms and conditions of the Master Communications Site License Agreement approved by the City Council of the City of Riverside on March 26, 1996, per City Council Minutes Vol. 81 Page 320. Permittee shall within the time prescribed by the City, remove and relocate all improvements necessary for the planned public improvement. If Permittee fails to abide by the relocation request of the City, the City shall have the right to remove Permittee's facilities without reimbursement to Permittee. The cost of such removal shall constitute a debt owed to the City and shall be paid by Permittee to the City.

Whenever the City causes the grading, widening, or other City improvement of the areas occupied by Permittee, and such grading, widening, or other City improvement requires the relocation of Permittee's then-existing facilities within the areas, the City shall:

Provide Permittee, within a reasonable time prior to the commencement of such grading or widening, written notice requesting such relocation; and

Provide Permittee with copies of any available plans and specifications for such grading or widening.

After receipt of such notice, plans and specifications, and pursuant to said terms and conditions contained in said Master Communications Site License Agreement, Permittee shall relocate such facilities which are in conflict with City construction and such relocation shall be at no cost to the City.

3. Permittee waives the right of claim, loss, damage or action against the City resulting from revocation, termination, removal of improvements or any action of the City, its officers, agents or employees taken in accordance with the terms herein.

4. If the City Council of the City of Riverside finds that Permittee is in default of the terms of this permit, that finding shall be cause for revocation.

5. Permittee shall hold the City of Riverside harmless from and against all claims demands, costs, losses, damages, injuries, actions for damages and/or injuries, and liability in connection with the construction, encroachment, and/or maintenance to be done by Permittee within the areas. Permittee also waives and releases any and all claims against the City of Riverside and its officers and employees for future losses, expenses, lost revenues and incidental and consequential damages suffered by

Permittee as a result of the City's negligently damaging Permittee's installation, except for the reasonable cost of repair.

6. Before commencing any construction on City controlled property, Permittee shall obtain a Construction Permit or Street Opening Permit from the City Public Works Department. The Permittee's contractor shall conduct construction activities in the areas as directed by the City's Construction Inspector. Particular attention shall be made to restoration of surfaces with similar materials where construction and/or investigations result in damage to public improvements. Restoration of the parkway to previously existing conditions must also be adhered to.

7. Permittee shall insure that construction of Permittee's improvements will not interfere in any way with existing City or utility facilities. The existing City facilities will require future maintenance, reconstruction and revisions and facilities may be added, any of which may result in removal or alteration of Permittee's improvements without reimbursement to the Permittee.

8. Prior to construction, Permittee shall contact Underground Service Alert to field locate existing utility lines. Any conflicts discovered will suspend the further work at the affected site until acceptable revisions are made.

9. At the end of construction, Permittee shall furnish a complete set of as-built plans that, in addition to showing usual construction details, shall also adequately show the horizontal and vertical location of Permittee's installations and appurtenances.

11. Permittee agrees to maintain a minimum of 4.00' clearance on existing sidewalks at each location to permit unobstructed pedestrian traffic.

12. This encroachment permit is further subject to the terms and conditions of the said Master Communications Site License Agreement approved by the City Council on March 26, 1996.

Dated August 27, 1996

PACIFIC BELL MOBILE SERVICES, a
California corporation





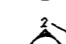
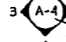
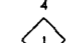
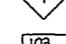
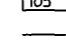
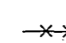
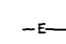
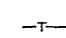
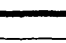

By Charles M. Munn

Title Aug. 27, 1996
Charles Munn

GENERAL NOTES

- DRAWINGS ARE NOT TO BE SCALED. WRITTEN DIMENSIONS TAKE PRECEDENCE AND THIS SET OF PLANS IS INTENDED TO BE USED FOR DIAGNOSTIC PURPOSES ONLY, UNLESS NOTED OTHERWISE. THE GENERAL CONTRACTOR'S SCOPE OF WORK SHALL INCLUDE TURNING ALL MATERIALS EQUIPMENT, LABOR, AND ANYTHING ELSE DEEMED NECESSARY TO COMPLETE INSTALLATIONS AS DESCRIBED HEREIN.
- PRIOR TO THE SUBMISSION OF BIDS, THE CONTRACTORS INVOLVED SHALL VISIT THE PROJECT SITE AND FAMILIARIZE THEMSELVES WITH THE LOCATION OF THE PROPOSED PROJECT WITH THE CONSTRUCTION AND CONTRACT DOCUMENTS, FIELD CONDITIONS AND NOTED OTHERWISE. FIELD CONDITIONS AND NOTED PRIOR TO PROCEEDING WITH CONSTRUCTION. ANY ERRORS, OMISSIONS, OR DISCREPANCIES ARE TO BE BROUGHT TO THE ATTENTION OF THE ARCHITECT/ENGINEER.
- THE CONTRACTOR SHALL RECEIVE WRITTEN AUTHORIZATION TO PROCEED WITH CONSTRUCTION PRIOR TO STARTING WORK ON ANY ITEM NOT CLEARLY DEFINED BY THE CONSTRUCTION DRAWINGS/CONTRACT DOCUMENTS.
- THE CONTRACTOR SHALL SUPERVISE AND DIRECT THE PROJECT DESCRIBED HEREIN. THE CONTRACTOR SHALL BE SOLELY RESPONSIBLE FOR ALL CONSTRUCTION MEANS, METHODS, TECHNIQUES, SEQUENCES AND PROCEDURES AND FOR COORDINATING ALL PORTIONS OF THE WORK UNDER THE CONTRACT.
- THE CONTRACTOR SHALL INSTALL ALL EQUIPMENT AND MATERIALS ACCORDING TO MANUFACTURER'S/VENDOR'S SPECIFICATIONS UNLESS NOTED OTHERWISE OR WHERE LOCAL CODES OR ORDINANCES TAKE PRECEDENCE.
- ALL WORK PERFORMED ON PROJECT AND MATERIALS INSTALLED SHALL BE IN STRICT ACCORDANCE WITH ALL APPLICABLE LOCAL REGULATIONS AND ORDINANCES. CONTRACTOR SHALL PROVIDE ALL NOTICES AND COPIES WITH ALL LAWS, ORDINANCES, RULES, REGULATIONS AND LAWFUL ORDERS OF ANY AGENCY AUTHORITY AND UTILITIES COMPANY SPECIFICATIONS AND LOCAL AND STATE JURISDICTIONAL CODES BEARING ON THE PERFORMANCE OF THE WORK.
- CONTRACTOR SHALL PROVIDE AT THE PROJECT SITE A FLEET SEVERAL CONSTRUCTION DOCUMENTS UPDATED WITH THE LATEST REVISIONS AND ADDENDA OR CLARIFICATIONS FOR USE BY ALL PERSONNEL INVOLVED WITH THE PROJECT.
- THE STRUCTURAL COMPONENTS OF THIS PROJECT SITE/FACILITY ARE NOT TO BE ALTERED BY THIS CONSTRUCTION PROJECT UNLESS NOTED OTHERWISE.
- DETAILS INCLUDED HEREIN ARE INTENDED TO SHOW THE END RESULT OF DESIGN. MINOR MODIFICATIONS ARE REQUIRED TO SUIT JOB CONDITIONS OR SITUATIONS AND SUCH MODIFICATIONS SHALL BE INCLUDED AS PART OF THE SCOPE OF WORK.
- SEAL PENETRATIONS THROUGH FIRE-RATED AREAS WITH ALL LISTED FIRE RESISTANT APPROVED MATERIALS IF APPLICABLE TO THIS FACILITY AND OF PROJECT SITE.
- PROVIDE A PORTABLE FIRE EXTINGUISHER WITH A RATING OF NOT LESS THAN 2-A OR 2-ABC WITH IN 75 FEET TRAVEL DISTANCE TO ALL PORTIONS OF THE PROJECT AREA DURING CONSTRUCTION.
- THE CONTRACTOR SHALL MAKE NECESSARY PROVISIONS TO PROTECT EXISTING IMPROVEMENTS, EASEMENTS, PAVING, CURBS, ETC DURING CONSTRUCTION. UPON COMPLETION OF WORK CONTRACTOR SHALL REPAIR ANY DAMAGE THAT MAY HAVE OCCURRED DUE TO CONSTRUCTION ON OR ABOUT THE PROPERTY.
- CONTRACTOR SHALL SEE TO IT THAT GENERAL WORK AREA IS KEPT CLEAN AND HAZARD FREE DURING CONSTRUCTION. DISPOSE OF ALL DIRT, DEBRIS, AND RUBBISH AND REMOVE EQUIPMENT NOT SPECIFIED AS REMAINING ON THE PROPERTY. PREMISES SHALL BE LEFT IN CLEAN CONDITION AND FREE FROM PAINT SPOTS, DUST, OR SMUDGES OF ANY NATURE.
- THE ARCHITECTS/ENGINEERS HAVE MADE EVERY EFFORT TO SET FORTH IN THE CONSTRUCTION AND CONTRACT DOCUMENTS THE COMPLETE SCOPE OF WORK. CONTRACTORS BIDDING THE WORK ARE NEVER THE LESS CAUTIONED THAT MINOR OMISSIONS OR ERRORS IN THE DRAWINGS AND OR SPECIFICATIONS SHALL NOT EXCUSE THE CONTRACTOR FROM COMPLETING THE PROJECT AND IMPROVEMENTS IN ACCORDANCE WITH THE INTENT OF THESE DOCUMENTS. THE BIDDER SHALL BEAR THE BURDEN OF CORRECTING THE CONTRACTOR'S PROPOSAL IN THE EVENT OF DISCREPANCIES. THE CONTRACTOR SHALL PRICE THE MORE COSTLY OR EXTENSIVE WORK, UNLESS DIRECTED OTHERWISE.
- CONTRACTOR MUST PERFORM WORK DURING OWNER'S PREFERRED HOURS TO AVOID DISTURBING NORMAL BUSINESS.
- IT SHALL BE THE RESPONSIBILITY OF THE CONTRACTOR TO LOCATE ALL EXISTING UTILITIES WHETHER SHOWN HEREON OR NOT AND TO PROTECT THEM FROM DAMAGE. THE CONTRACTOR SHALL BEAR ALL EXPENSES OF REPAIR OR REPLACEMENT IN CONNECTION WITH THE EXECUTION OF THIS WORK.
- THE CONTRACTOR SHALL VERIFY THE NUMBER AND LOCATION OF ALL EQUIPMENT ANCHORS WITH THE EQUIPMENT MANUFACTURERS.

SYMBOLS

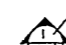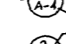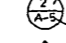-  SECTION NUMBER
-  SECTION REFERENCE
-  DETAIL NUMBER
-  DETAIL REFERENCE
-  ELEVATION NUMBER
-  EXTERIOR ELEVATION REFERENCE
-  ELEVATION NUMBER TYPICAL
-  INTERIOR ELEVATION REFERENCE
-  KEY NOTE REFERENCE
-  AREA AND/OR ROOM NUMBER
-  PROPERTY LINE
-  FENCING
-  ELECTRICAL SERVICE
-  TELCO SERVICE

SHEET INDEX

- T-1 TITLE SHEET
- A-1 CONSTRUCTION PLAN
- A-2 NORTH ELEVATION & SECTION
- A-3 EAST ELEVATION & SECTION AT POLE
- A-4 TRENCHING DETAILS


UTILITY PURVEYORS

- WATER - N/A (NOT USED)
- SEWER - N/A (NOT USED)
- GAS - N/A (NOT USED)
- TELEPHONE - GTE
- ELECTRICAL - SCE

CONSULTANT TEAM

- ARCHITECT:**
 JACK E. ANDERSEN
 SBA, Inc.
 2955 REDHILL AVENUE
 SUITE 100
 COSTA MESA, CA 92626
 PHONE: (714) 825-8051
 FAX: (714) 825-8050
- ELECTRICAL ENGINEER:**
 OMB ELECTRICAL
 23412 MOULTON PARKWAY
 SUITE 230
 LAGUNA HILLS, CA 92653
 PHONE: (714) 330-1552
 FAX: (714) 330-8921
 CONTACT: ROY LOPEZ
- ASSOCIATE ARCHITECT:**
 BAT
 2600 E. COAST HWY.
 SUITE: D
 CORONA DEL MAR, CA 92625
 PHONE: (714) 644-9321
 FAX: (714) 660-8651
 CONTACT: JASON WEEKS
- STRUCTURAL ENGINEER:**
 PEYTON - TOMITA & ASSOCIATES
 14730 BEACH BLVD.
 SUITE 202
 LA MIRADA, CA 90638
 PHONE: (714) 670-6614
 FAX: (714) 670-0931
 CONTACT: MARK TOMITA
- LAND SURVEYOR:**
 AGI
 937 S. VIALATA
 SUITE: 500
 COLTON, CA 92345
 PHONE: (909) 783-0101
 FAX: (909) 783-0108
 CONTACT: PAUL COCK

PACIFIC BELL

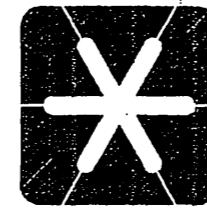

BELL

Mobile Services

CM-148-08 INDIANA
 LIGHT POLE ANTENNA INSTALLATION
 PUBLIC WORKS SET

LEGAL DESCRIPTION

PROJECT SUMMARY

- OWNER:**
 CITY OF RIVERSIDE
 3900 MAIN STREET
 RIVERSIDE, CA 92522
 (909) 369-0548
- APPLICANT:**
 PACIFIC BELL MOBILE SERVICES
 2955 REDHILL AVENUE
 SUITE 100
 COSTA MESA, CA 92626
 TELEPHONE: (714) 825-8017
- ZONING:**
 PUBLIC RIGHT OF WAY
- OCCUPANCY:**
 1991 UBC, 11-2; 1994 CBC, U-2
 CONSTRUCTION TYPE: V-N

PROJECT DESCRIPTION:

THE PROPOSED PROJECT ENTAILS:
 INSTALLATION OF A BASE TRANSCIVER STATION (BTS) MOUNTED ON A CONCRETE PAD.
 INSTALLATION OF A 60'-0" FOOT HIGH STREET LIGHT POLE WITH TOP MOUNTED UNICELL ANTENNAS.
 COAX CABLE RUNS WITH IN LIGHT POLE FROM ANTENNAS TO BTS;
 A NEW TELEPHONE SERVICE RUN TO BTS AS SHOWN;
 A NEW 100A ELECTRICAL SERVICE TO BTS AS SHOWN;
 THE SITE MAY REQUIRE A SMALL AMOUNT OF CIVIL WORK TO FACILITATE A LEVEL SITE.

PLANCHECK #:


APPROVALS

THE FOLLOWING PARTIES HEREBY APPROVE AND ACCEPT THESE DOCUMENTS AND AUTHORIZE THE CONTRACTOR TO PROCEED WITH THE CONSTRUCTION DESCRIBED HEREIN. ALL CONSTRUCTION DOCUMENTS ARE SUBJECT TO REVIEW BY THE LOCAL BUILDING DEPARTMENT AND ANY CHANGES AND MODIFICATIONS THEY MAY IMPOSE.

	PRINT NAME	SIGNATURE	DATE
LANDLORD	_____	_____	_____
PBMS MANAGER	_____	_____	_____
RF MANAGER	_____	_____	_____
SITE ACQUISITION	_____	_____	_____
AEC	_____	_____	_____

NOT FOR CONSTRUCTION
 PUBLIC WORKS PARTIAL SET
 SEE CONSTRUCTION DRAWINGS
 FOR DETAILS AND ADDITIONAL
 INFORMATION

VICINITY MAP

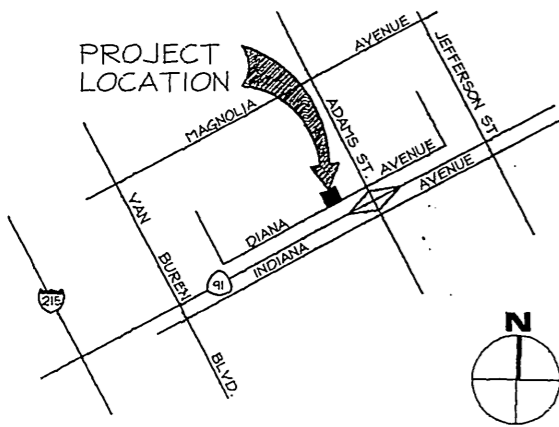

PROPRIETARY INFORMATION

THE INFORMATION CONTAINED IN THIS SET OF CONSTRUCTION DOCUMENTS IS PROPRIETARY BY NATURE. ANY USE, OR DISCLOSURE OTHER THAN THAT WHICH RELATES TO PACIFIC BELL MOBILE SERVICES IS STRICTLY PROHIBITED.

DATE: 7-29-96

ARCHITECT: BAT

DRAWN BY: RT

CHECKED BY:

REVISIONS

REV	DATE	DESCRIPTION	BY
▲			
▲			
PACIFIC BELL
 Mobile Services
 4420 ROSEWOOD DR. BLDG. 2, 4TH FLOOR
 PLEASANTON, CALIFORNIA 94568

SBA
 SBA Consulting Services, Inc.
 Project Office:
 955 Main St.
 Redhill, CA 92626
 (714) 825-8051
 (714) 825-8052

BAT
 Architecture & Planning
 1800 E. Coast Hwy., Ste. D
 Corona Del Mar, CA 92625
 Phone: (714) 644-9321
 Fax: (714) 644-8551

SITE NUMBER:
 CM-148-08 PA1 BS2

SITE TYPE:
 LIGHT POLE
 ANTENNA INSTALLATION

LOCATION:
 INDIANA
 DIANA AVENUE

RIVERSIDE, CA 92504

TITLE:
 TITLE SHEET

SHEET NUMBER:
 T-1

LAST UPDATED: 08/07/96 - 08:05
 LAST PLOTTED: 08/07/96 - 08:05

801-308

CONSTRUCTION PLAN KEYED NOTES

- | | |
|--|--|
| 1 LEASE AREA LIMIT LINE | 11 (4) UNDERGROUND 4" CONDUITS FROM LIGHTPOLE TO CONCRETE PULL-BOX |
| 2 EXISTING CONCRETE BLOCK RETAINING WALL | 12 (3) UNDERGROUND 4" CONDUITS FROM PULL-BOX TO BTS |
| 3 EXISTING LIGHTPOLE TO BE REMOVED MAINTAIN STREET LIGHT DURING CONSTRUCTION | 13 EXISTING UNDERGROUND ELECTRICAL SERVICE |
| 4 EXTERNAL DISCONNECT SWITCH AND SUB-METER ENCLOSURE, SEE I/E-2 | 14 EXISTING UNDERGROUND GAS LINE |
| 5 BASE TRANSCIVER STATION (BTS) | 15 CONCRETE SLAB, SEE I/A-2 |
| 6 NOT USED | 16 EXISTING TREE |
| 7 LIGHTPOLE WITH TOP MOUNTED ANTENNA SEE MONOPOLE MANUFACTURER DRAWINGS | 17 PROPOSED SOIL BORING LOCATION (SEE IMPORTANT NOTICE BELOW) |
| 8 LNA ENCLOSURE SEE DETAIL 3/A-2 | |
| 9 TELEPHONE CABINET SEE DETAIL 3/E-1 | |
| 10 UNDERGROUND 3'-0" X 2'-0" PULL-BOX FOR COAX CABLE TRANSITION OF 7/8" CABLE TO 1/2" JUMPERS. SEAL WITH AIR AND WATERTIGHT LID. | |

IMPORTANT NOTICE
 Section 4216/4217 of the Government Code requires a DigAlert Identification Number be issued before a "Permit to Excavate" will be valid. For your DigAlert I.D. Number Call Underground Service Alert TOLL FREE 1-800-422-4133 Two working days before you dig


NOTE:

- NO SEWER/WATER LATERAL LINES OR WATER METERS WITHIN THIS AREA OF ENCROACHMENT PERMIT.
- CONTRACTOR TO REPAIR, REPLACE OR RELOCATE LANDSCAPE & IRRIGATION LINES AS NECESSARY & PROVIDE ADEQUATE SCREENING OR TREATMENT CABINETS PER CITY DESIGN REVIEW REQUIREMENTS.
- NO WORK SHALL OCCUR ON PRIVATE PROPERTY. ALL NEW WORK SHALL BE CONFINED TO PUBLIC RIGHT-OF-WAY.

NOTE:
 ALL EQUIPMENT BOXES WITHIN LEASE AREA SHALL BE PAINTED WITH SINCLAIR "FOREST GREEN" (OR EQUAL) AND TREATED WITH AN ANTI-GRAFFITI COATING

retain and protect as many existing junipers in place as possible

NOT FOR CONSTRUCTION
 PUBLIC WORKS PARTIAL SET
 SEE CONSTRUCTION DRAWINGS FOR DETAILS AND ADDITIONAL INFORMATION

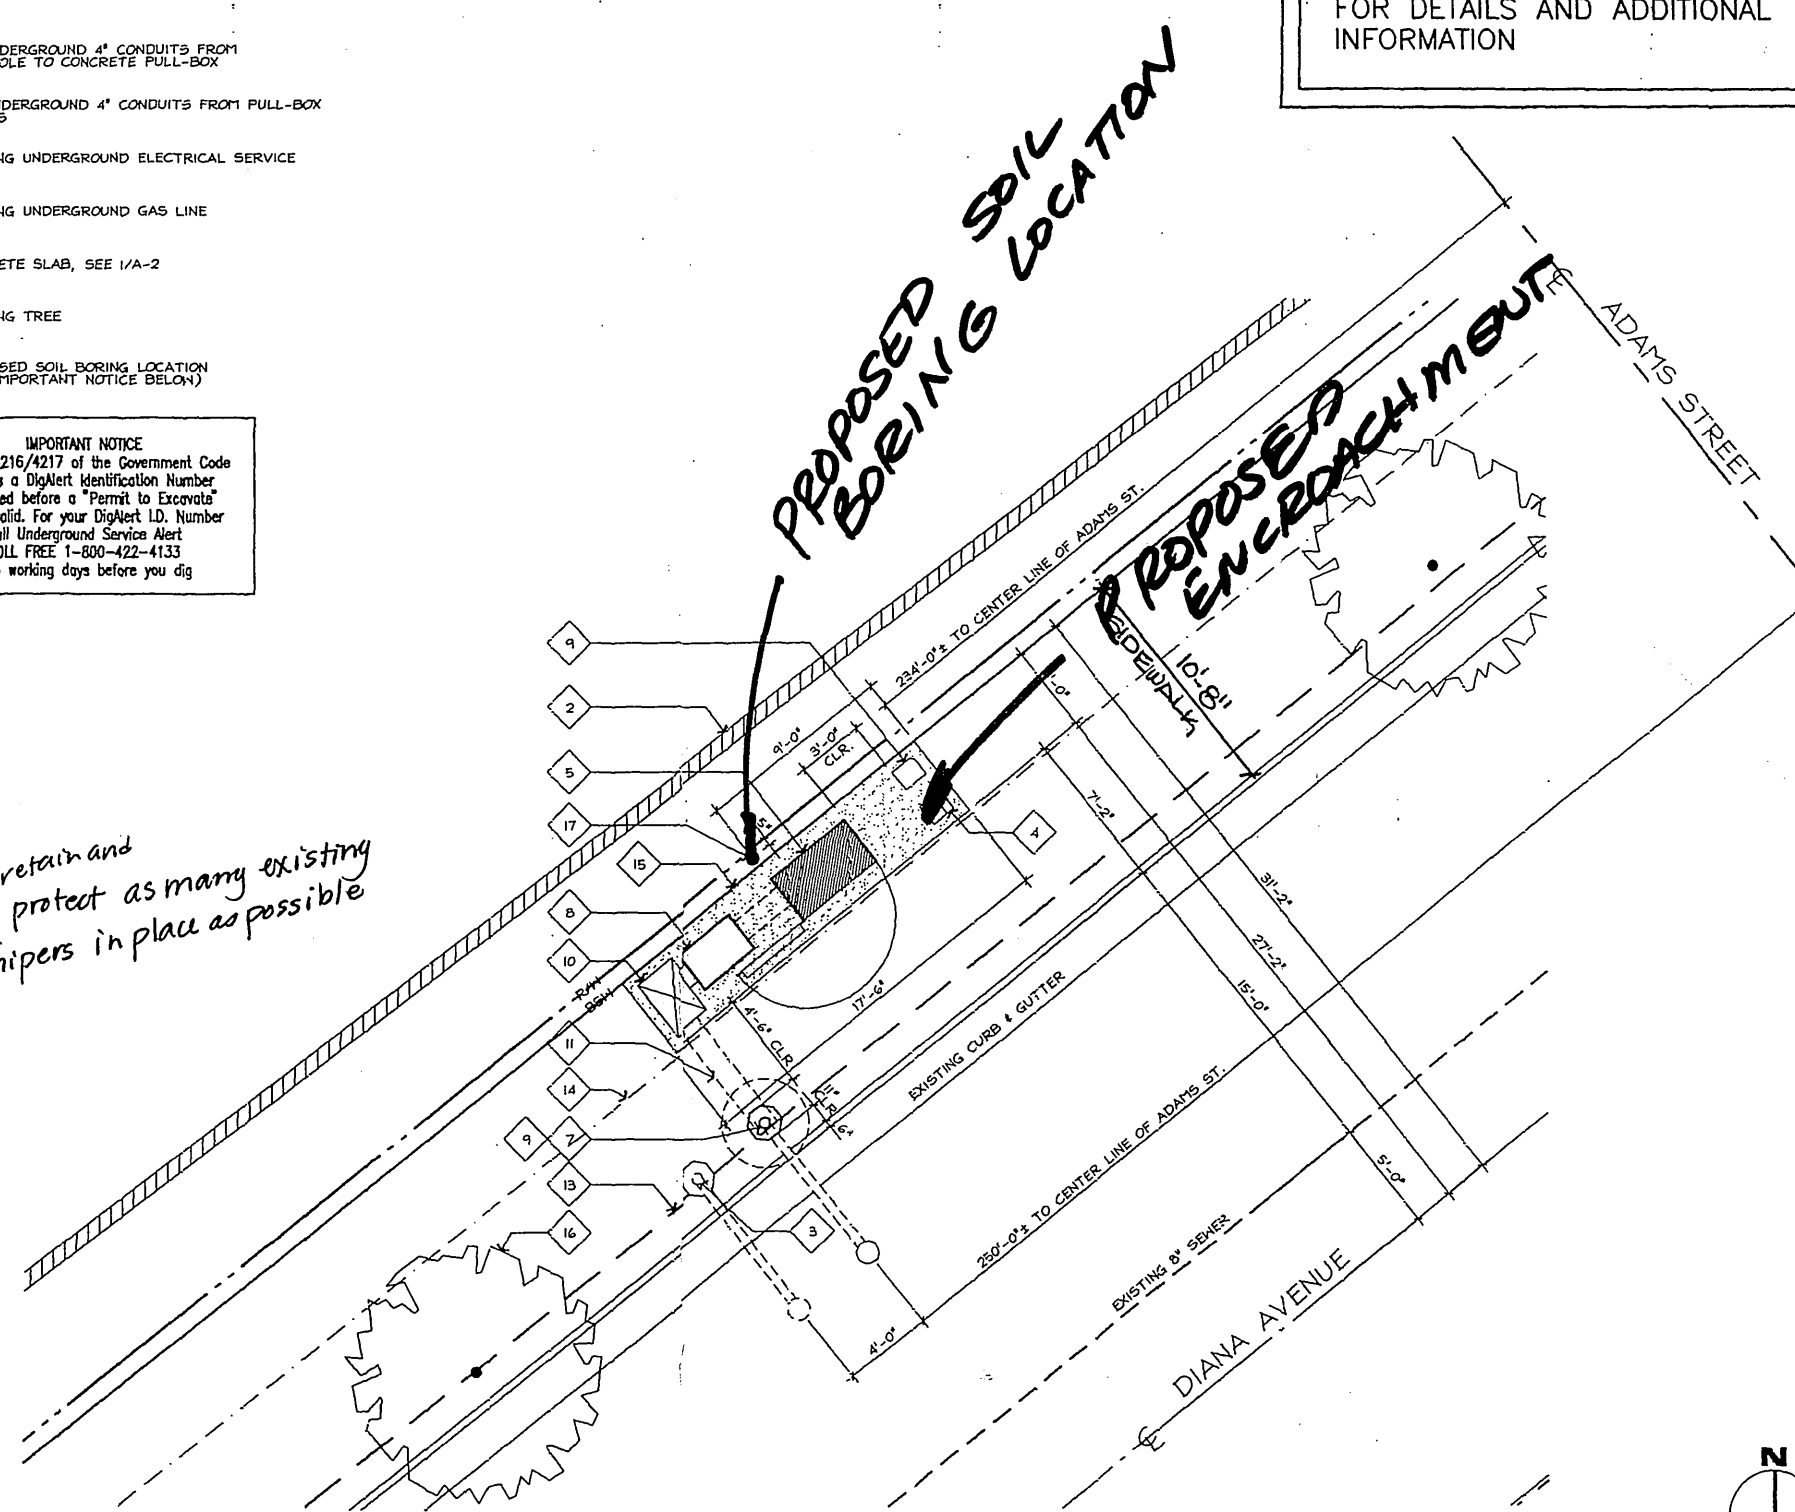

PROPRIETARY INFORMATION
 THE INFORMATION CONTAINED IN THIS SET OF CONSTRUCTION DOCUMENTS IS PROPRIETARY BY NATURE. ANY USE OR DISCLOSURE OTHER THAN THAT WHICH RELATES TO PACIFIC BELL MOBILE SERVICES IS STRICTLY PROHIBITED.

DATE: 7-29-96
 ARCHITECT: BAT
 DRAWN BY: RT
 CHECKED BY:

REVISIONS			
REV	DATE	DESCRIPTION	BY

PACIFIC BELL
Mobile Services
 4420 ROSEWOOD DR. BLDG. 2, 4TH FLOOR
 PLEASANTON, CALIFORNIA 94588

SBA
 SBA Consulting Services, Inc.
 Project Office:
 2955 Redhill Avenue
 Costa Mesa, CA 92626
 (714) 825-8051
 (714) 825-8052

Btelecommunications
 Architecture & Planning
 2600 E. Coast Hwy, Suite 0
 Corona Del Mar, CA 92625
 Phone: (714) 841-9321
 Fax: (714) 841-8551

SITE NUMBER:
 CM-148-08 PA1 BS2

SITE TYPE:
 LIGHT POLE
 ANTENNA INSTALLATION

LOCATION:
 INDIANA
 DIANA AVENUE
 RIVERSIDE, CA 92504

TITLE:
 CONSTRUCTION PLAN

SHEET NUMBER:
 A-1

CONSTRUCTION PLAN

SCALE: 1/4"=1'-0" 1


20f5

LAST UPDATED: 08/07/96 - 08:04
 LAST PLOTTED: 08/07/96 - 08:04

E-1368

NOTE:
 ALL EQUIPMENT BOXES SHALL BE
 PAINTED SINCLAIR "FOREST GREEN" (OR EQUAL)
 AND TREATED WITH AN ANTIGRAFFITI COATING

NOT FOR CONSTRUCTION
 PUBLIC WORKS PARTIAL SET
 SEE CONSTRUCTION DRAWINGS
 FOR DETAILS AND ADDITIONAL
 INFORMATION

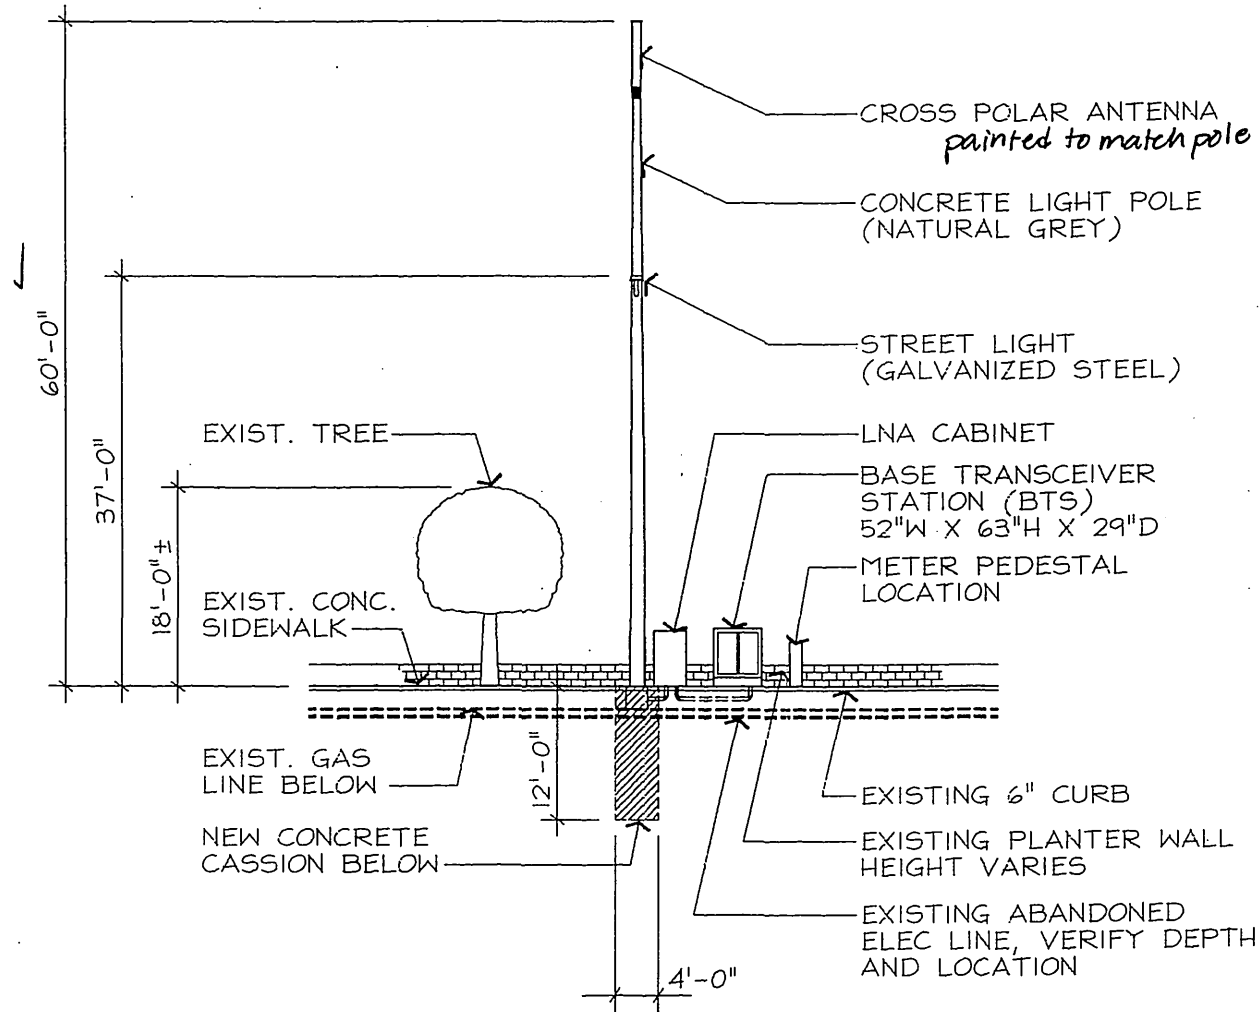

PROPRIETARY INFORMATION
 THE INFORMATION CONTAINED IN THIS
 SET OF CONSTRUCTION DOCUMENTS IS
 PROPRIETARY BY NATURE. ANY USE
 OR DISCLOSURE OTHER THAN THAT
 WHICH RELATES TO PACIFIC BELL
 MOBILE SERVICES IS STRICTLY PROHIBITED.

DATE: 7-29-96

ARCHITECT: BAT

DRAWN BY: RT

CHECKED BY:

REVISIONS			
REV	DATE	DESCRIPTION	BY
△			
△			
△			
△			

PACIFIC BELL
Mobile Services
 4420 ROSEWOOD DR. BLDG. 2, 4TH FLOOR
 PLEASANTON, CALIFORNIA 94588

SBA
 SBA Consulting Services, Inc.
 Project Office:
 28th Street
 Castro Valley, CA 94526
 Phone: (714) 825-8051
 Fax: (714) 825-8052

Btelecommunications
 Architecture & Planning
 2600 E. Coast Hwy, Suite 0
 Corona Del Mar, CA 92625
 Phone: (714) 641-9321
 Fax: (714) 641-9351

SITE NUMBER:
 CM-148-08 PA1 BS2

SITE TYPE:
 LIGHT POLE
 ANTENNA INSTALLATION

LOCATION:
 INDIANA
 DIANA AVENUE
 RIVERSIDE, CA 92504

TITLE:
 SOUTHEAST ELEVATION
 SECTION

SHEET NUMBER:
 A-2

SOUTHEAST ELEVATION SECTION

SCALE:
 1/16"=1'-0"

1


A-2

LAST UPDATED: 08/07/96 - 08:04
 LAST PLOTTED: 08/07/96 - 08:04

E-1368

NOTE:
 ALL EQUIPMENT BOXES SHALL BE PAINTED SINCLAIR "FOREST GREEN" (OR EQUAL) AND TREATED WITH AN ANTIGRAFFITI COATING

NOT FOR CONSTRUCTION
 PUBLIC WORKS PARTIAL SET
 SEE CONSTRUCTION DRAWINGS FOR DETAILS AND ADDITIONAL INFORMATION

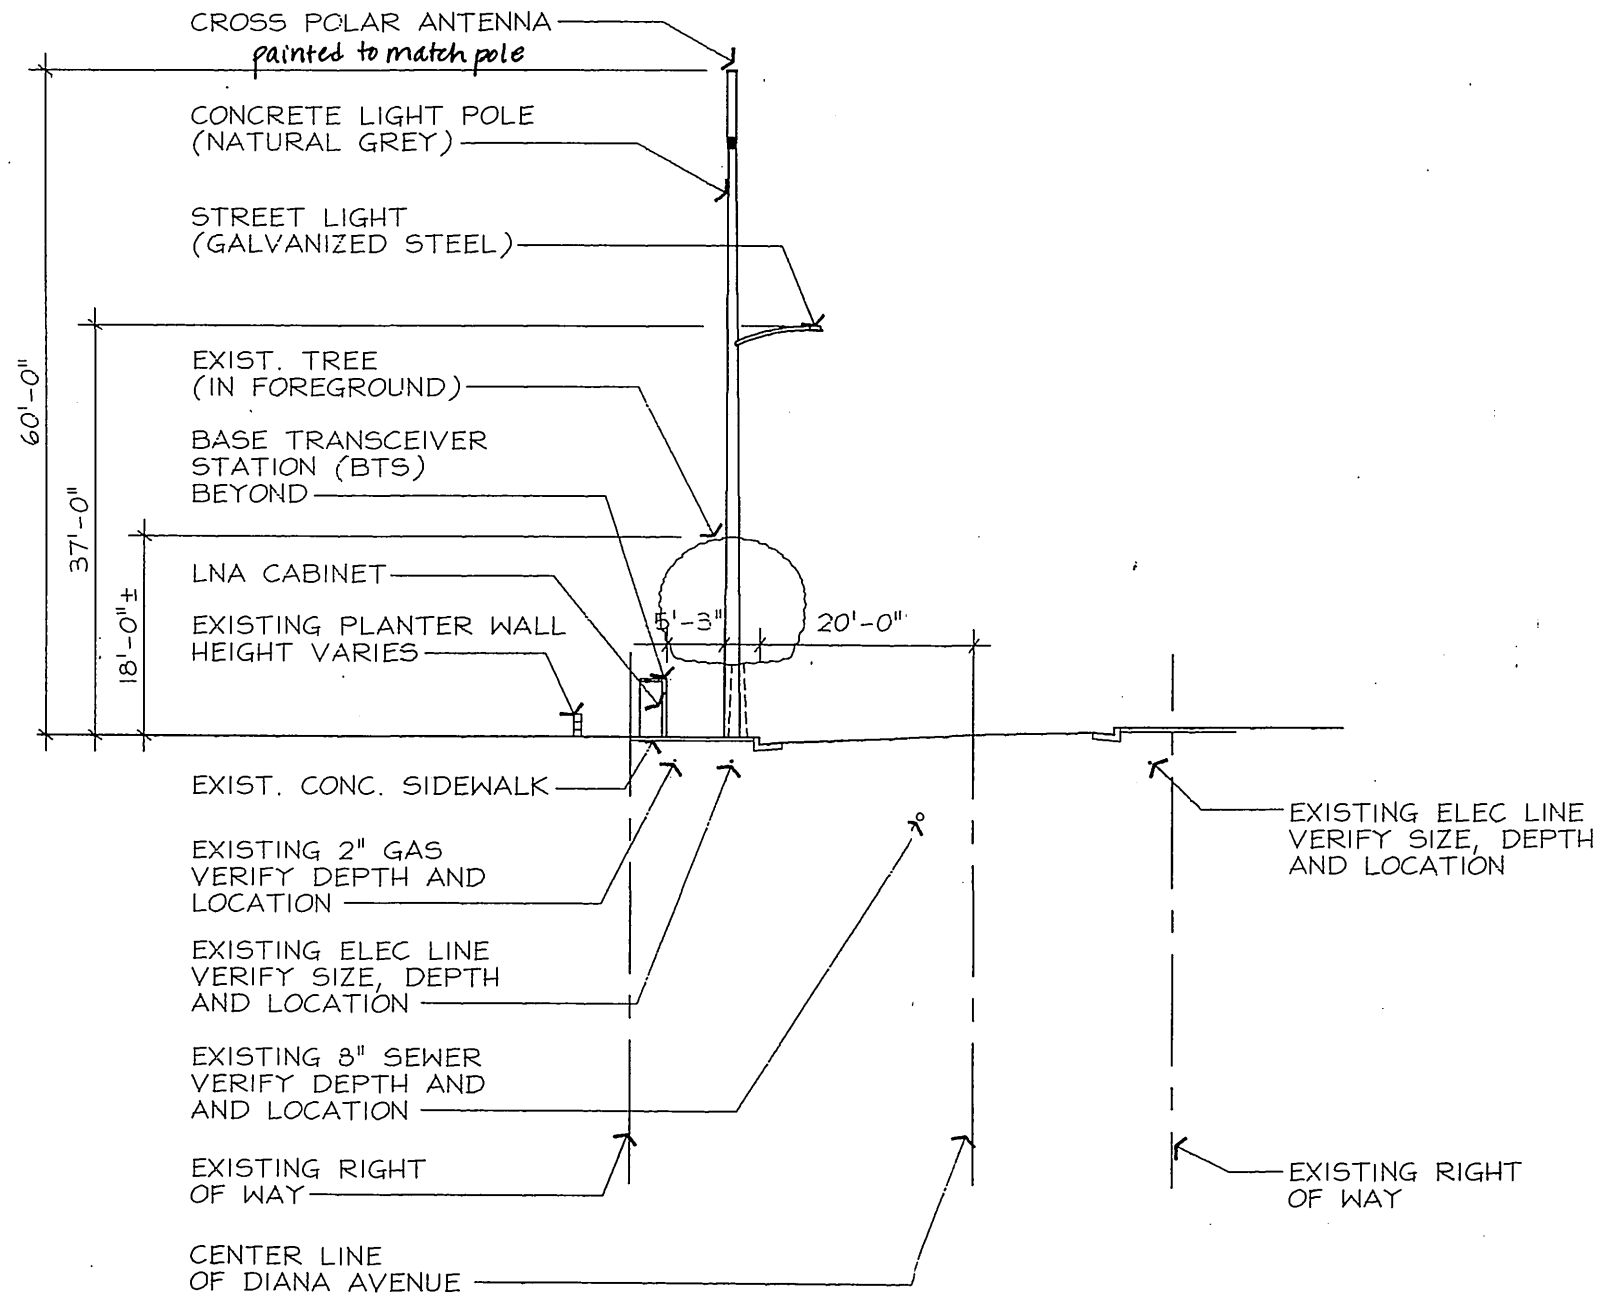

PROPRIETARY INFORMATION
 THE INFORMATION CONTAINED IN THIS SET OF CONSTRUCTION DOCUMENTS IS PROPRIETARY BY NATURE. ANY USE OR DISCLOSURE OTHER THAN THAT WHICH RELATES TO PACIFIC BELL MOBILE SERVICES IS STRICTLY PROHIBITED.

DATE: 7-29-96
 ARCHITECT: BAT
 DRAWN BY: RT
 CHECKED BY:

REVISIONS			
REV	DATE	DESCRIPTION	BY
▲			
▲			
PACIFIC BELL
Mobile Services
 4420 ROSEWOOD DR. BLDG. 2, 4TH FLOOR
 PLEASANTON, CALIFORNIA 94588

SBA Consulting Services, Inc.
 Project Office:
 10000 Wilshire Blvd., Suite 200
 Culver City, CA 90230
 Phone: (714) 825-8051
 Fax: (714) 825-8052

BAT Telecommunications
 Architecture & Planning
 7800 E. Coast Hwy, Suite 0
 Corona Del Mar, CA 92625
 Phone: (714) 641-8321
 Fax: (714) 641-8651

SITE NUMBER:
CM-148-08 PA1 BS2

SITE TYPE:
LIGHT POLE ANTENNA INSTALLATION

LOCATION:
INDIANA DIANA AVENUE
RIVERSIDE, CA 92504

TITLE:
SOUTHWEST ELEVATION SECTION

SHEET NUMBER:
A-3

SOUTHWEST ELEVATION SECTION

SCALE:
 1/16"=1'-0"


1

A-3

LAST UPDATED: 08/07/96 - 08:05
 LAST PLOTTED: 08/07/96 - 08:05

E-1360

- NOTE:
1. THE CITY WILL PROVIDE THE CABLE, THE DEVELOPER WILL PROVIDE AND INSTALL THE DB CONDUIT.
 2. THE TRANSITION INTO THE PEDESTAL WILL BE A CITY APPROVED SWEEP UP TO PED. CONTACT INSPECTION AT 782-5429 FOR APPROVAL.
 3. NO CABLE IN CONDUIT IS TO BE USED FOR ELECTRIC SYSTEM.
 4. ONLY USE SELECT BACKFILL.
 5. SIZE OF CONDUIT SHALL BE AS SPECIFIED ON CITY OF RIVERSIDE UTILITY DRAWING.

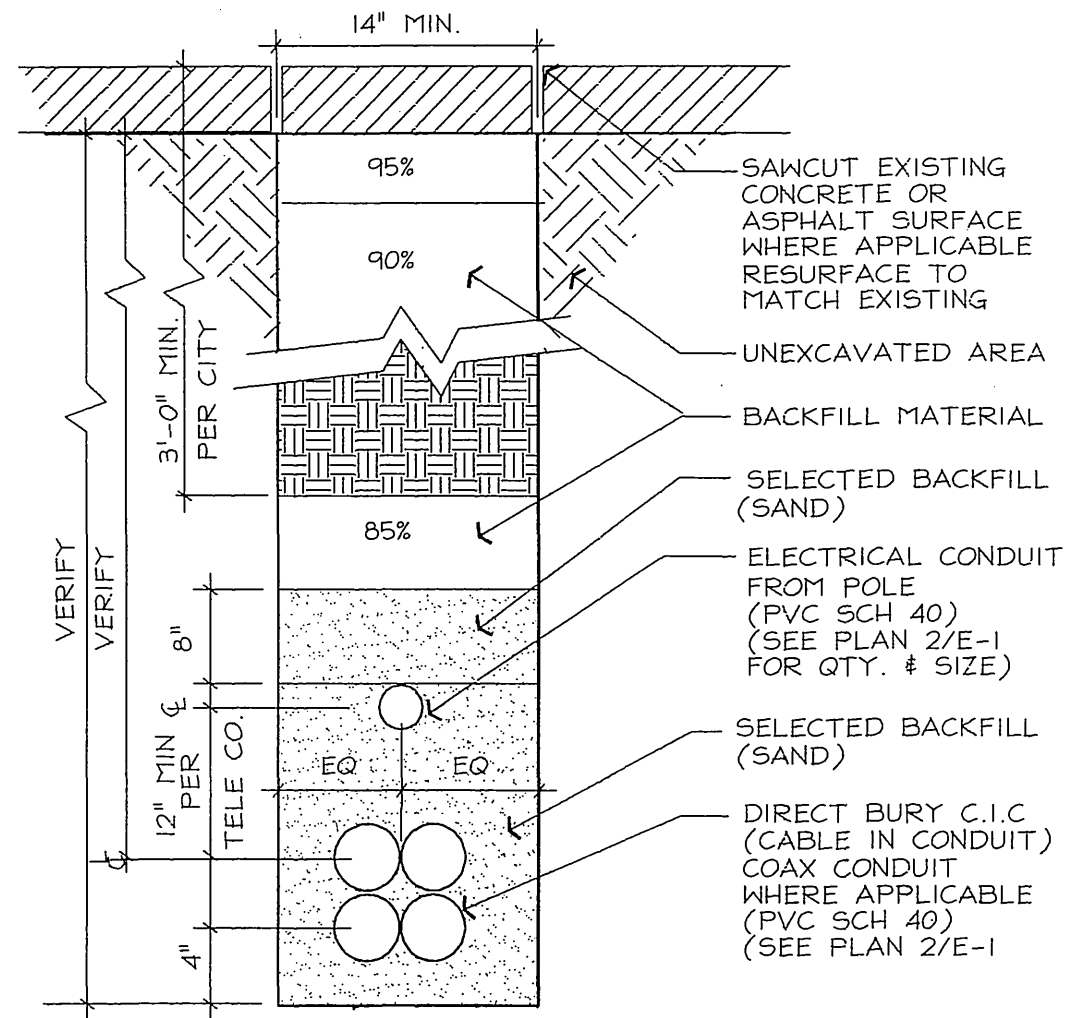


COAX CONDUIT TRENCH

SCALE:
1 1/2" = 1'-0"

6

NOT FOR CONSTRUCTION
PUBLIC WORKS PARTIAL SET
SEE CONSTRUCTION DRAWINGS
FOR DETAILS AND ADDITIONAL
INFORMATION

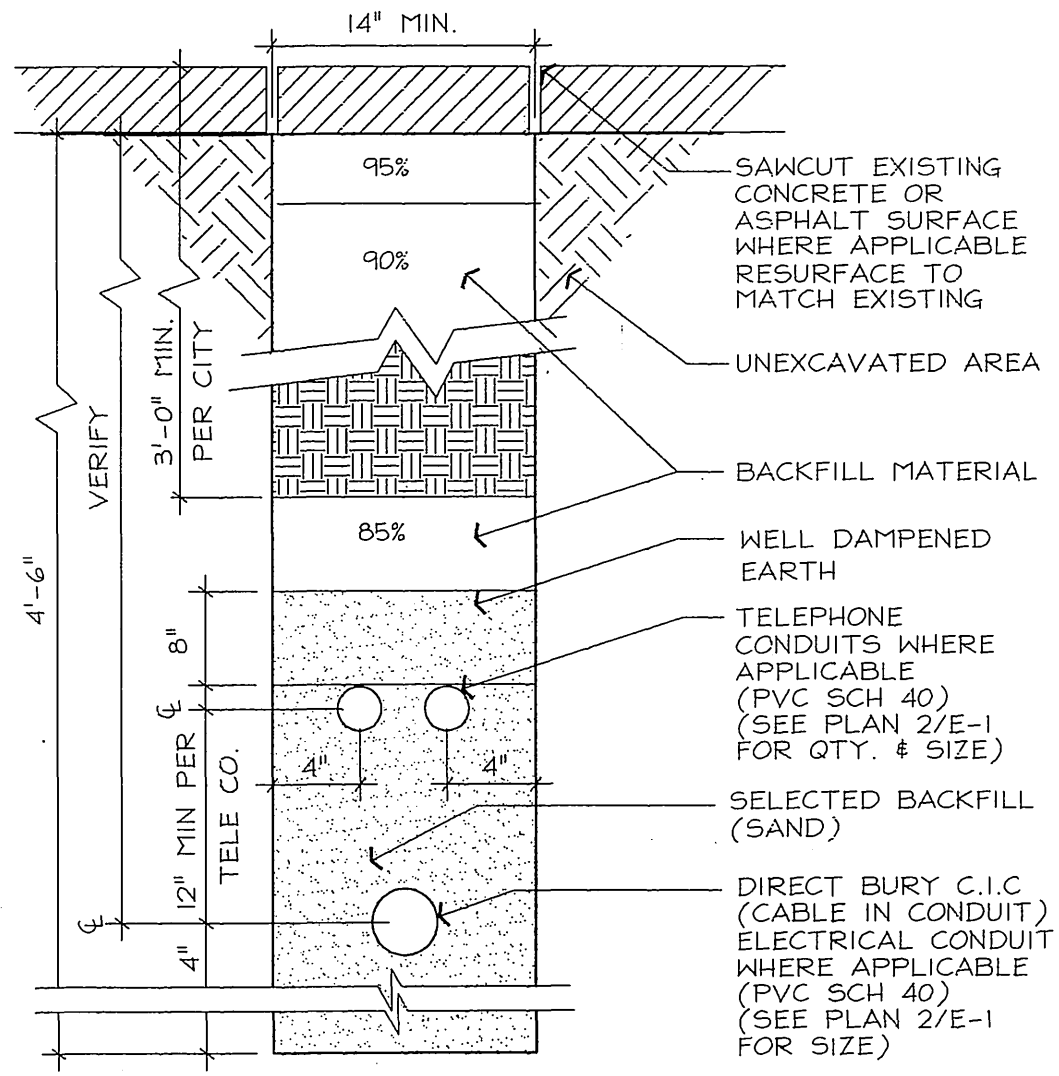

ELEC/TELCO TRENCH

SCALE:
1 1/2" = 1'-0"

3

PROPRIETARY INFORMATION
THE INFORMATION CONTAINED IN THIS SET OF CONSTRUCTION DOCUMENTS IS PROPRIETARY BY NATURE. ANY USE OR DISCLOSURE OTHER THAN THAT WHICH RELATES TO PACIFIC BELL MOBILE SERVICES IS STRICTLY PROHIBITED.

DATE: 7-29-96
ARCHITECT: BAT
DRAWN BY: RT
CHECKED BY:

REVISIONS			
REV	DATE	DESCRIPTION	BY
▲			
▲			
PACIFIC BELL
Mobile Services
4420 ROSEWOOD DR. BLDG. 2, 4TH FLOOR
PLEASANTON, CALIFORNIA 94588

SBA Consulting Services, Inc.
Project Office:
2855 Redhill Avenue
Costa Mesa, CA 92626
(714) 823-8052

Btelecommunications
Architecture & Planning
2600 E. Coast Hwy, Suite 0
Carrollton, TX 75620
Phone: (714) 844-8851
Fax: (714) 844-8851

SITE NUMBER:
CM-148-08 PA1 BS2
SITE TYPE:
LIGHT POLE
ANTENNA INSTALLATION
LOCATION:
INDIANA
DIANA AVENUE
RIVERSIDE, CA 92504
TITLE:
TRENCHING
DETAILS
SHEET NUMBER:

A-4

LAST UPDATED: 08/07/96 - 08:05
LAST PLOTTED: 08/07/96 - 08:05

E-1368