

ENCROACHMENT PERMIT

Pursuant to Resolution No. 11065 of the City of Riverside, permission is hereby granted to Leslie A. Devors
3054 Belvedere Dr.
Riverside, CA

his heirs and assigns, hereinafter referred to as "Permittee" to use and occupy the following described property.

That portion of Belvedere Drive, a public right of way, adjacent to the southwesterly line of Lot 27 and Lot 26 of Belvedere Heights on file in Book 22 of Maps, at Page 31 thereof, records of Riverside County, California,

in accordance with the terms hereof.

1. Permittee shall use and occupy the described property only in the manner and for the purposes as follows:

To maintain a variable height fence against a block retaining wall 4.33 feet high at corners (lowers slightly to northwest) encroaching into said right of way from 14 feet to 19 feet, as shown by Exhibit "A" attached and made a part hereof by this reference.

2. Permittee, by acceptance of the benefits hereunder, acknowledges title to the property to be in the City of Riverside and waives any right to contest the validity of the dedication or grant.

3. Permittee acknowledges that the described property is the site of a proposed or planned public improvement and that, accordingly, all rights and privileges of use permitted shall cease and expire upon notice of revocation by the City. Upon the expiration or revocation, Permittee shall, within the time prescribed by the City, remove all improvements or obstructions placed, constructed or maintained by the Permittee. If the Permittee fails to abide by the removal order of the City within the time prescribed, the City shall have the right to remove and destroy the improvements without reimbursement to the Permittee and the cost of such removal shall be paid by the Permittee to the City of Riverside and shall constitute a debt owed to the City of Riverside.

4. Permittee, by acceptance hereof, waives the right of claim, loss, damage or action against the City of Riverside arising out of or resulting from revocation, termination, removal of the improvements or any action of the City of Riverside, its officers, agents or employees taken in accordance with the terms hereof.

5. Finding and determination by the City Council of the City of Riverside that the Permittee, or his heirs and assigns or successors in interest, are in default of the terms hereunder shall be cause for revocation.

6. Permittee herewith agrees to hold the City of Riverside harmless from and against all claims, demands, costs, losses, damages, injuries, action for damages and/or injuries, and liability growing or arising out of or in connection with the construction, encroachment, and/or maintenance to be done by Permittee or his agents, employees or contractors within the described property.

DATED: Sept. 21, 1981

CITY OF RIVERSIDE, a municipal corporation

By M. Brown Mayor

Attest: Alice A. Stone City Clerk

The foregoing is accepted by:

[Signature]
(Signature(s) of Permittee)

APPROVED AS TO CONTENT

[Signature]
Department Head


APPROVED AS TO FORM

John Woodhead
City Attorney

CITY MANAGER APPROVAL

Robert C. Fremont
City Manager

EXHIBIT 'A'

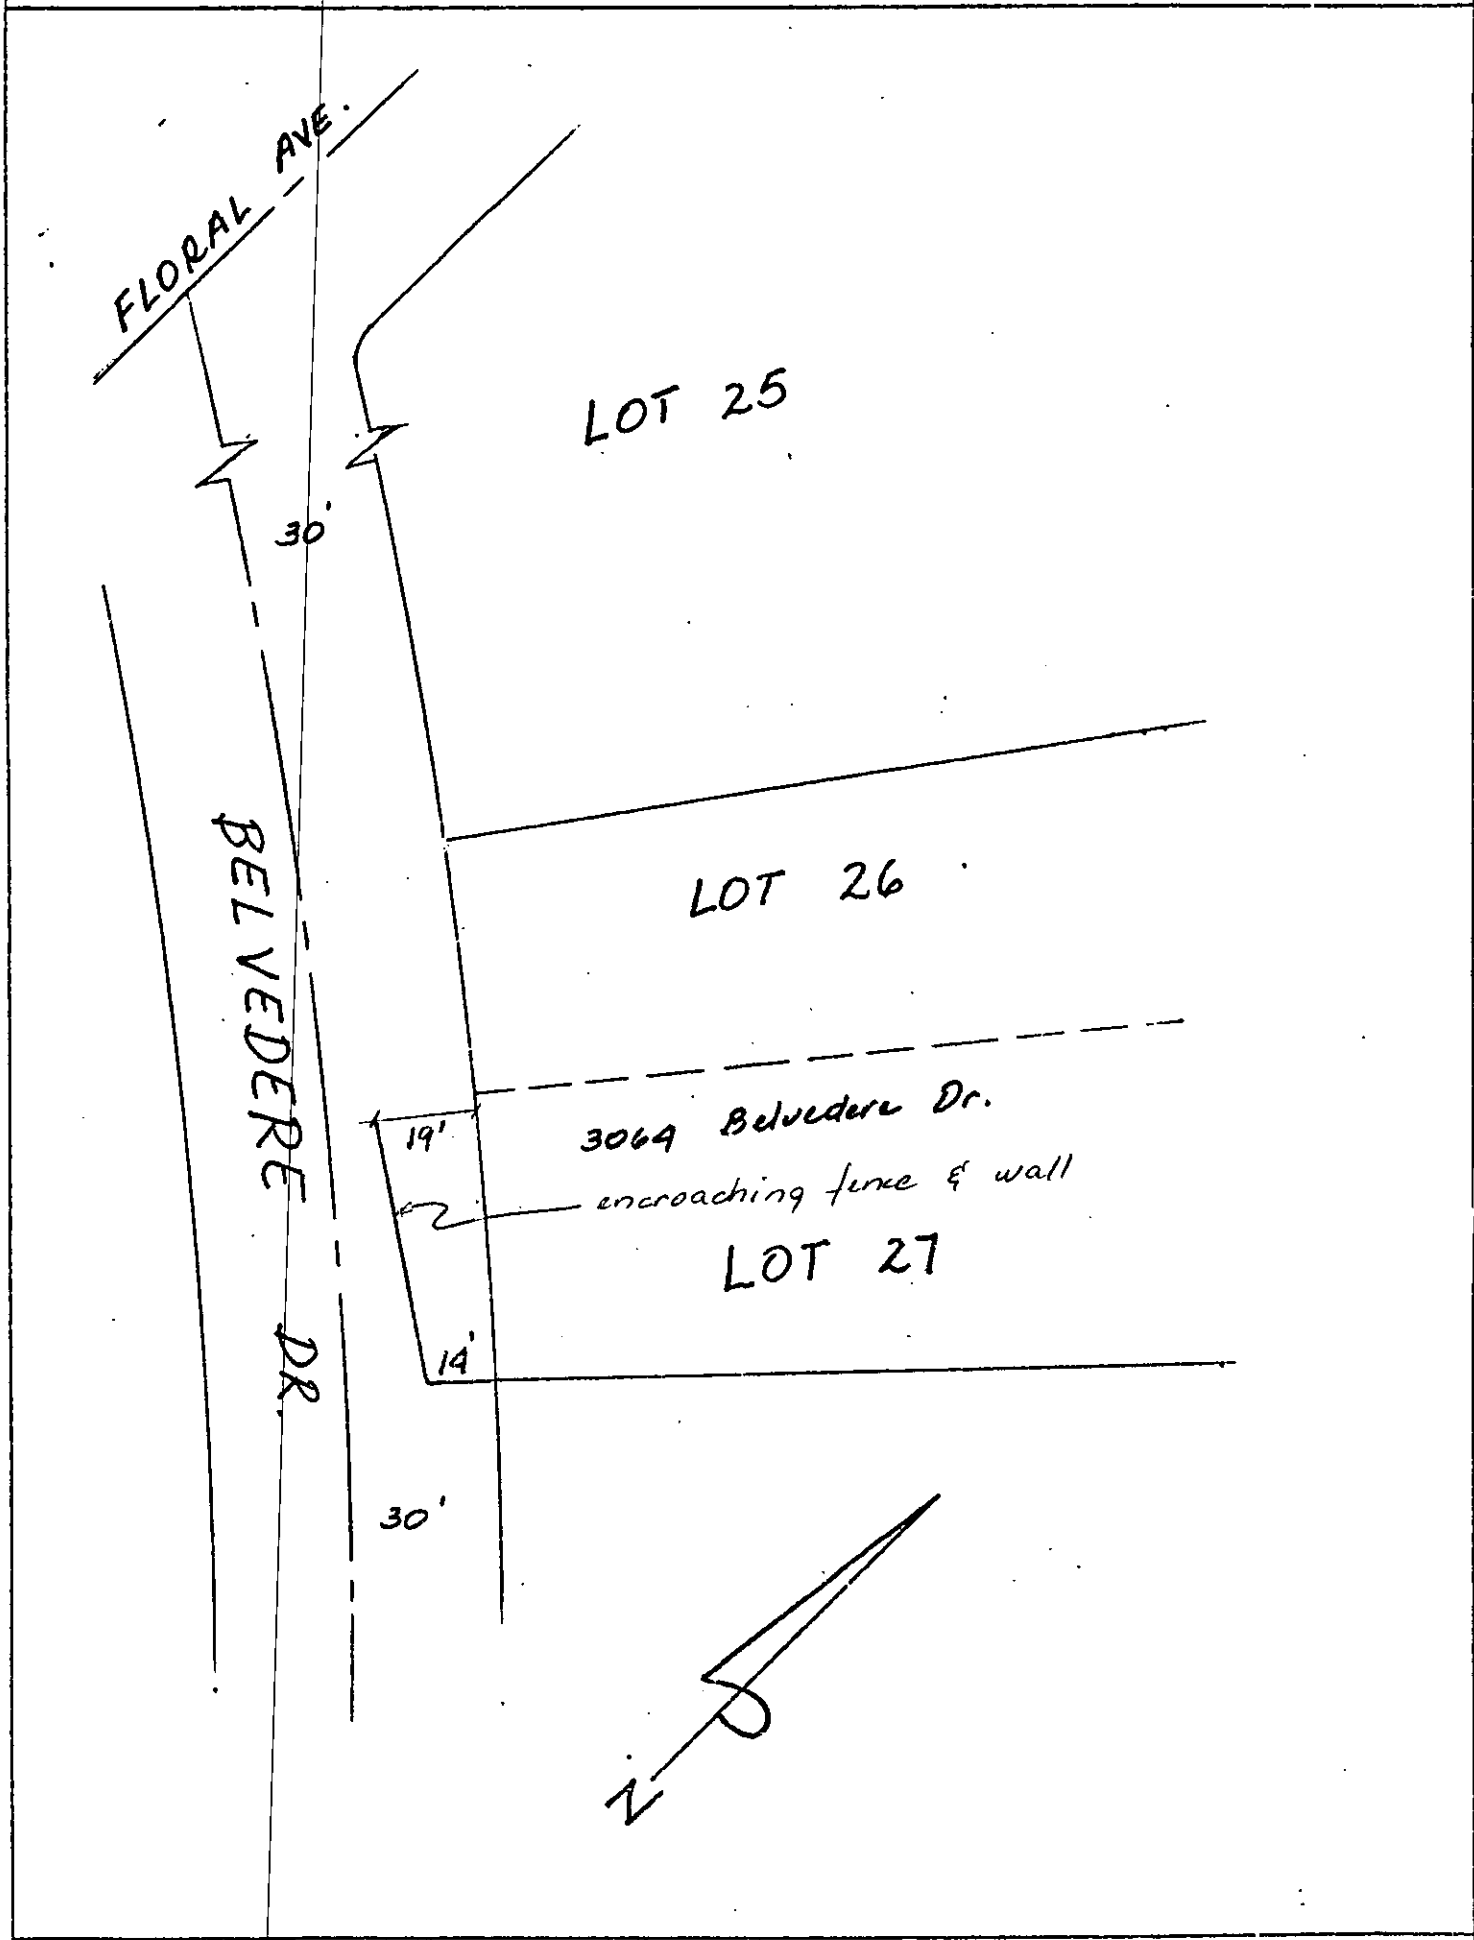

CITY OF RIVERSIDE, CALIFORNIA

Par Lot 27 & Lot 26 MB 22/31 Belvedere Hts.


SHEET 1 OF 2

CB 12/26-1

SCALE: 1" = 40'

DRAWN BY E.F. DATE 4/24/81

SUBJECT: Encroachment Permit - 3064 Belvedere Dr.

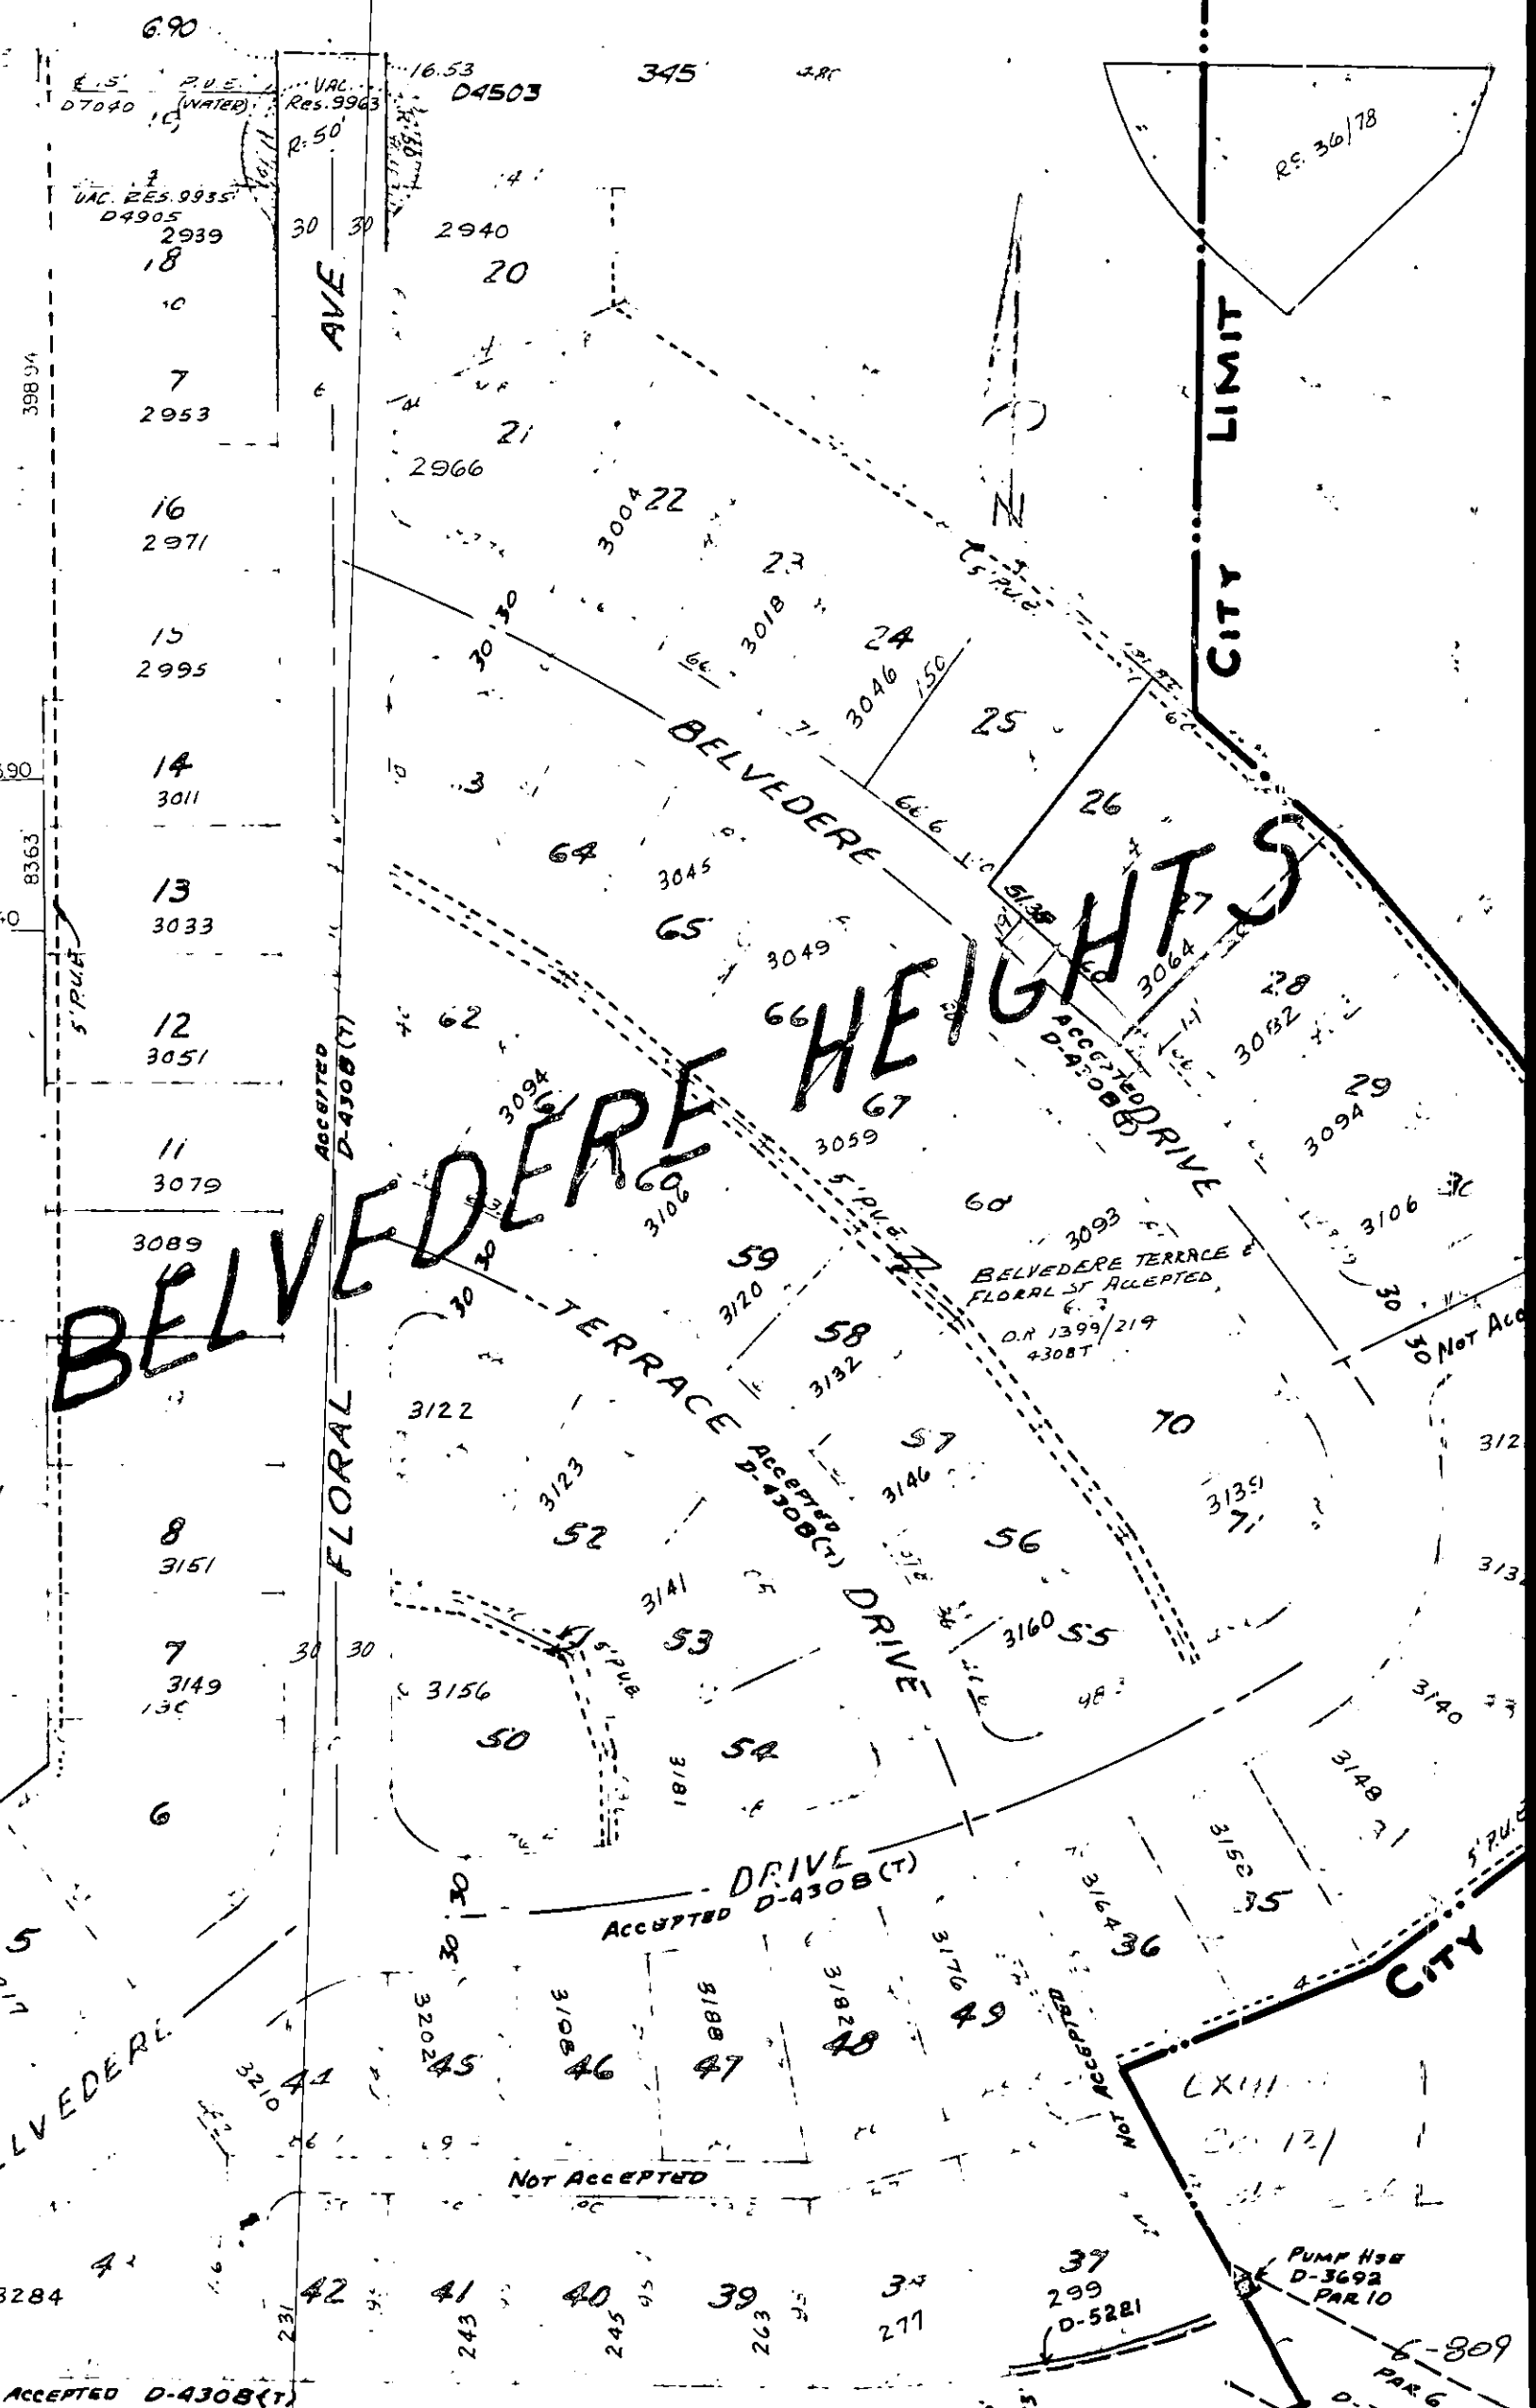

6.90

VAL. RES. 9963

16.53 345 2.80 D4503

RS. 36/78

UAC. RES. 9935 D4905 2939

R-50

2940 20

388.94

7 2953

390

14 3011

836.3

13 3033

5' P.U.E.

12 3051

ACCEPTED D-4308(T)

11 3079

3089

8 3151

7 3149 130

6

FLORAL AVE

TERRACE

DRIVE ACCEPTED D-4308(T)

BELVEDERE

HEIGHTS

BELVEDERE TERRACE & FLORAL ST ACCEPTED D.R. 1399/219 430BT

CITY LIMIT

CITY

NOT ACCEPTED

PUMP HSE D-3692 PAR 10

37 299 D-5281

6-809 PAR 6 D-36

ACCEPTED D-4308(T)