



Sheet No. 1 General Plan  
 2 Span No. 1  
 3 " 2  
 4 " 3  
 5 " 4  
 6 " 5  
 7 Abutments.  
 8 Pylons.  
 9 Roadway Section and Rail D  
 10 Placing Diagram.  
 11 Reinforced Conc. Retaining

C.H.C. Datum Elev. 700.00

Pier No.	Station
1	543+77.00 (face of abutment)
2	544+72.00
3	545+74.00
4	546+80.00
5	547+82.26
6	548+80.33 (face of abutment)

For GENERAL NOTES on this set of Plans see Sheet No. 10  
 Grading and Paving of Approaches not a part of this contract.  
 Length of piles shown for estimating only. Actual length to be determined by test piles. = 25'

ELEVATION

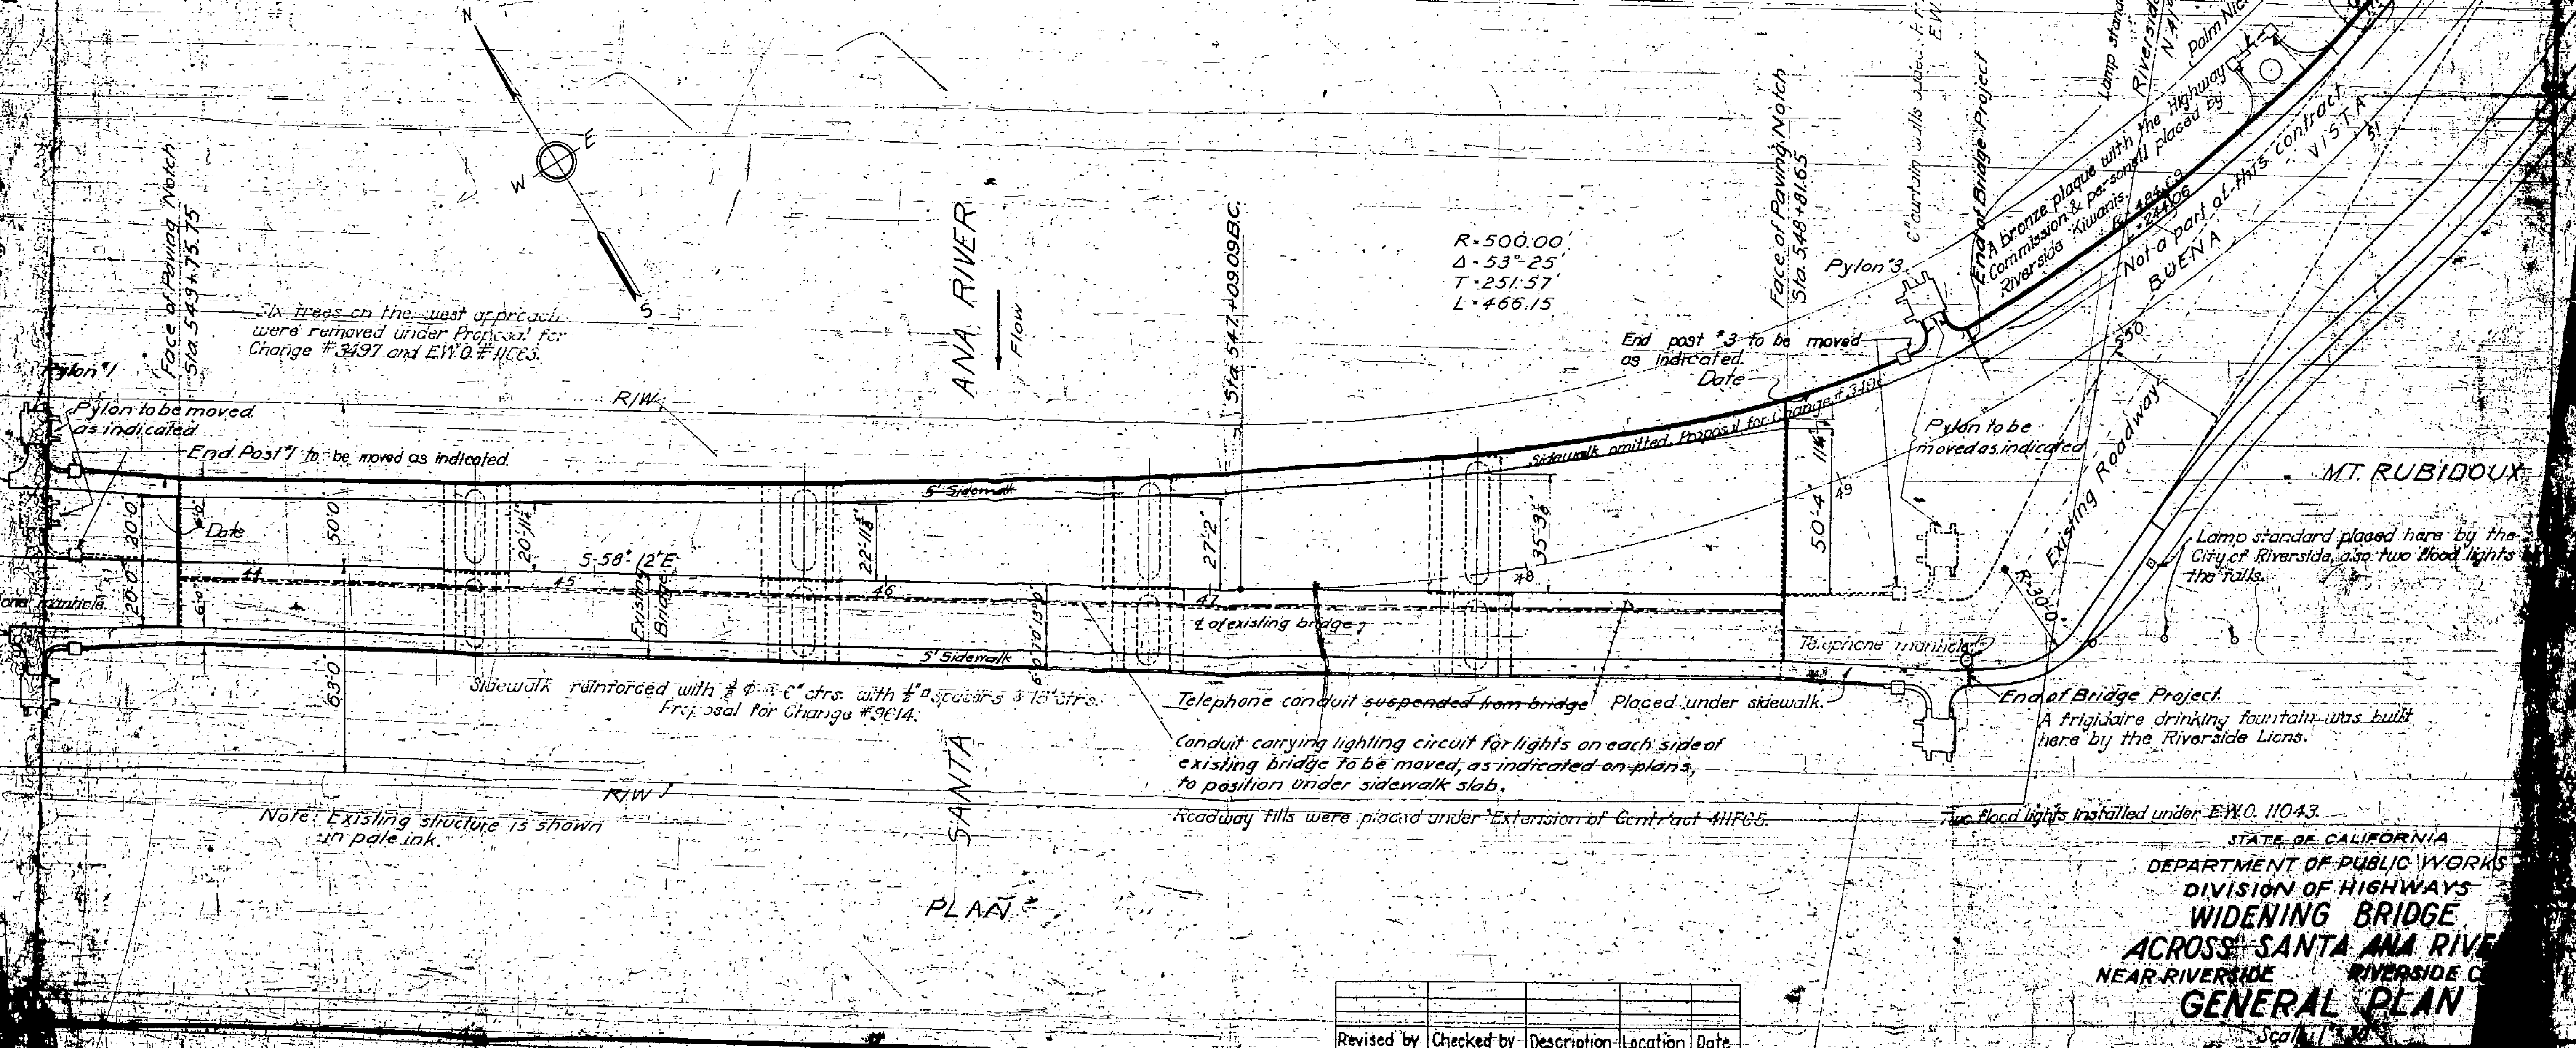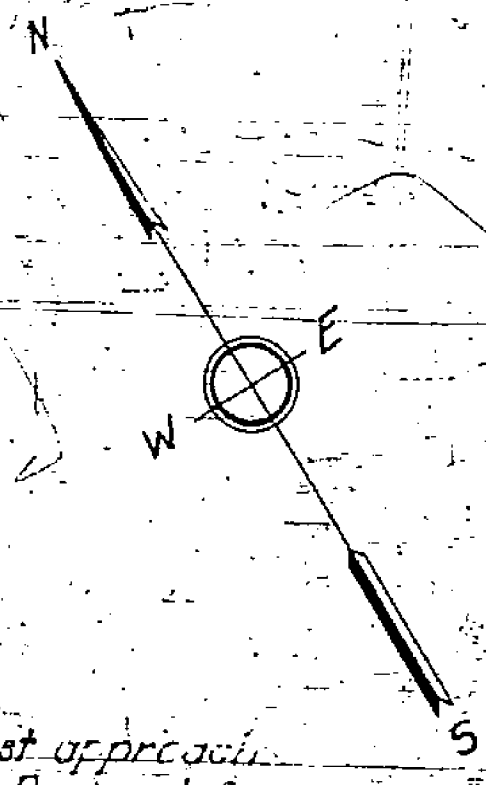

Revised by	Checked by	Description	Location	Date