
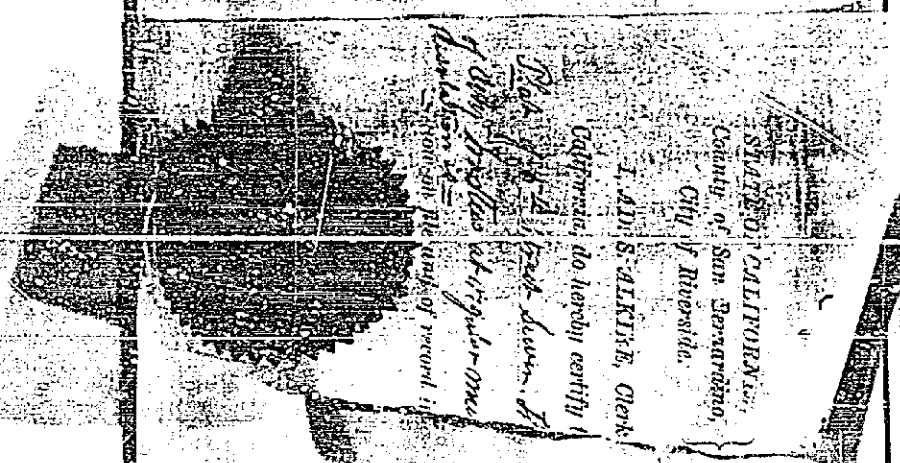


101-V

101

Diagram Exhibiting 1st Street and its intersecting streets from the center line of Market Street to the center line of Union Street in the City of Riverside, which work has been done under my official contract as Chief Surveyor and Chief Engineer of said City, with a plan and map dated the 24th day of October A.D. 1891, for the construction of an eight inch sewer with Manholes and Risers in said City as is more particularly described in said contract showing the relative location of each distinct lot, portion of lot, or parcel of land to the work done; numbers in red ink to correspond with the red ink numbers in the assessments and showing the number of feet fronting assessed for said work contracted for and performed. Herein "No." is used as the contraction of the word "number", and "ft." for the word "feet"; "ft. mark" and "mean" respectively "feet" and "inches"; figures in black ink next to property lines show each the length of said line in feet. Other figures in black ink show the numbers of the lots.

At said City of Riverside this 20th day of January A.D. 1892.  
 James Johnson Surveyor of Streets of the City of Riverside.  
 Recorded Jan 22 1892  
 James Johnson Surveyor of Streets of the City of Riverside.

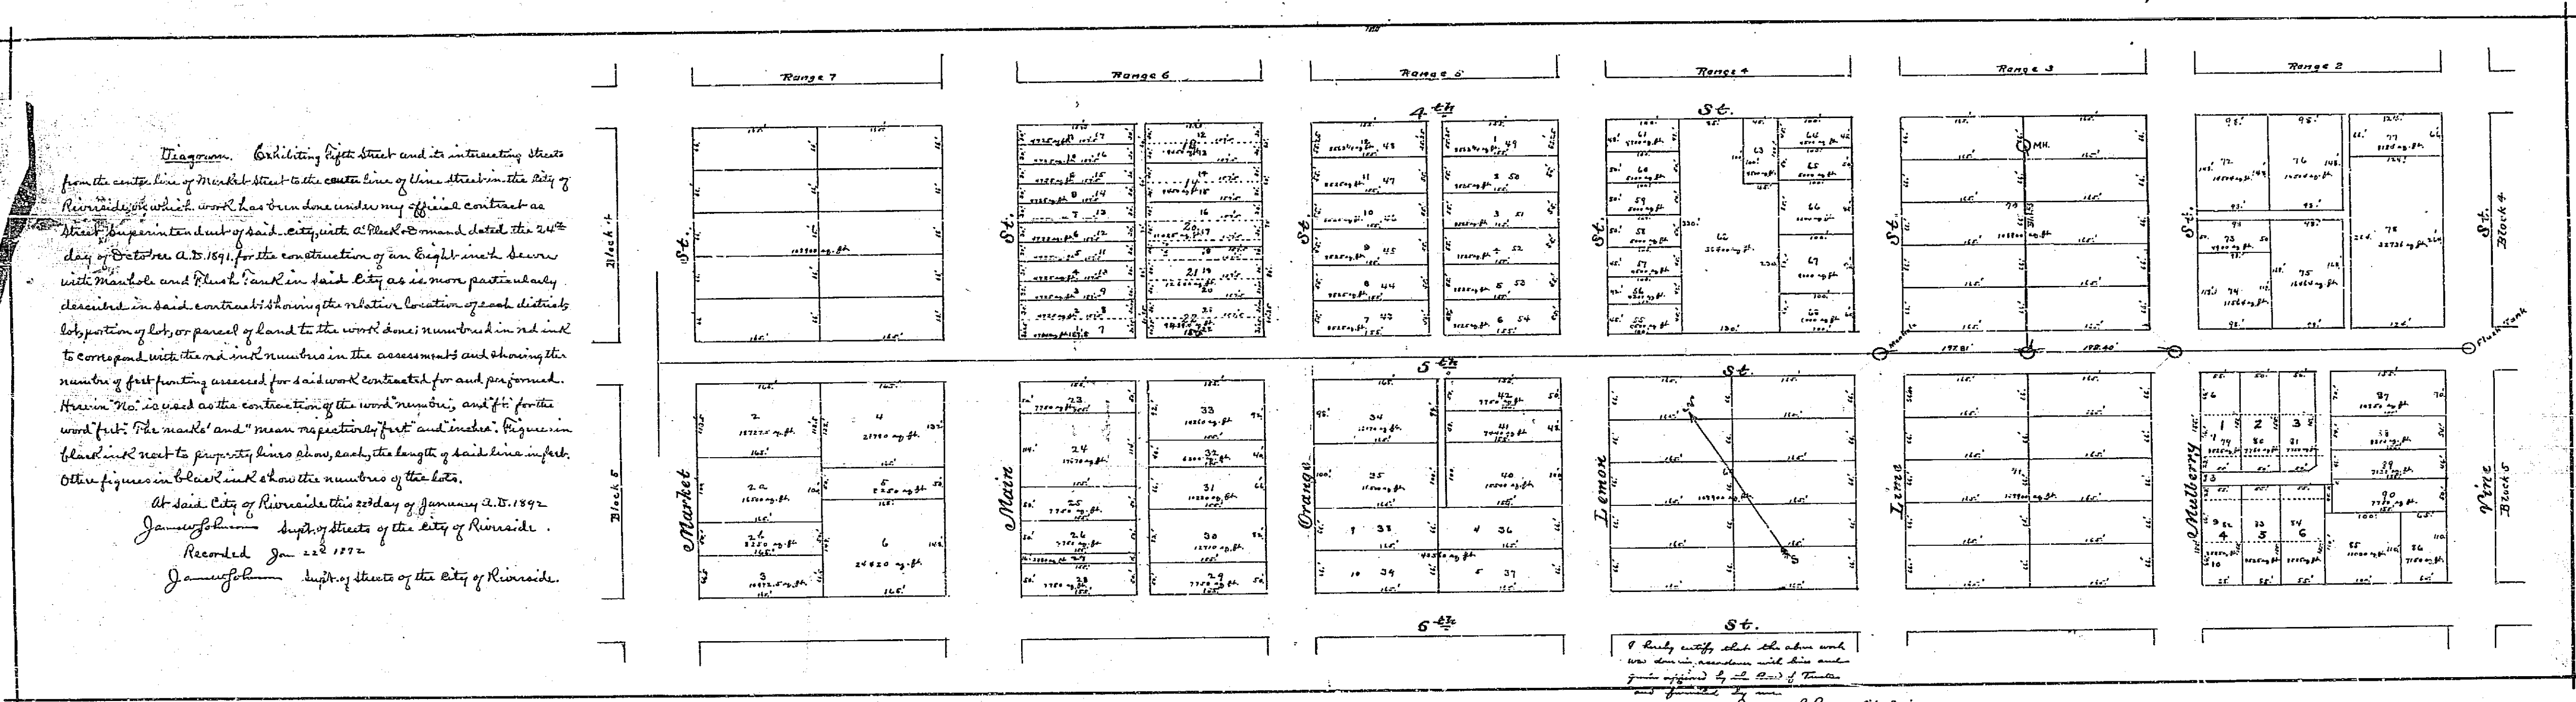

POWERED BY THE  
 CITY OF RIVERSIDE

101-V