

103
 The plan of the sewer
 work in the city of
 Knoxville, Tennessee,
 is hereby approved
 and authorized by the
 Board of Public Works
 of the City of Knoxville,
 this 10th day of
 December, 1891.

105
 105


OS-B

Diagram exhibiting 9th St. and its intersecting streets from the center line of Lemon street to the center line of Mulberry street in the City of Knoxville on which work has been done under my official contract as Street Superintendent of said city, with the Board of Public Works dated the 24th day of October A. D. 1891 for the construction of an eight inch sewer, a flush tank and changing a flush tank to a manhole as is more particularly described in said contract; showing the relative location of each district, lot, portion of lot or parcel of land to the work done; numbered in red ink to correspond with the red ink number in the assessment; and showing the number of feet frontage assessed for said work contracted for and performed. Herein "R." is used as the contraction of the word "number", "ft" for the word "feet" and "sq" for the word "square". The word "man" means feet.

Figures in black ink next to property lines show, each, the length of said line in feet. Other figures in black ink show the number of the lots.


at said City of Knoxville this 23rd day of Dec. A. D. 1891.
 James Johnson
 Superintendent of Streets of the City of Knoxville.

Revised Dec. 23rd 1891.
 James Johnson
 Superintendent of Streets of the City of Knoxville.

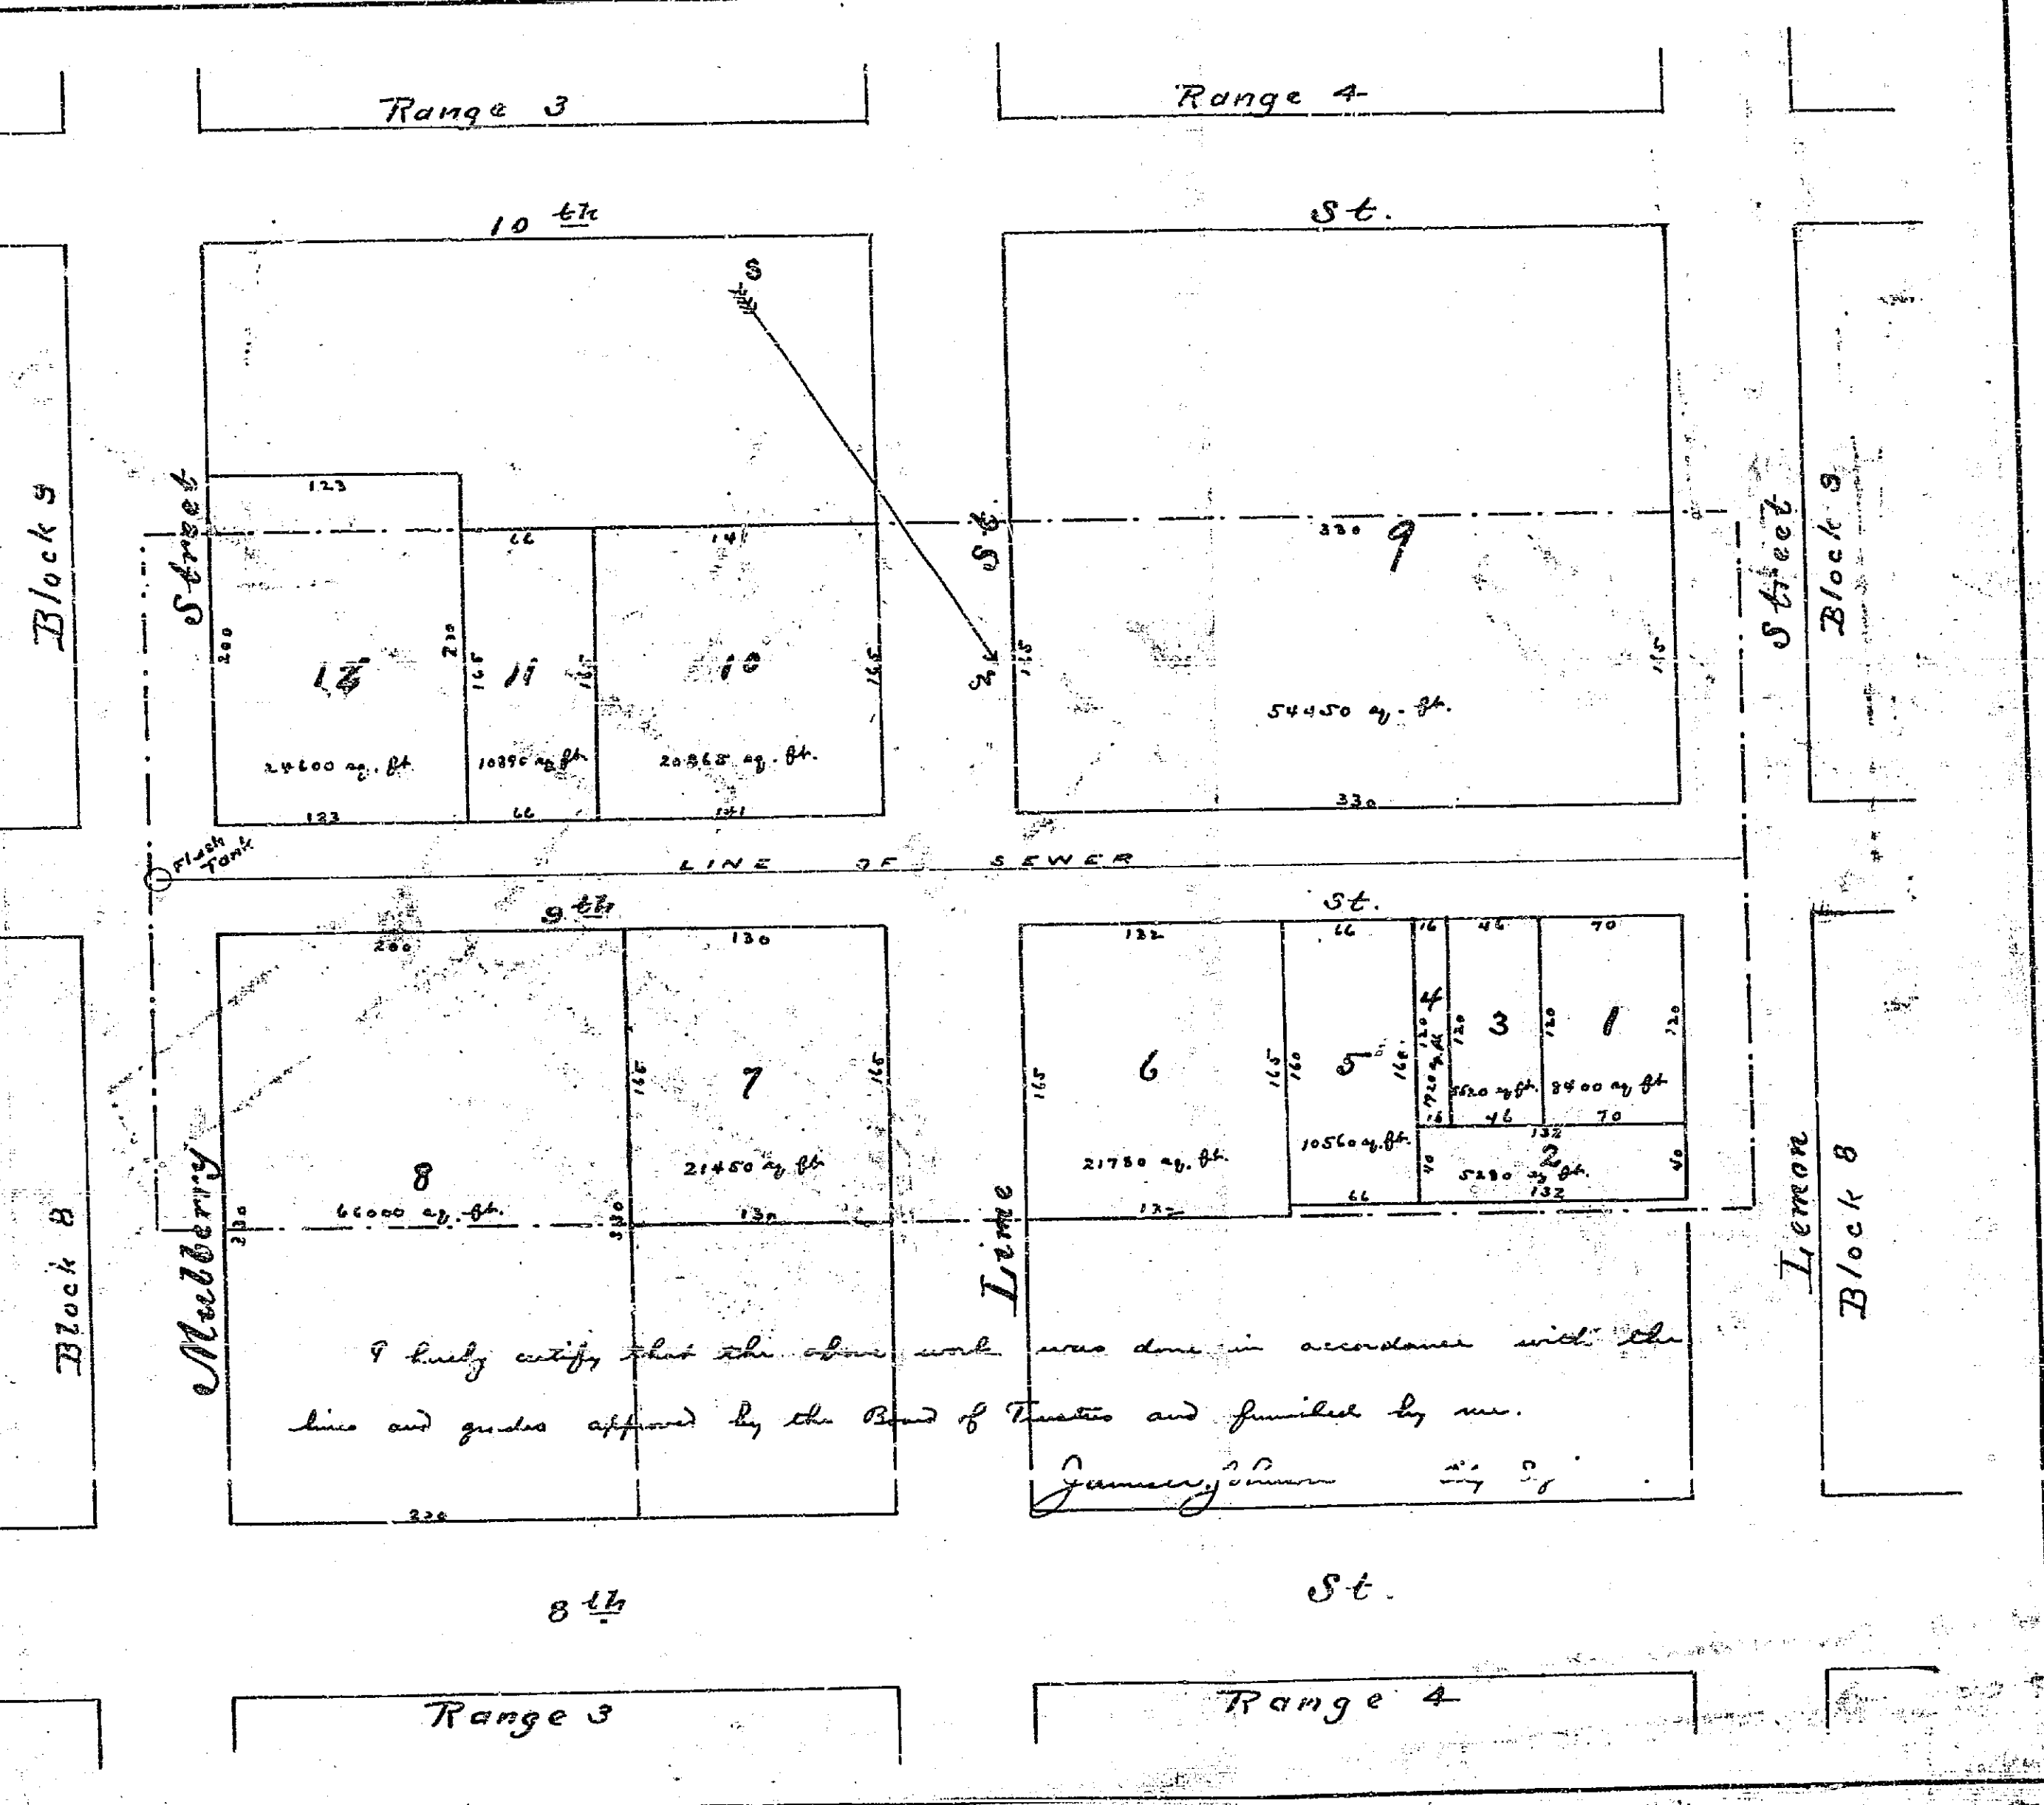

I hereby certify that the above work was done in accordance with the lines and grades approved by the Board of Public Works and furnished by me.
 James Johnson
 City Engineer

State of Tennessee
 County of Sevier
 City of Knoxville
 I, the undersigned, Clerk of the Board of Public Works of the City of Knoxville, do hereby certify that the above is a true and correct copy of the plan of the sewer work in the city of Knoxville, Tennessee, as approved and authorized by the Board of Public Works of the City of Knoxville, this 10th day of December, 1891.

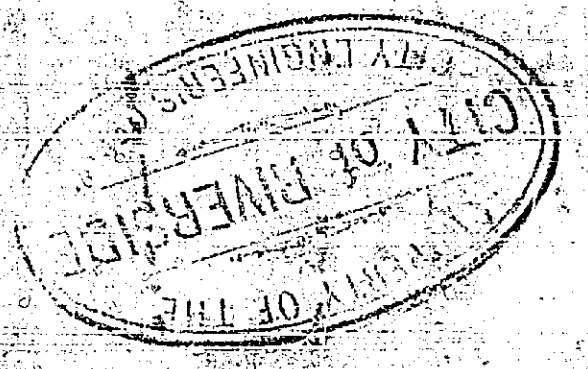

103

102-B