

ASSESSMENT NO. 375

DIAGRAM


EXHIBITING CASA BLANCA SANITARY SEWER DISTRICT

IN THE CITY OF RIVERSIDE ON WHICH WORK HAS BEEN DONE UNDER MY OFFICIAL CONTRACT AS SUPERINTENDENT OF STREETS OF SAID CITY WITH PIPELINE CONSTRUCTION CO. DATED OCTOBER 6 1952 FOR THE CONSTRUCTION OF SANITARY SEWER, HOUSE CONNECTIONS, MANHOLES, CLEANOUTS, WYE BRANCHES, CHIMNEYS, CORRUGATED METAL PIPE AS IS MORE PARTICULARLY DESCRIBED IN SAID CONTRACT TO WHICH REFERENCE IS HEREBY MADE FOR FURTHER PARTICULARS; SAID DIAGRAM ALSO SHOWS THE RELATIVE LOCATION OF EACH LOT, PORTION OF LOT, PIECE OR PARCEL OF LAND ASSESSED FOR THE WORK DONE NUMBERED IN CIRCLES TO CORRESPOND TO THE RED INK NUMBERS IN THE ASSESSMENT HEREIN FIGURED NEXT TO PROPERTY LINES SHOW LENGTH OF SAID LINES IN FEET. THE MARK (C) MEANS FEET PROPERTY LINES THAT DIFFER FROM THE RECORDED SUBDIVISIONS ARE SHOWN BY BROKEN LINES. THE DISTRICT BENEFITED IS BOUNDED BY A HEAVY DASHED LINE.

PROPERTY COVERED BY THIS ASSESSMENT IS SHOWN ON THE FOLLOWING RECORDED MAPS:

- ORANGE ACRES M.B. 13, PG. 7, REC. RIV. CO.
- W.T. SAYWARD & S.C. EVANS TRACT M.B. 3, PG. 2, REC. S.B. CO.
- MADISON PARK M.B. 14, PG. 82, 83, REC. RIV. CO.
- RL & I. CO. LANDS M.B. 1, PG. 70, REC. S.B. CO.
- WALNUT GROVE TRACT M.B. 23, PG. 49, REC. RIV. CO.
- SANTA MARGARITA HEIGHTS M.B. 17, PG. 53, REC. RIV. CO.
- ST. FRANCIS ANNEZ M.B. 12, PG. 93, REC. RIV. CO.
- ST. FRANCIS ANNEZ NO. 2 M.B. 16, PG. 4, REC. RIV. CO.
- CASA BLANCA HEIGHTS M.B. 5, PG. 117, REC. RIV. CO.
- VILLAGE OF CASA BLANCA M.B. 9, PG. 21, REC. S.B. CO.
- SURPLUS ADDITION M.B. 4, PG. 96, REC. RIV. CO.
- P.T. EVANS ADDITION M.B. 2, PG. 44, REC. RIV. CO.
- WALNUT PARK ADDITION M.B. 10, PG. 50, REC. RIV. CO.
- MONTEREY SUBDIVISION M.B. 12, PG. 24, REC. RIV. CO.
- ST. FRANCIS HEIGHTS M.B. 11, PG. 41, REC. RIV. CO.
- FREDA SUBDIVISION M.B. 10, PG. 20, REC. RIV. CO.
- EL GRANDE TRACT M.B. 5, PG. 174, REC. RIV. CO.
- RICCA ADDITION M.B. 12, PG. 15, REC. RIV. CO.
- VICTORIA ADDITION M.B. 5, PG. 132, REC. RIV. CO.

HEREIN THE LEGEND OF THE DIFFERENT KINDS OF WORK PERFORMED IS SHOWN AS FOLLOWS:

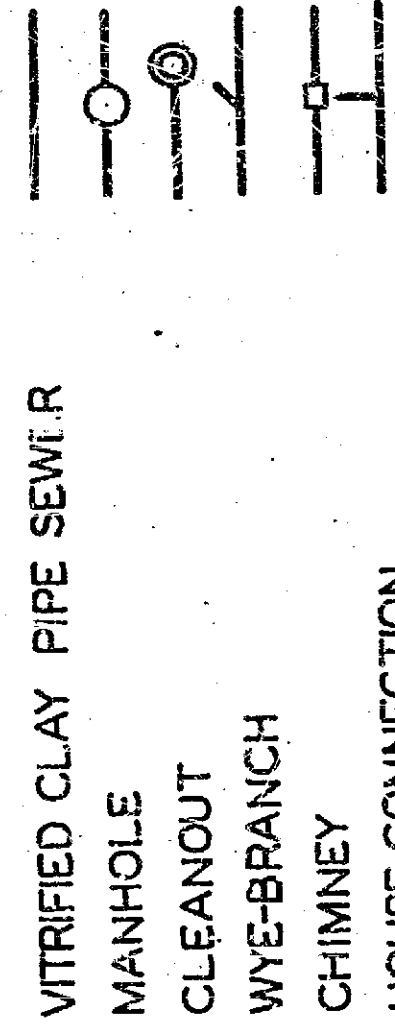

I HEREBY CERTIFY THAT THIS ASSESSMENT DIAGRAM WAS APPROVED BY THE CITY COUNCIL OF THE CITY OF RIVERSIDE AT A MEETING THEREOF HELD ON THE DAY OF 19

CITY CLERK OF THE CITY OF RIVERSIDE.

SUPERINTENDENT OF STREETS OF THE CITY OF RIVERSIDE THE FOLLOWING IS A STATEMENT OF AMOUNTS OF DIFFERENT KINDS OF WORK DONE BY PIPELINE UNDER

CONSTRUCTION CO. 1952 PURSUANT TO CONTRACT DATED OCTOBER 6 1952 ADOPTED BY THE RESOLUTION OF INTENTION NO 5347 OF THE CITY COUNCIL OF THE CITY OF RIVERSIDE ON THE 24 TH DAY OF JUNE 1952

4" VITRIFIED CLAY PIPE HOUSE CONNECTIONS	101 1/2 LIN. FT.
8" STD. STR. VITRIFIED CLAY PIPE SEWER	26,193.31 LIN. FT.
8" EXTRA STR. VITRIFIED CLAY PIPE SEWER	29.45 LIN. FT.
10" STD. STR. VITRIFIED CLAY PIPE SEWER	1,941.01 LIN. FT.
10" EXTRA STR. VITRIFIED CLAY PIPE SEWER	1,993.53 LIN. FT.
12" STD. STR. VITRIFIED CLAY PIPE SEWER	52.98 LIN. FT.
12" EXTRA STR. VITRIFIED CLAY PIPE SEWER	625.51 LIN. FT.
STD. MANHOLES	109
DROP MANHOLES	4
STD. CLEANOUTS	9
8x4" VITRIFIED CLAY WYE BRANCHES	767
10x4" VITRIFIED CLAY WYE BRANCHES	45
12x4" VITRIFIED CLAY WYE BRANCHES	16
6" VITRIFIED CLAY PIPE CHIMNEYS	233 LIN. FT.
24" 12-GAUGE CORRUGATED METAL PIPE	92 LIN. FT.
36" 12-GAUGE CORRUGATED METAL PIPE	24 LIN. FT.
54" 12-GAUGE CORRUGATED METAL PIPE	90 LIN. FT.
RECONSTRUCTING DROP MANHOLE SAND (EXTRA ITEM)	39.47 CU. YDS.

AT SAID CITY OF RIVERSIDE: THIS DAY OF

SUPERINTENDENT OF STREETS OF THE CITY OF RIVERSIDE.

I HEREBY CERTIFY THAT THE ABOVE WORK WAS DONE IN ACCORDANCE WITH LINES AND GRADES FURNISHED BY ME AND THAT THE DIAGRAM OF THE ASSESSMENT DISTRICT FOR THE SAME IS CORRECT.

CITY ENGINEER OF THE CITY OF RIVERSIDE.

RECORDED AT 8 10 O'CLOCK A.M. THIS 2ND DAY OF SEPTEMBER 1953

SUPERINTENDENT OF STREETS OF THE CITY OF RIVERSIDE.

1083