

**LEGEND**


1. Approximate Existing Ground Before Fill shown thus
2. Approximate Existing Ground as of January 1961 shown thus
3. Contour Interval Original Ground = 1'
4. Contour Interval Existing Fills = 2'-0"
5. Contours Compiled by Field notes - EG. NO. 420, 329 and 624
6. Planimetric Details Compiled from Plan No. 1264 and 1580

**FILLED AREAS ENCLOSED BY THE FOLLOWING**

- △ - GRAVEL
- - SAND
- - CLAY
- ◇ - SILT
- ◇ - COARSE SAND
- ◇ - FINE SAND
- ◇ - SILT
- ◇ - CLAY
- ◇ - GRAVEL

1087A

REVISIONS	CITY OF A
APPROVED BY	DEPARTMENT
<b>SANITARY FILL</b>	
CONDITIONS AS OF JANUARY 3, 1961	
SCALE 1"=40'	
APPROVED BY	1084-4

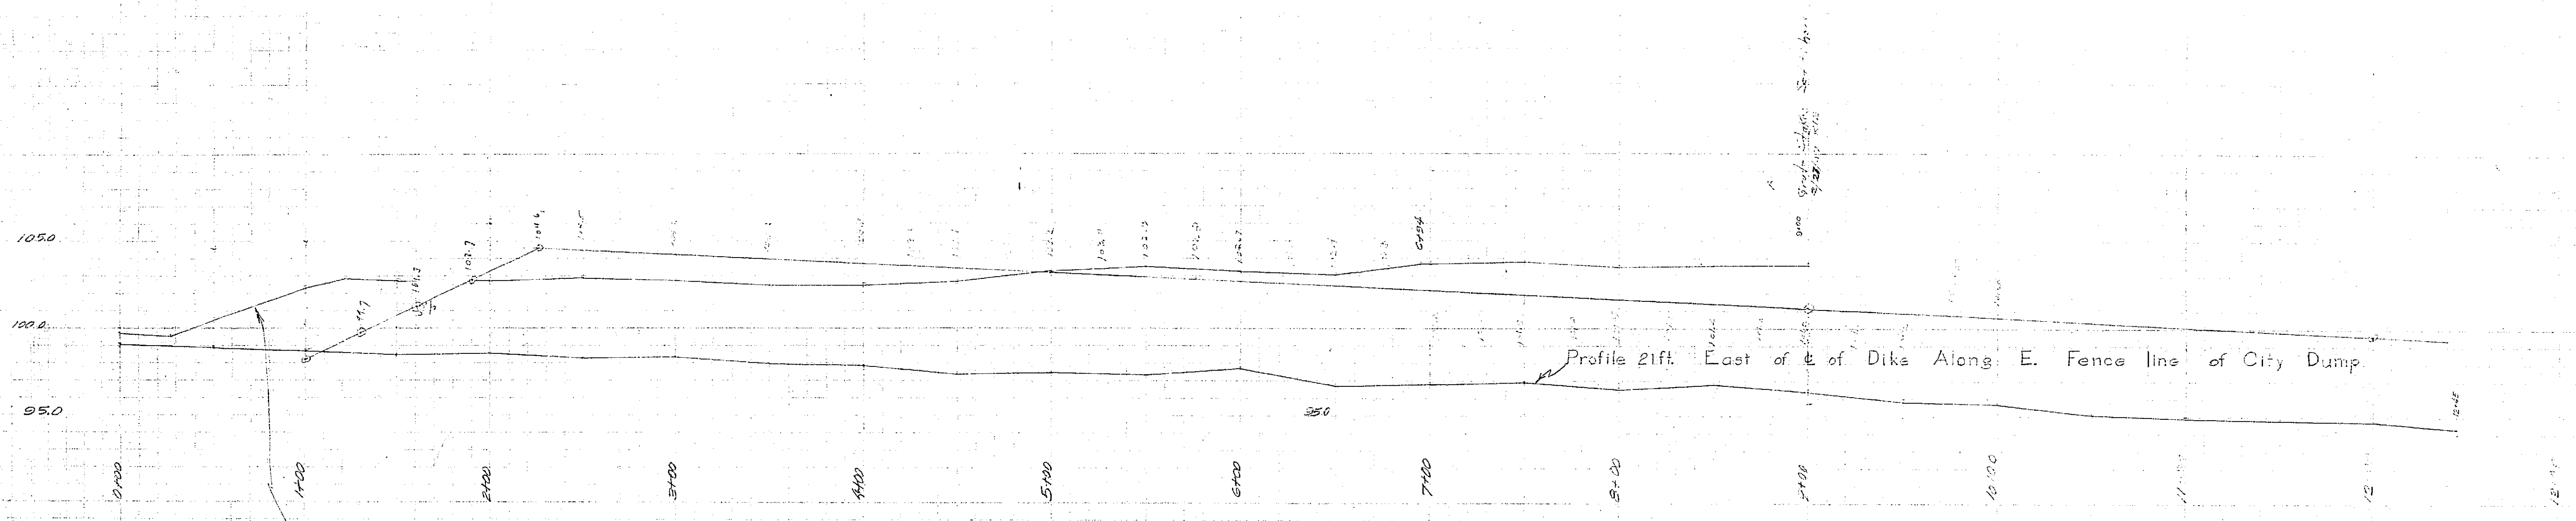

© Profile of dike along E. fence line of City Dump  
 FB/1420 2/17/47 etc.

10847A