


1084-B
 No. ~~552-B~~
 PLAT OF EAST EDGE OF
 SANITARY FILL
 SHOWING RELATION OF FILL
 TO NATURAL GROUND
 FB. 920 '53 AUG. 1951
 SCALES HOR. 1 IN. = 100 FT.
 VERT. 1 IN. = 4 FT.

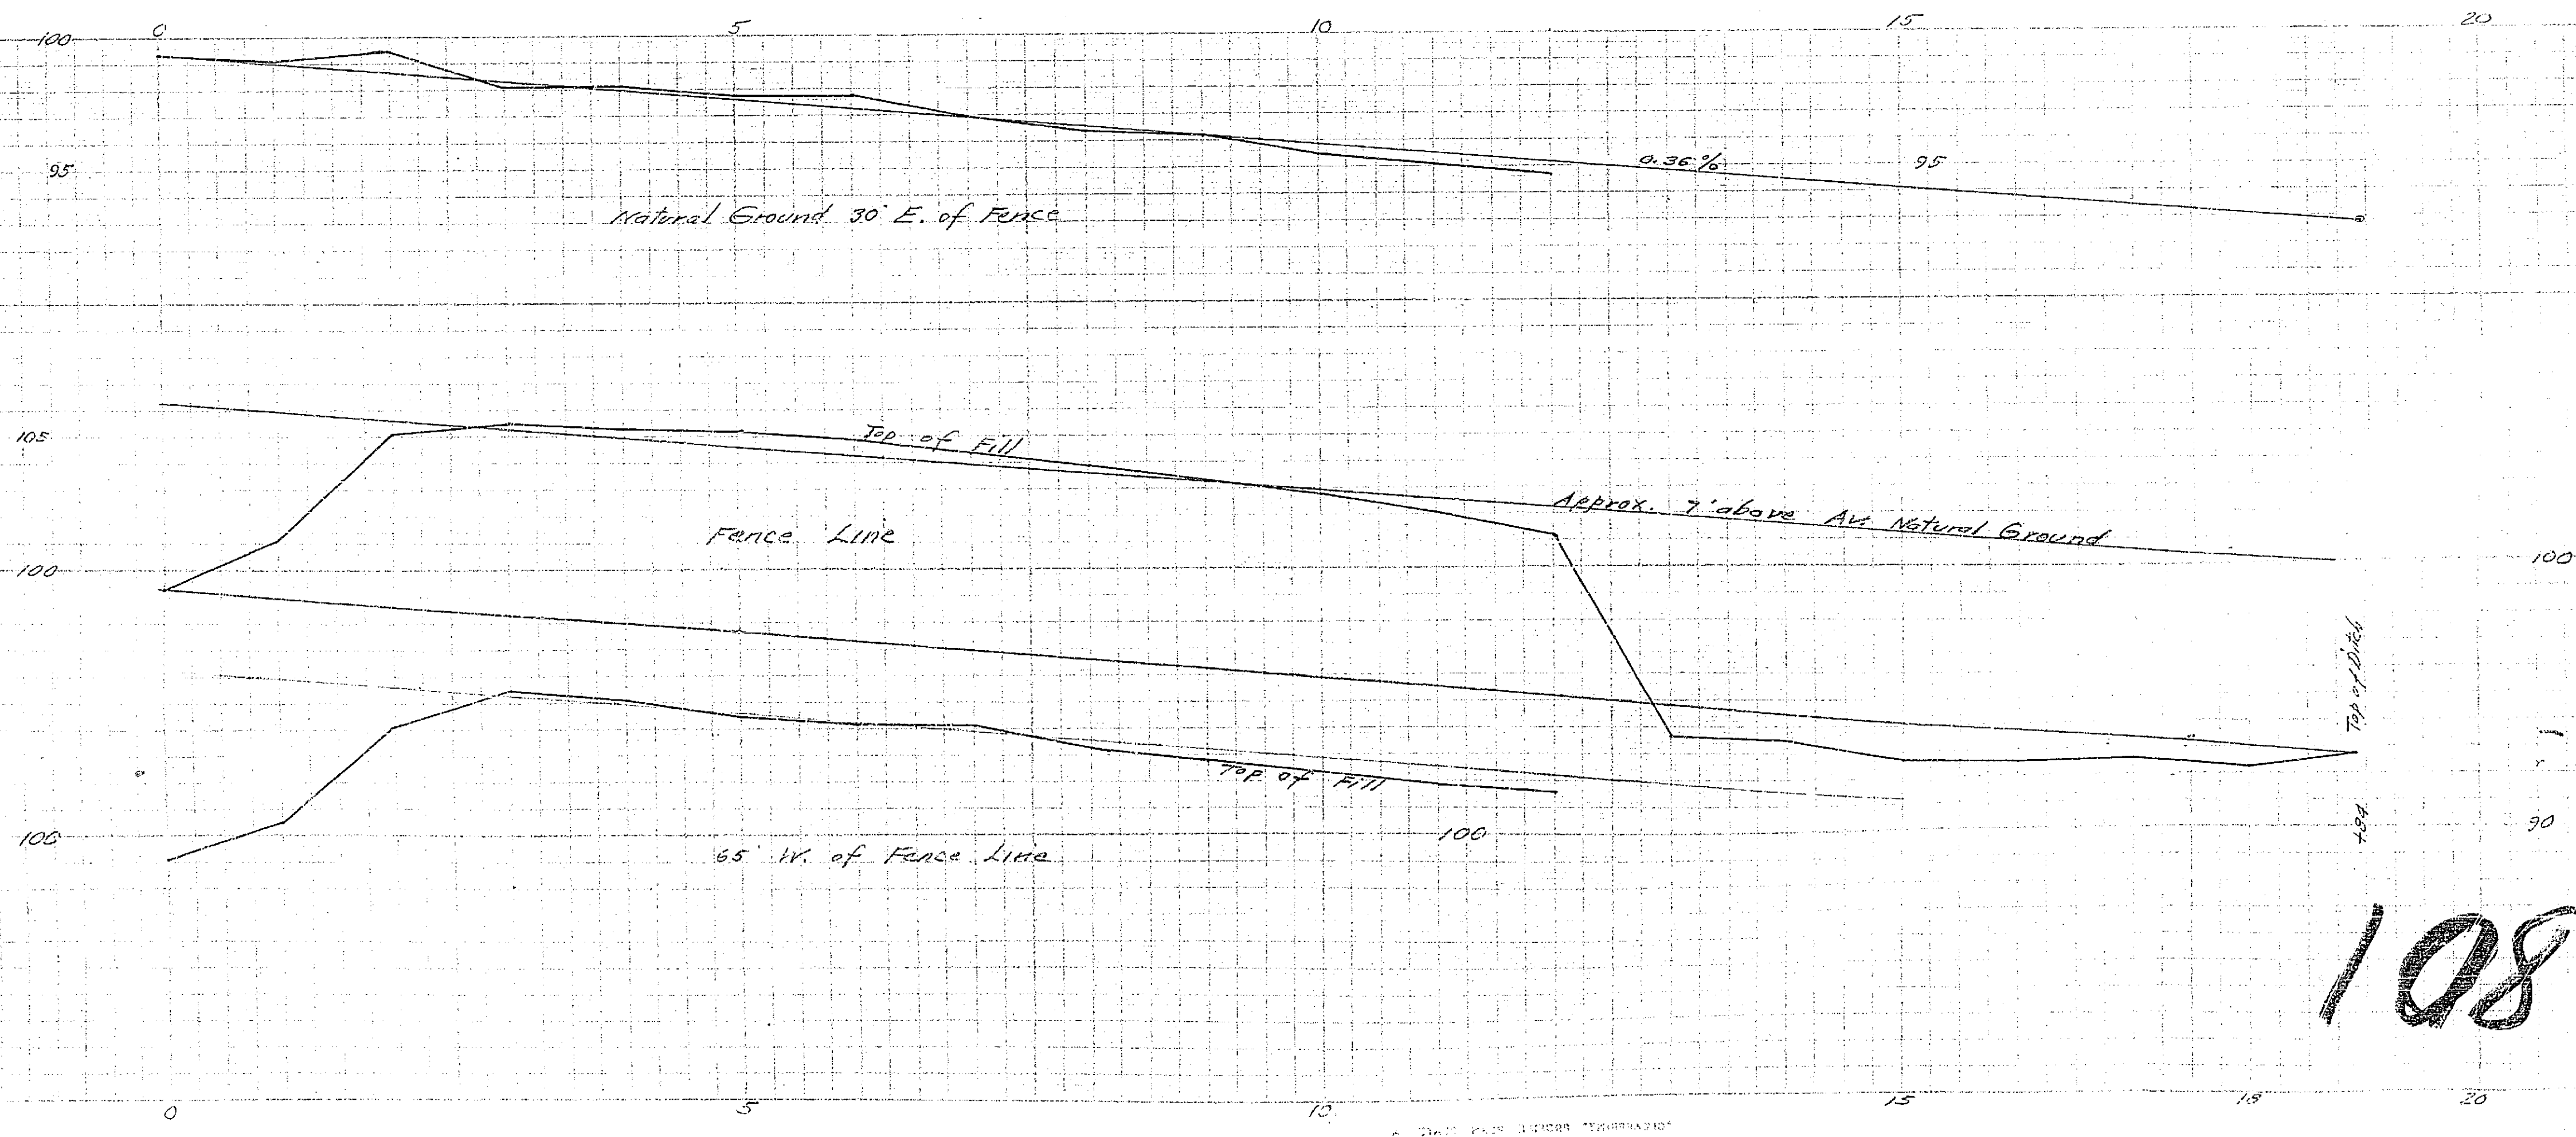

1084B