

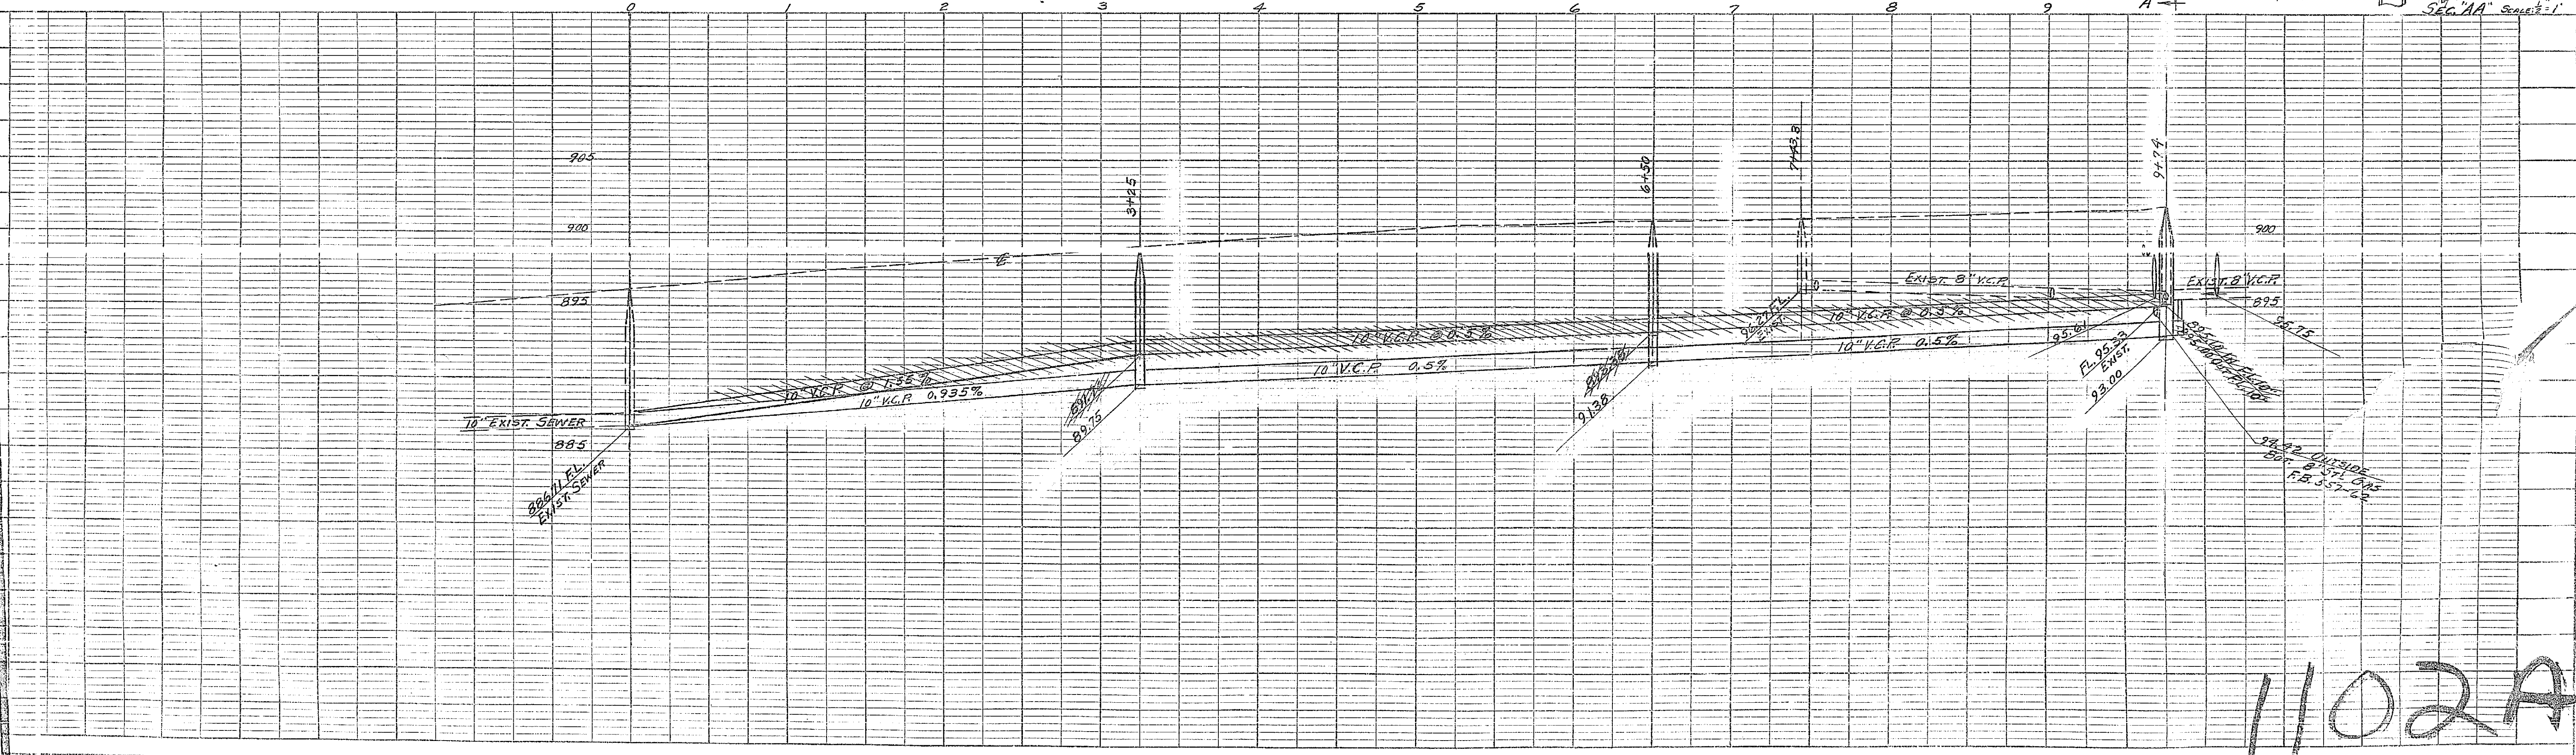


NOTE: SHADED AREAS NOT CONSTRUCTED


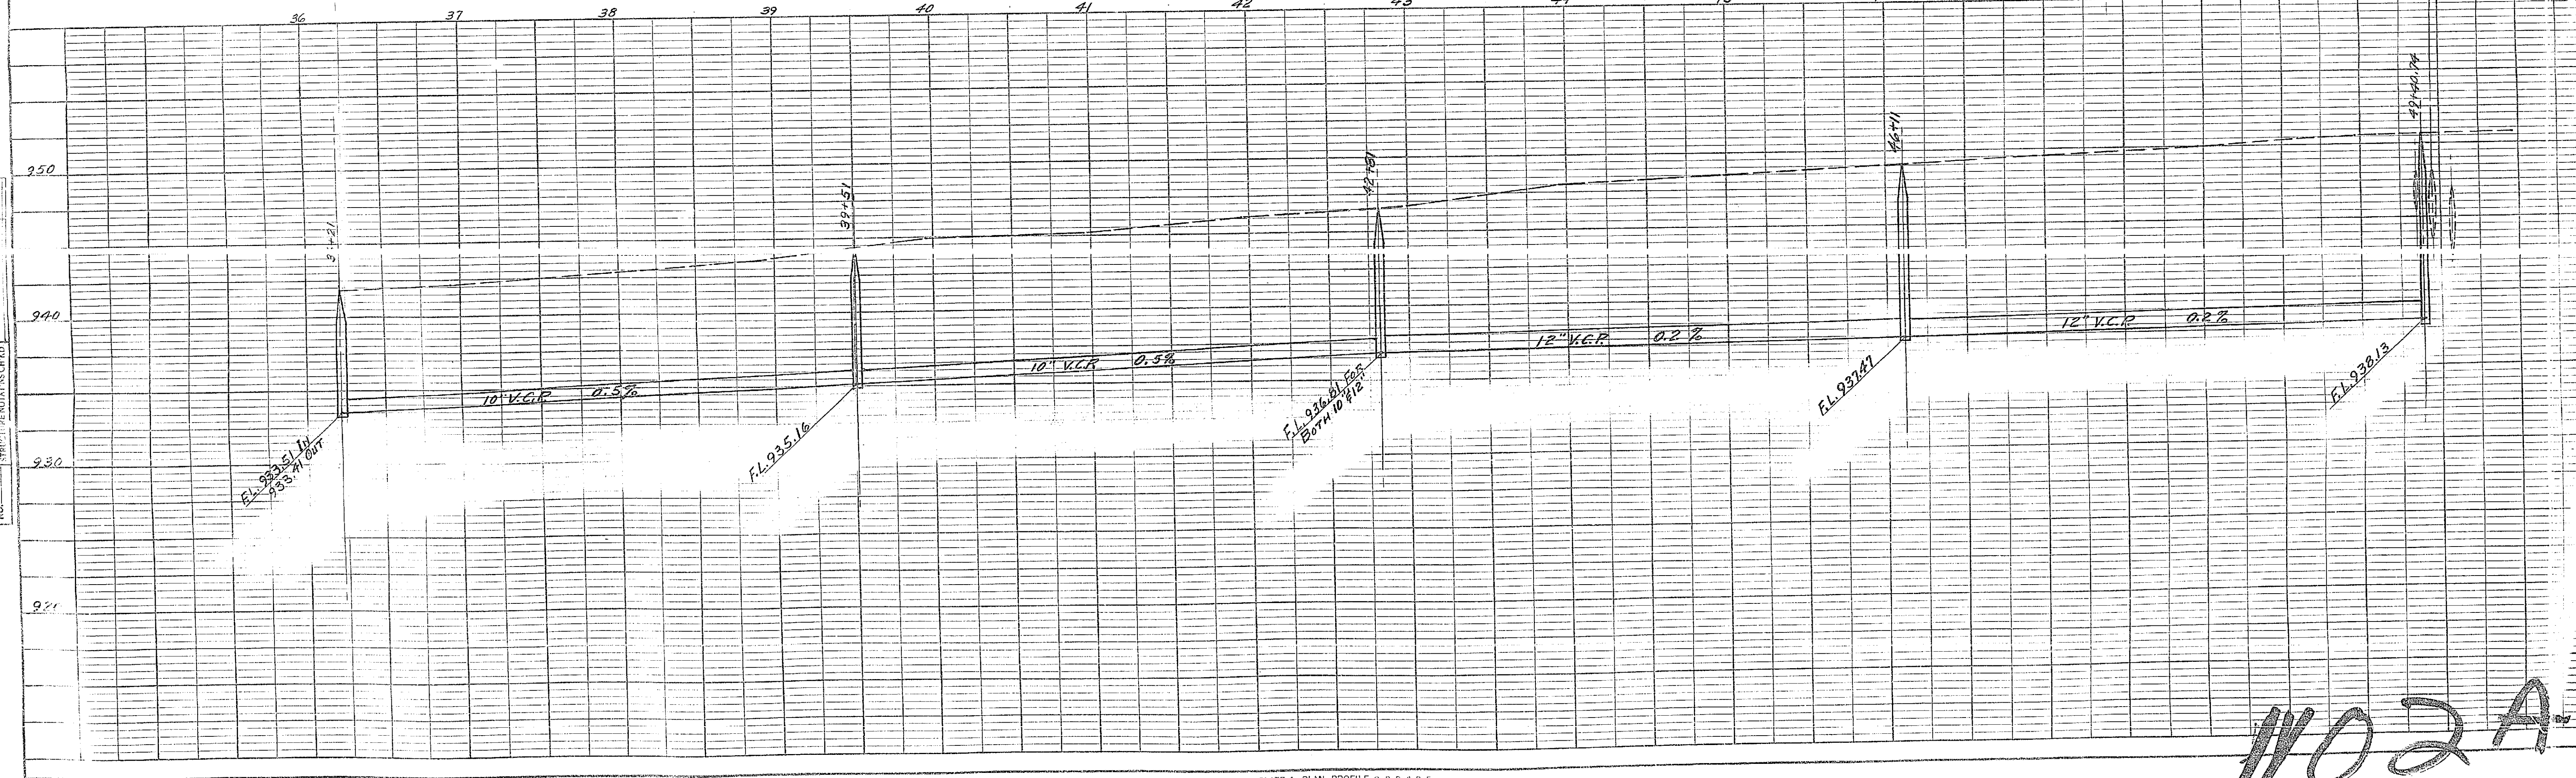


1102A



SCALES: HOR. 1" = 50'  
VER. 1" = 5'

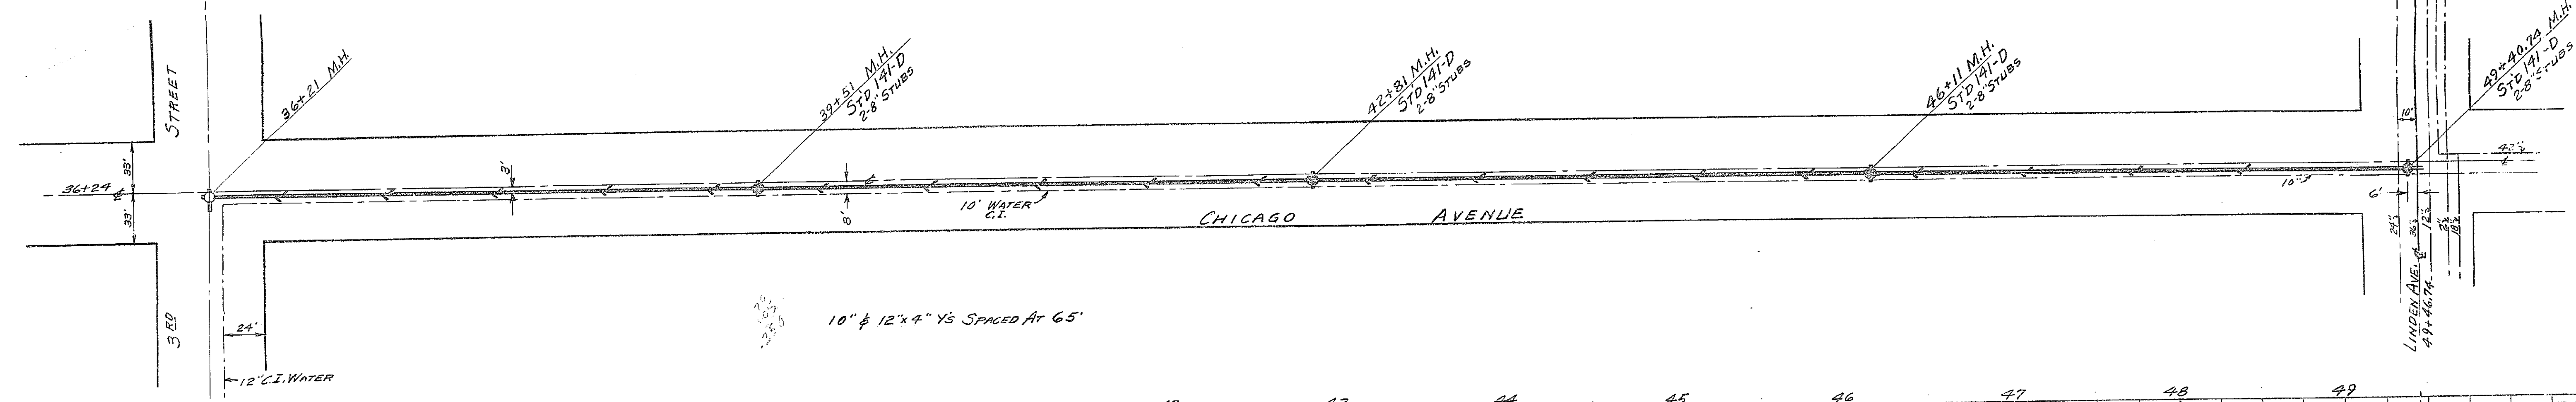

1102A

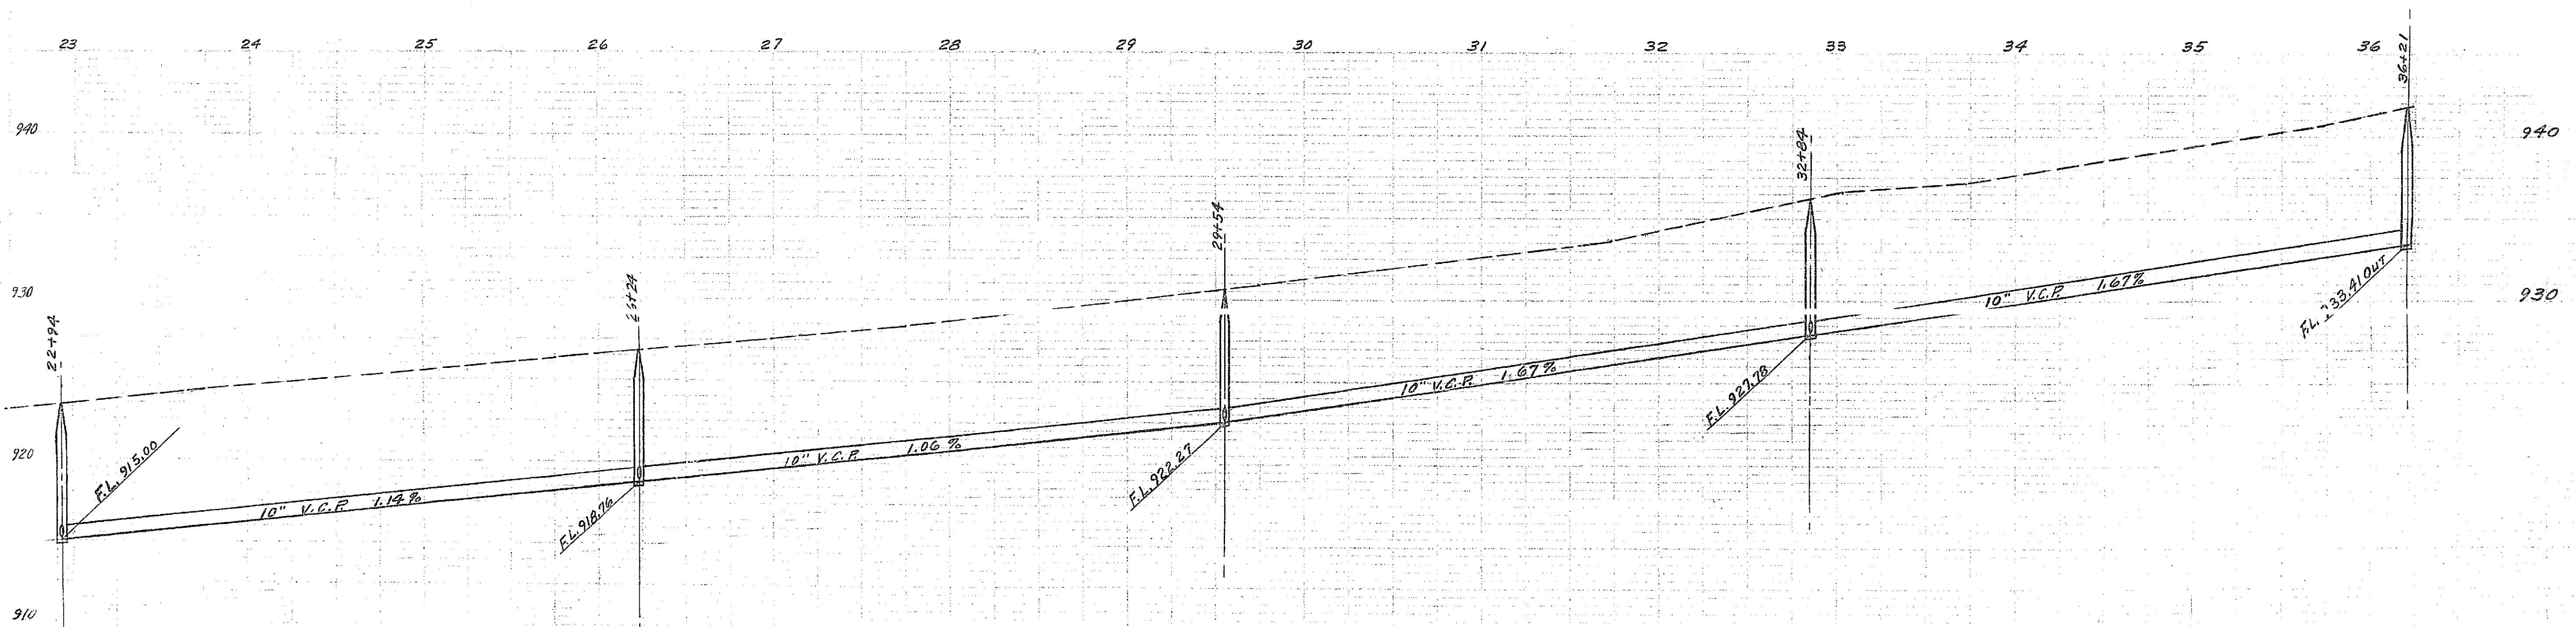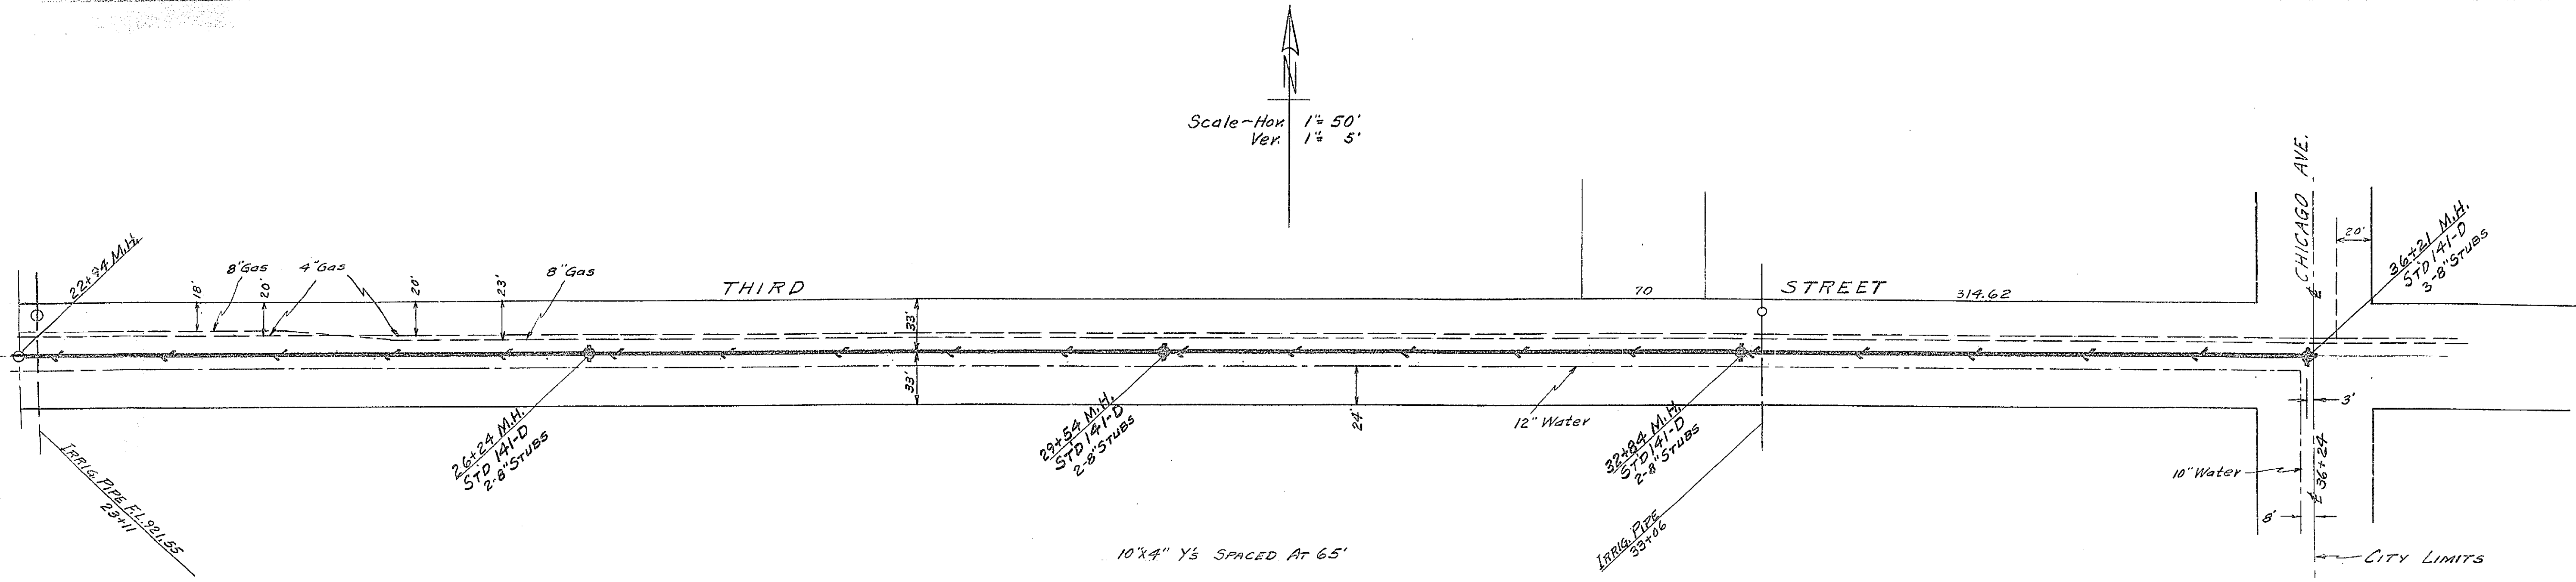

1102A


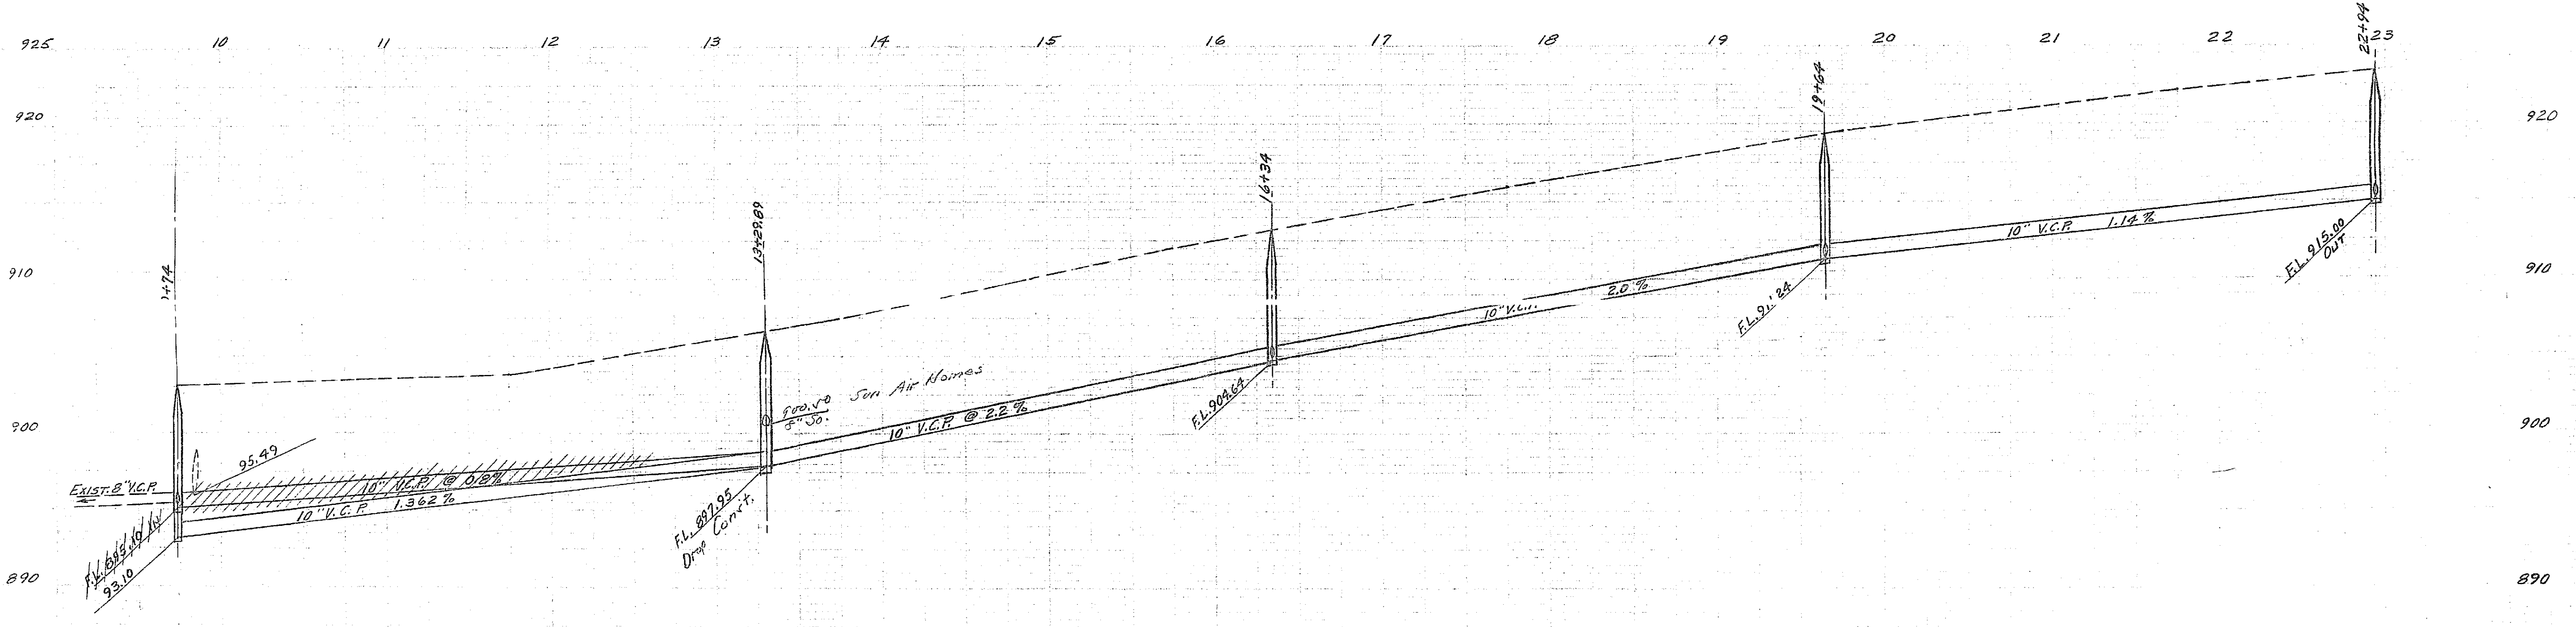
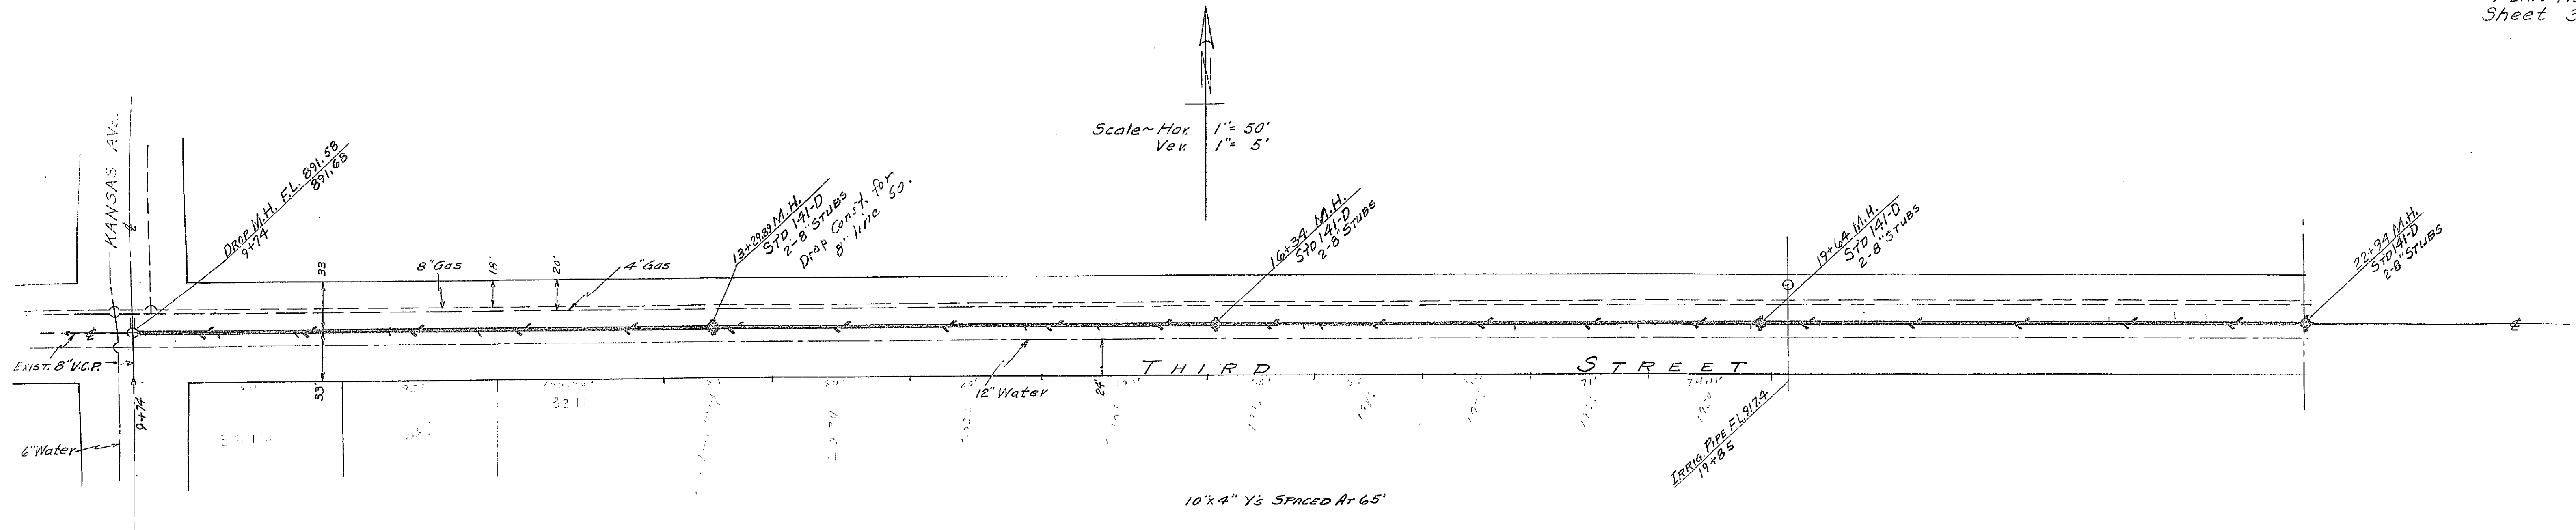


1102A

INDEX SHEET TO  
PLAN NO. 1102-A  
FOR THE CONSTRUCTION OF  
**CHICAGO AVE. RELIEF SEWER**  
CONNECTING SEWER AT 8th St. - E. CHICAGO TO  
SEWER ON KANSAS AVE. NEAR MASSACHUSETTS  
RIVERSIDE, CALIFORNIA  
DEC 1954 SCALE 1" = 20'




APPROVED: *M. H. Swinn*  
M. H. Swinn, P.E., C.E.  
CITY ENGINEER  
RIVERSIDE, CALIFORNIA  
FB 557-39

Sheet 6

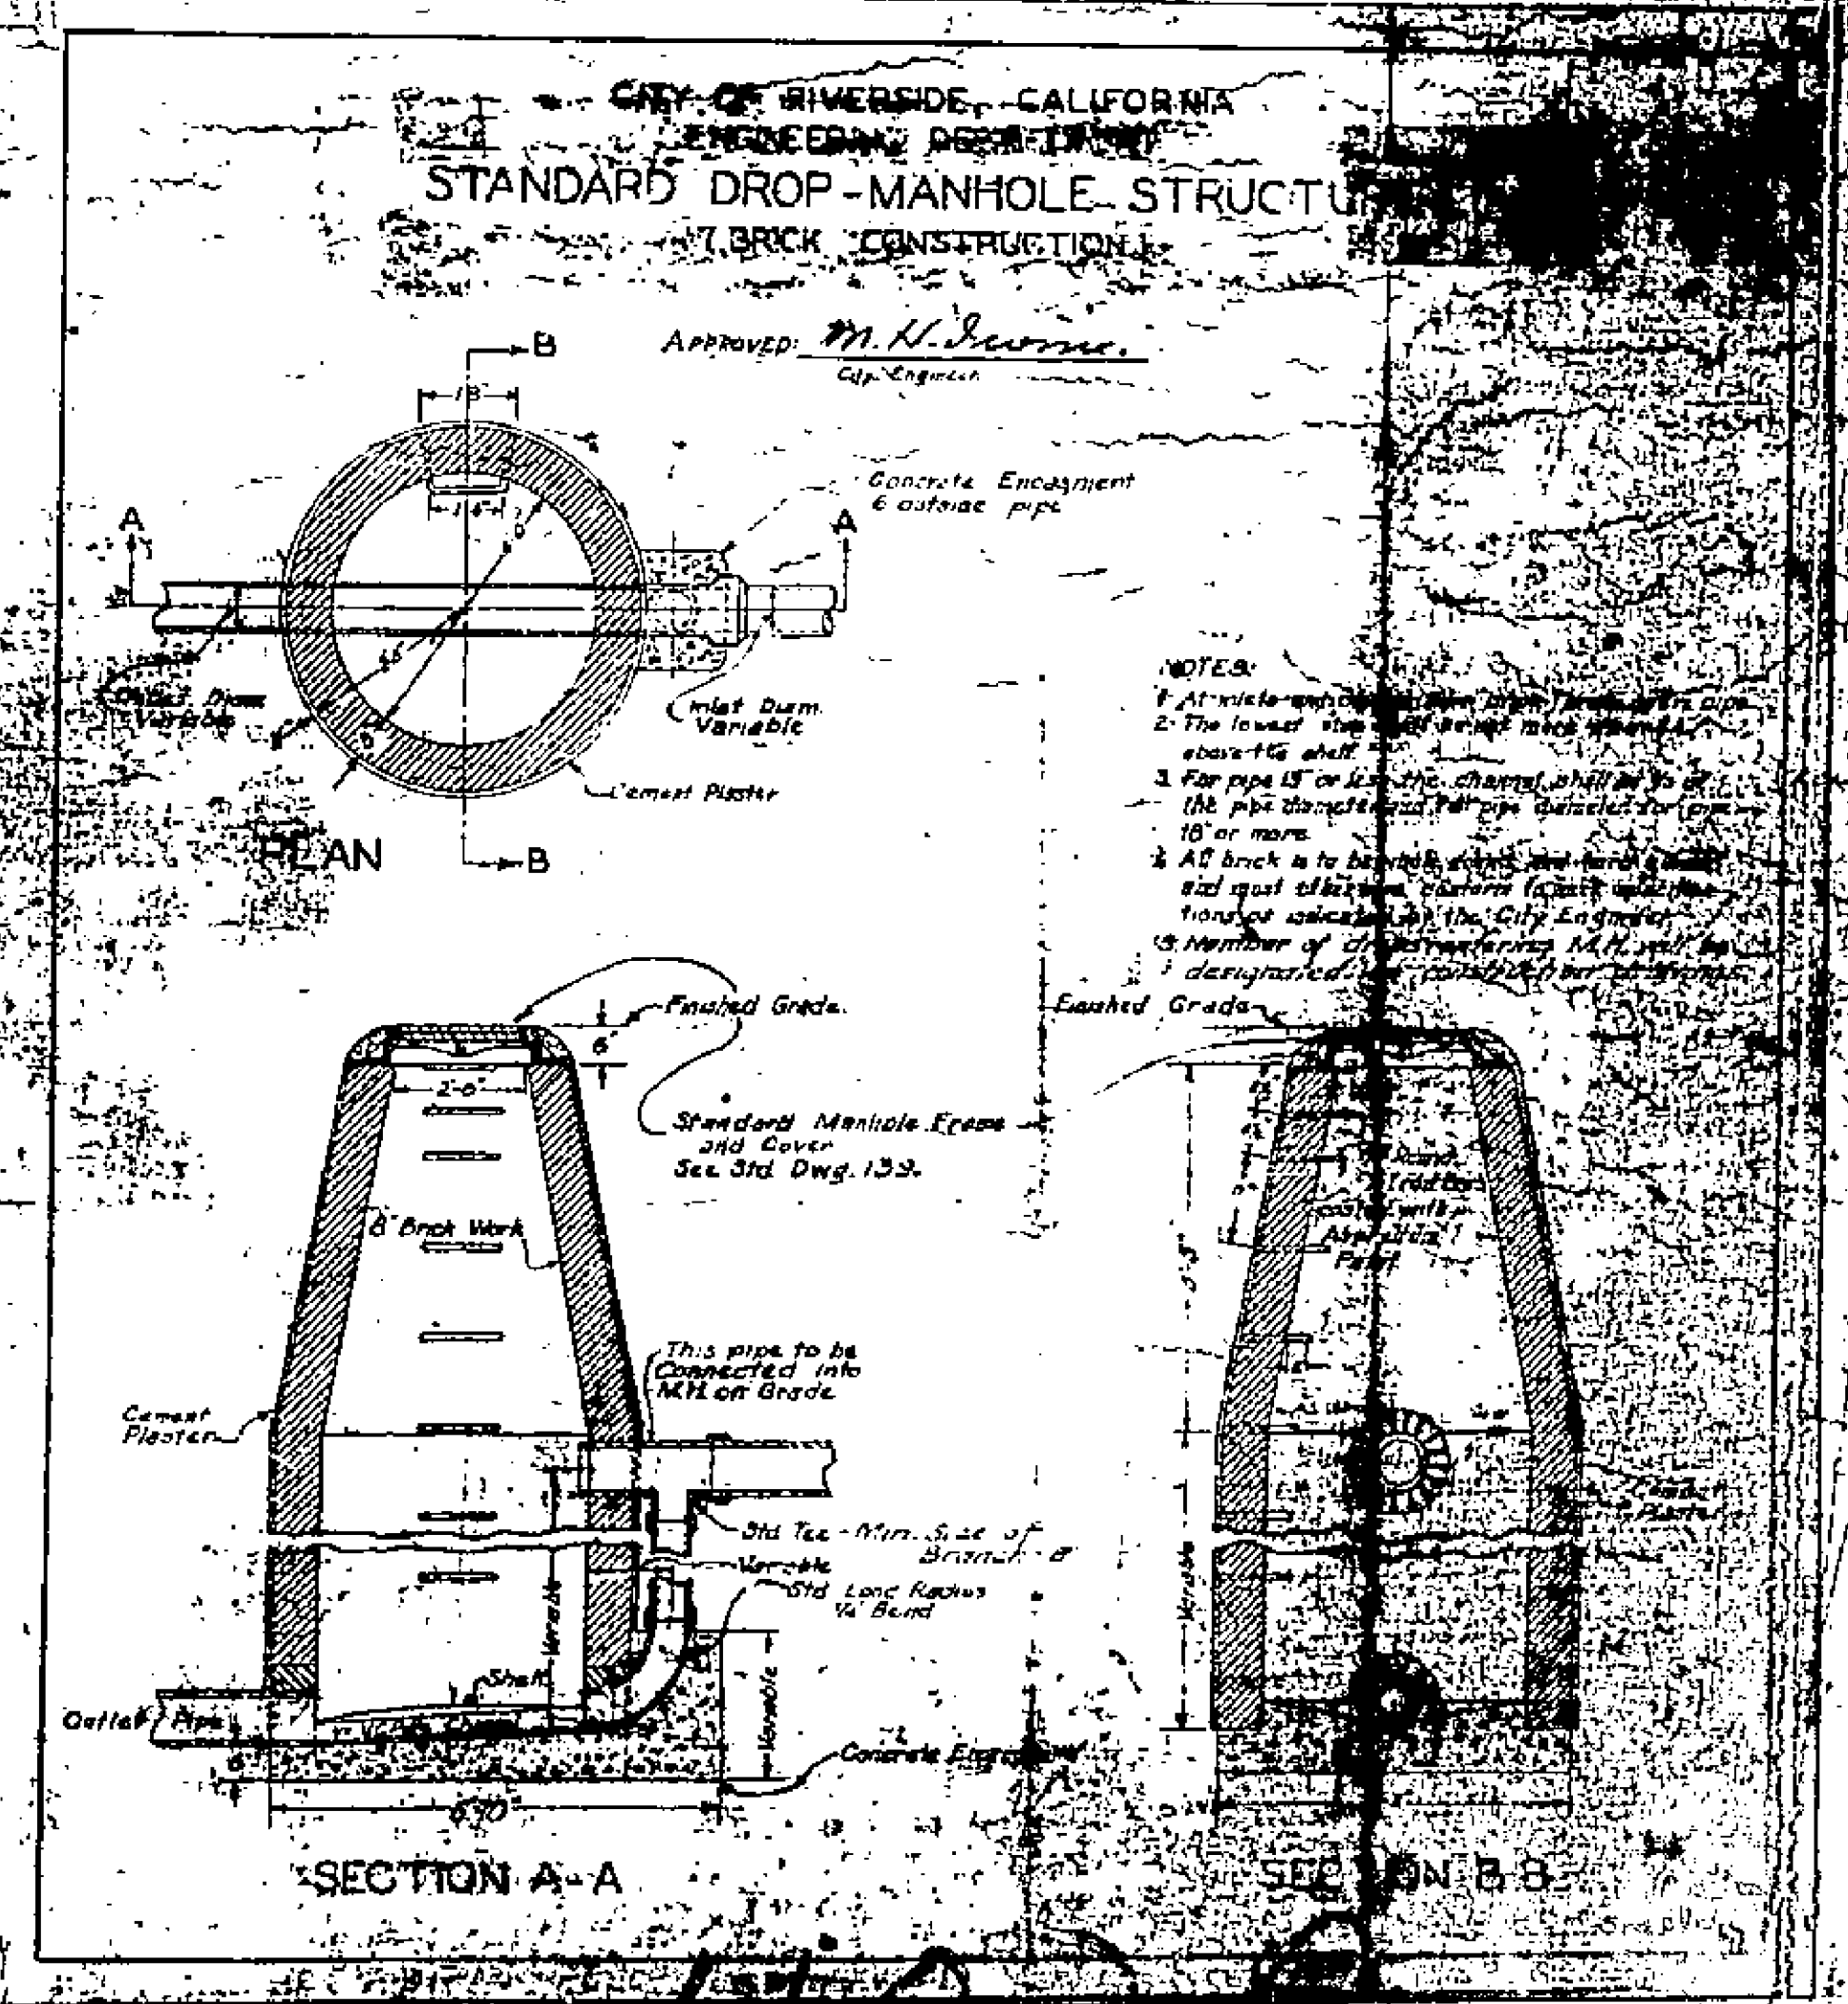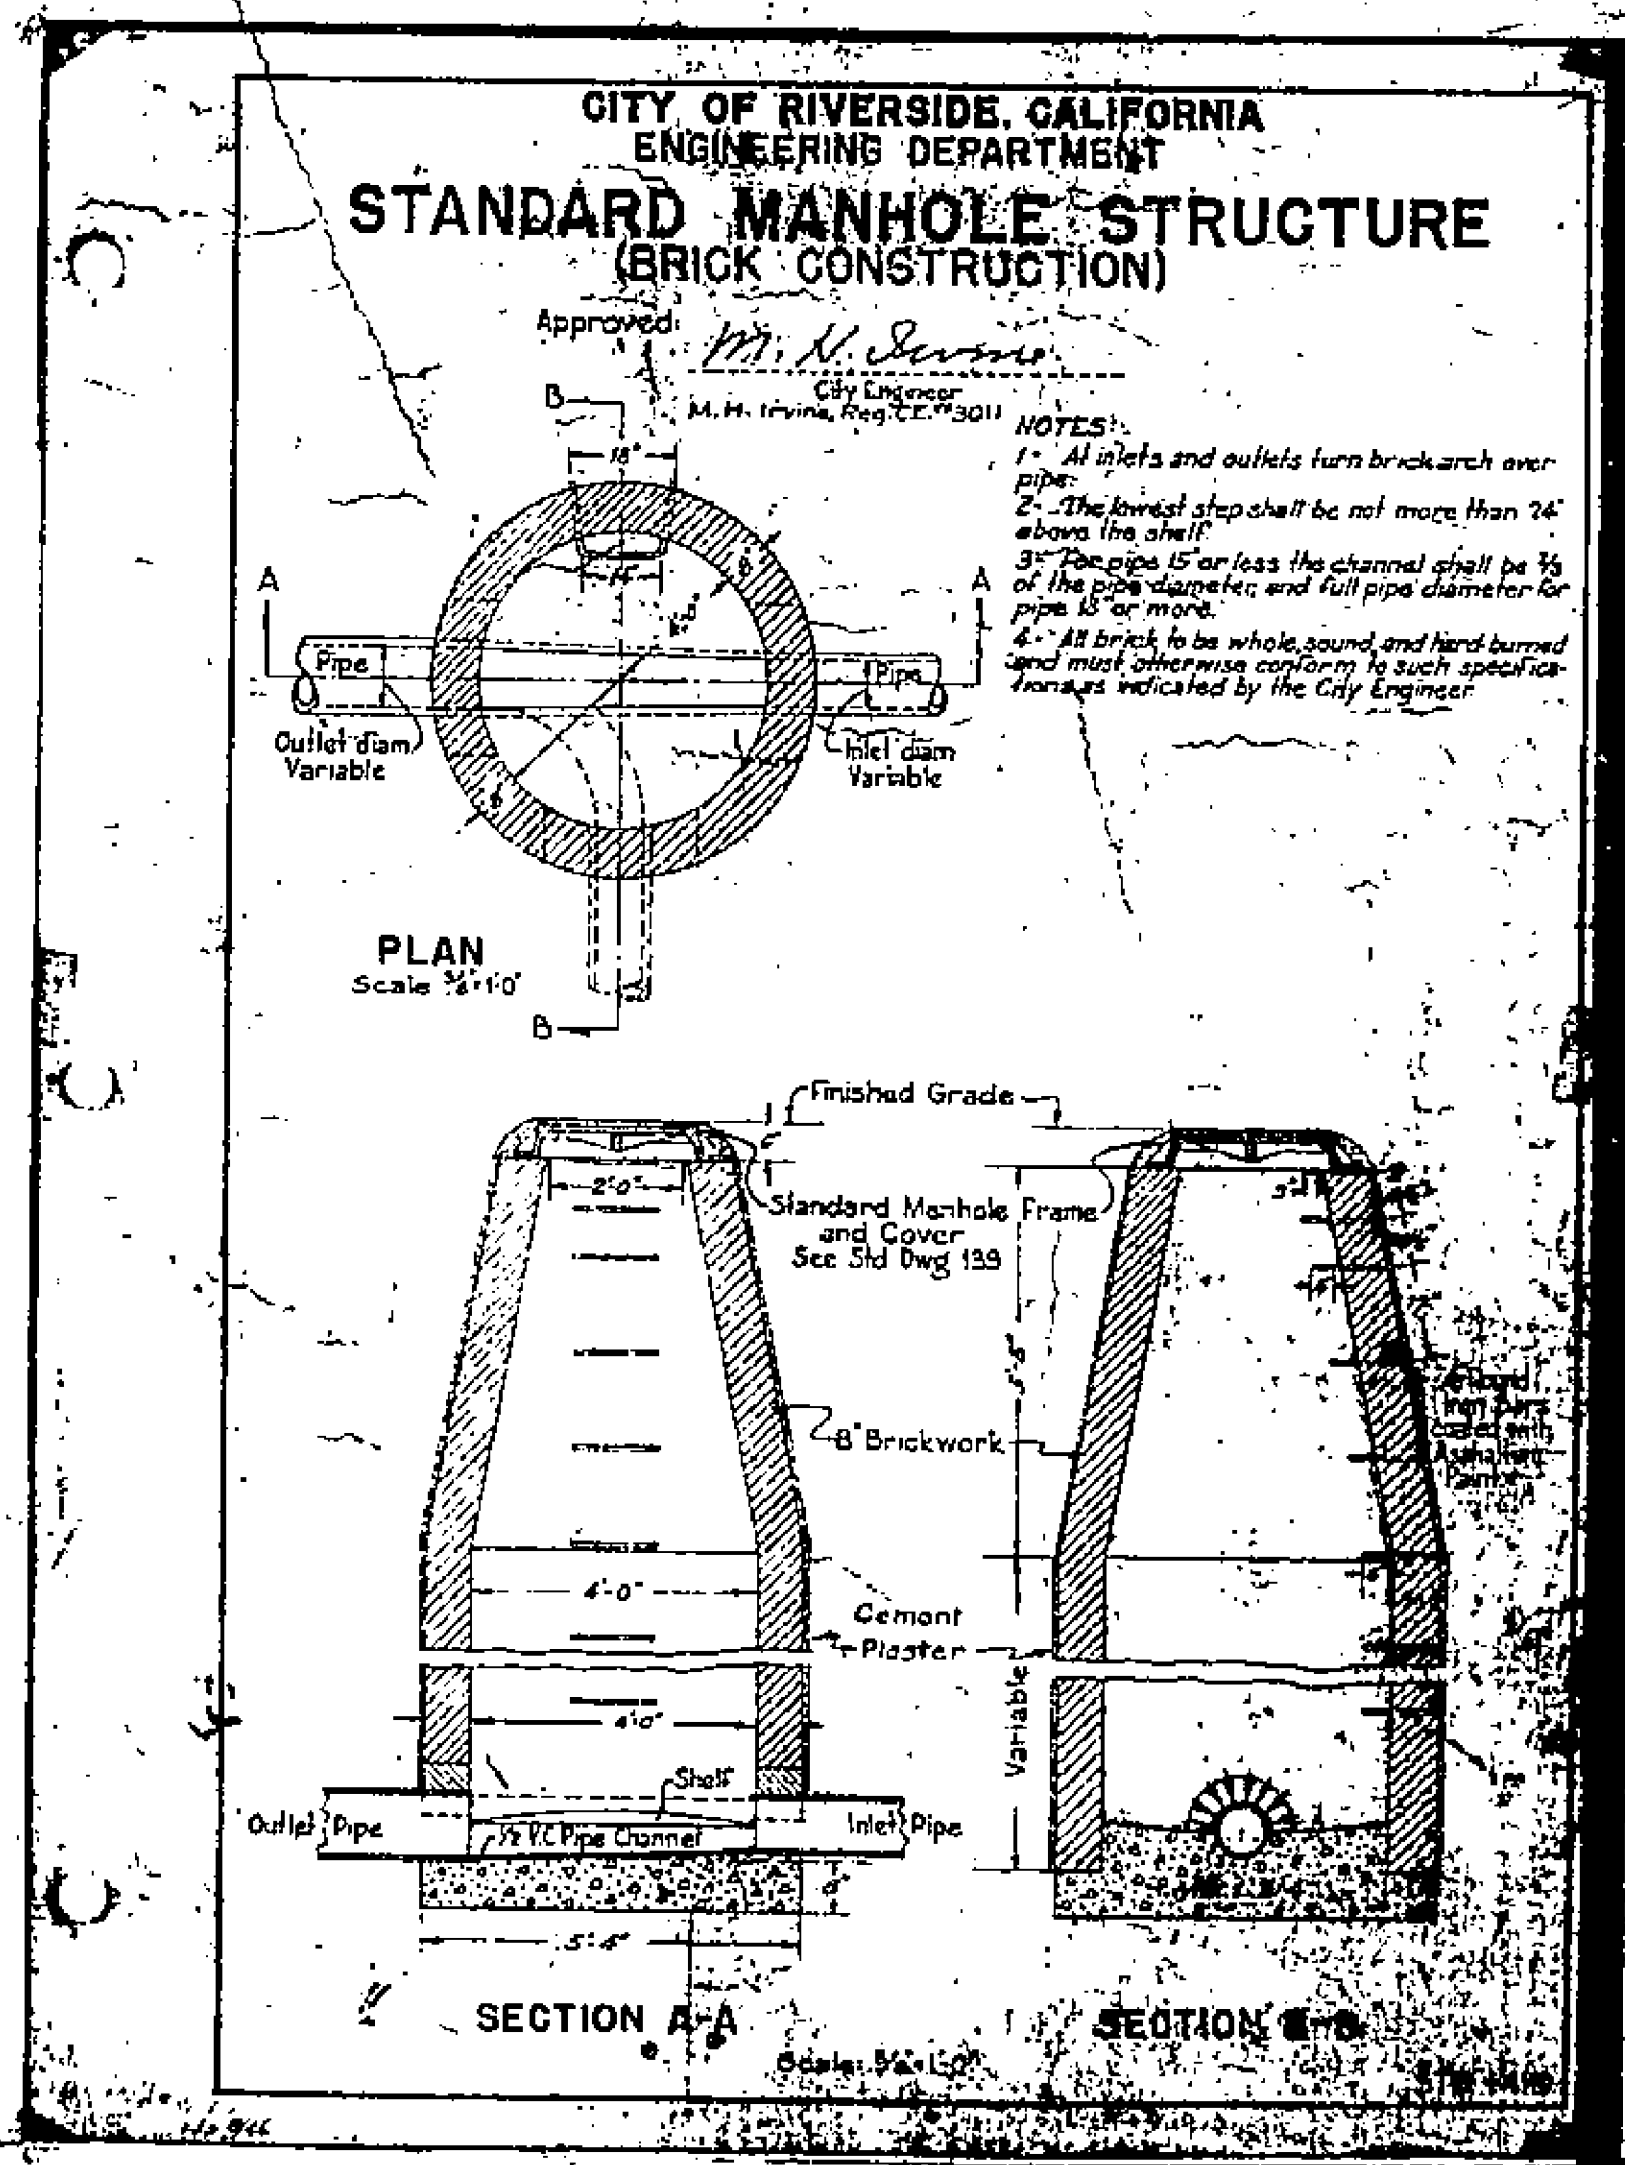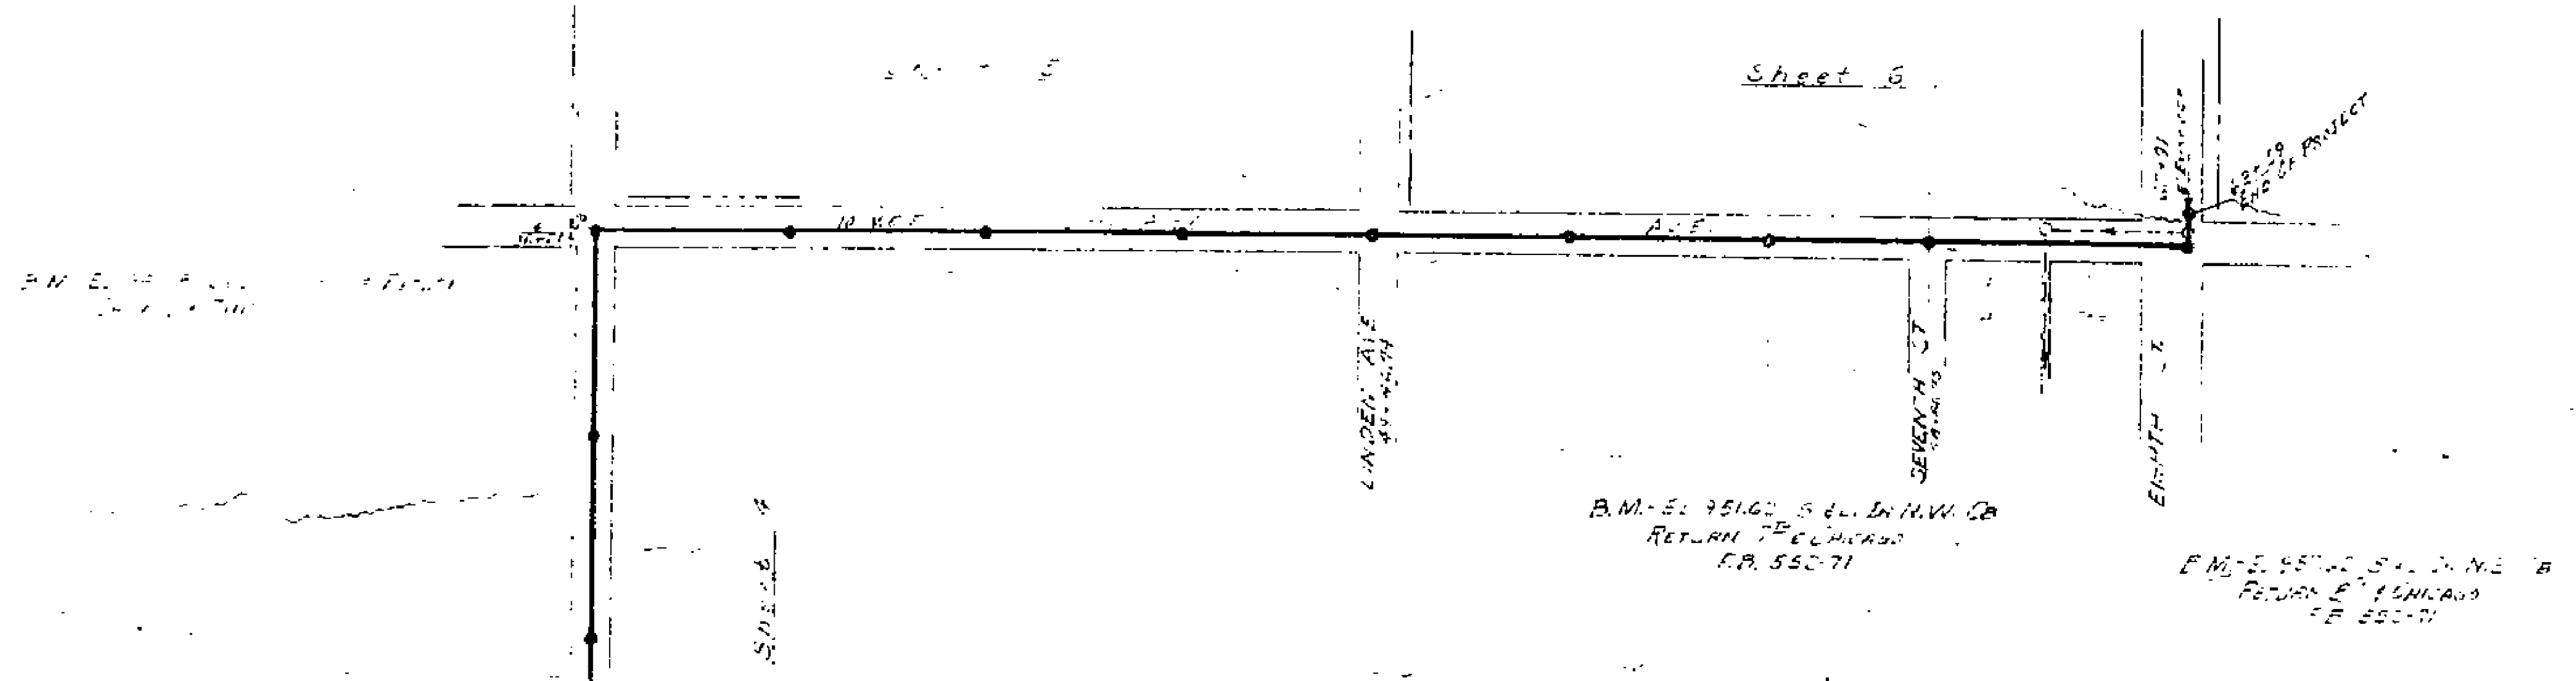

1102A

SCALES: HOR. 1" = 50'  
VER. 1" = 5'

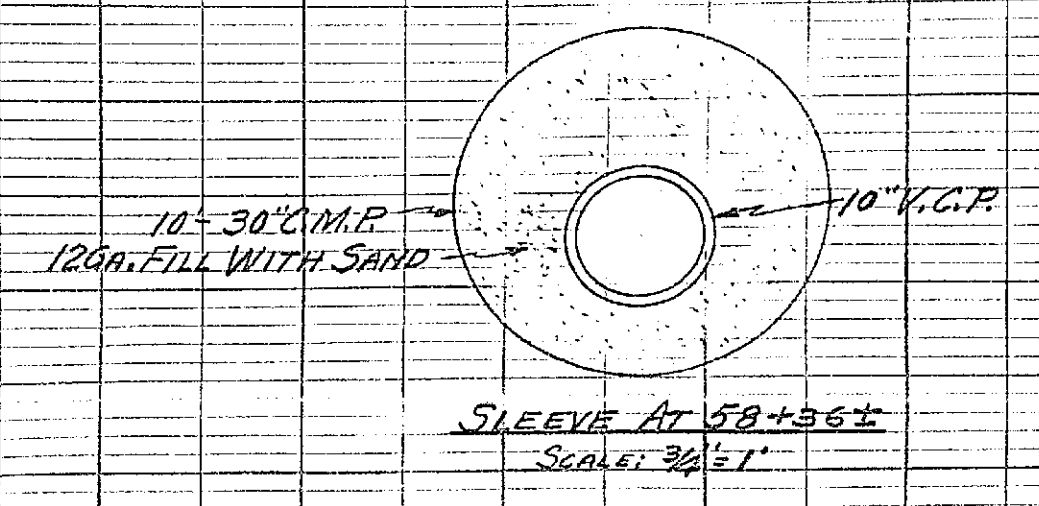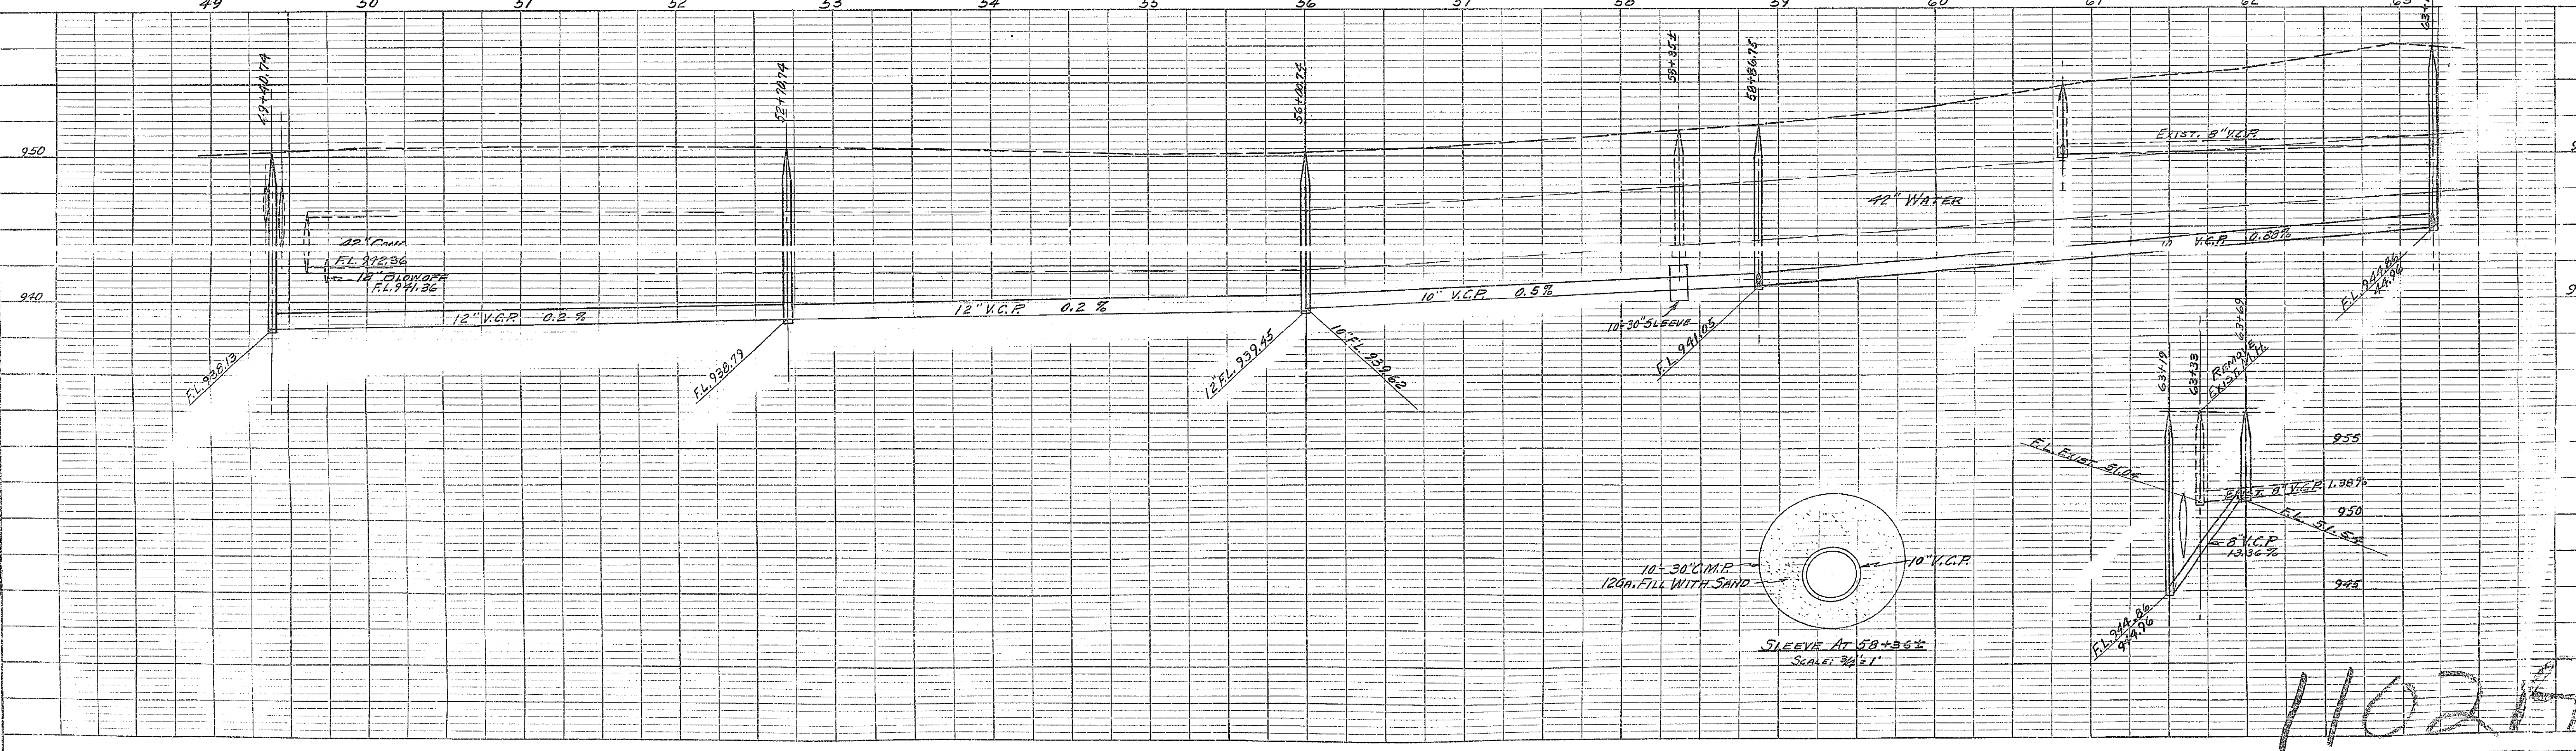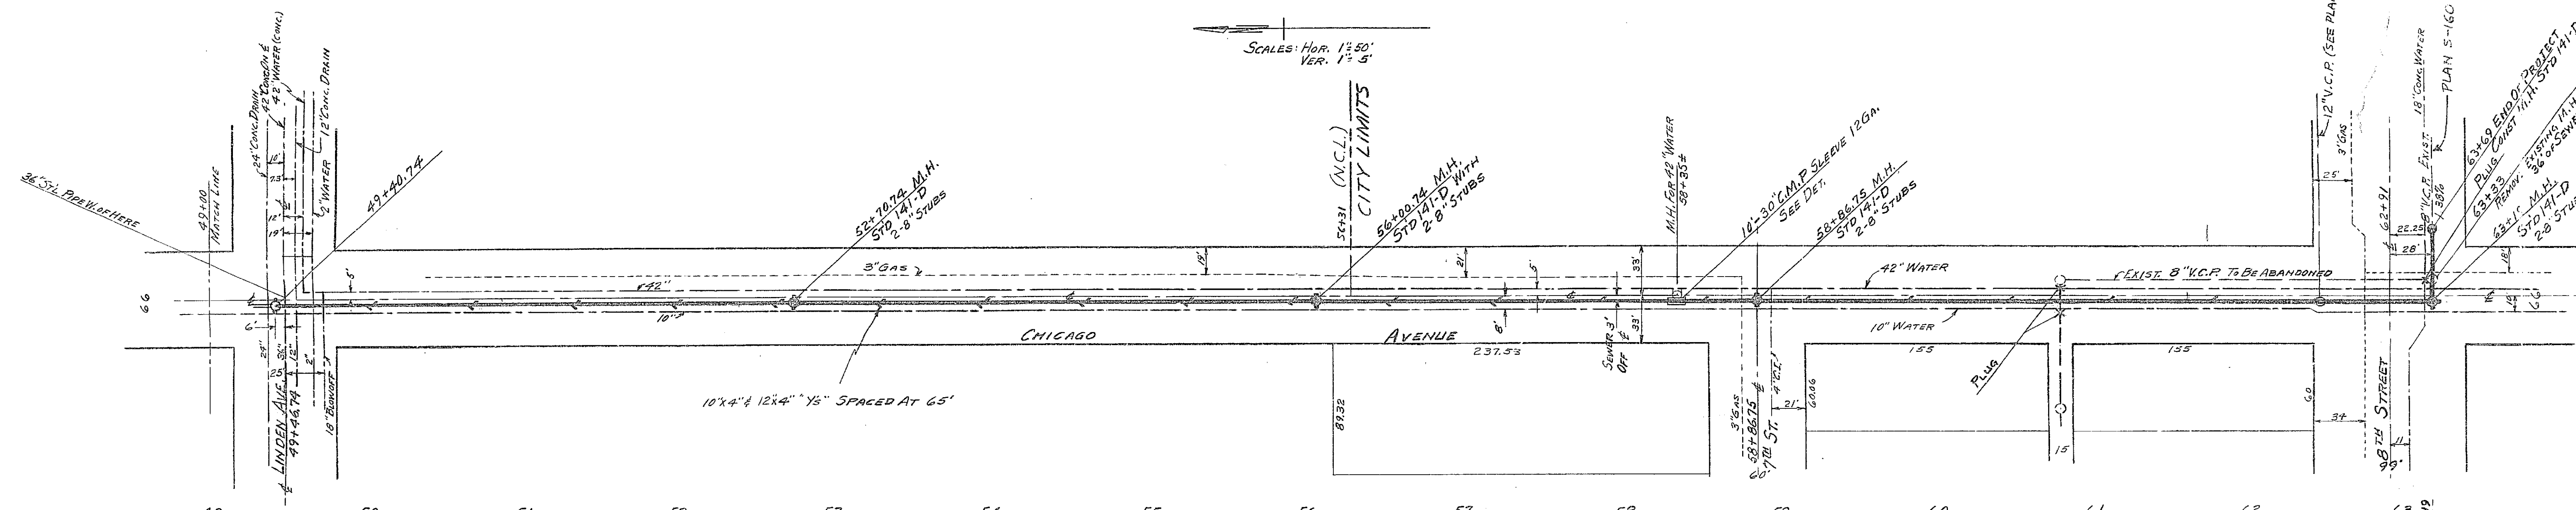

1102A

NO. OF SHEETS  
NO. OF SHEETS CHECKED

DATE  
NO.