


**MAP OF THE
MILE SQUARE
SHOWING
IMPROVEMENTS
ON PUBLIC STREETS.**

**RIVERSIDE
CAL**
SCALE. 1 INCH = 200 FEET

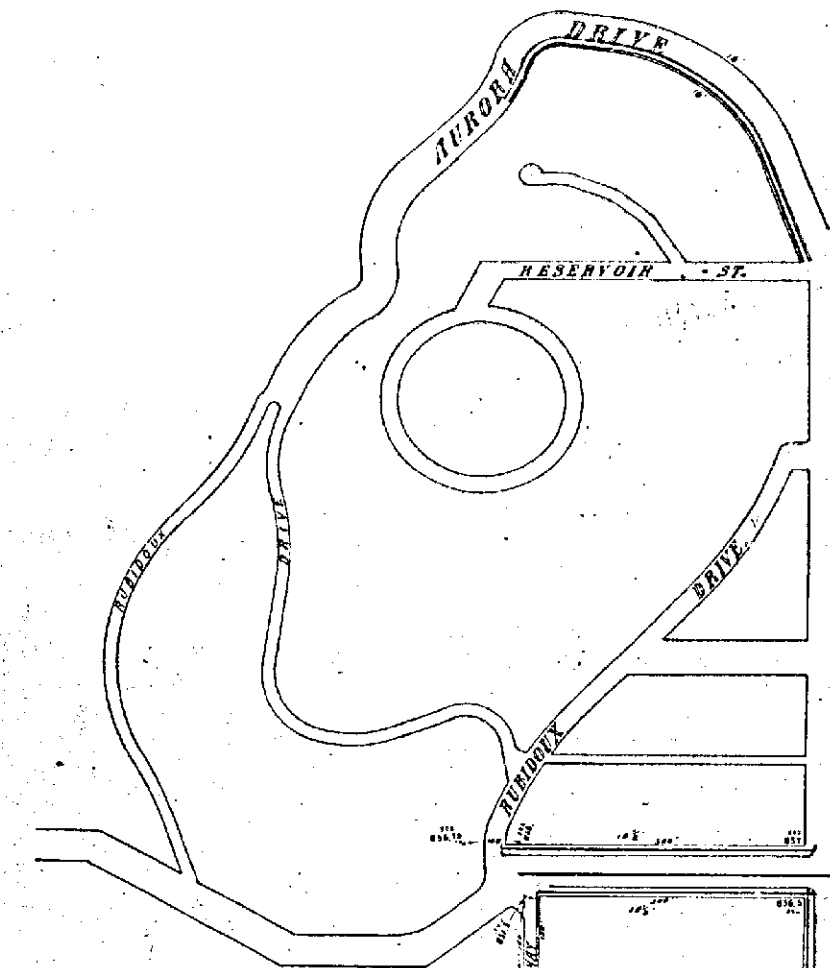

INDEX

- 1 Cement sidewalk
- 2 Asphalt sidewalk
- 3 Curbs, stone or concrete
- 4 Curb line
- 5 Gutters, stone or concrete
- 6 Canals
- 7 Graded and oiled roadway
- 8 Decomposed granite base roadway
- 9 Rock base roadway
- 10 Macadam base roadway
- 11 4" rock & 3" granite base roadway
- 12 Asphalt roadway
- 13 Culverts
- 14 Public buildings
- 15 Black figures thus \bullet - established grade elevations.
- 16 Red figures denote ordinance No of established grades
- 17 Green figures denote ordinance No of street width
- 18 Width of walk & parking space is shown thus \square between corners

1142

