


1271

# GRACE STREET - FERN TO LINCOLN

SEE FB T7 SH 8 to 11

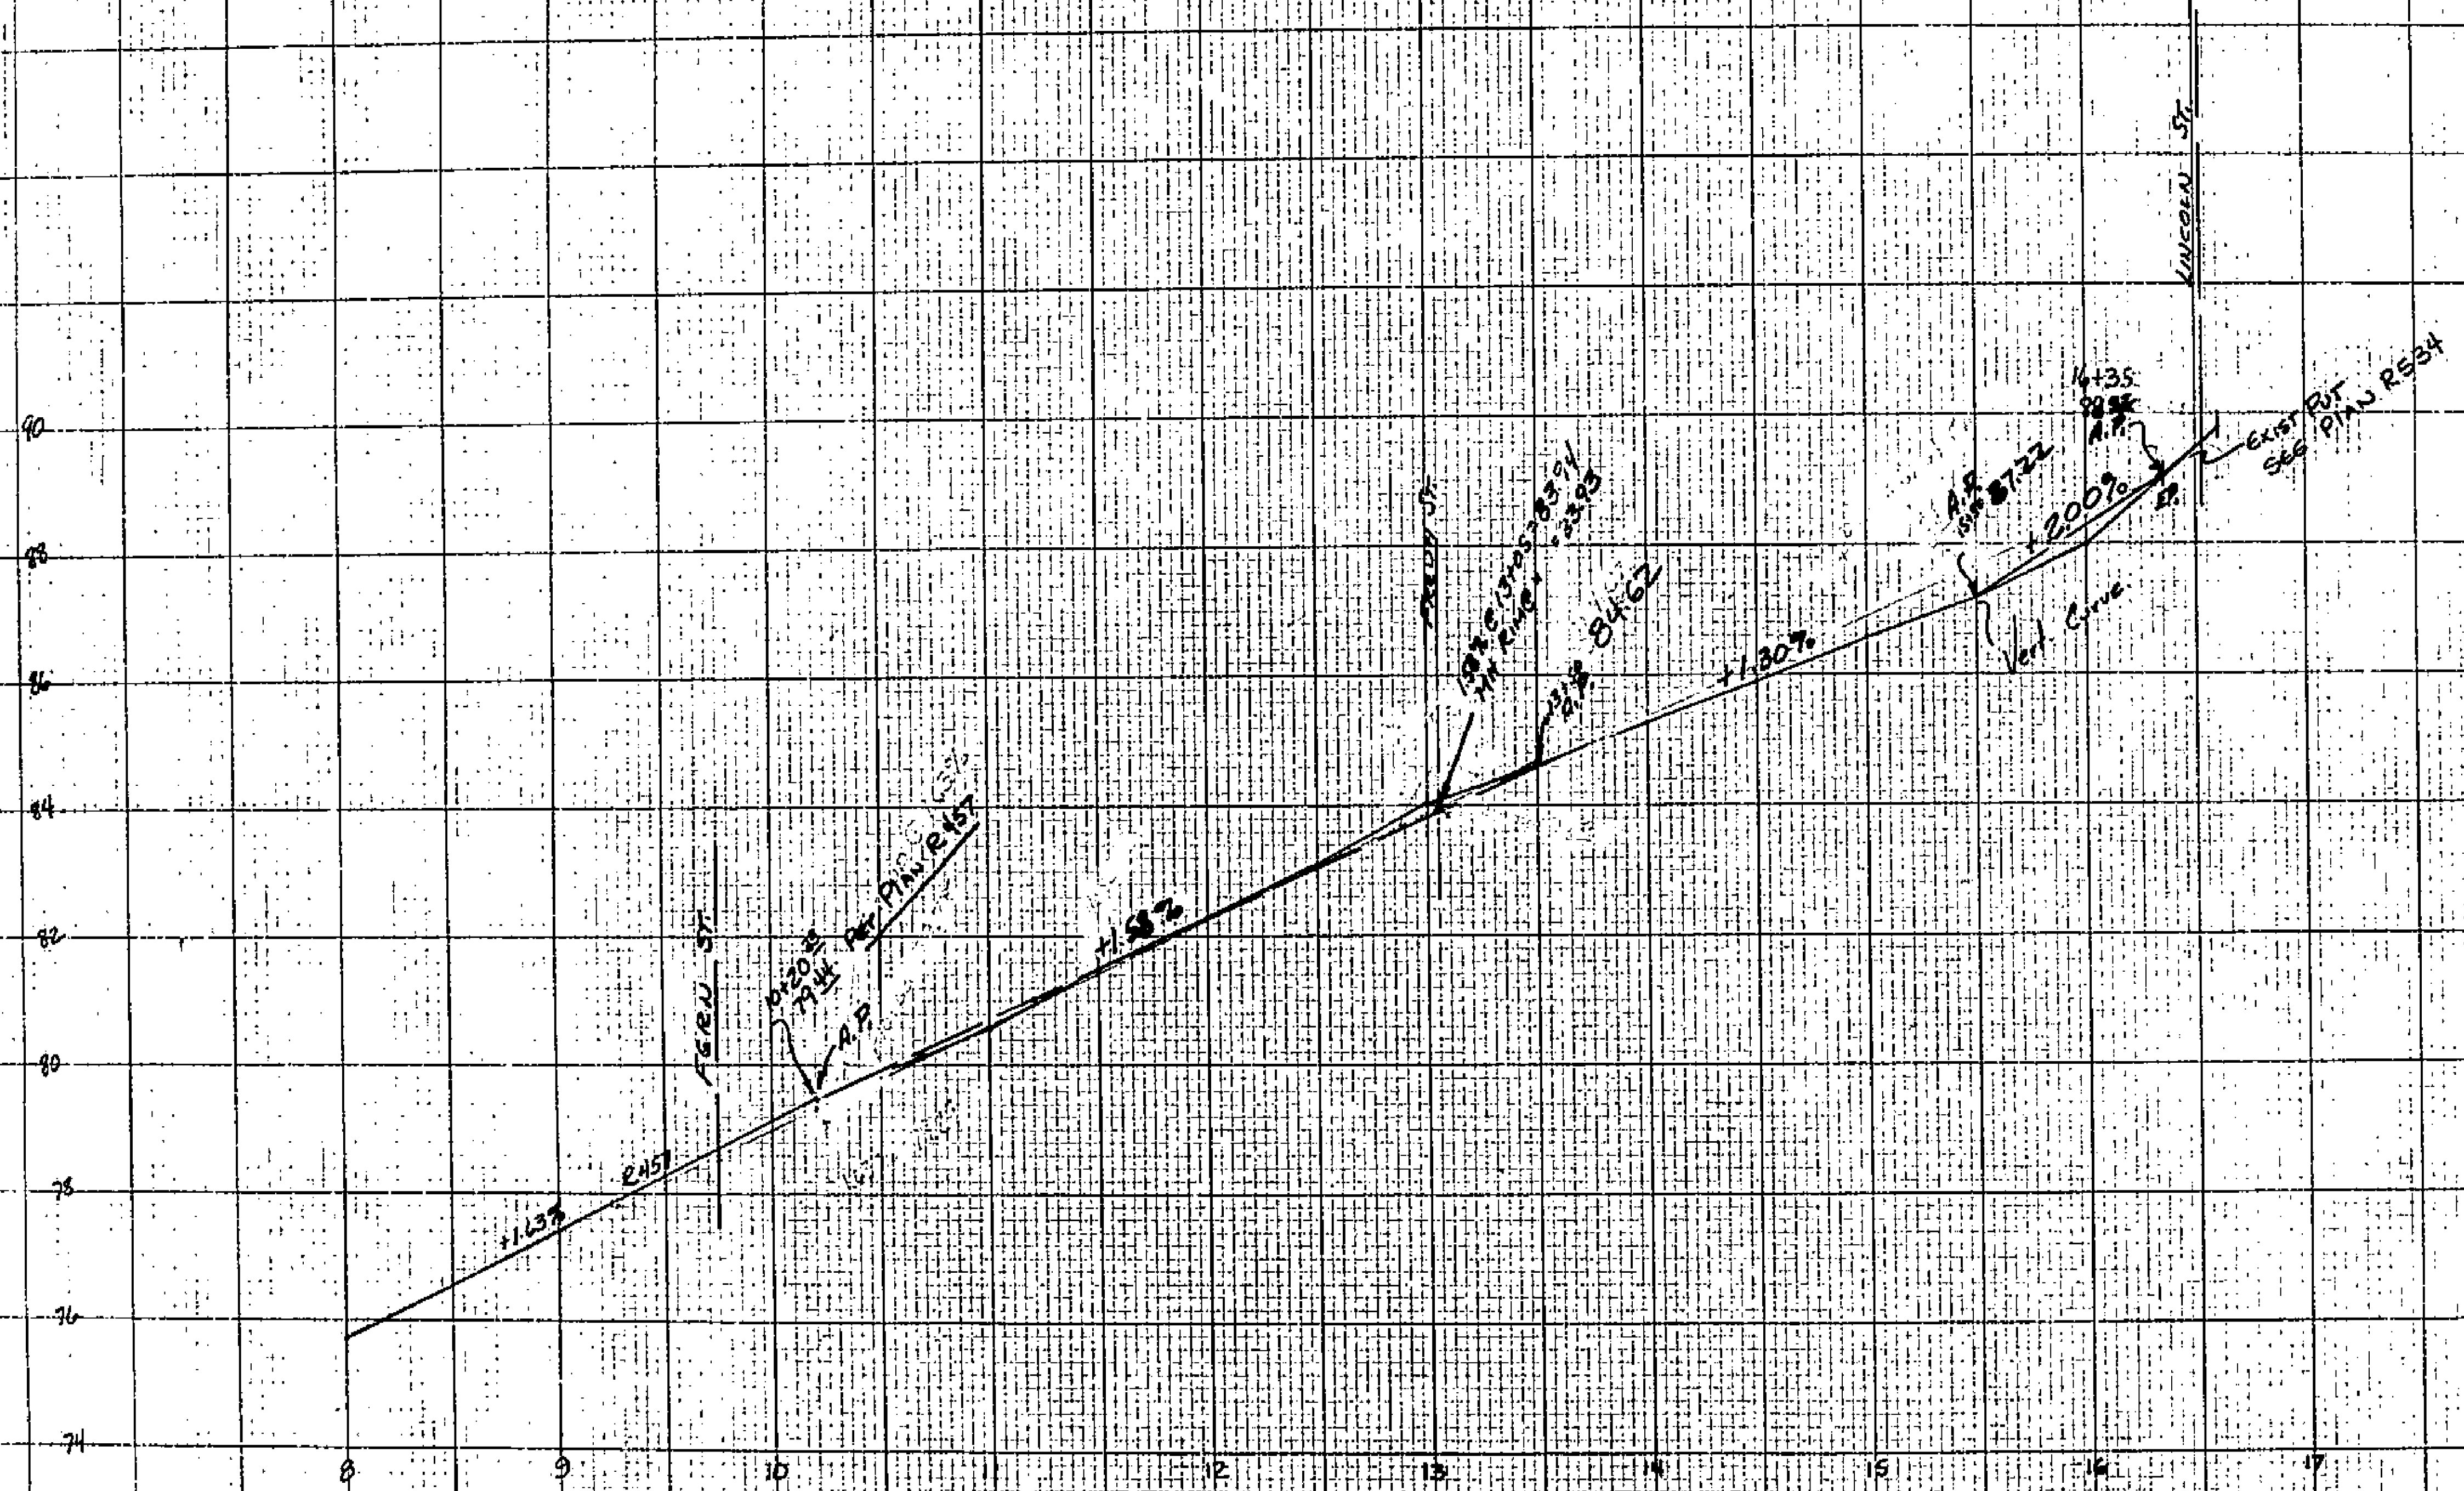

As Constructed by Public Service  
1-21-65  
JAC

1270

1270

