


100

# JEFFERSON STREET - VICTORIA TO LINCOLN

FB P1/ 48-49  
ACCT 9006

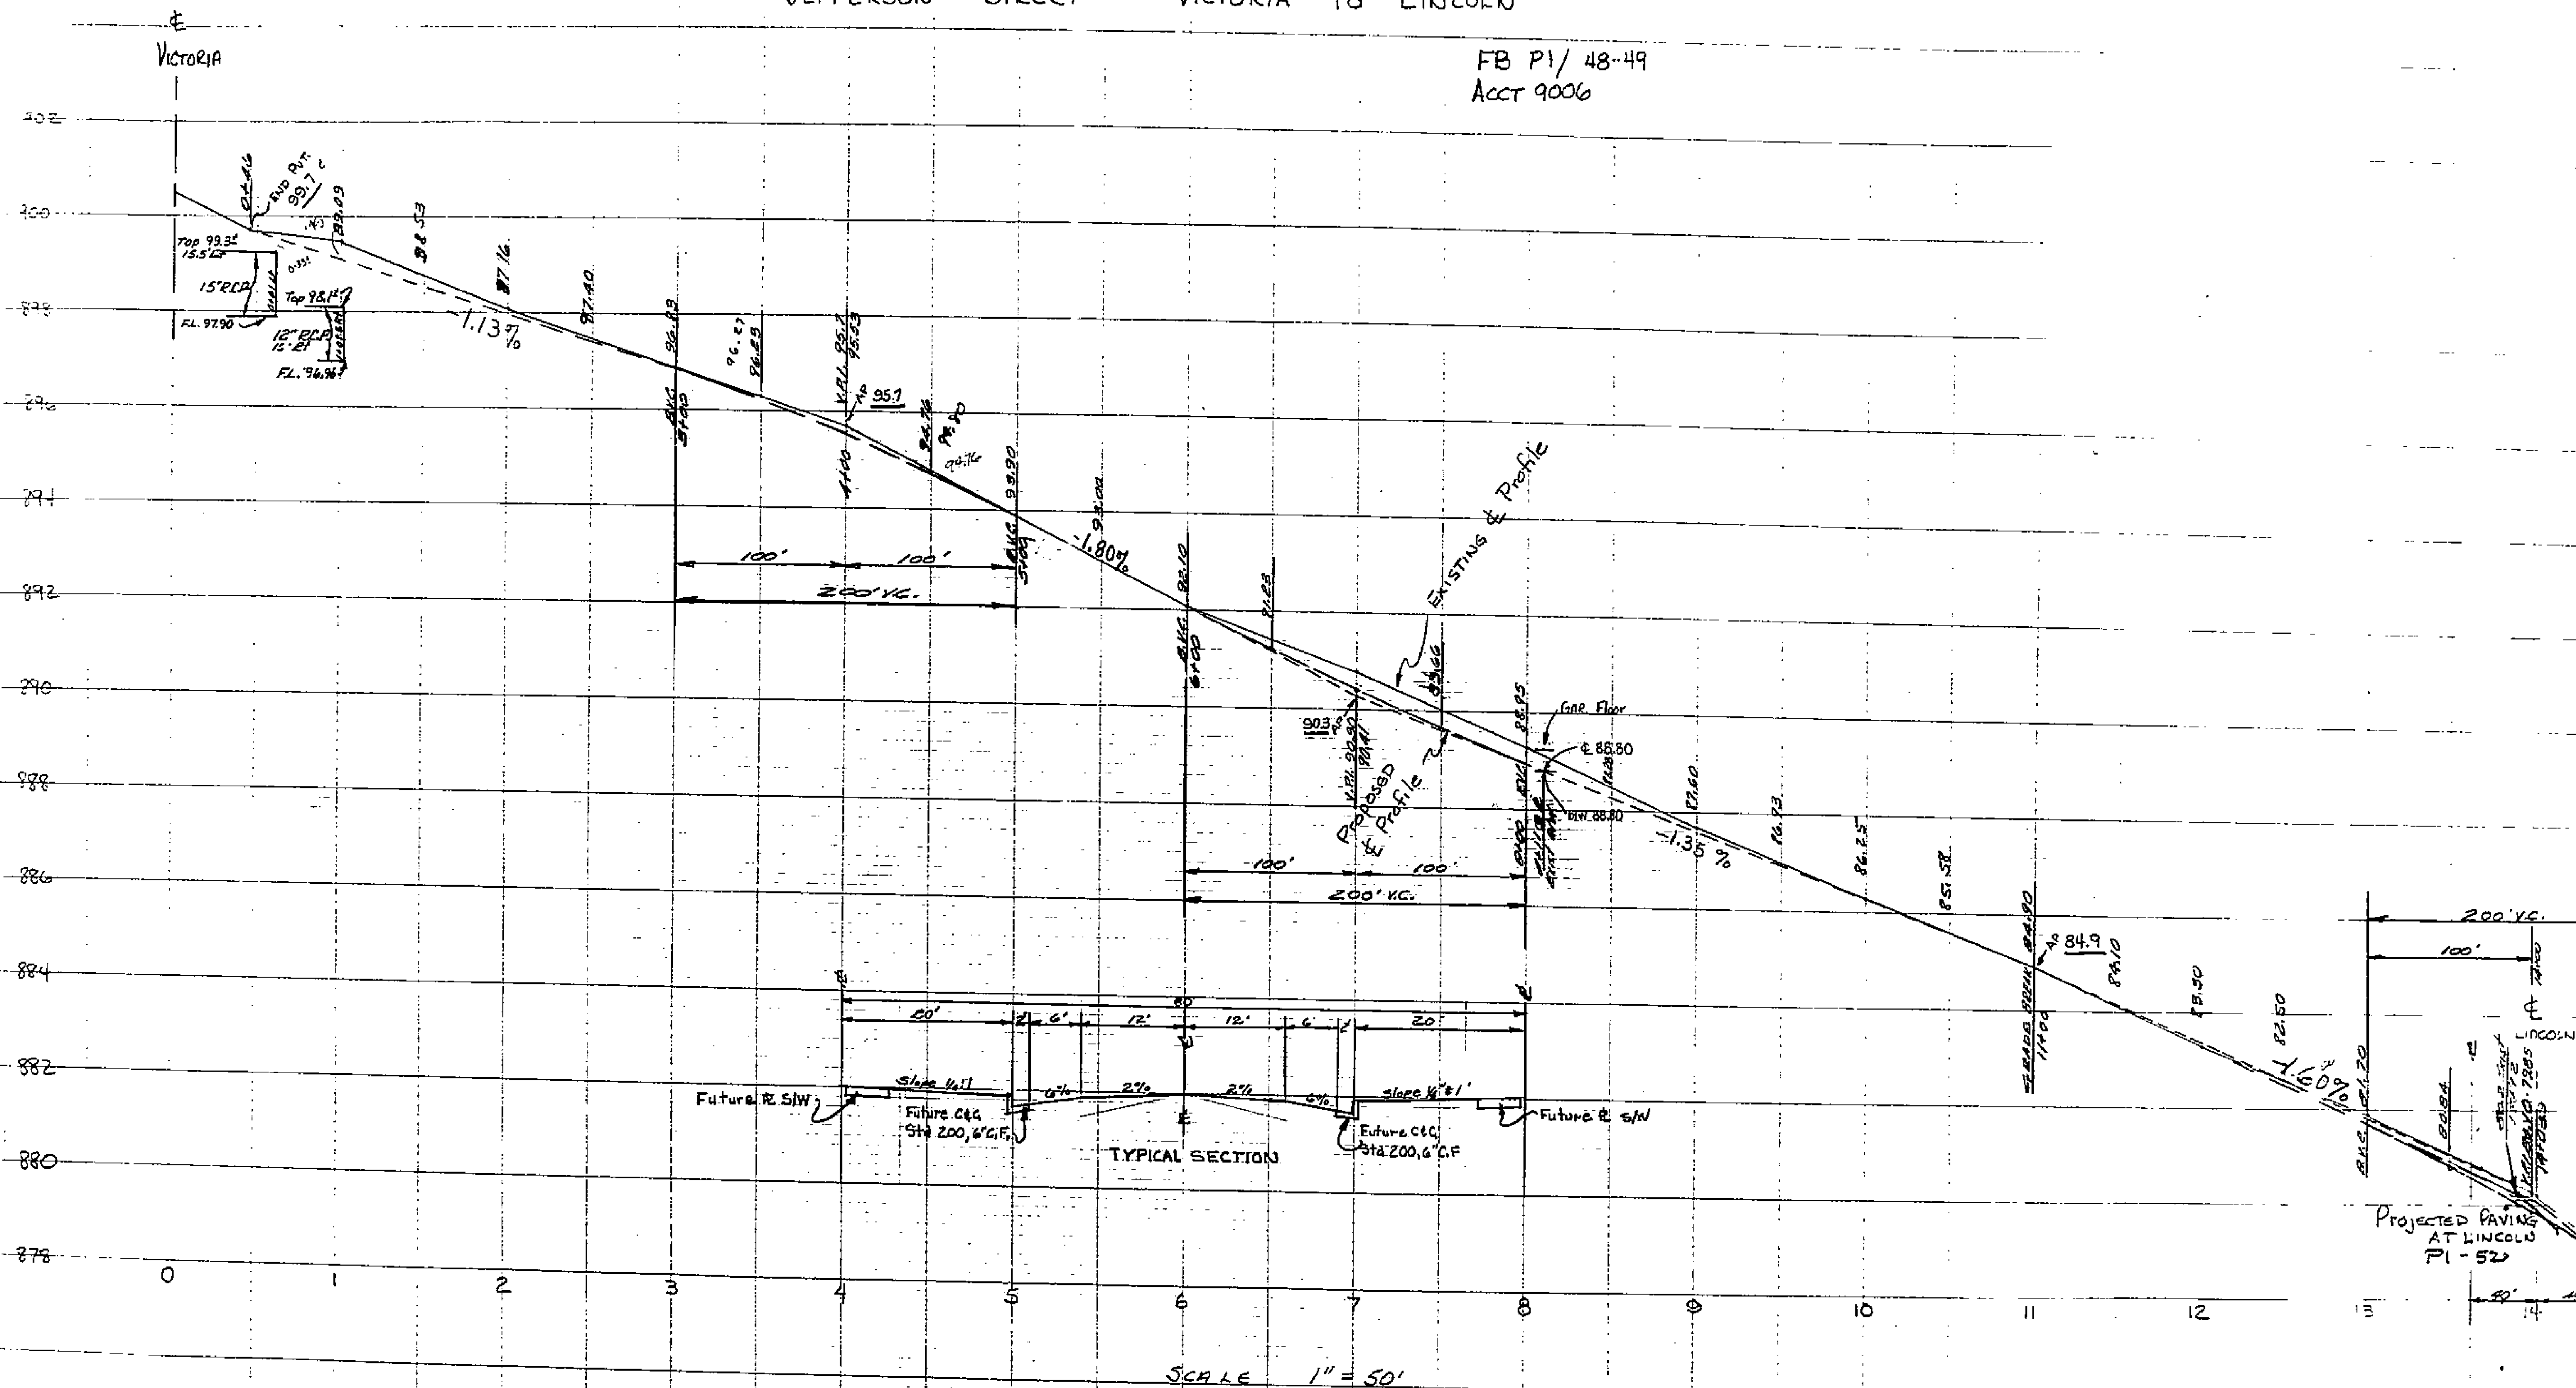

SCALE  
1" = 2'


SCALE 1" = 50'

As Constructed by Public Service  
8-25-66  
JHK

1270A 1270A

JEFFERSON - LINCOLN TO EVANS

FB PI/49-50  
Acct. 9006

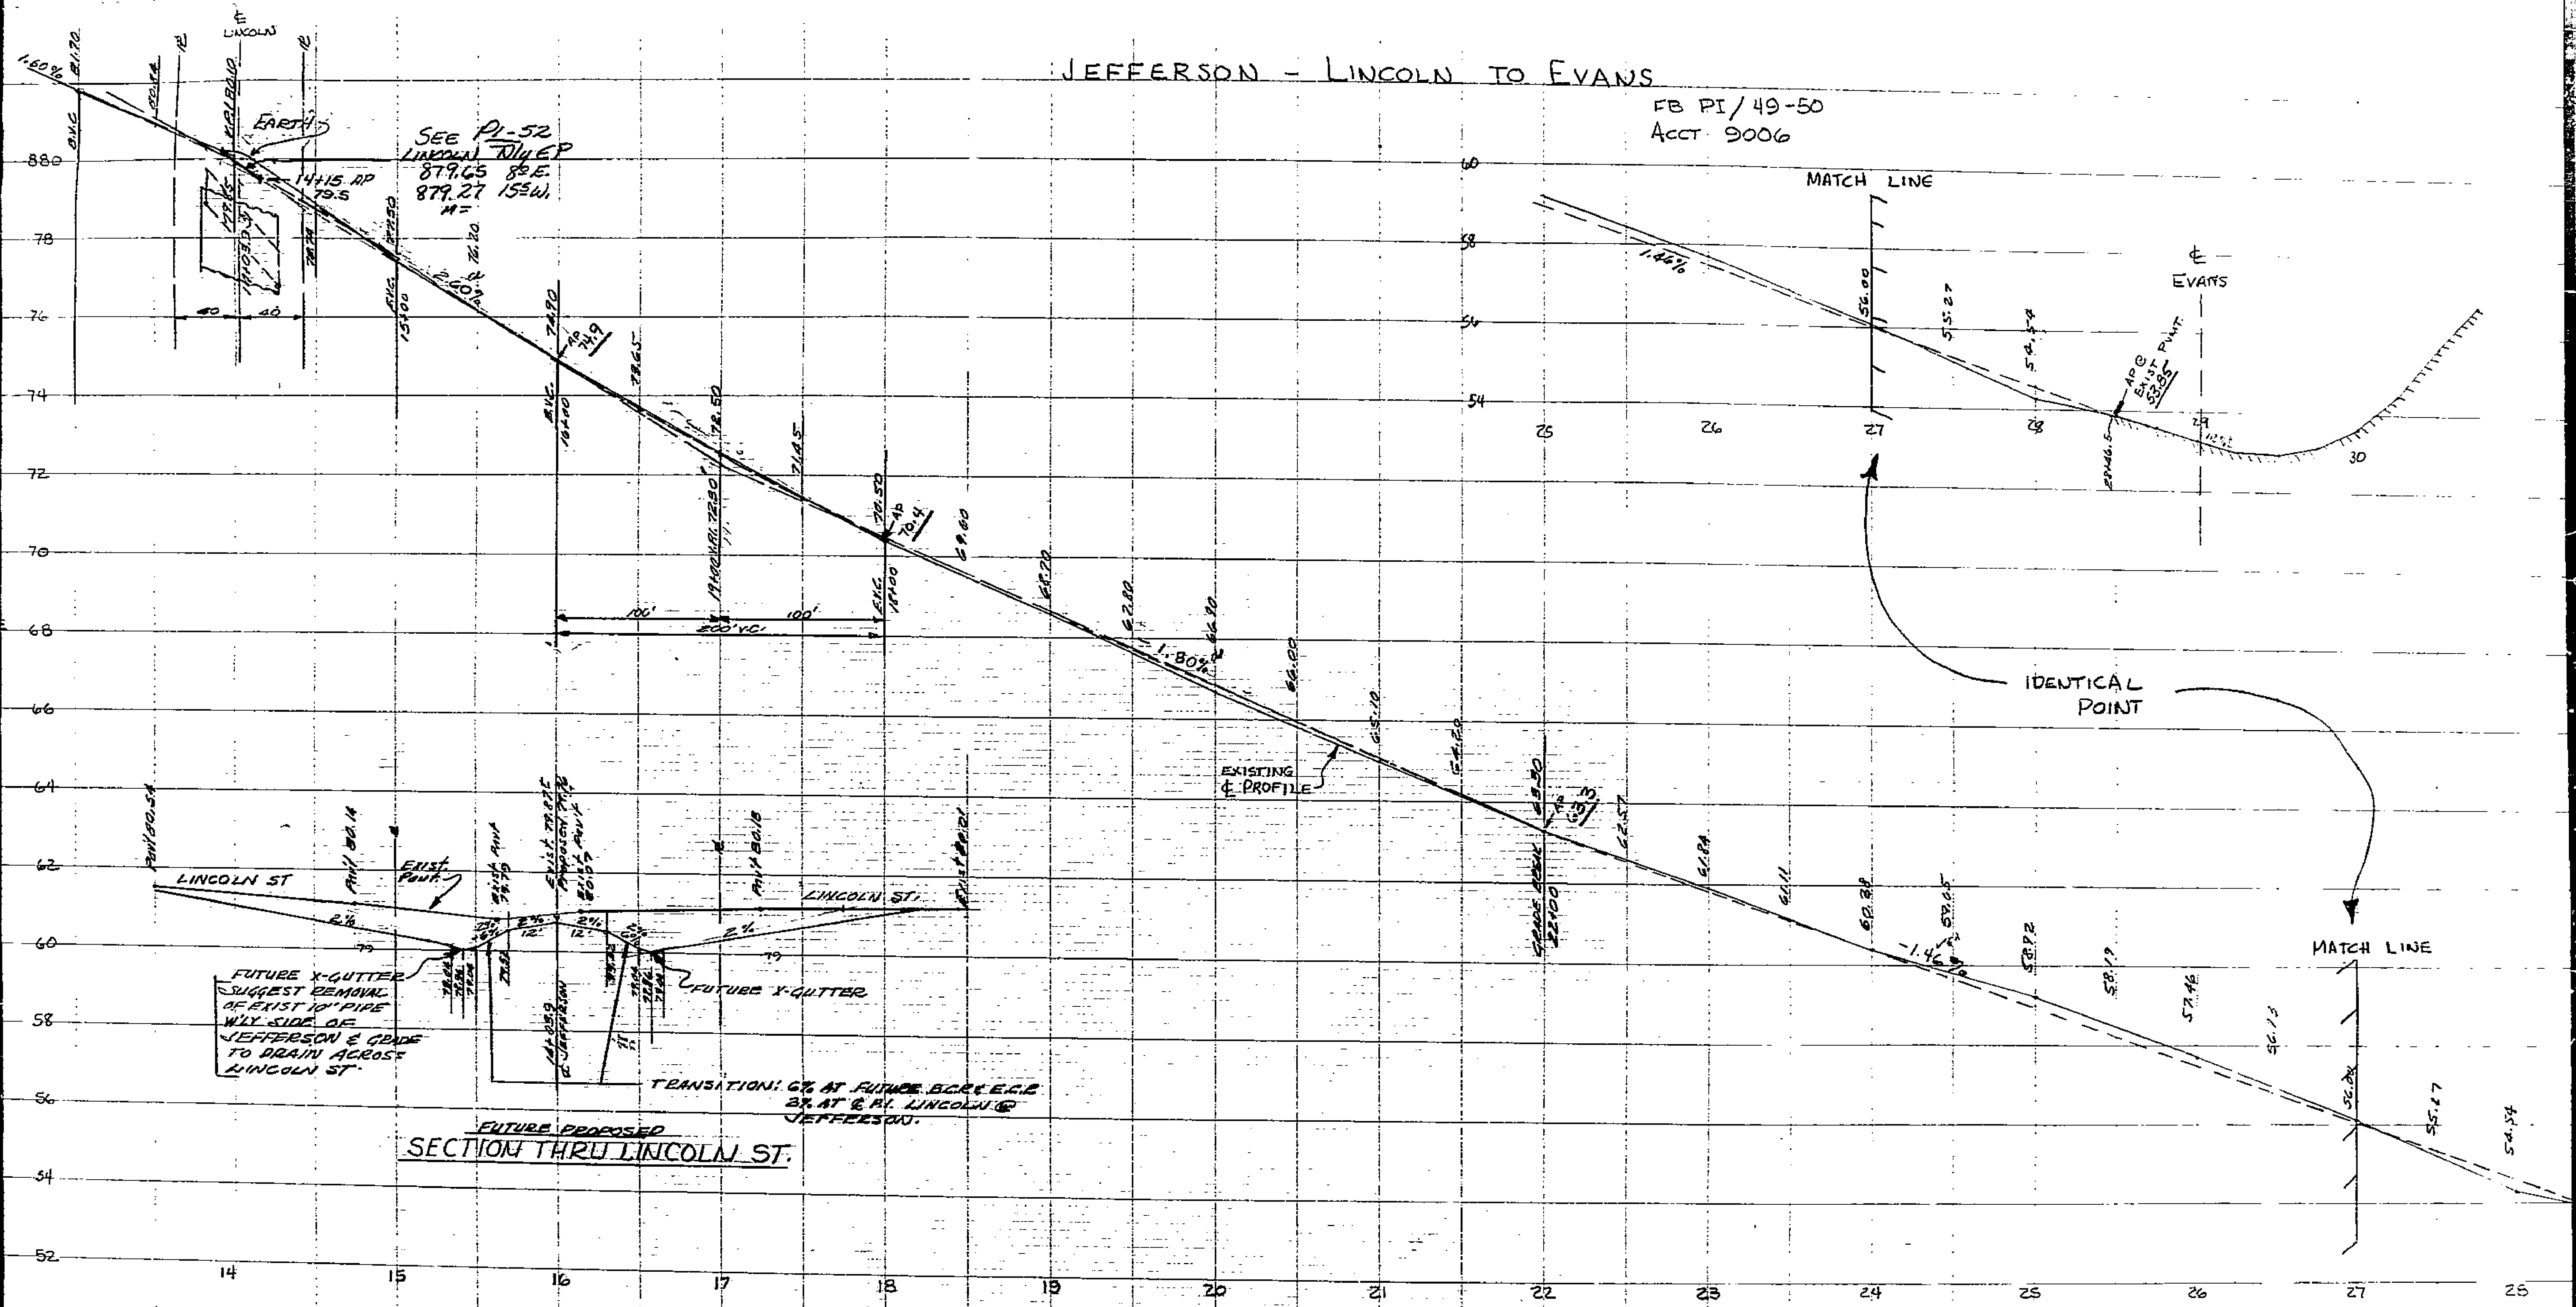

SEE PI-52  
LINCOLN R/W P  
879.65 88'E  
879.27 153'W  
M=

FUTURE X-GUTTER  
SUGGEST REMOVAL  
OF EXIST 10" PIPE  
W/ Y SIDE OF  
JEFFERSON & GRADE  
TO DRAIN ACROSS  
LINCOLN ST.

FUTURE PROPOSED  
SECTION THRU LINCOLN ST.

TRANSITION: 6% AT FUTURE BORE LEG  
2% AT & PI. LINCOLN &  
JEFFERSON.

SCALE 1" = 50'

As Constructed by Public Service  
P-29-69:JK

1270A  
1270 A

CLEARPRINT ©