


ST. LAWRENCE - VICTORIA TO LINCOLN
FB R6 Sh. 1-4

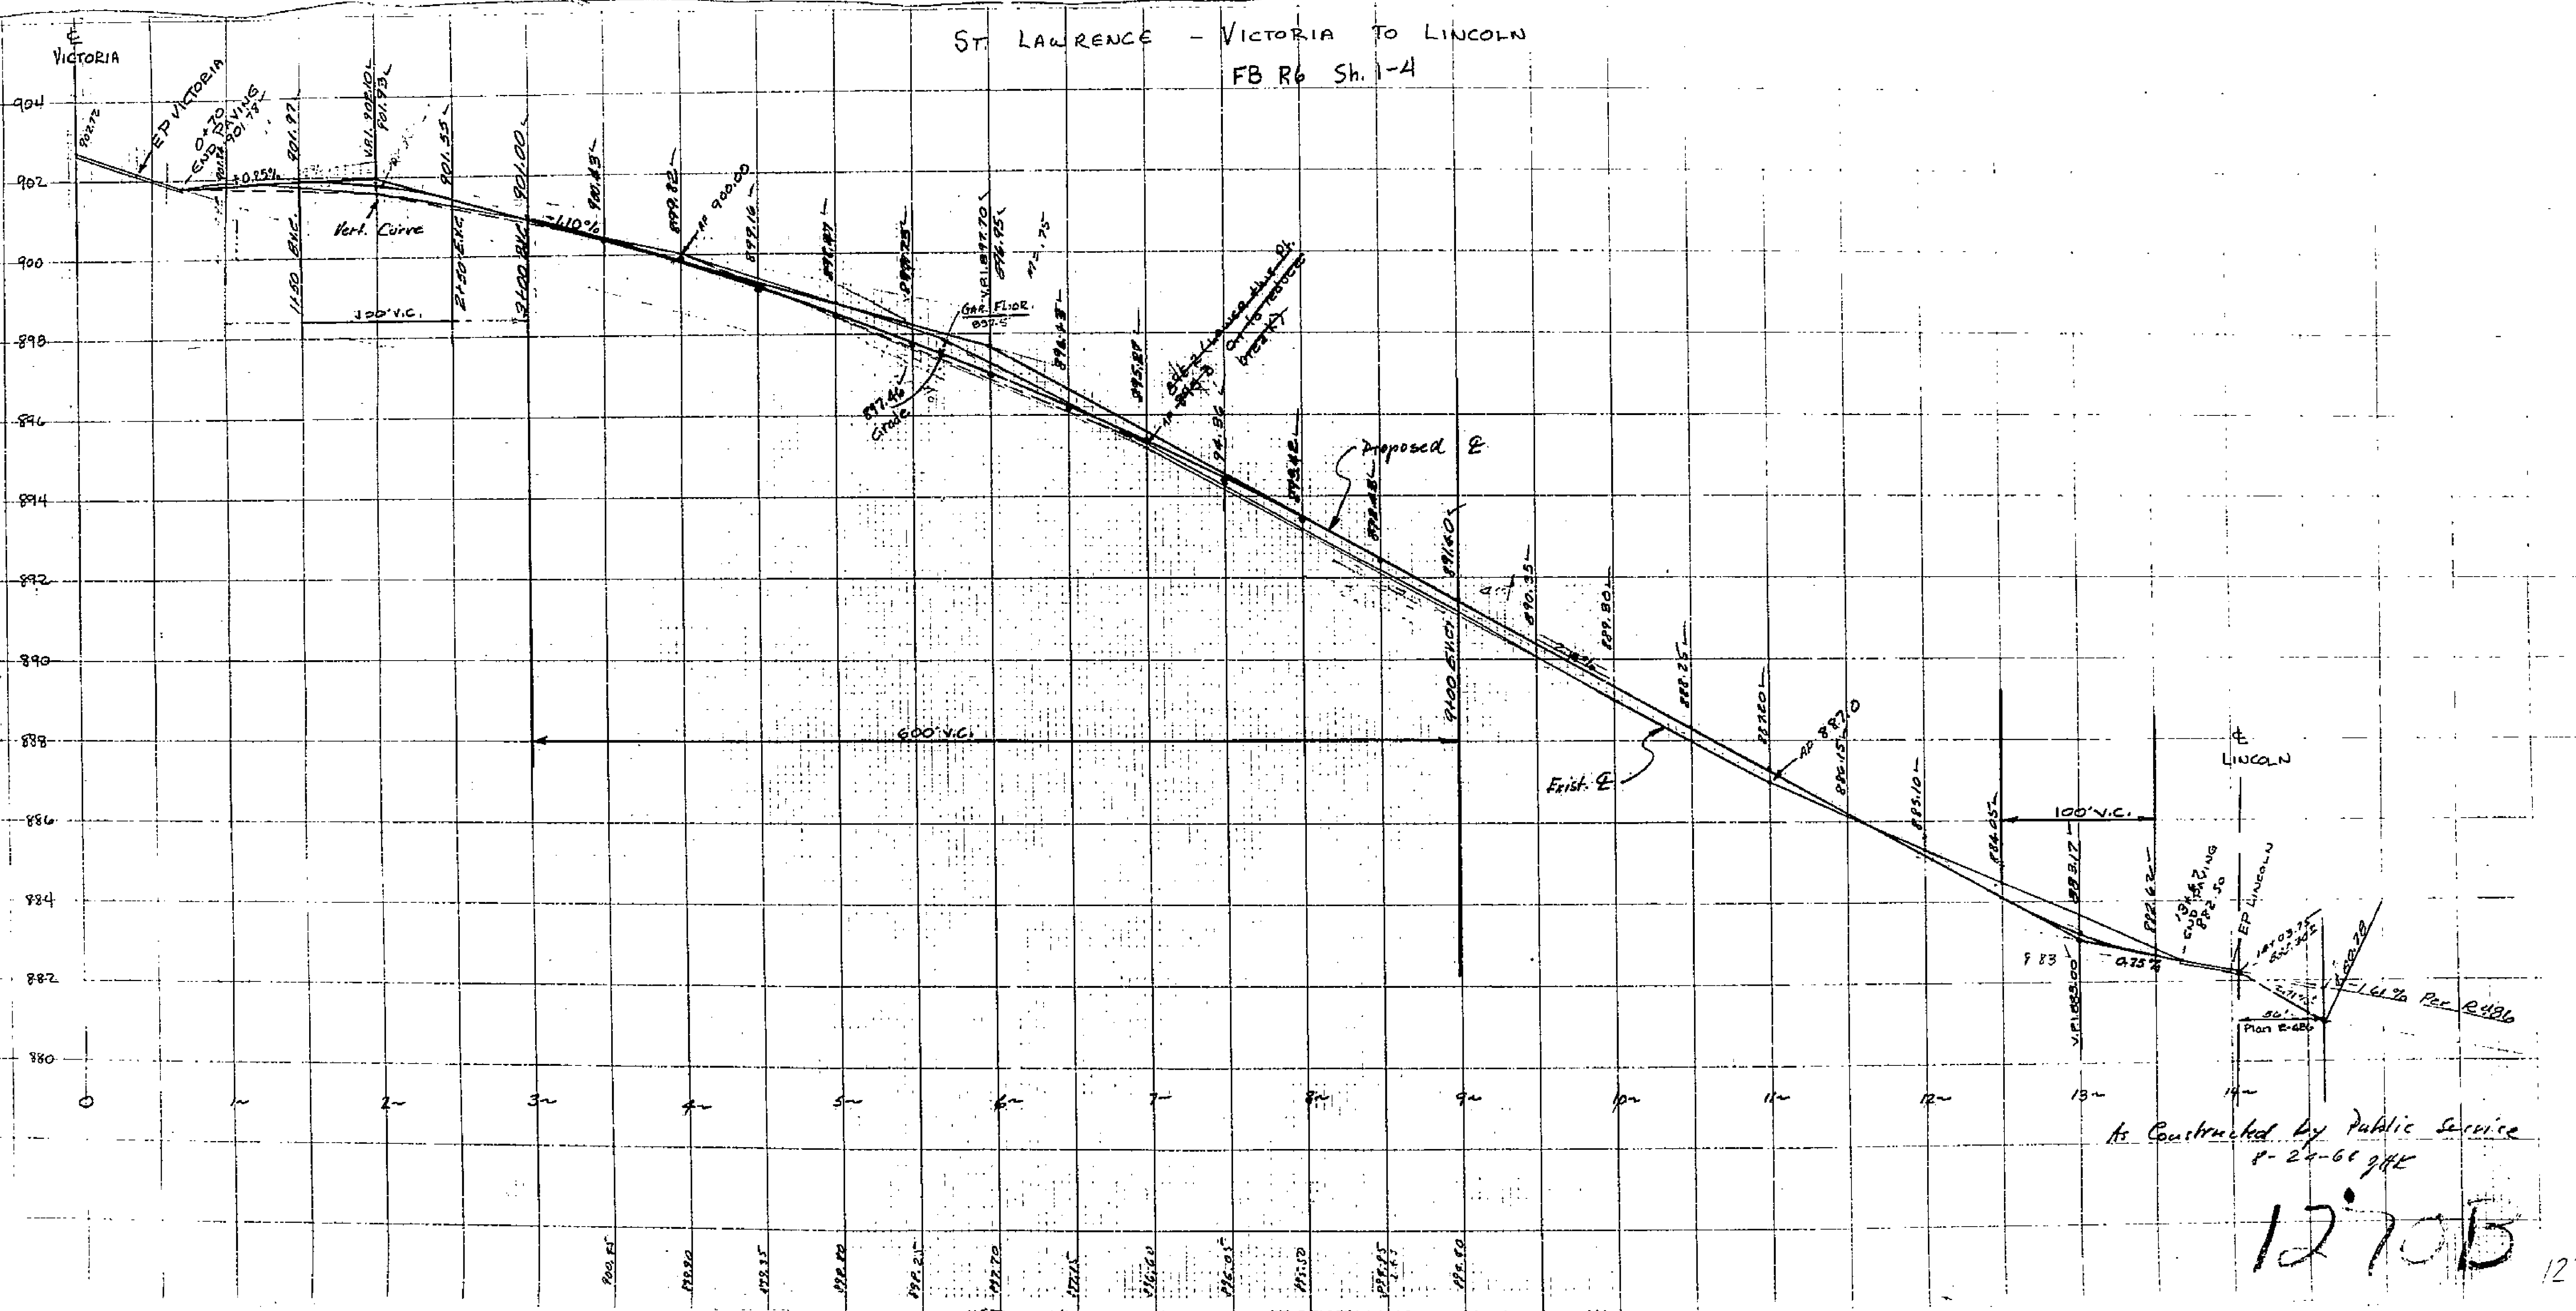

As Constructed by Public Service
8-24-60 gHK

12705