

134-A

134-A

# MONROE STREET STORM DRAIN


## BETWEEN COLORADO AVE. & CALIFORNIA AVE.

### 66" CONDUIT AT ANGLE

ENGINEER DEPT. RIVERSIDE, CALIF. 1939.  
 CITY (U.S.G.S.) DATUM PLANE  
 FIELD BOOK 281 PAGES 55-58


APPROVED *[Signature]*  
 CITY ENGINEER.

SCALE 1" = 20'

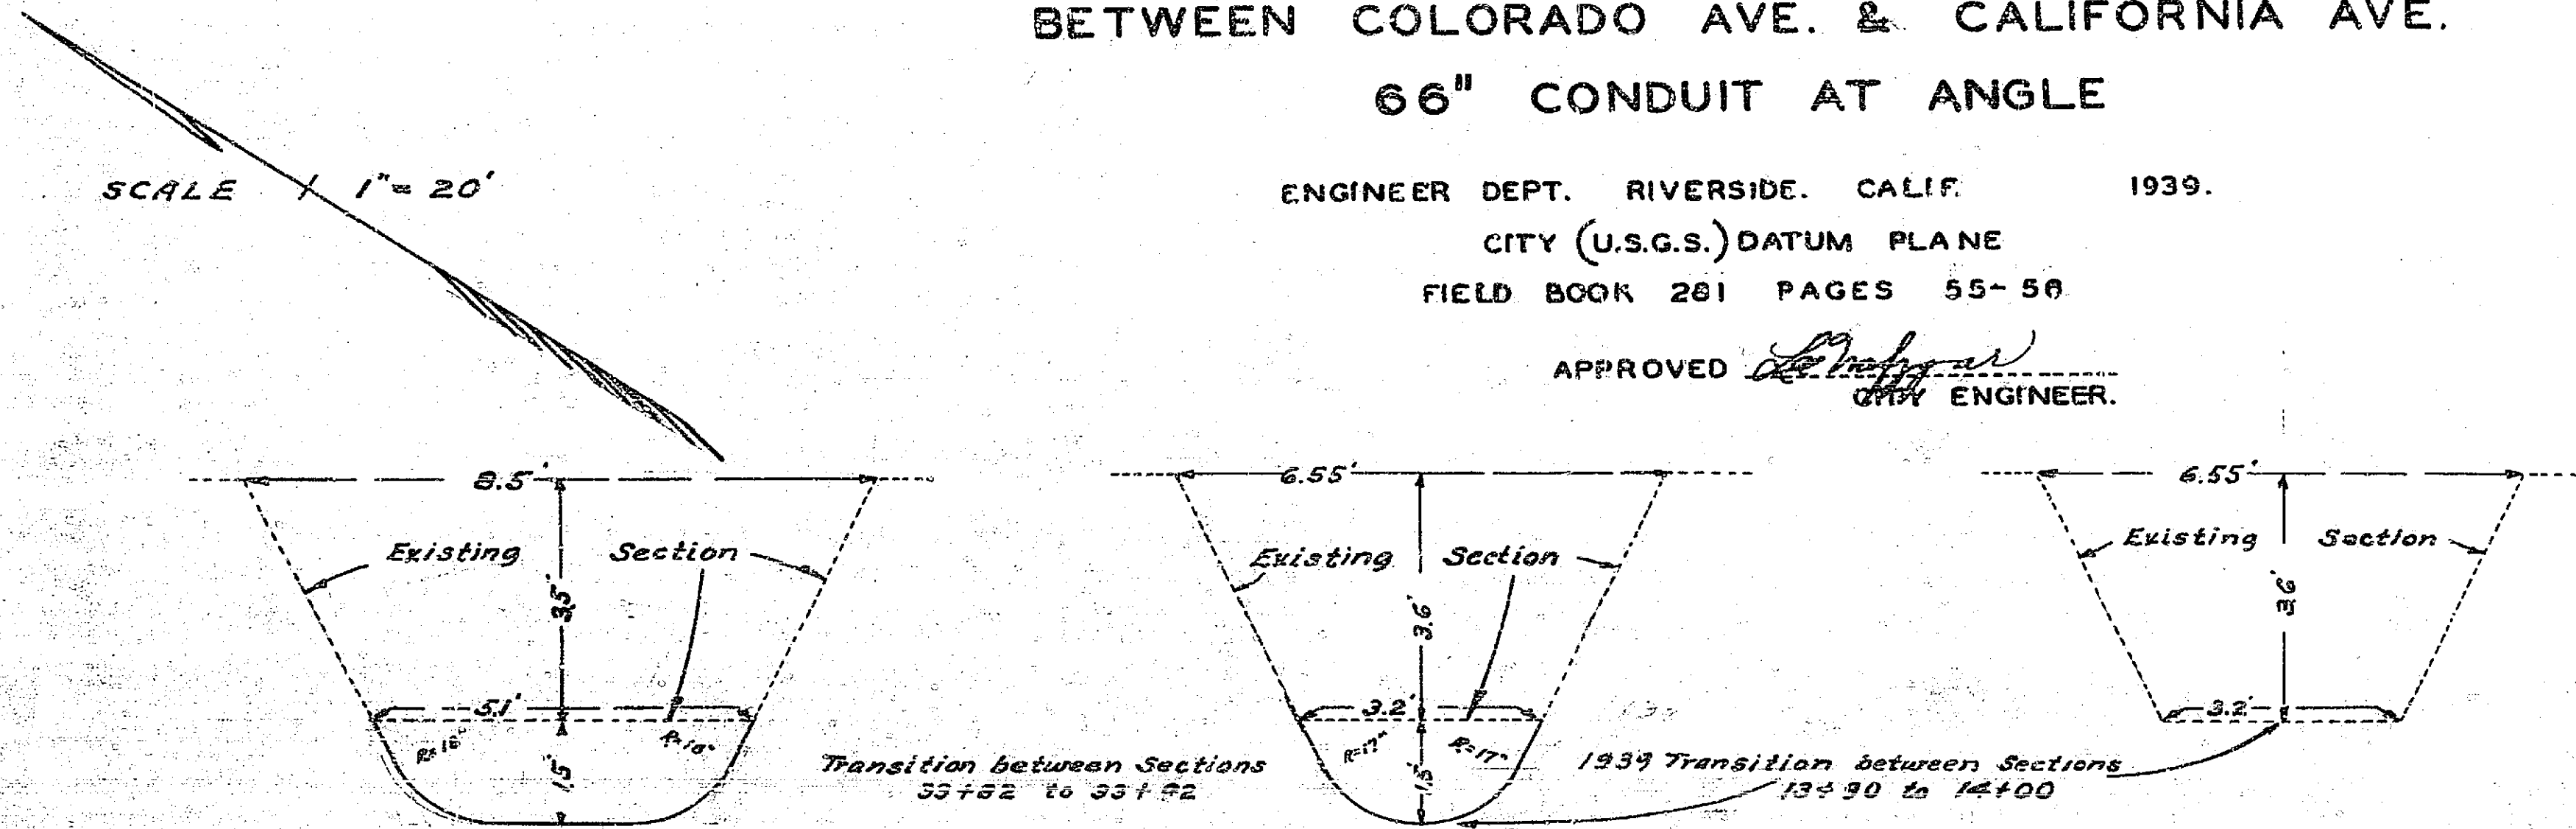

Existing Section 1939  
 Existing Section 1939 Enlargement 12+00 to 33+92  
 Existing Section 1939 Enlargement 12+00 to 33+92

CONSTRUCTED BY ST. DEP'T. & W.P.A.  
 1939

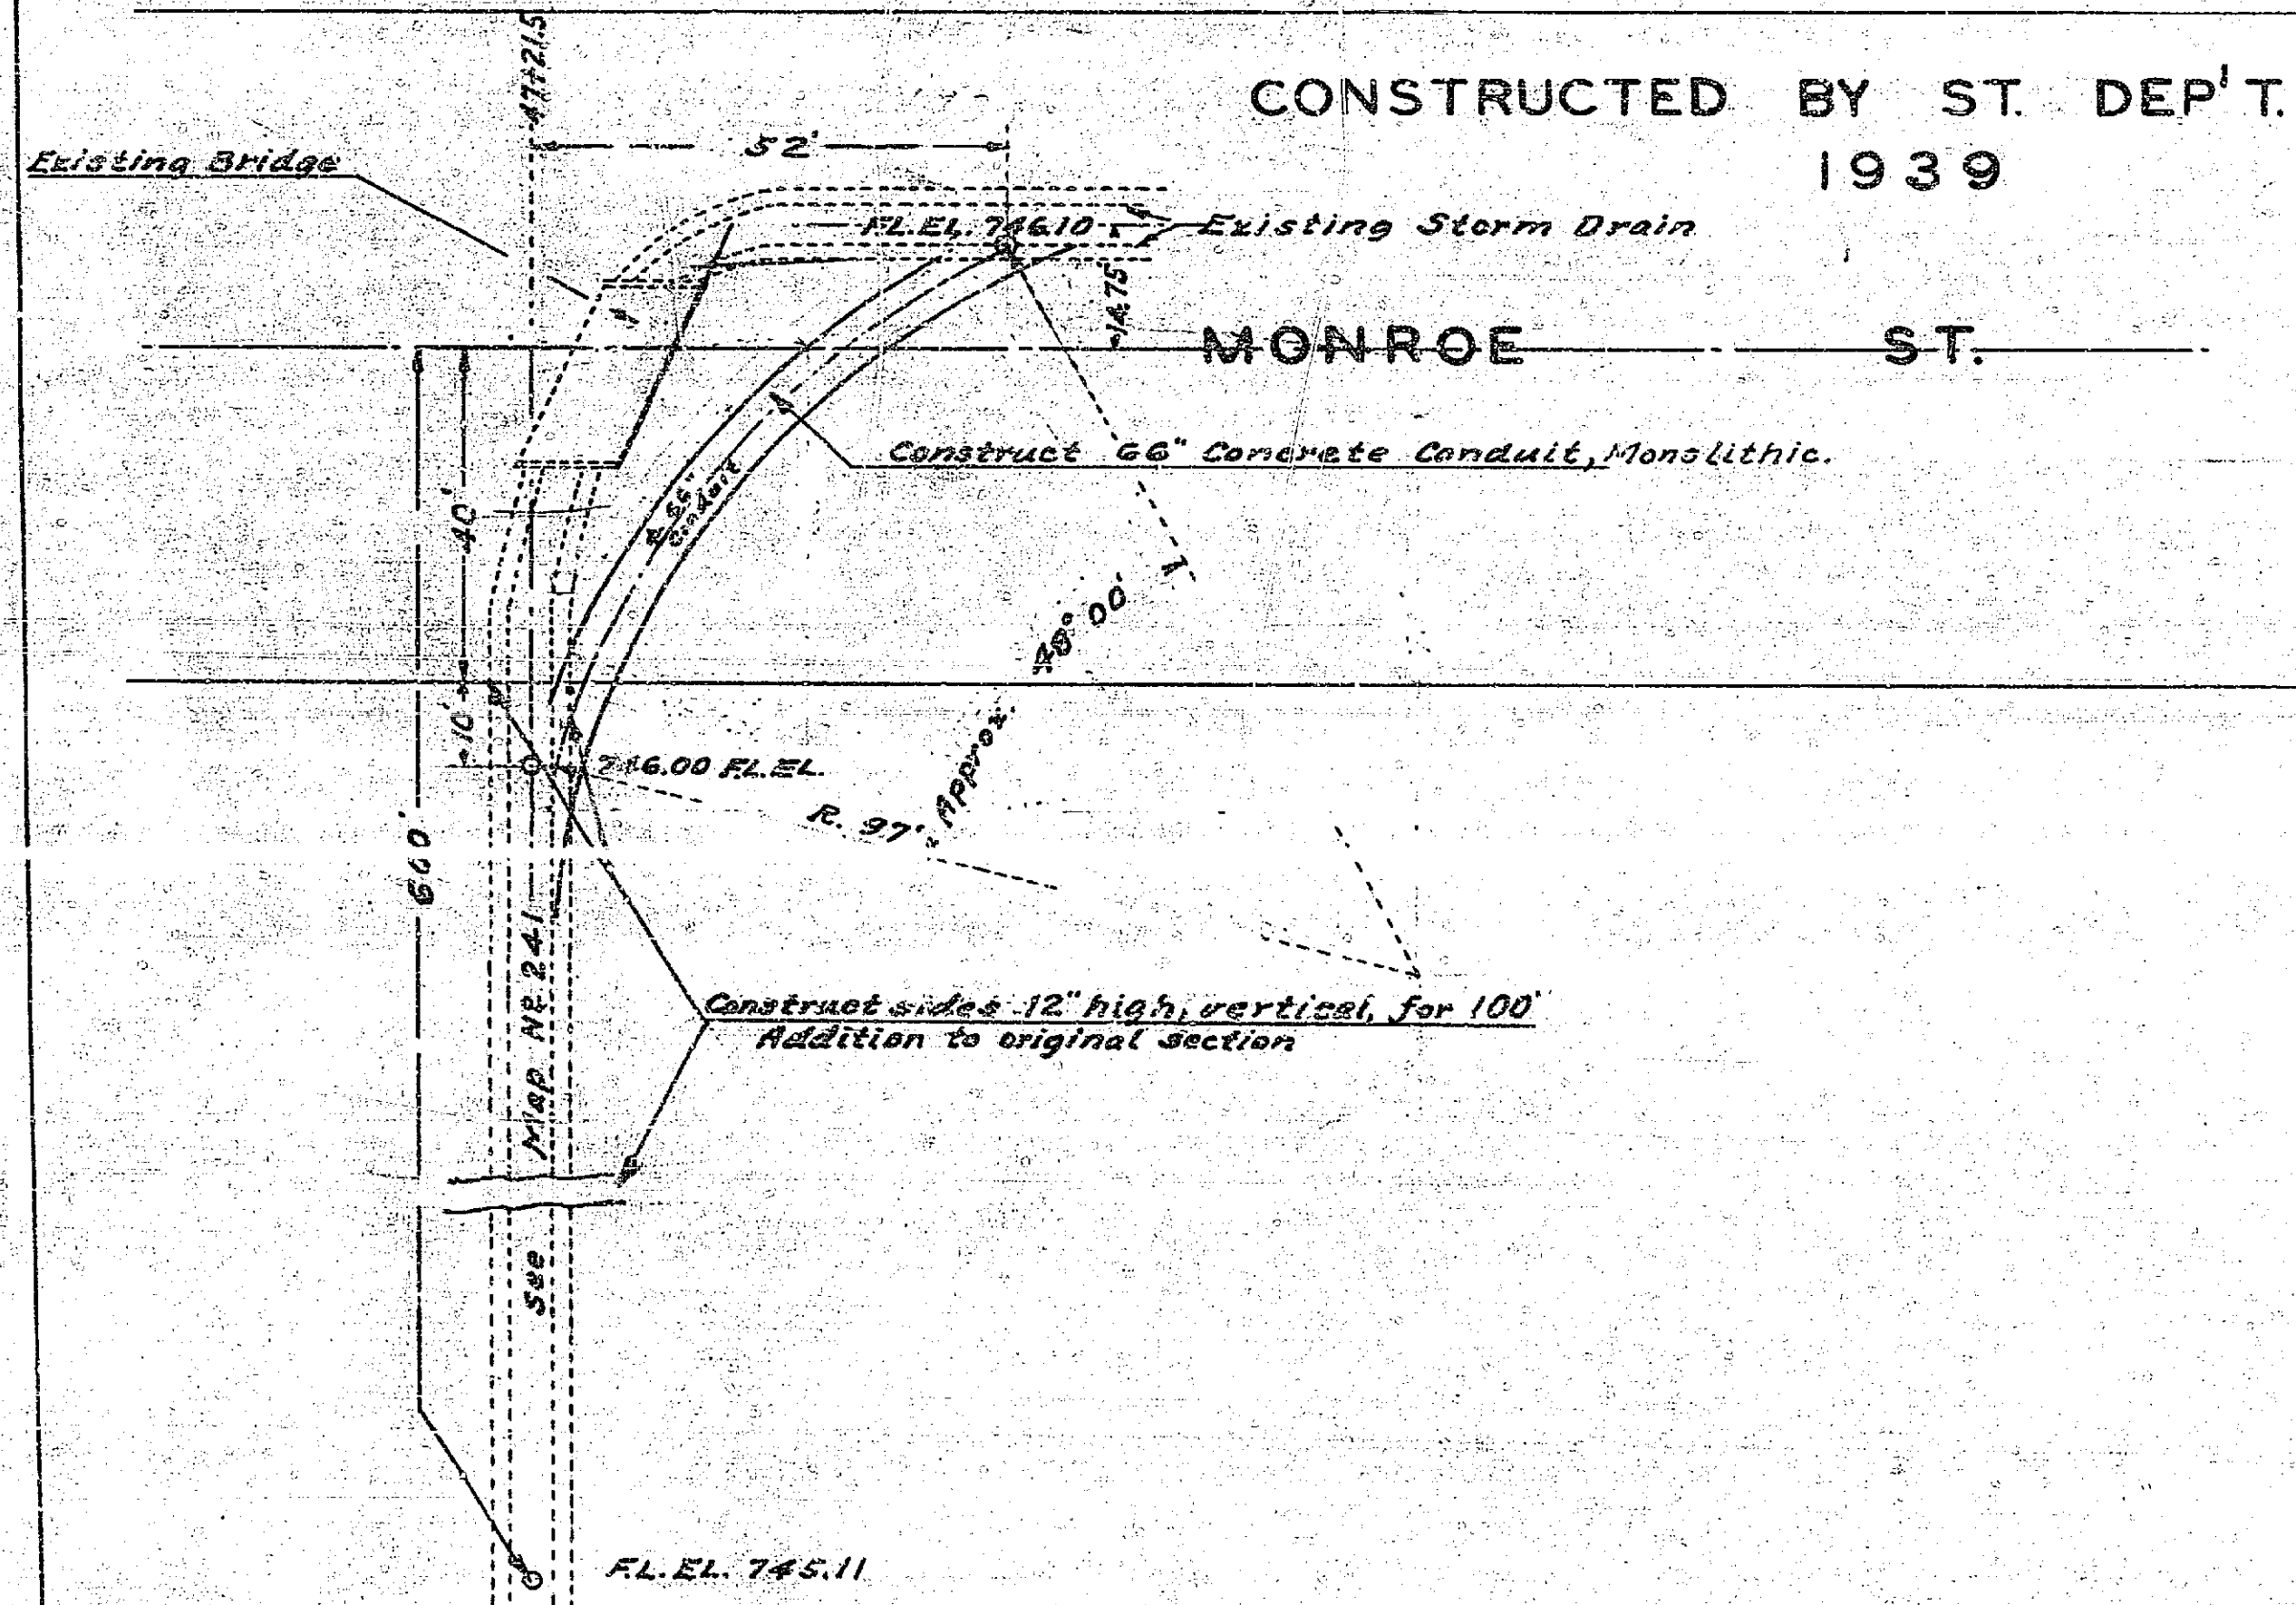

A-481

134-A