


PLAN AND PROFILE  
 NO. 137-C  
 FOR SANITARY SEWER FACILITIES AT  
 EVANS PARK  
 CITY OF RIVERSIDE  
 R.B. 534-1 APR. 1954  
 " 31 - as built

Scale: 1" = 20'

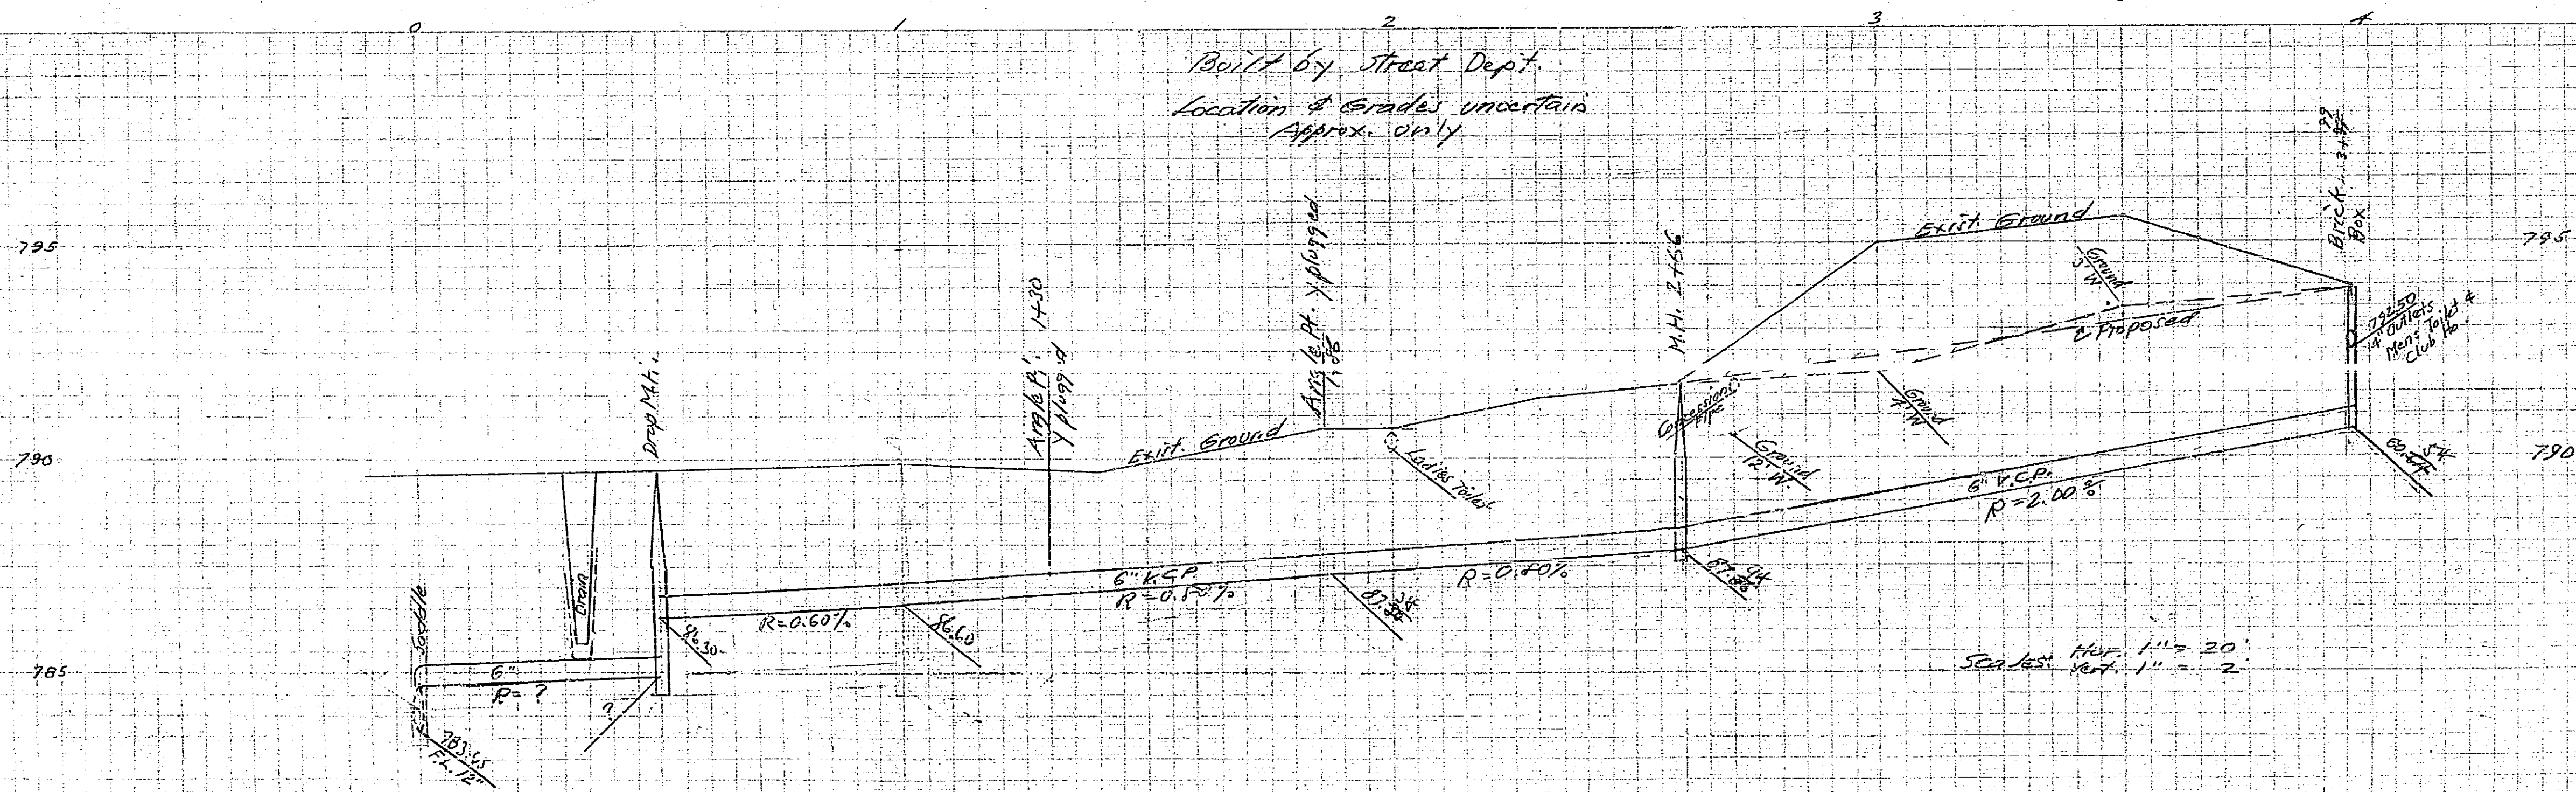

Built by Street Dept.  
 Location & Grades uncertain  
 Approx. only

Scale: Hor. 1" = 20'  
 Vert. 1" = 2'

137C