


1525

See Sheet No 210

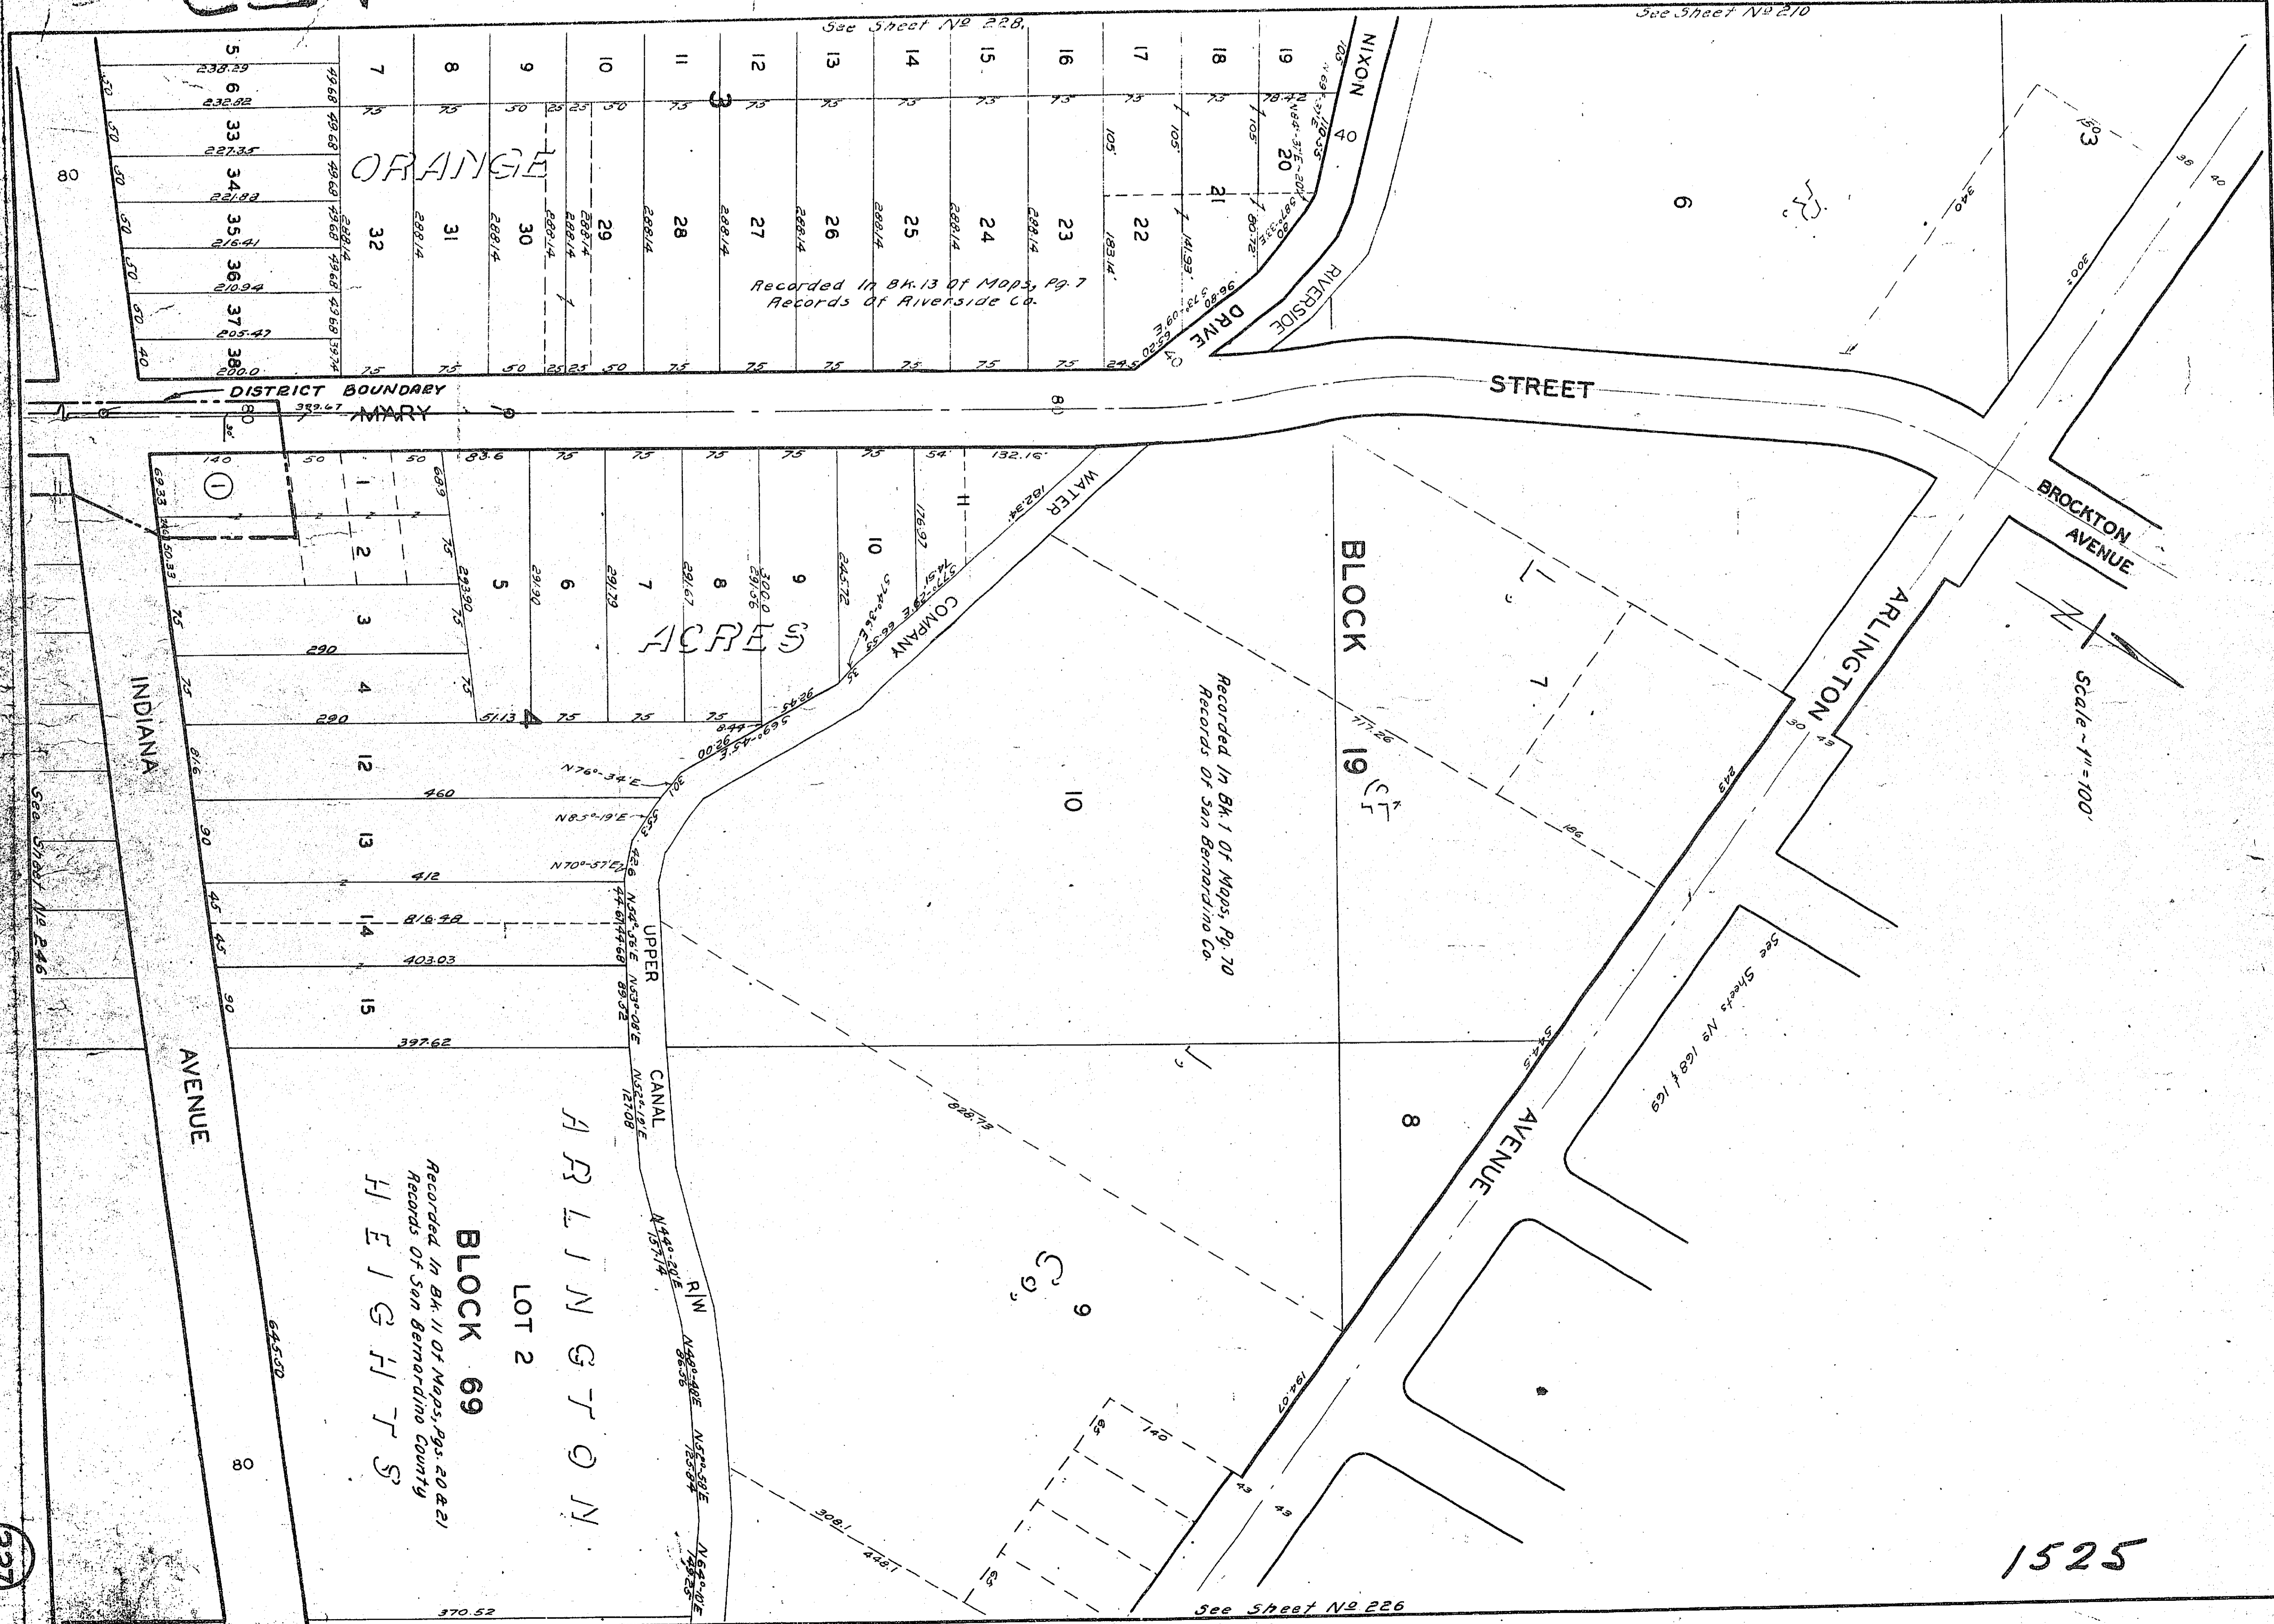

Scale - 1" = 100'

1525

227

See Sheet No 226

ASSESSMENT NO. 409  
**DIAGRAM**


EXHIBITING MARY STREET SANITARY SEWER DISTRICT

IN THE CITY OF RIVERSIDE ON WHICH WORK HAS BEEN DONE UNDER THE OFFICIAL CONTRACT OF THE SUPERINTENDENT OF STREETS OF SAID CITY WITH DATED AUGUST 15, 1955

FOR THE CONSTRUCTION OF APPURTENANCES  
 A SANITARY SEWER AND  
 AS IS MORE PARTICULARLY DESCRIBED IN SAID CONTRACT TO WHICH REFERENCE IS HEREBY MADE FOR FURTHER PARTICULARS, SAID DIAGRAM ALSO SHOWS THE RELATIVE LOCATION OF EACH LOT, PORTION OF LOT, PIECE OR PARCEL OF LAND ASSESSED FOR THE WORK DONE NUMBERED IN CIRCLES TO CORRESPOND TO THE RED INK NUMBERS IN THE ASSESSMENT  
 HEREIN FIGURES NEXT TO PROPERTY LINES SHOW LENGTH OF SAID LINES IN FEET THE MARK (1) MEANS FEET. PROPERTY LINES THAT DIFFER FROM THE RECORDED SUBDIVISIONS ARE SHOWN BY BROKEN LINES THE DISTRICT BENEFITED IS BOUNDED BY A HEAVY DASHED LINE  
 PROPERTY COVERED BY THIS ASSESSMENT IS SHOWN ON THE FOLLOWING RECORDED MAPS:

- ORANGE ACRES MB.13 PG. 7 REC. RIV. CO.
- ORANGE ACRES NO 2 MB 14 PG. 2 REC. RIV. CO.
- ORANGE VILLAGE TRACT MB 23 PG. 68 REC. RIV. CO

HEREIN THE LEGEND OF THE DIFFERENT KINDS OF WORK PERFORMED IS SHOWN AS FOLLOWS:

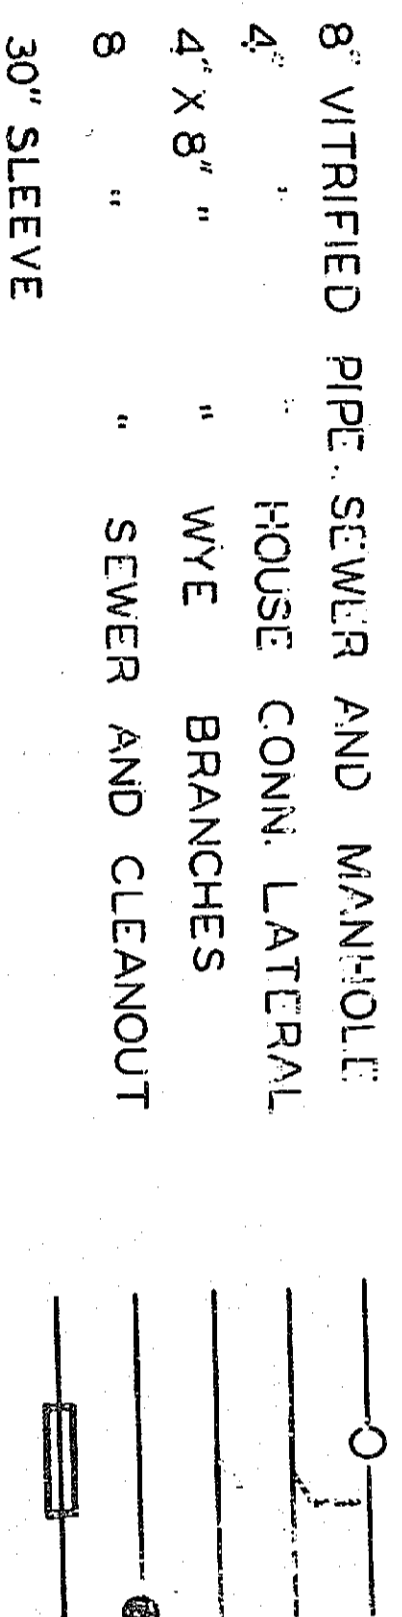

CITY ENGINEER OF THE CITY OF RIVERSIDE  
 THE FOLLOWING IS A STATEMENT OF AMOUNTS OF DIFFERENT KINDS OF WORK DONE BY C.O. BRAND UNDER CONTRACT DATED AUGUST 15 1955 PURSUANT TO RESOLUTION OF INTENTION NO. 6696 ADOPTED BY THE CITY COUNCIL OF THE CITY OF RIVERSIDE ON THE 24TH DAY OF MAY 1955

17 89.85	LIN. FT.	8" VIT. CLAY PIPE SEWER
646.00	LIN. FT.	4" VIT. CLAY PIPE SEWER
43		8" X 4" STD. WYE BRANCHES
6		STD. MANHOLES
1		STD. CLEANOUT
50	LIN. FT.	30" SLEEVE

AT SAID CITY OF RIVERSIDE THIS 1ST DAY OF NOVEMBER, 1955

CITY ENGINEER  
 OF THE CITY OF RIVERSIDE

I HEREBY CERTIFY THAT THE ABOVE WORK WAS DONE IN ACCORDANCE WITH LINES AND GRADES FURNISHED BY ME AND THAT THE DIAGRAM OF THE ASSESSMENT DISTRICT FOR THE SAME IS CORRECT

CITY ENGINEER  
 OF THE CITY OF RIVERSIDE

RECORDED AT 11:00 O'CLOCK A.M.  
 THIS 14TH DAY OF DECEMBER 1955


SUPERINTENDENT OF STREETS  
 OF THE CITY OF RIVERSIDE

1525








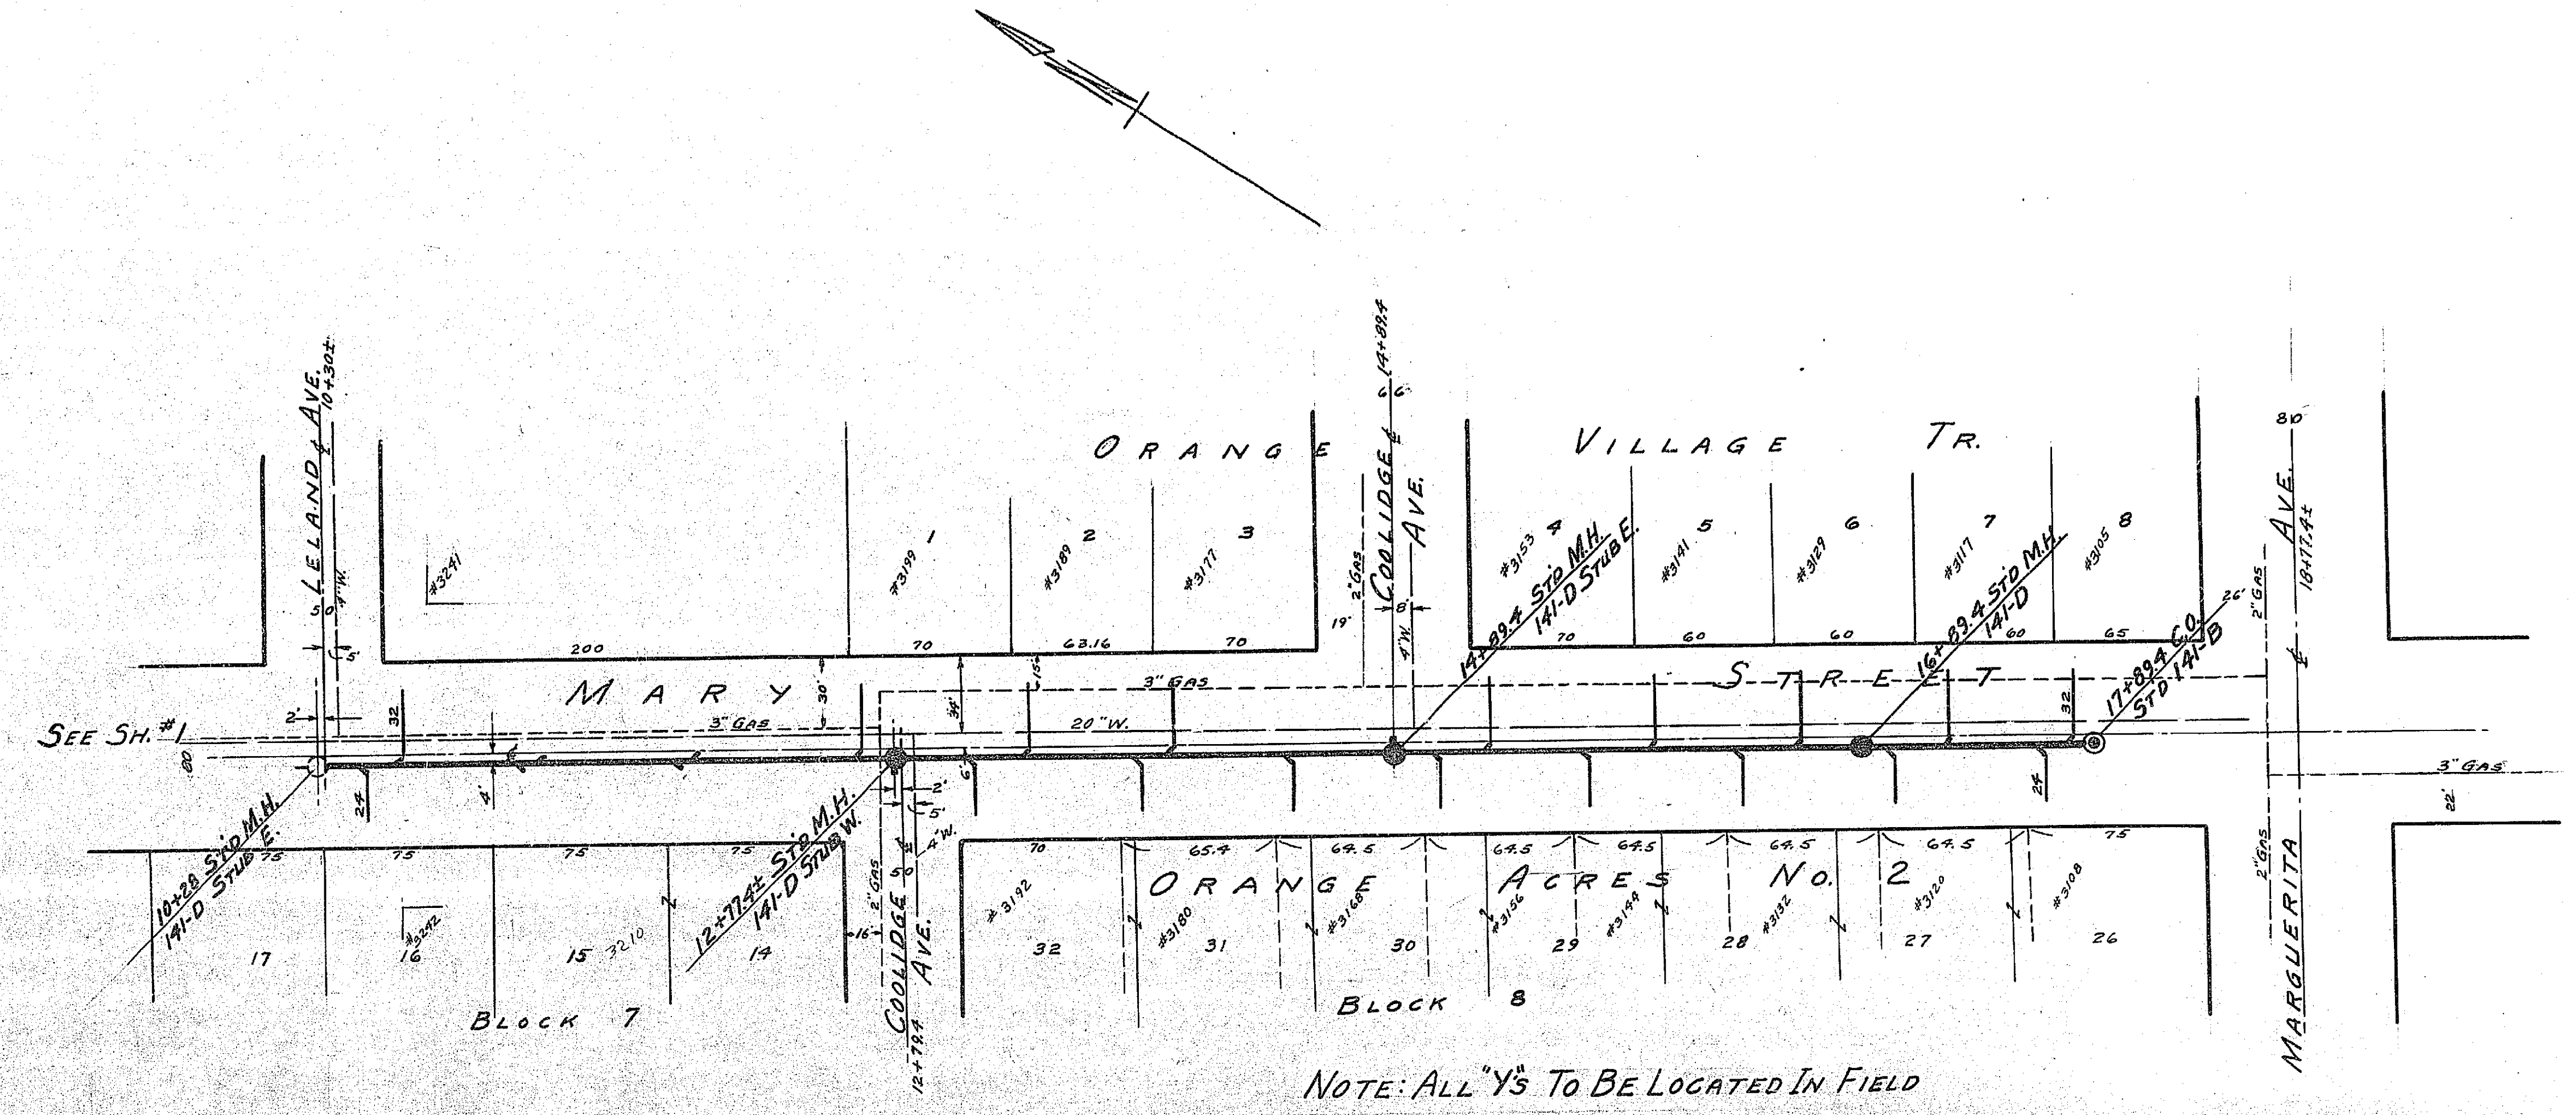

± Marguerita = 517.5  
± Orange V.O. = 516.0  
± Marguerita = 515.0  
± Orange V.O. = 514.0

NOTE: ALL "Y'S" TO BE LOCATED IN FIELD

F.B. 457-52  
F.B. 400-74

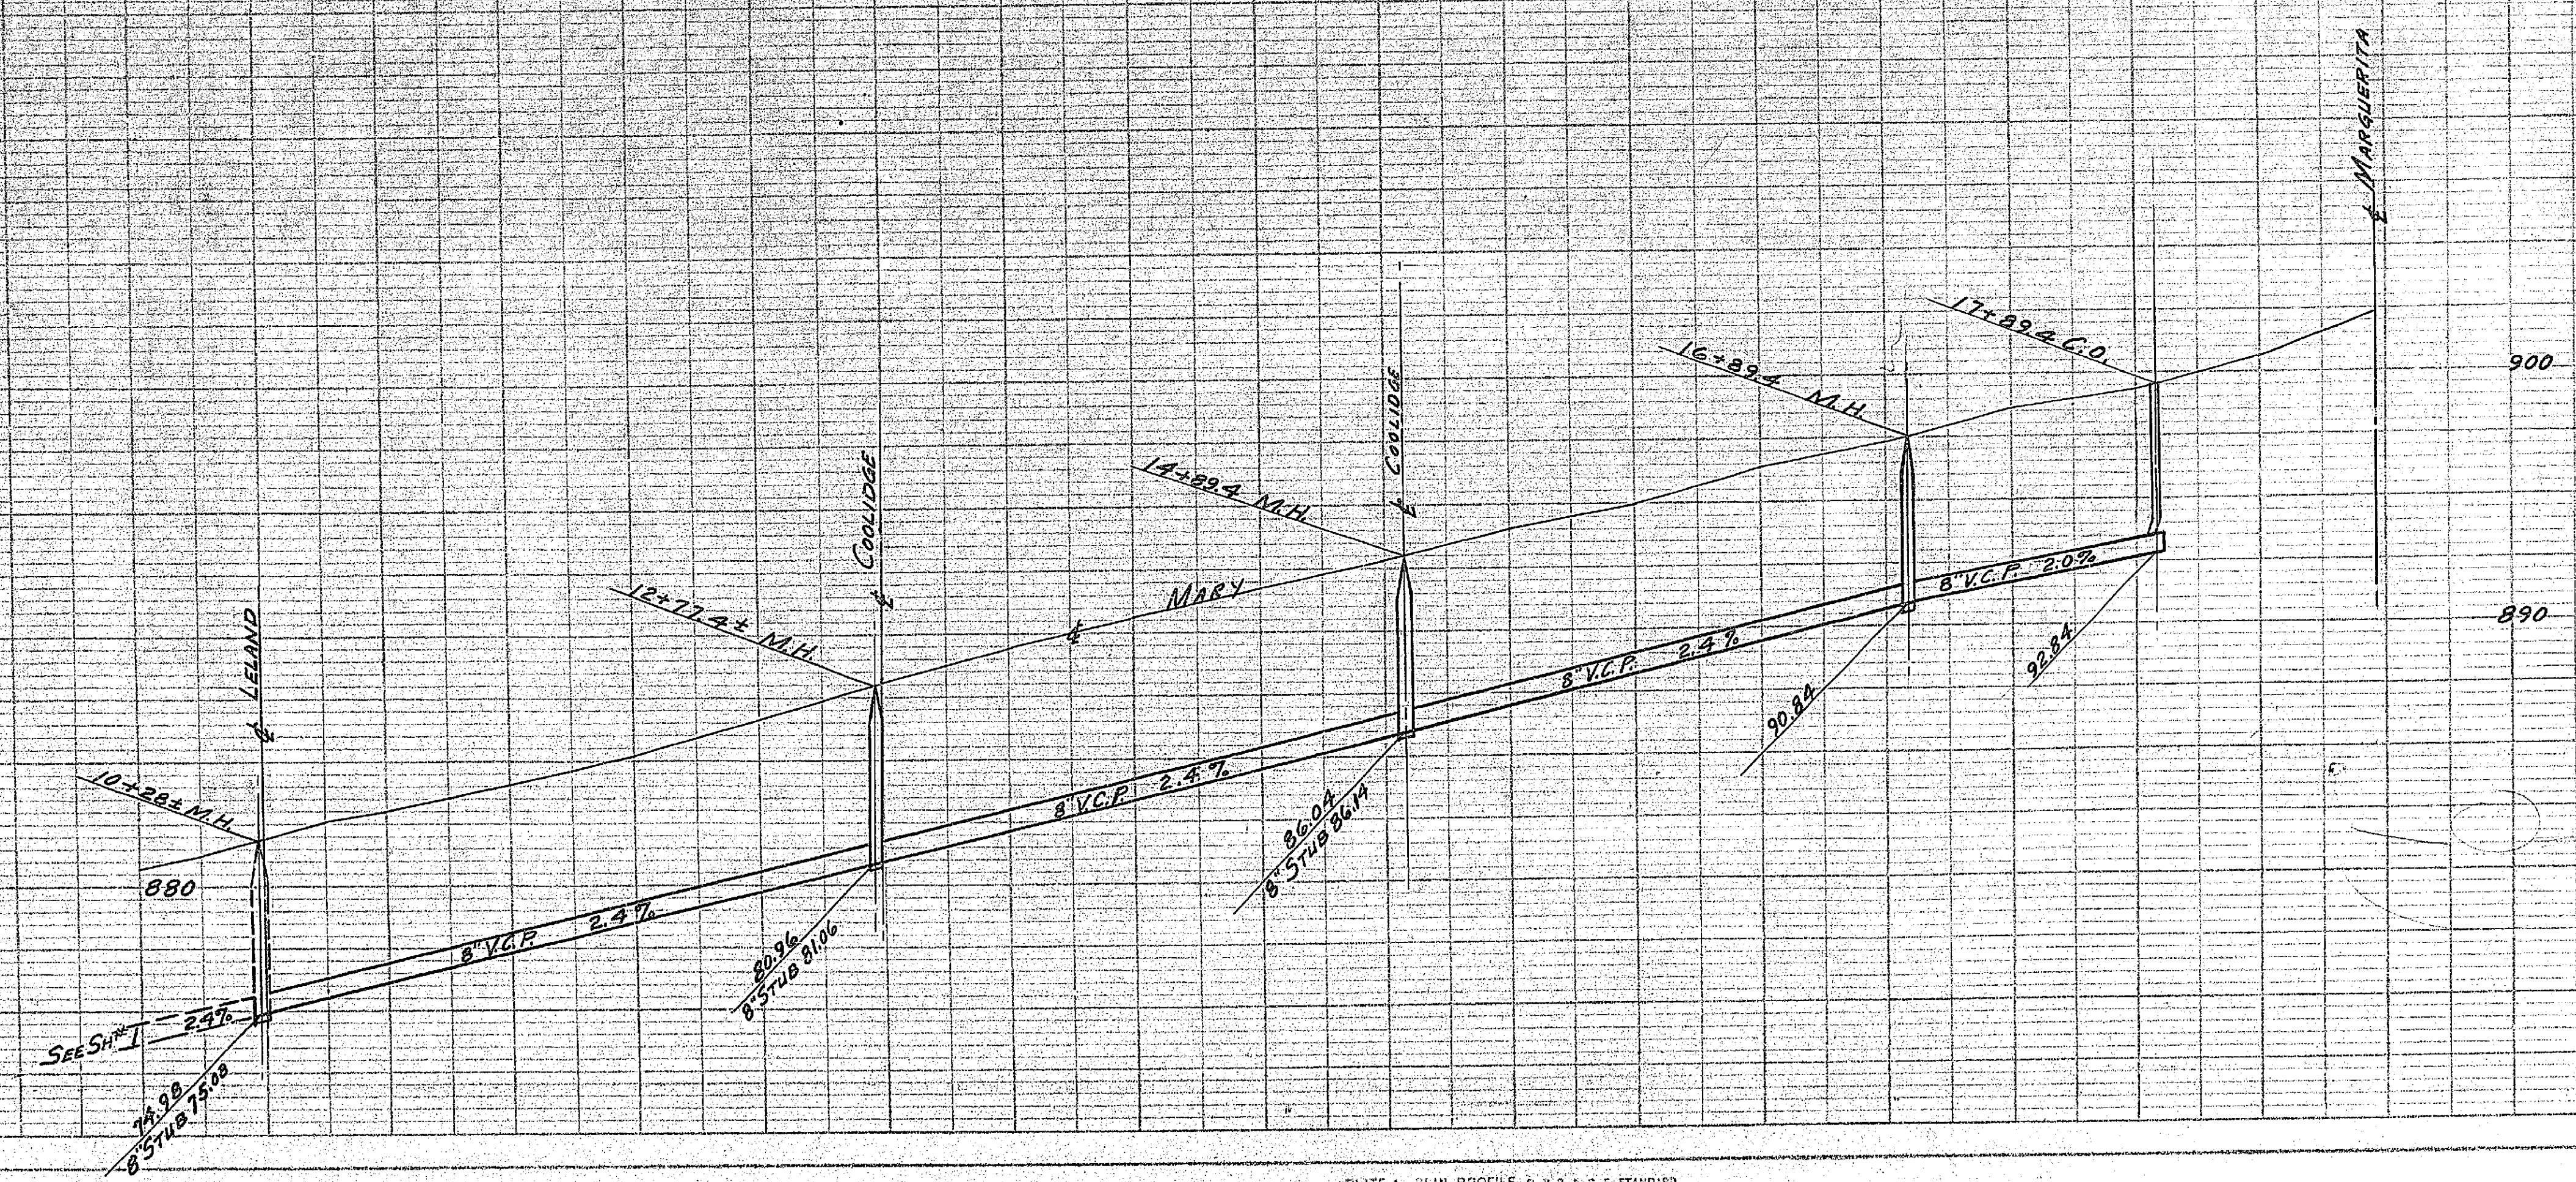


1525



Scale ~ 1" = 100'

See Sheet No 227

See Sheet No 245

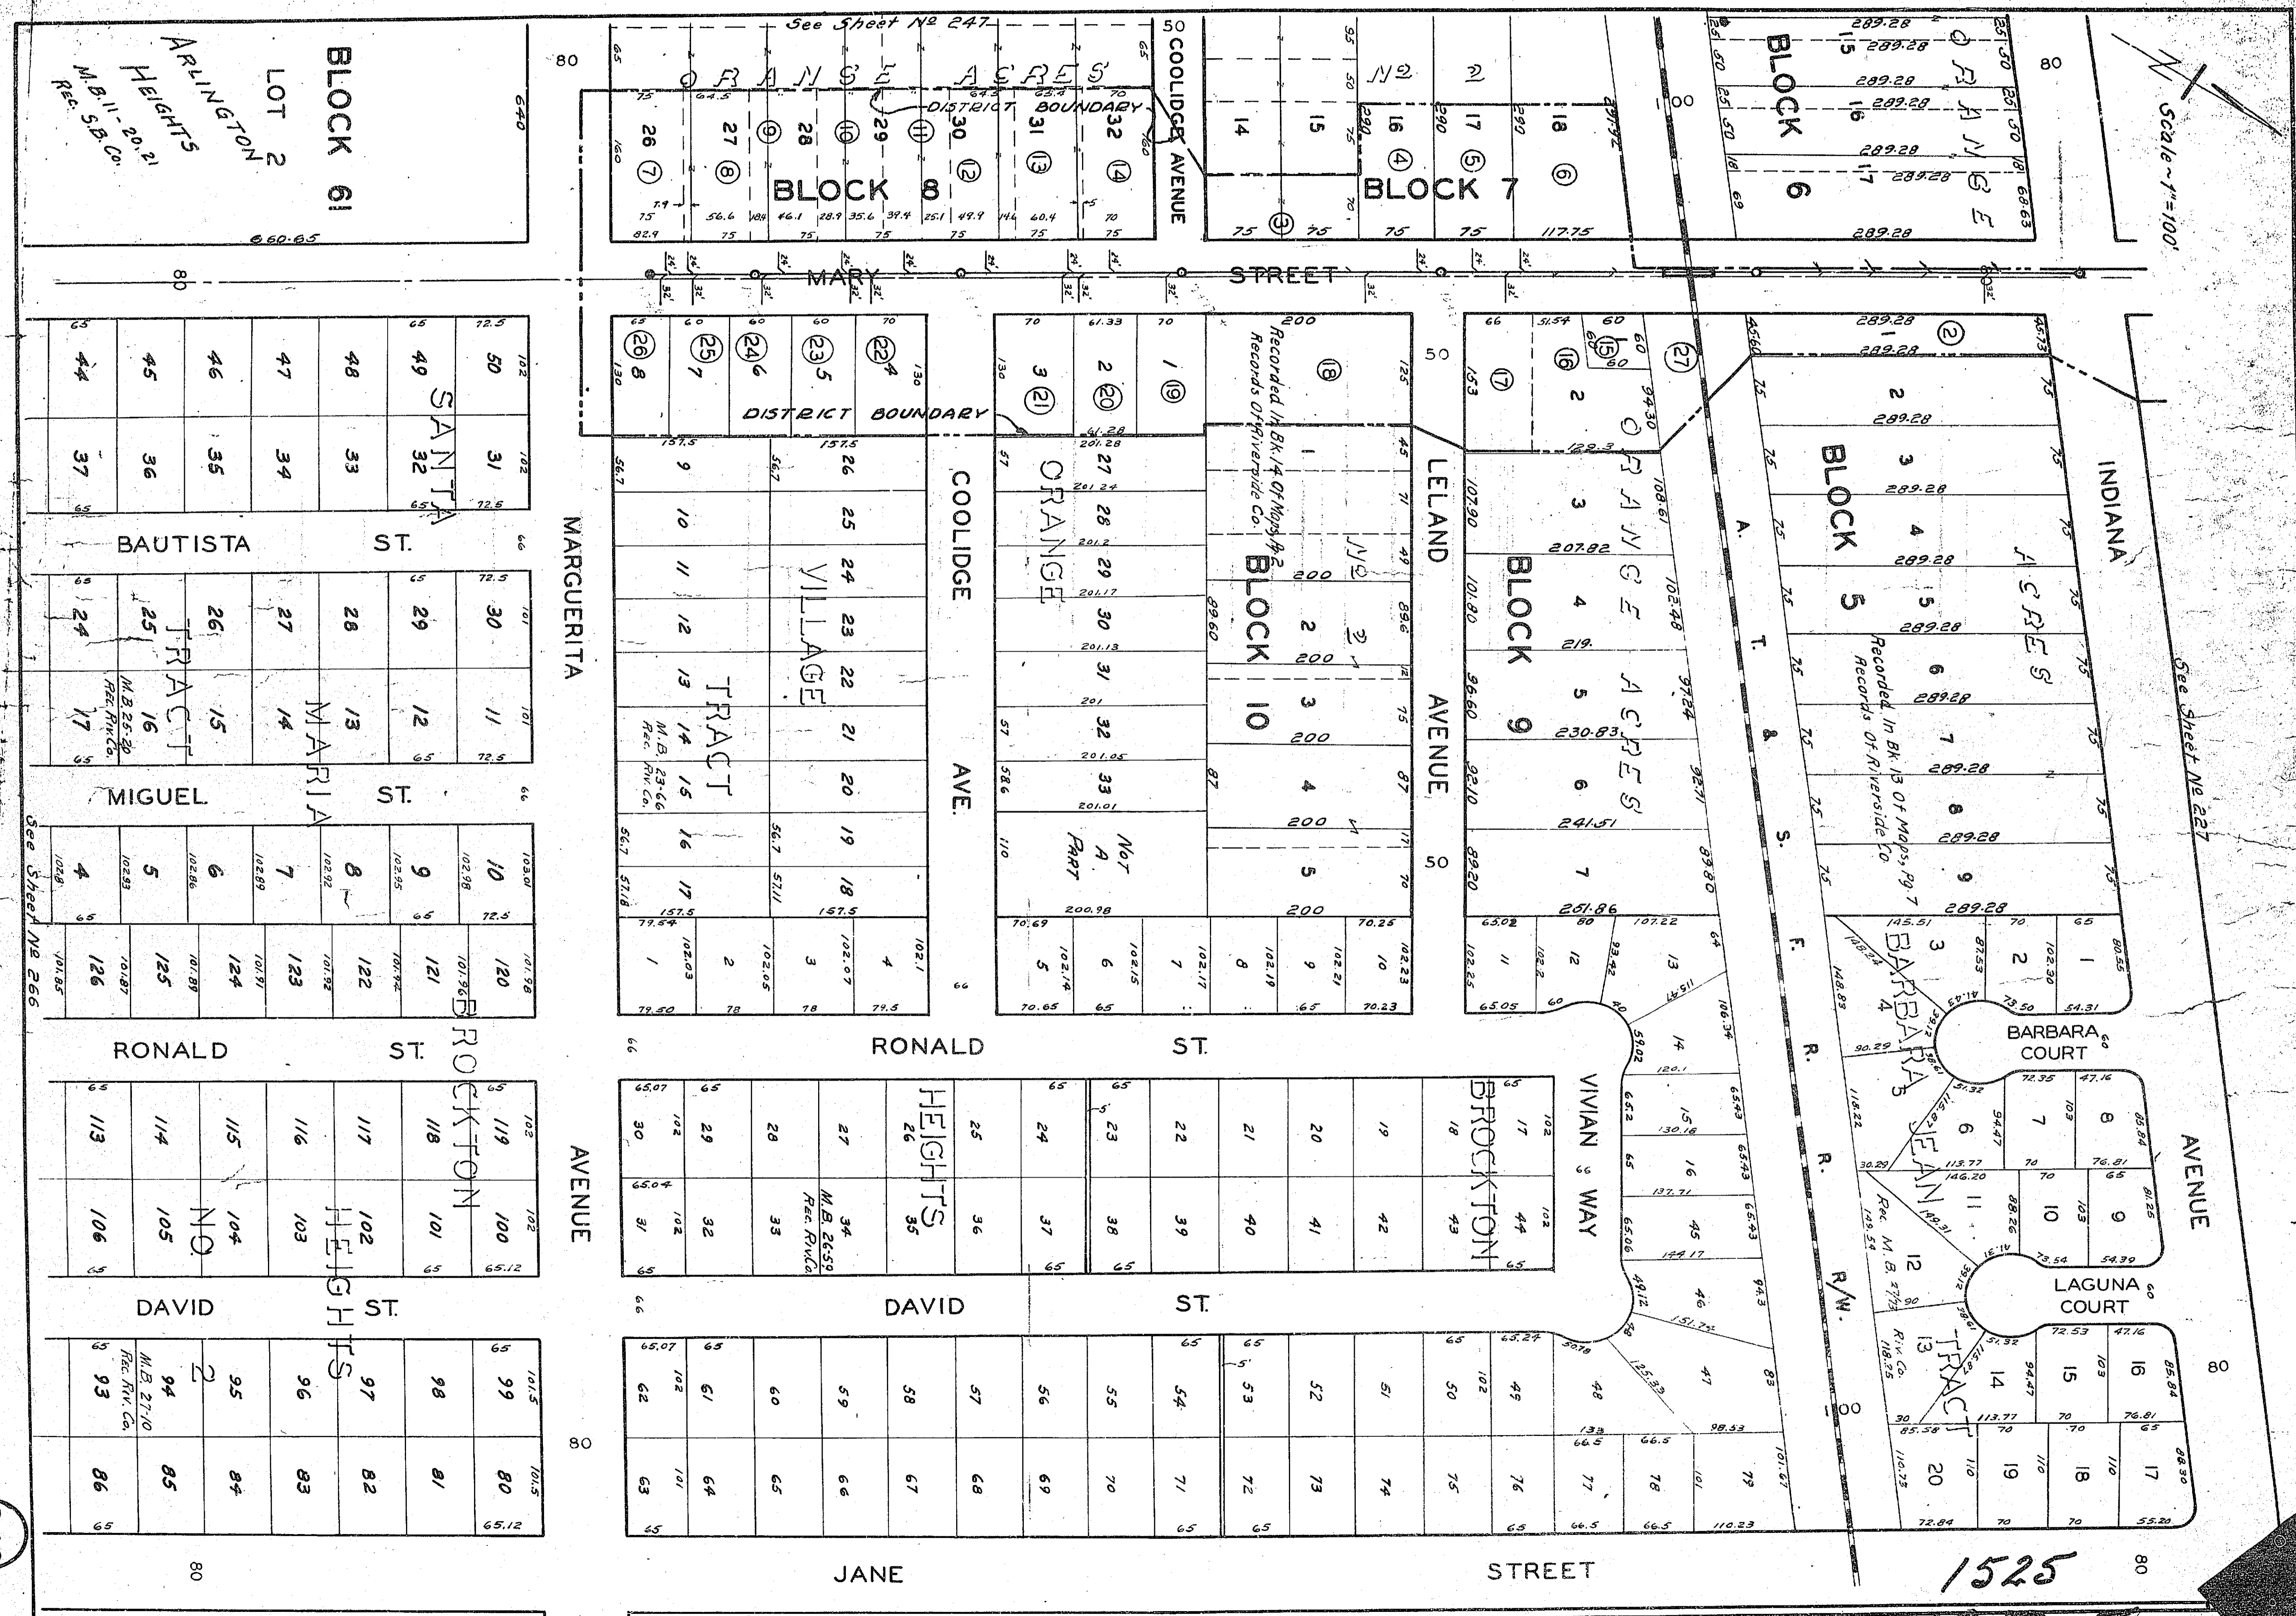

ARLINGTON HEIGHTS  
 LOT 2  
 BLOCK 61  
 M.B. 11-20-21  
 Rec. S.B. Co.

SANTA MARIA TRACT  
 49 32  
 48 33  
 47 34  
 46 35  
 45 36  
 44 37

BAUTISTA ST.  
 30 11  
 29 12  
 28 13  
 27 14  
 26 15  
 25 16  
 24 17

MIGUEL ST.  
 10 120  
 9 121  
 8 122  
 7 123  
 6 124  
 5 125  
 4 126

RONALD ST.  
 119 100  
 118 101  
 117 102  
 116 103  
 115 104  
 114 105  
 113 106

DAVID ST.  
 99 80  
 98 81  
 97 82  
 96 83  
 95 84  
 94 85  
 93 86

COOLIDGE VILLAGE  
 22 23  
 24 25  
 26 27  
 28 29  
 29 30  
 30 31  
 31 32  
 32 33

COOLIDGE AVE.  
 1 19  
 2 20  
 3 21  
 4 22  
 5 23  
 6 24  
 7 25  
 8 26  
 9 27  
 10 28  
 11 29  
 12 30  
 13 31  
 14 32  
 15 33

DAVID ST.  
 25 36  
 26 37  
 27 38  
 28 39  
 29 40  
 30 41  
 31 42

DAVID ST.  
 57 68  
 58 69  
 59 70  
 60 71  
 61 72  
 62 73  
 63 74

LELAND AVENUE  
 1 19  
 2 20  
 3 21  
 4 22  
 5 23  
 6 24  
 7 25  
 8 26  
 9 27  
 10 28  
 11 29  
 12 30  
 13 31  
 14 32  
 15 33

BROCKTON HEIGHTS  
 17 44  
 18 45  
 19 46  
 173 200

LELAND AVENUE  
 1 19  
 2 20  
 3 21  
 4 22  
 5 23  
 6 24  
 7 25  
 8 26  
 9 27  
 10 28  
 11 29  
 12 30  
 13 31  
 14 32  
 15 33

BROCKTON HEIGHTS  
 17 44  
 18 45  
 19 46  
 173 200

INDIANA AVENUE  
 1 19  
 2 20  
 3 21  
 4 22  
 5 23  
 6 24  
 7 25  
 8 26  
 9 27  
 10 28  
 11 29  
 12 30  
 13 31  
 14 32  
 15 33

INDIANA AVENUE  
 1 19  
 2 20  
 3 21  
 4 22  
 5 23  
 6 24  
 7 25  
 8 26  
 9 27  
 10 28  
 11 29  
 12 30  
 13 31  
 14 32  
 15 33

1525