


BRENTWOOD PARK NO. 2
EDGEWOOD PLACE NO. 2
M.B. 9/80


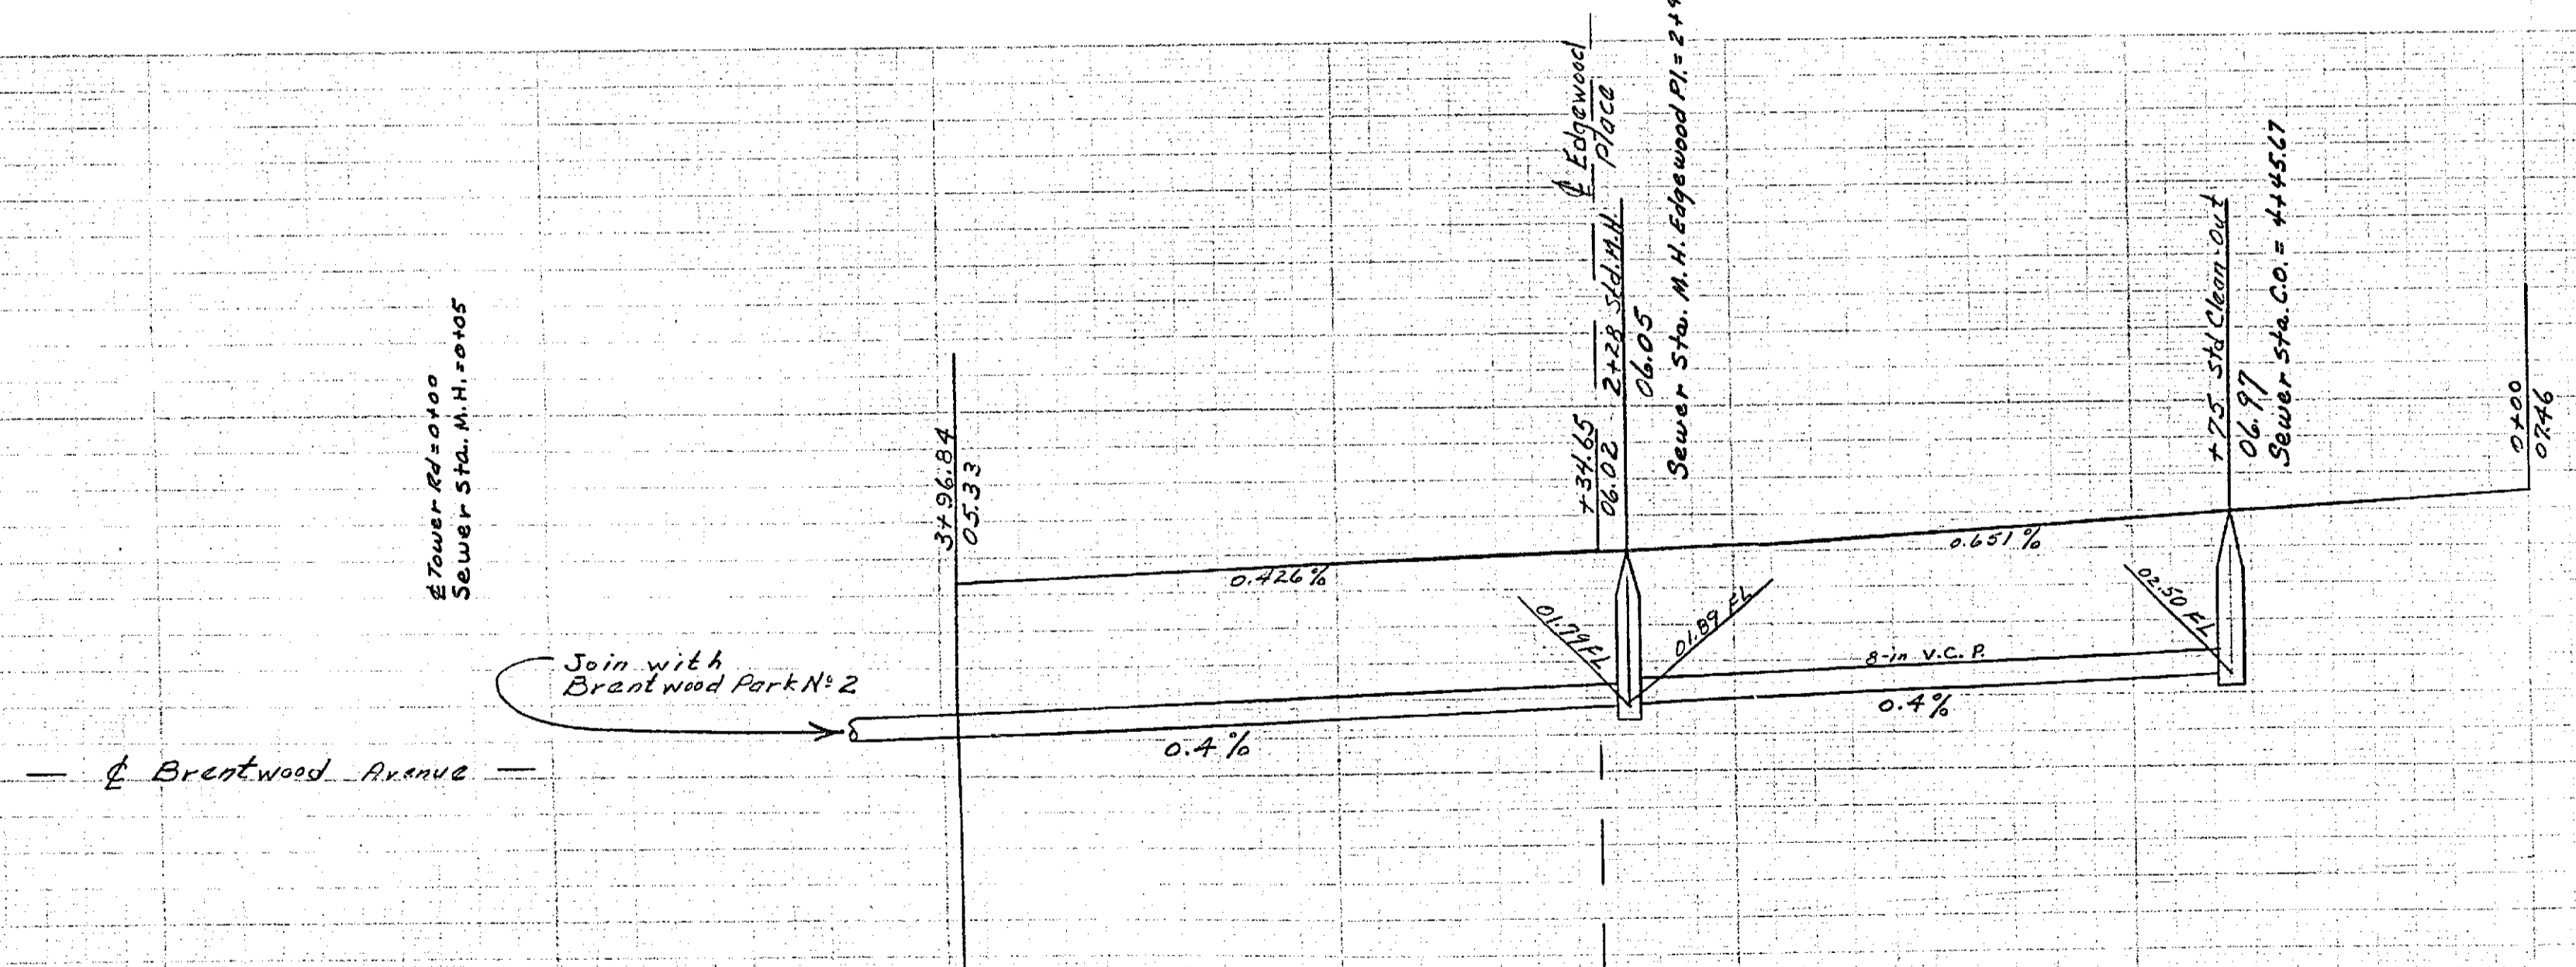


Approved *J. F. Davidson*
Date Oct 26 1955


PLAN & PROFILE
SANITARY SEWER
BRENTWOOD AVE.
BRENTWOOD PARK
UNIT 1

J.F. Davidson
Scale: Horiz. 1" = 40'
Vert. 1" = 4'

1547

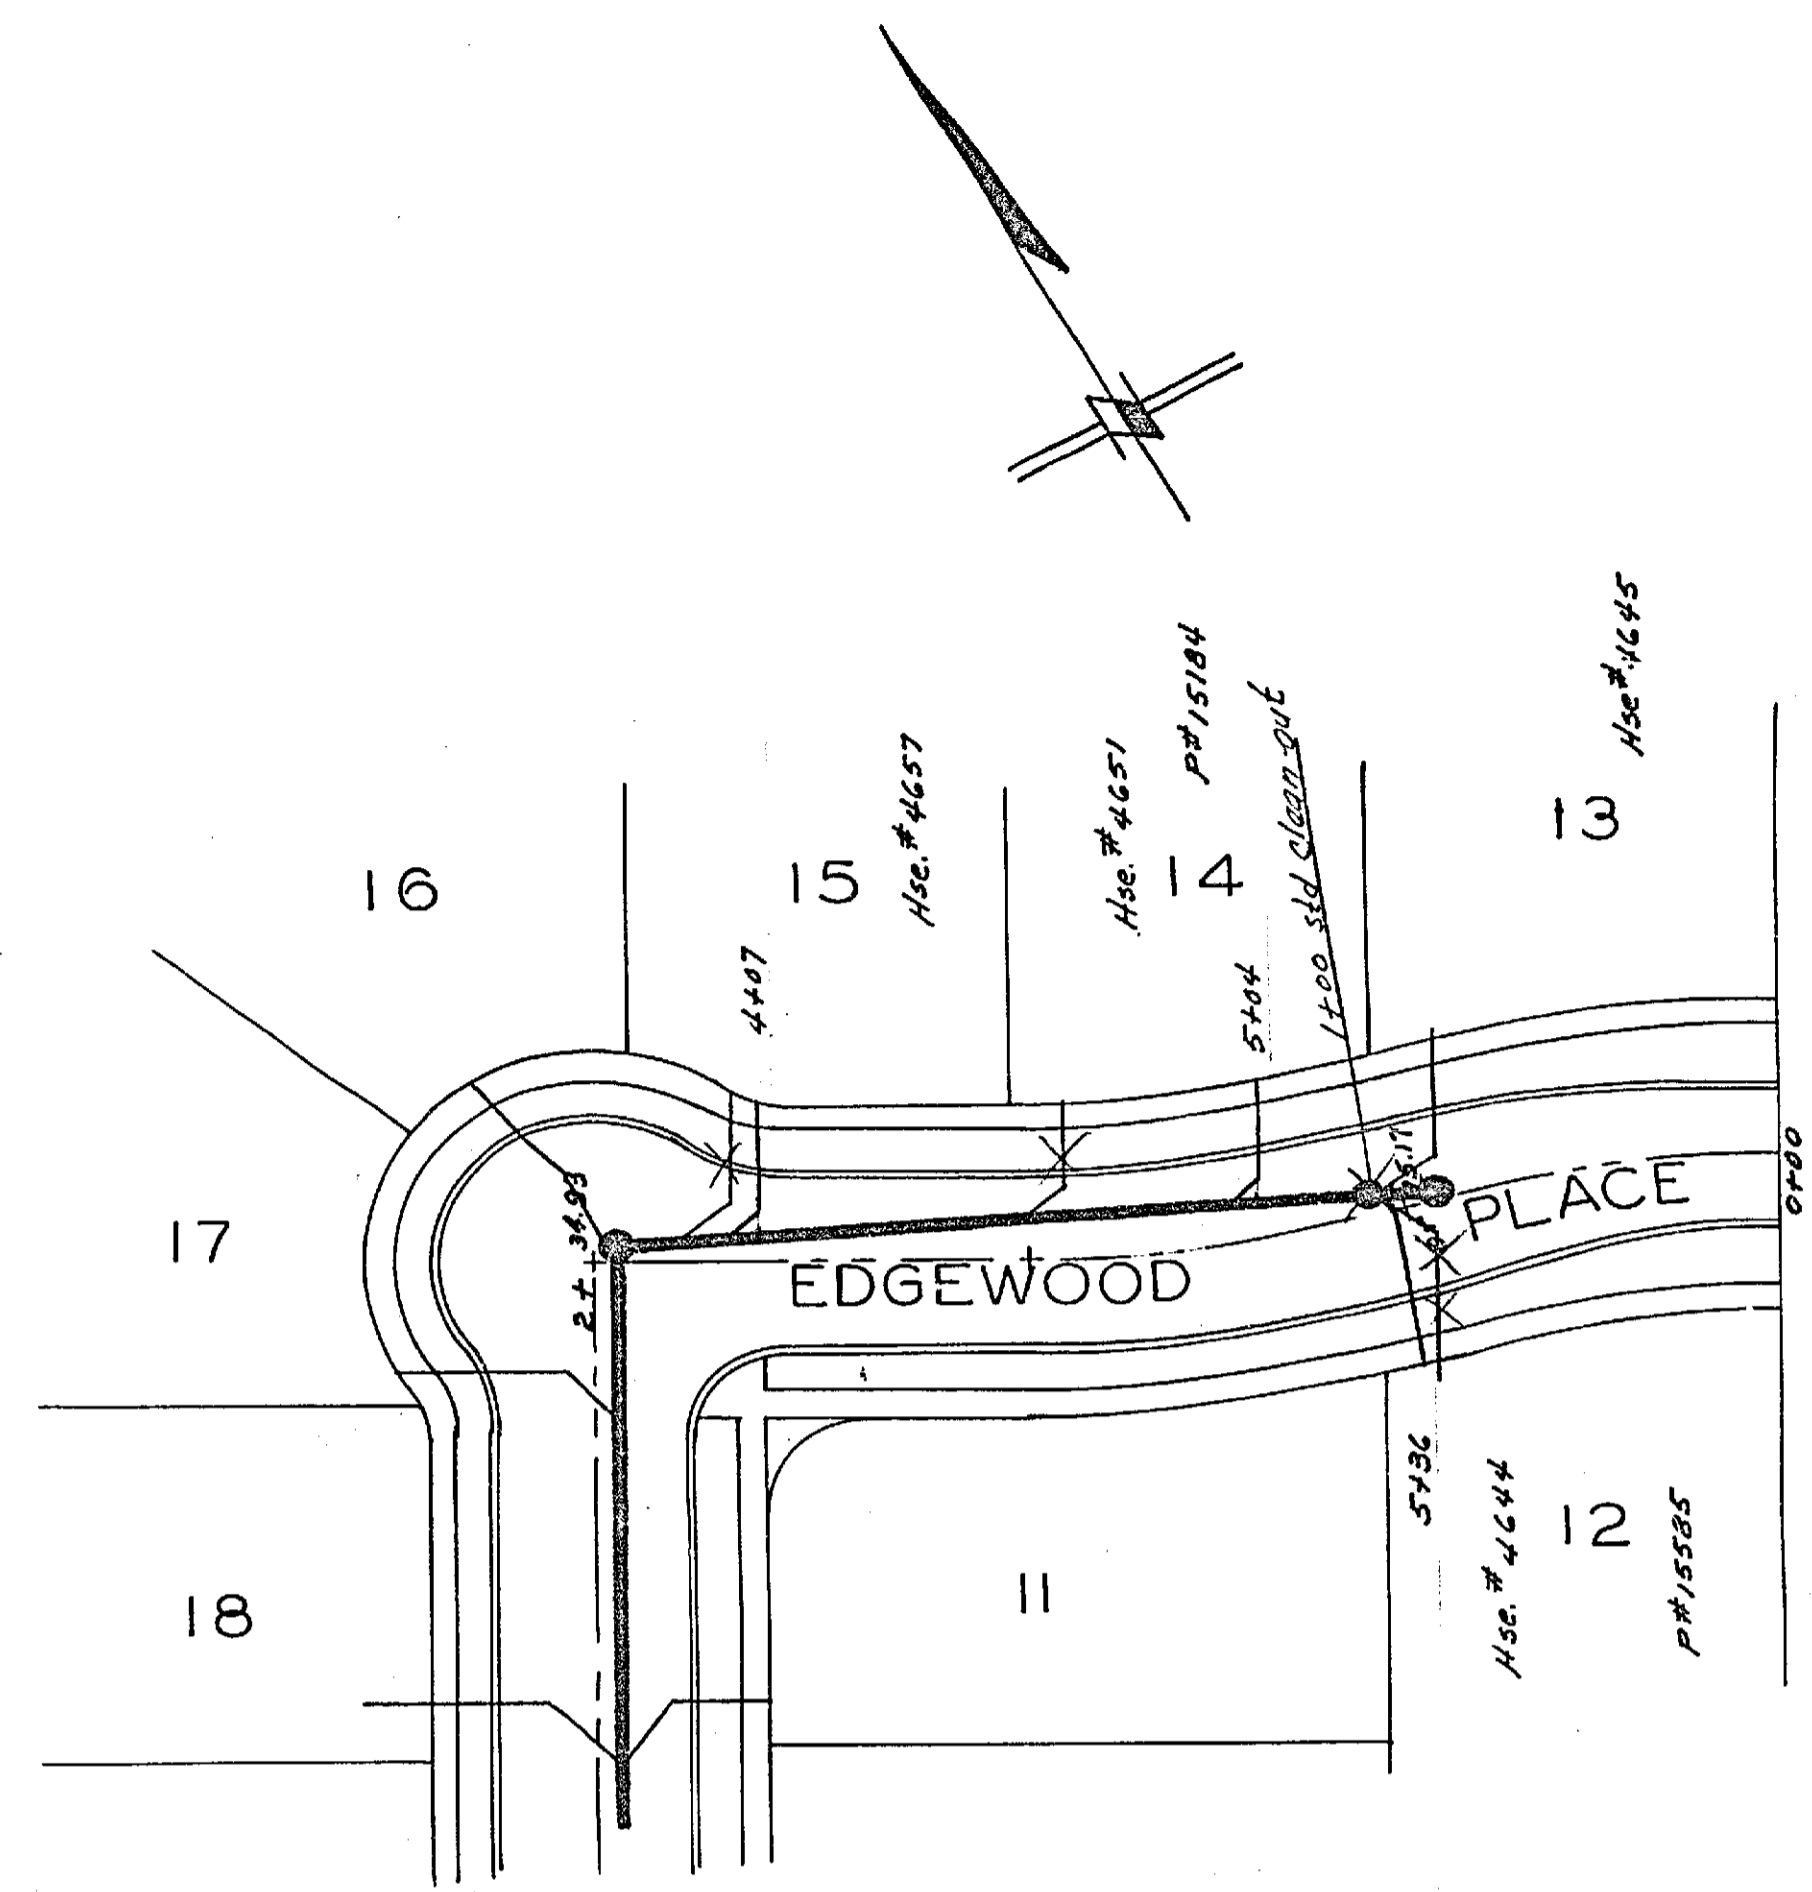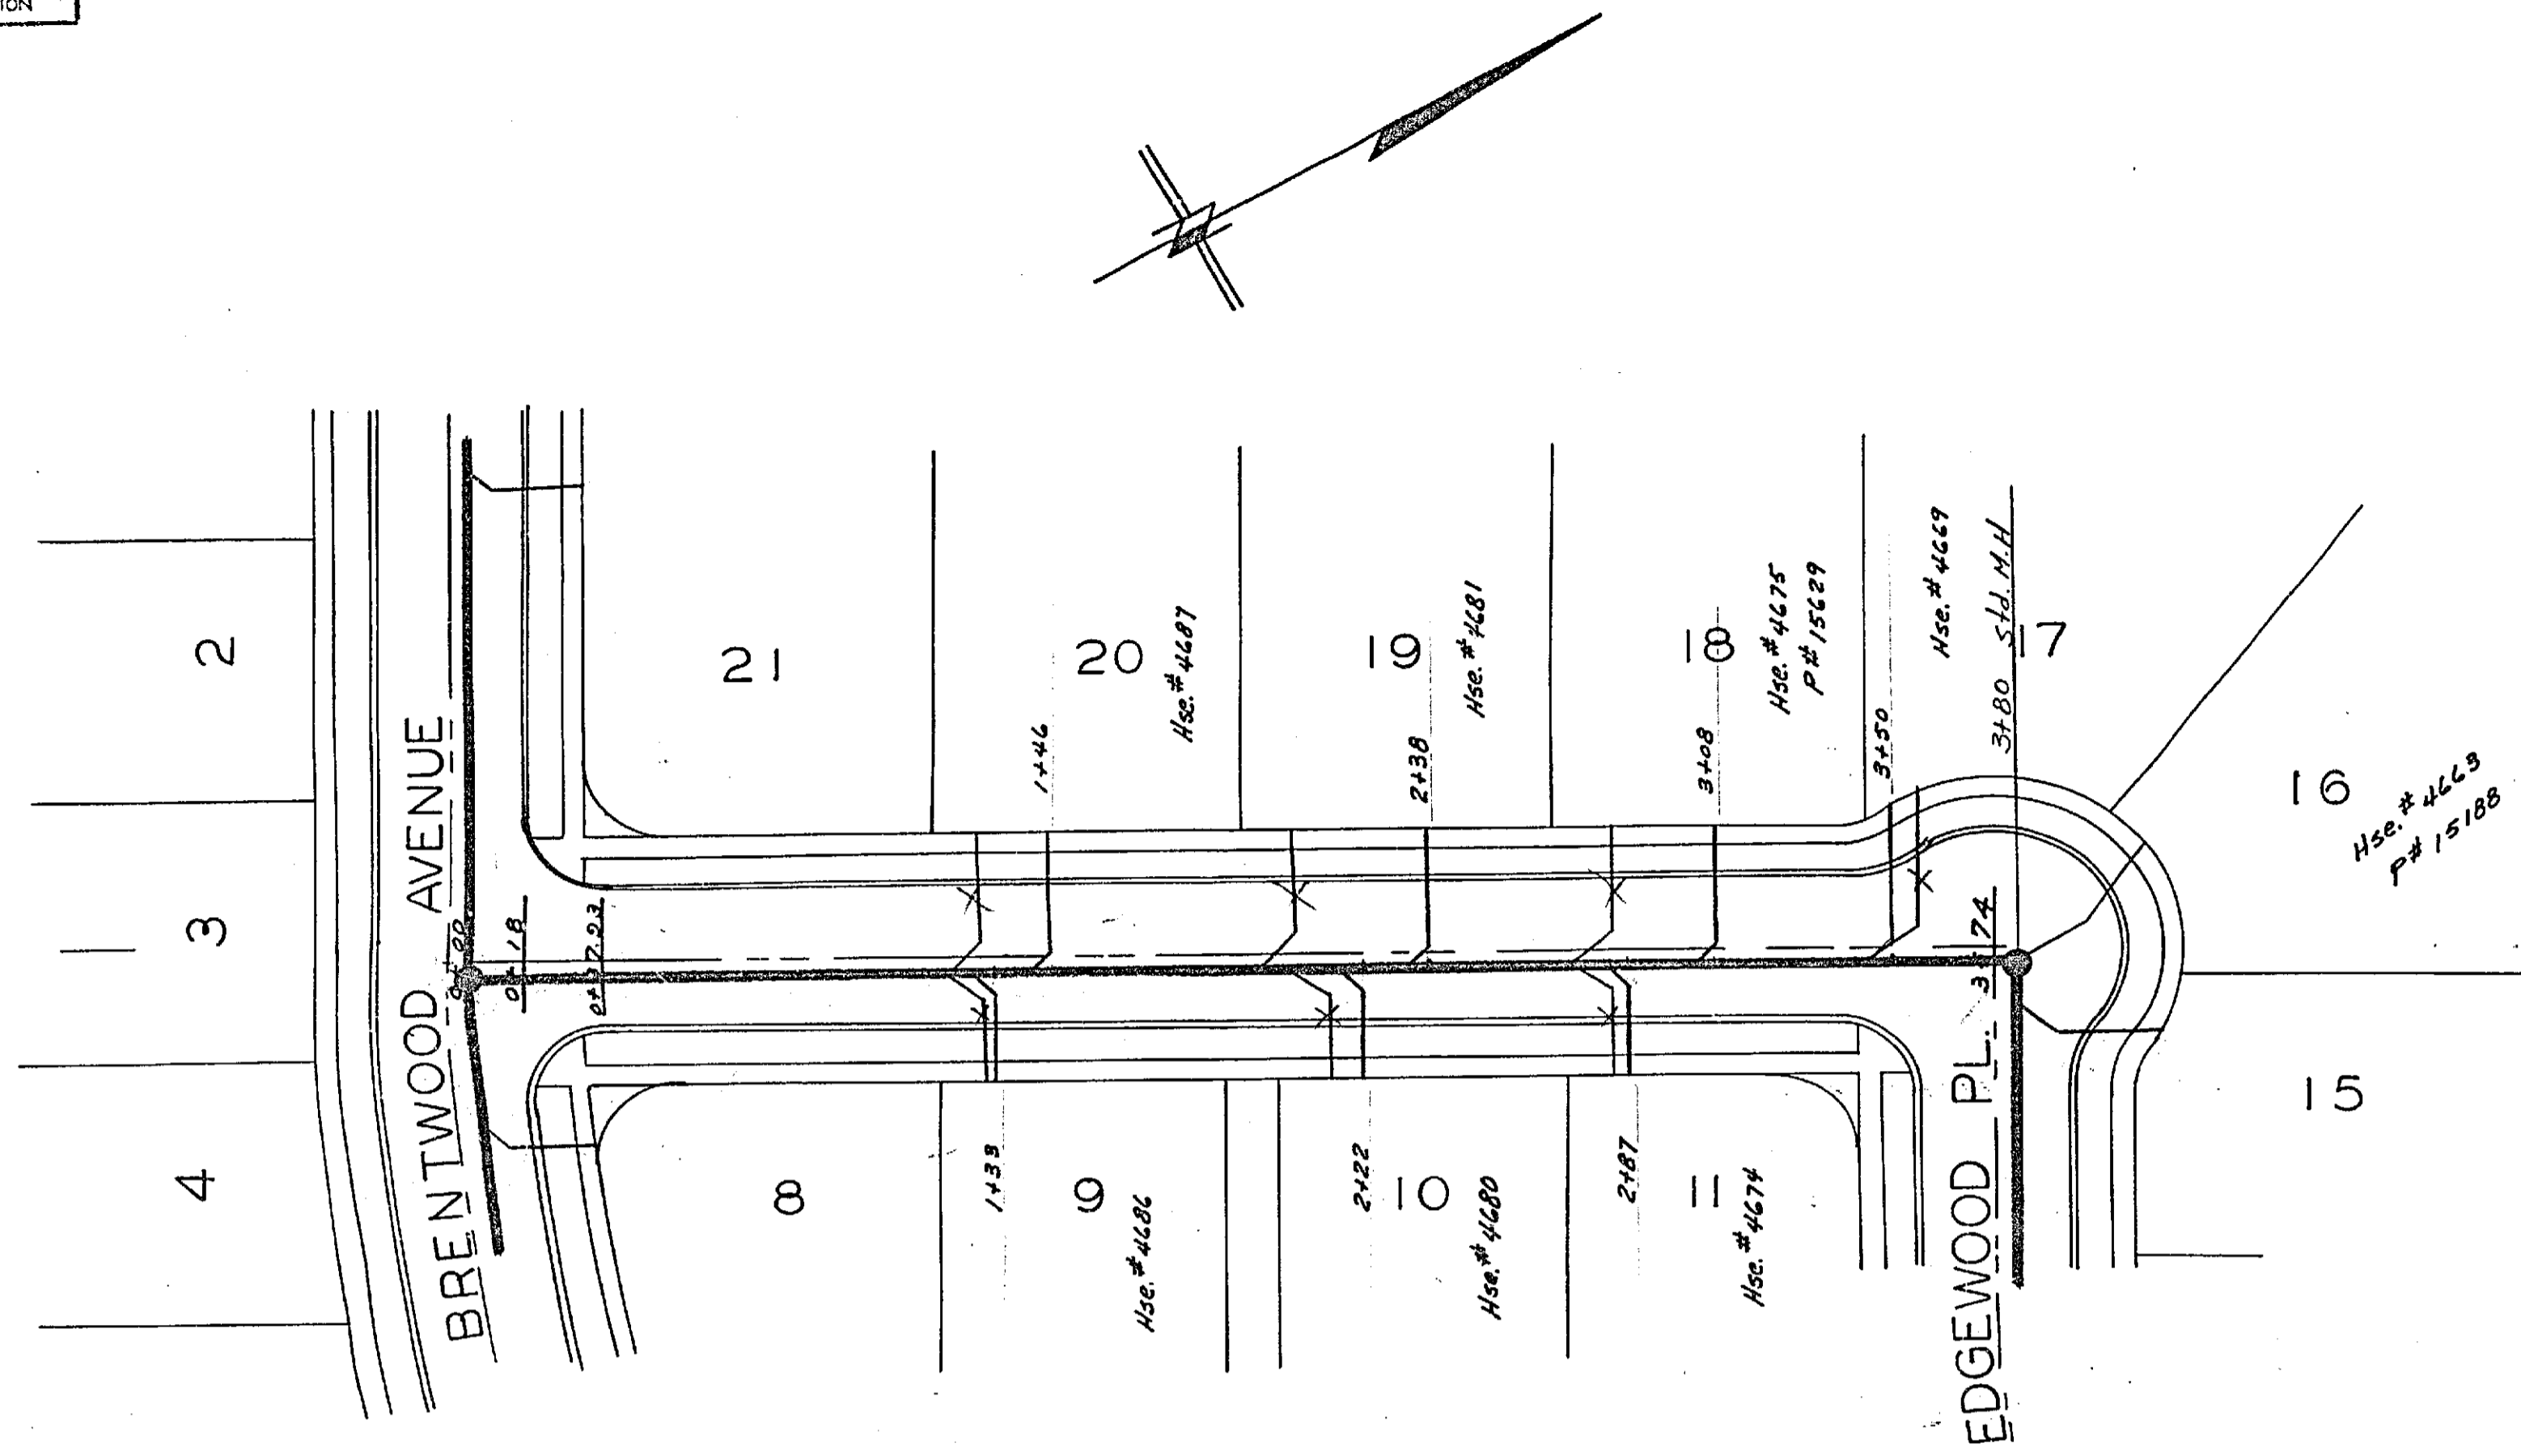

EDGEWOOD PLACE NO. 2
M.B. 9/80



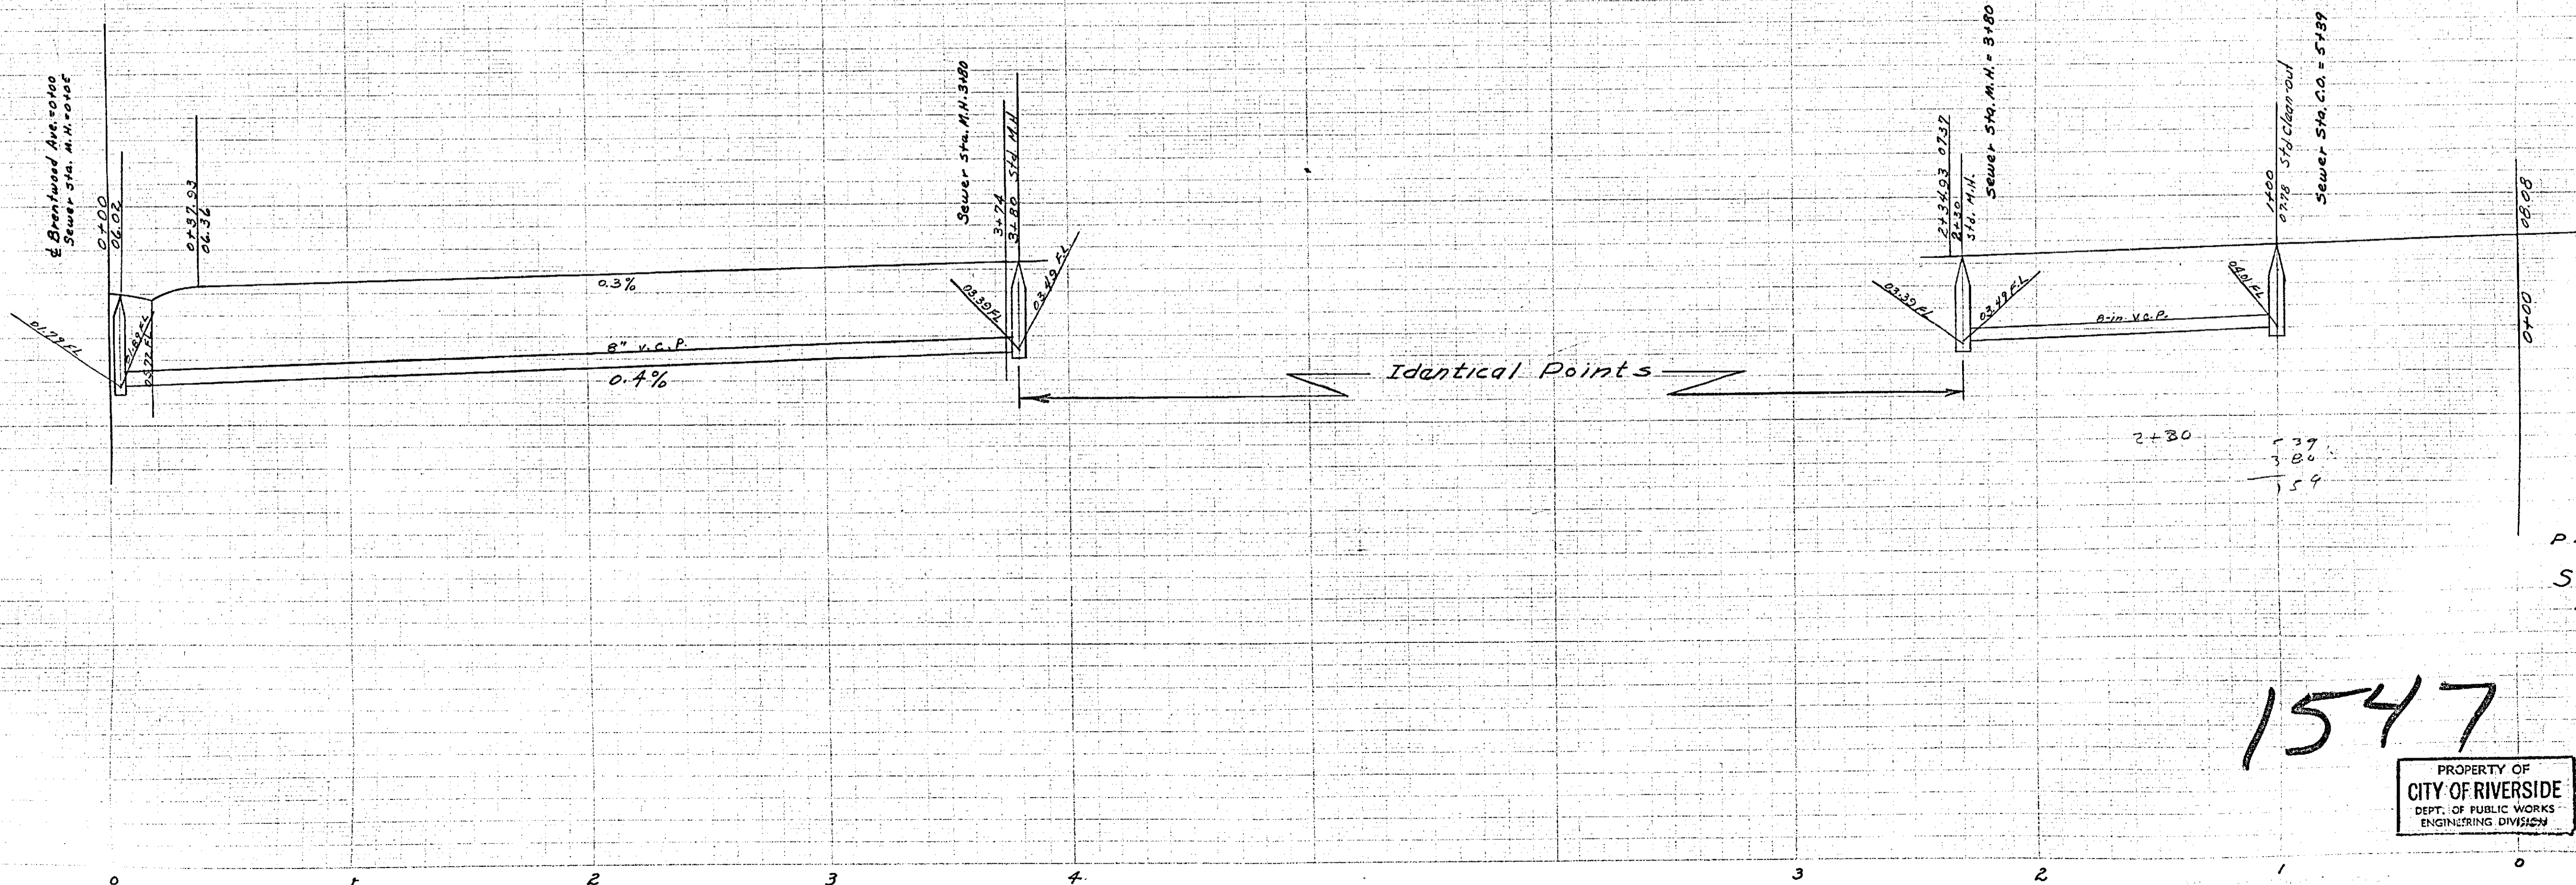


Approved *J.F. Davidson*
Date *Oct 18, 1980*

PLAN & PROFILE
SANITARY SEWER
EDGEWOOD PLACE
BRENTWOOD PARK
UNIT 1

1547

J.F. Davidson
Scale: Horiz. 1" = 40'
Vert. 1" = 4'

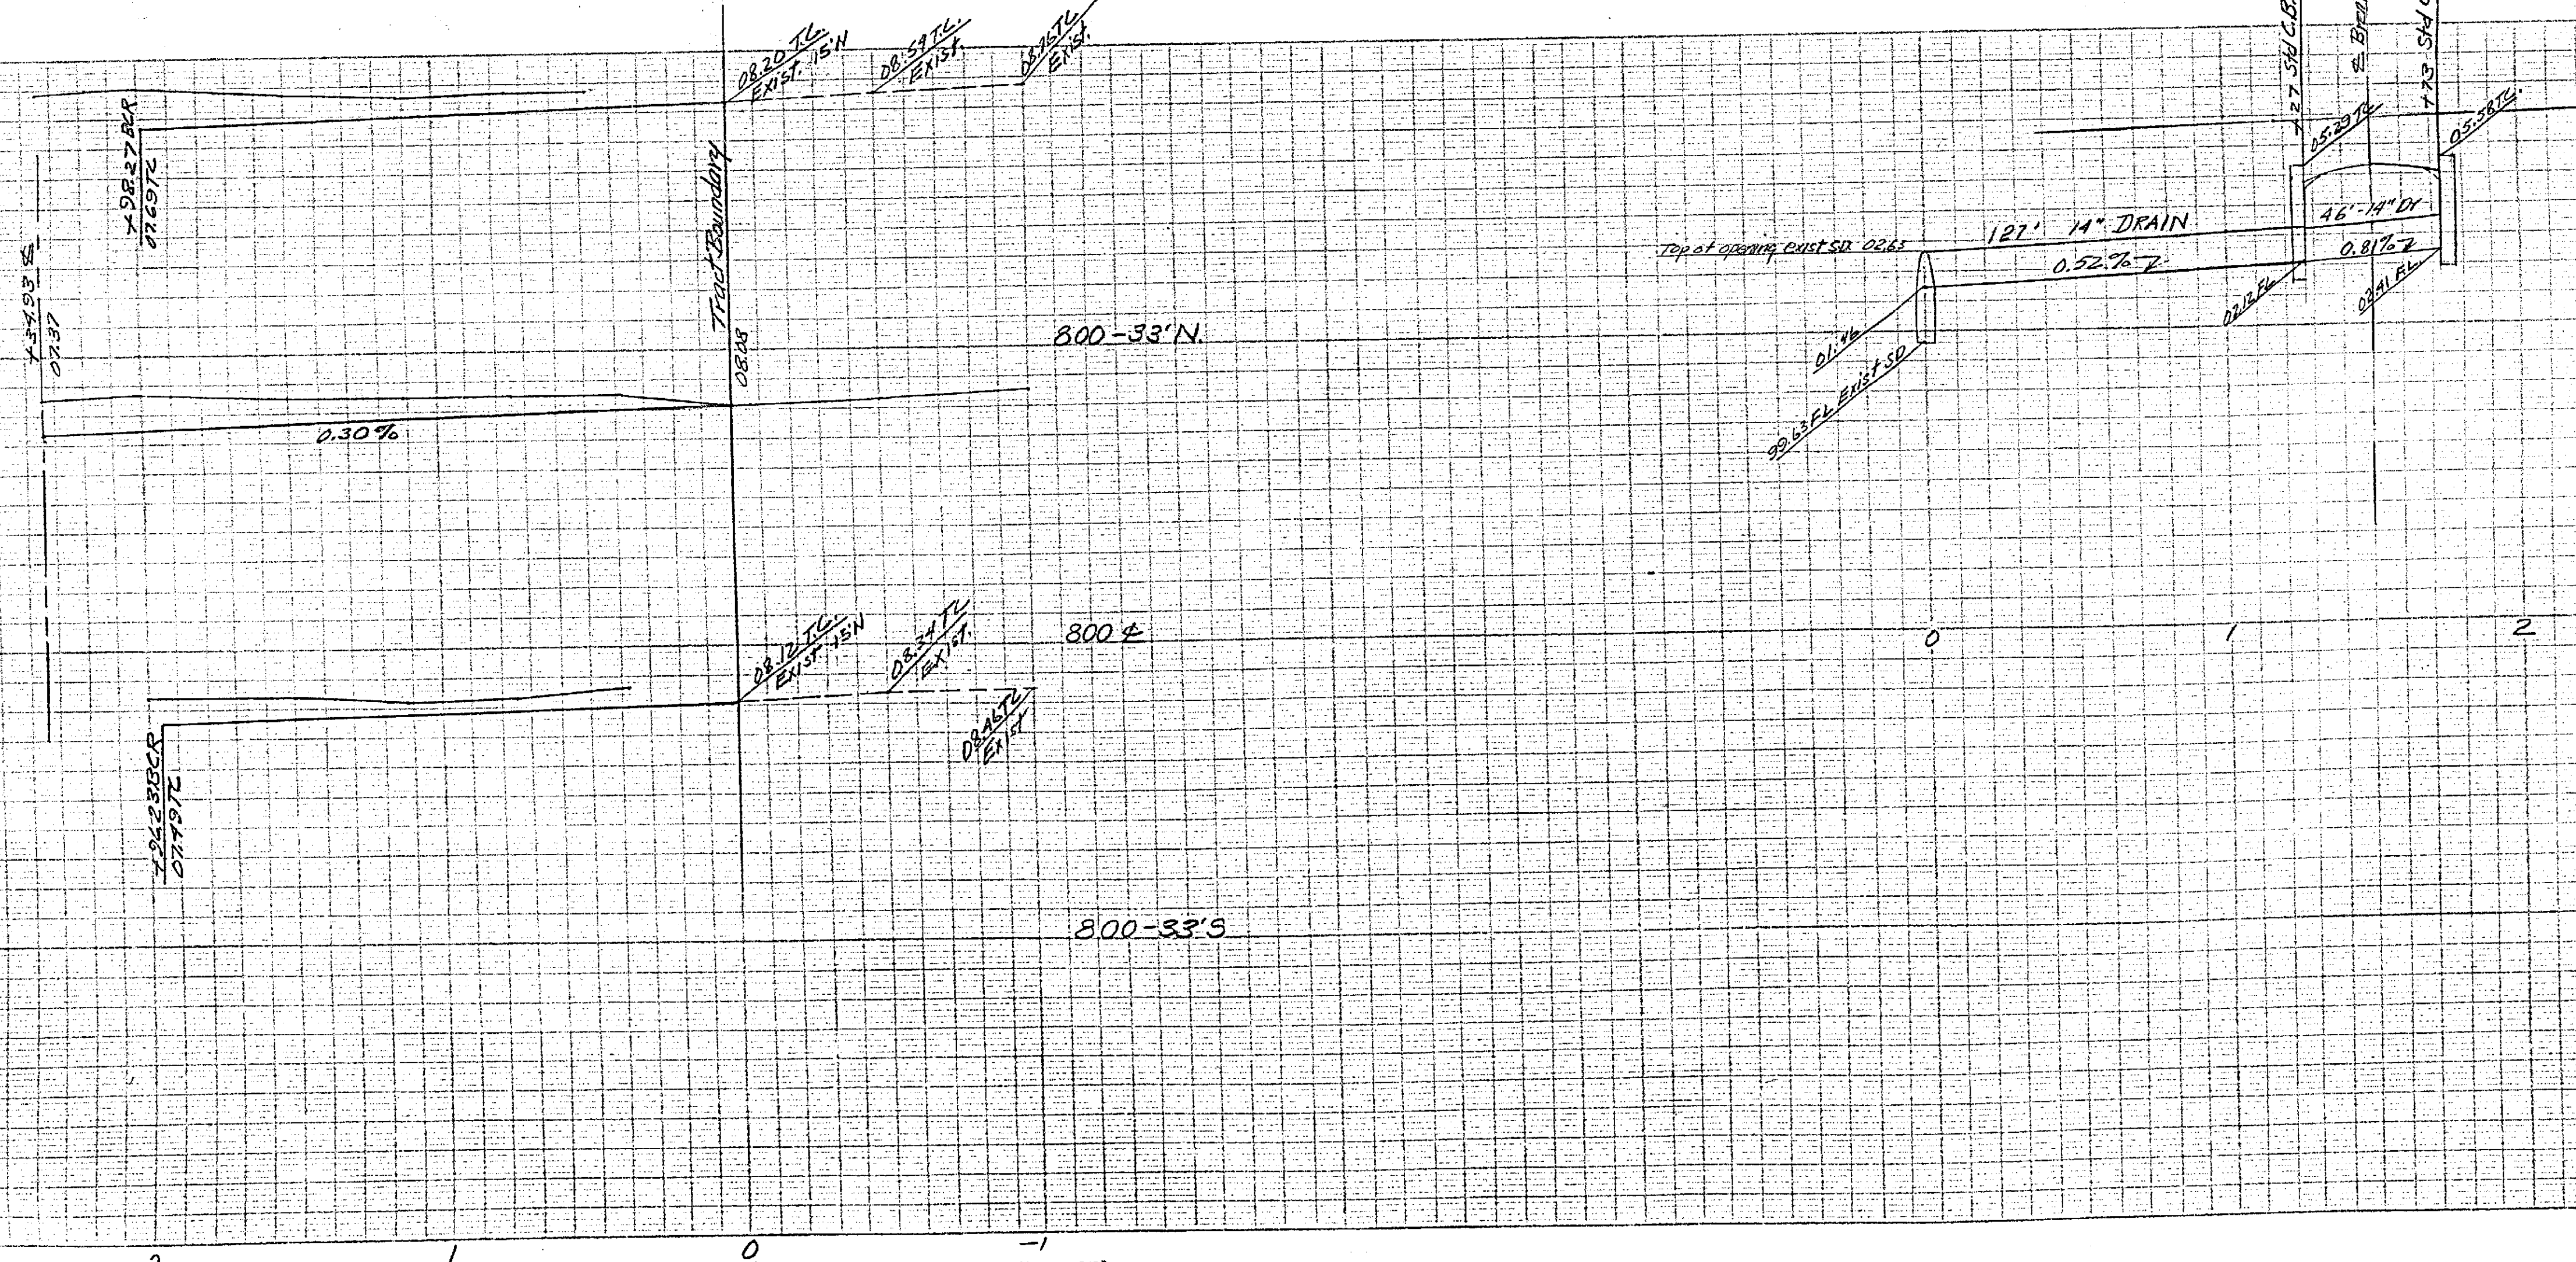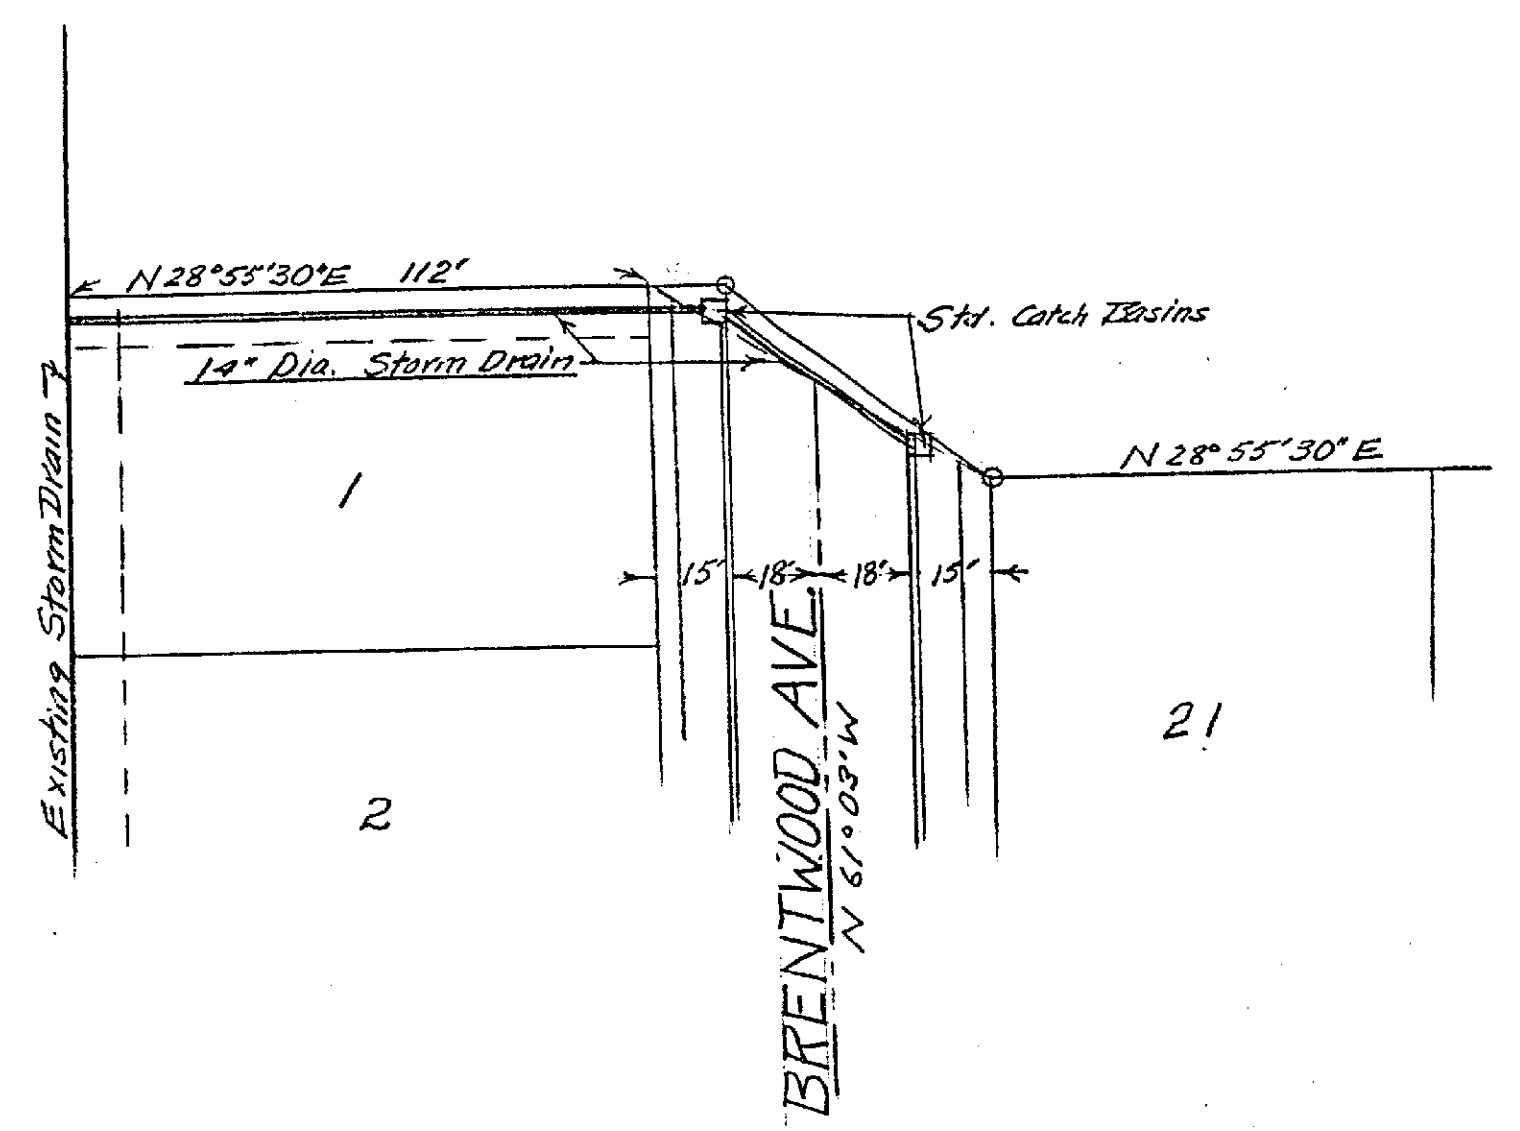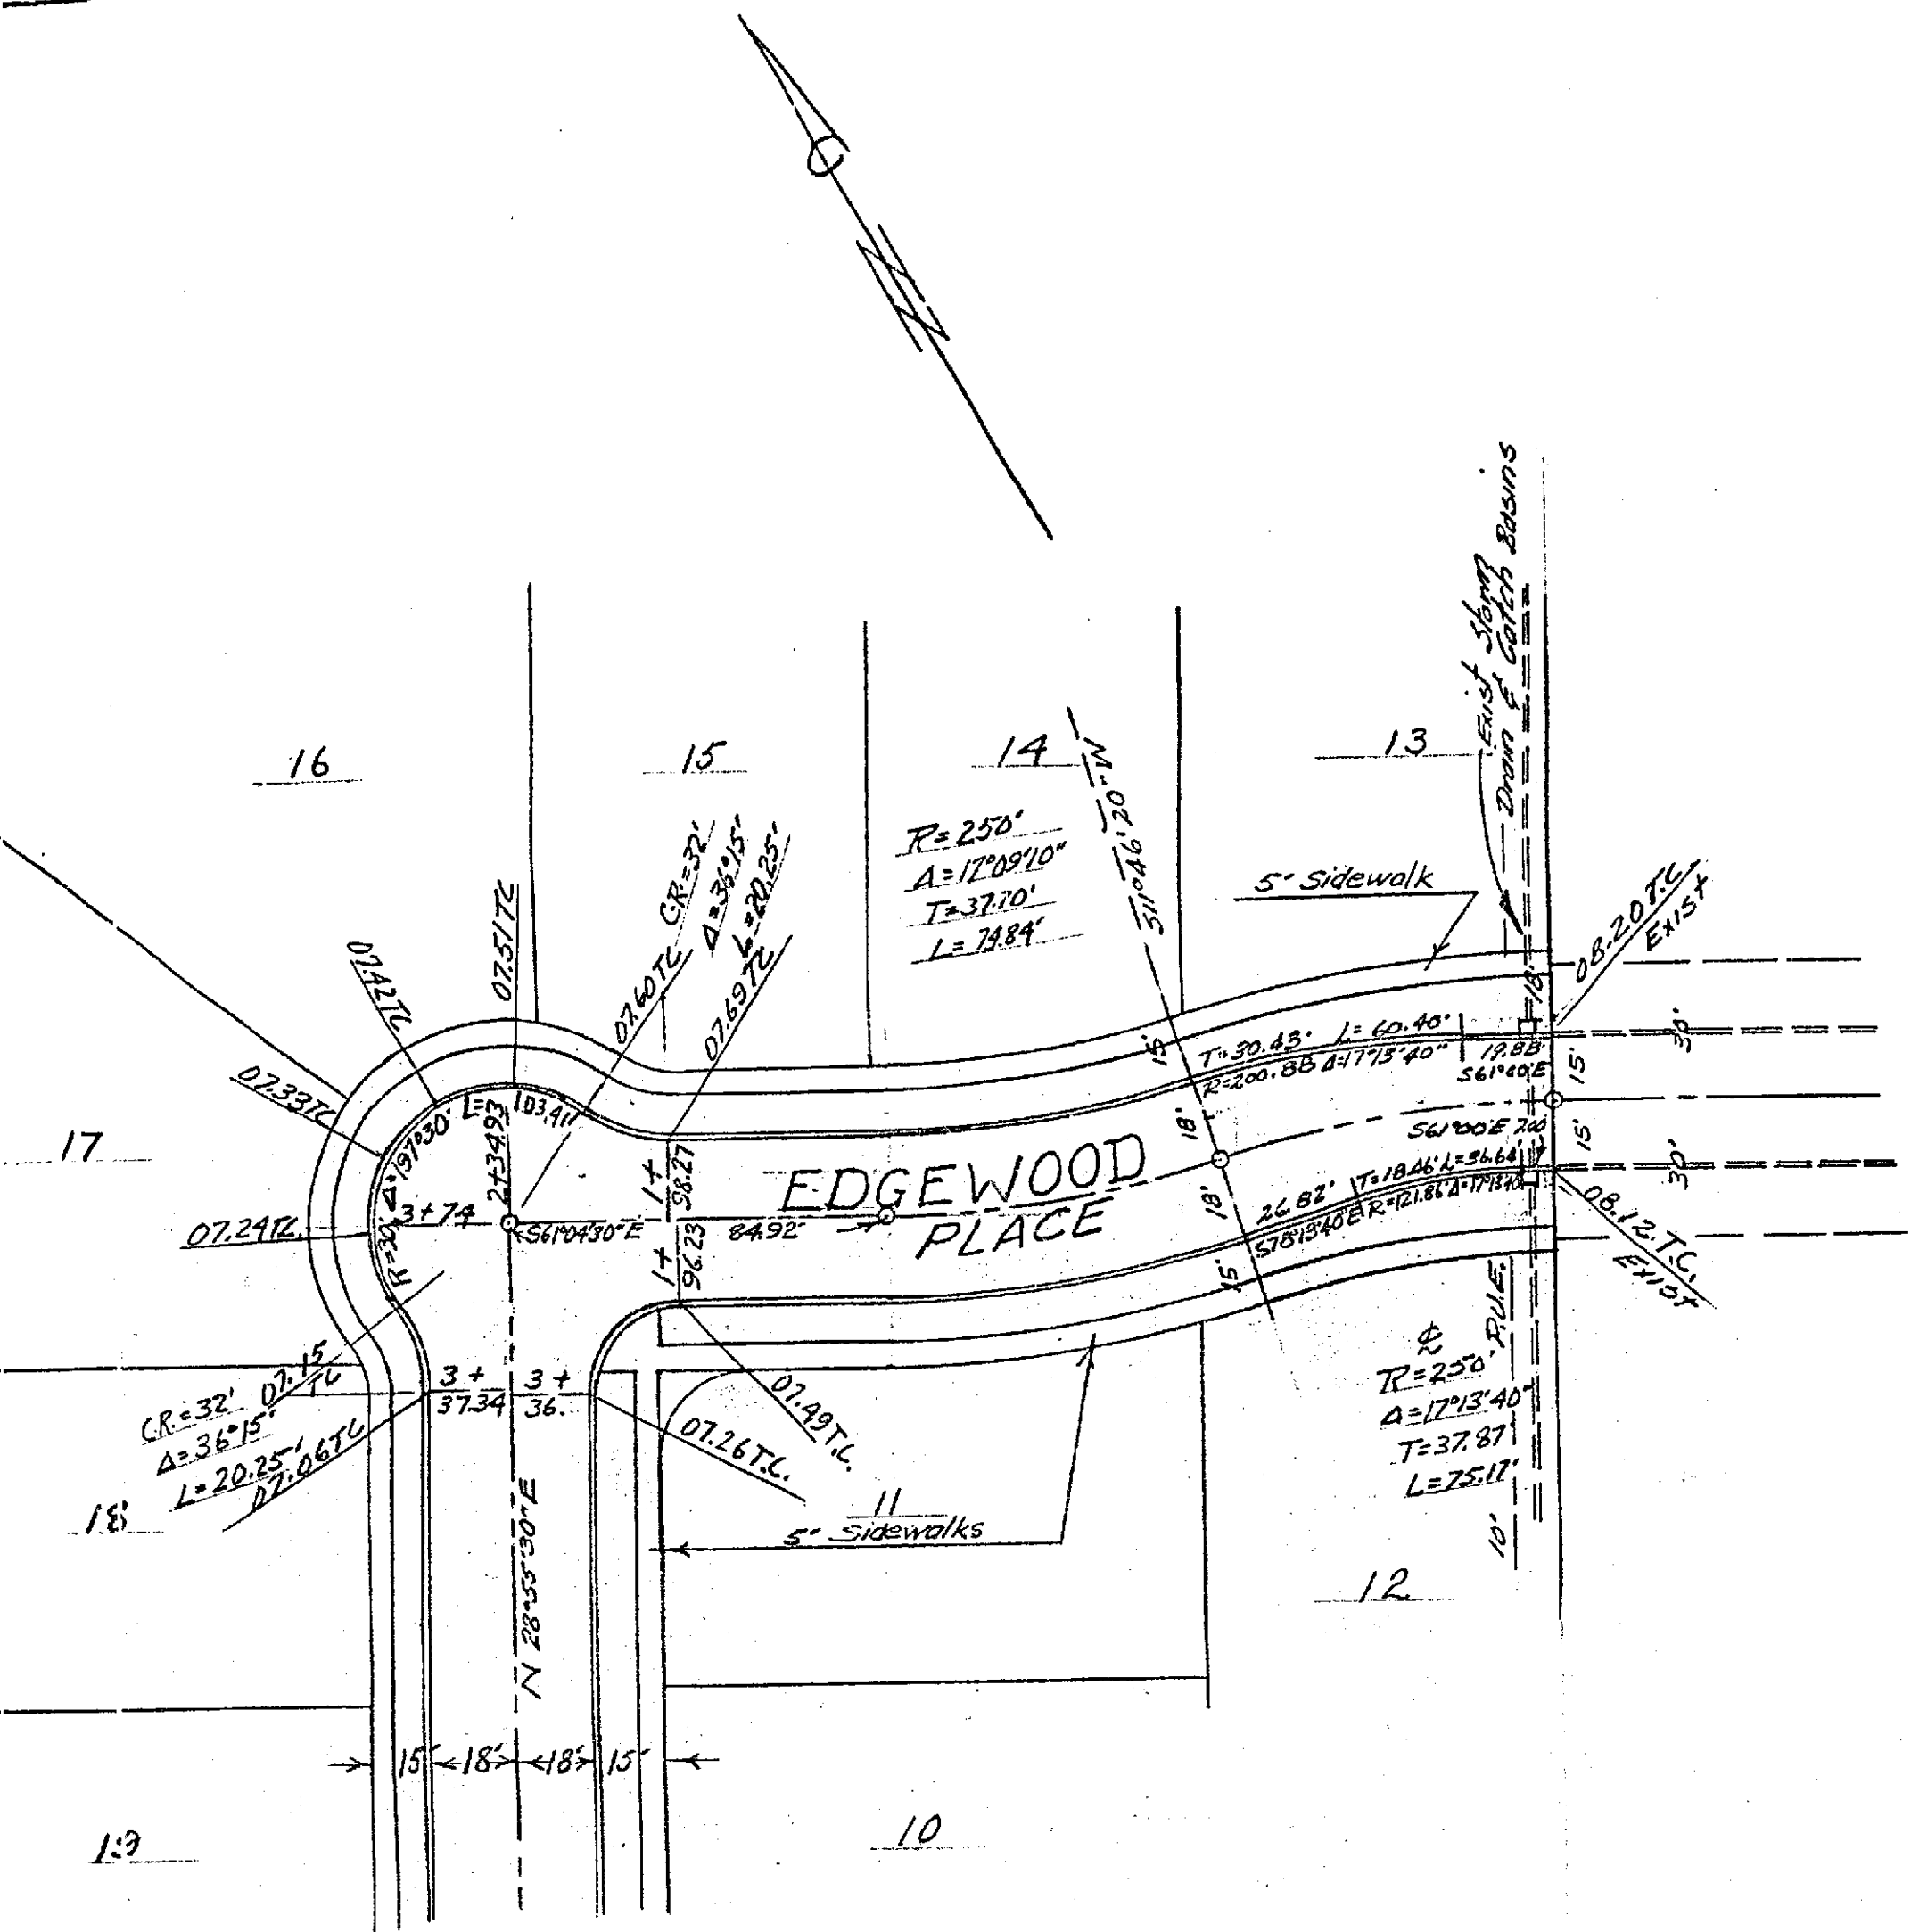




Approved M.H. Dumas 6-3-55
City Engineer

PROPERTY OF
CITY OF RIVERSIDE
CITY ENGINEERING DEPT.

PLAN AND PROFILE
EDGEWOOD PLACE
BRENTWOOD PARK
MARCH 1955 J.F. DAVIDSON C.E.
SCALE: HORIZ. 1"=40'
VERT. 1"=4'

1547




FB495-61 SHEET 2 OF 2

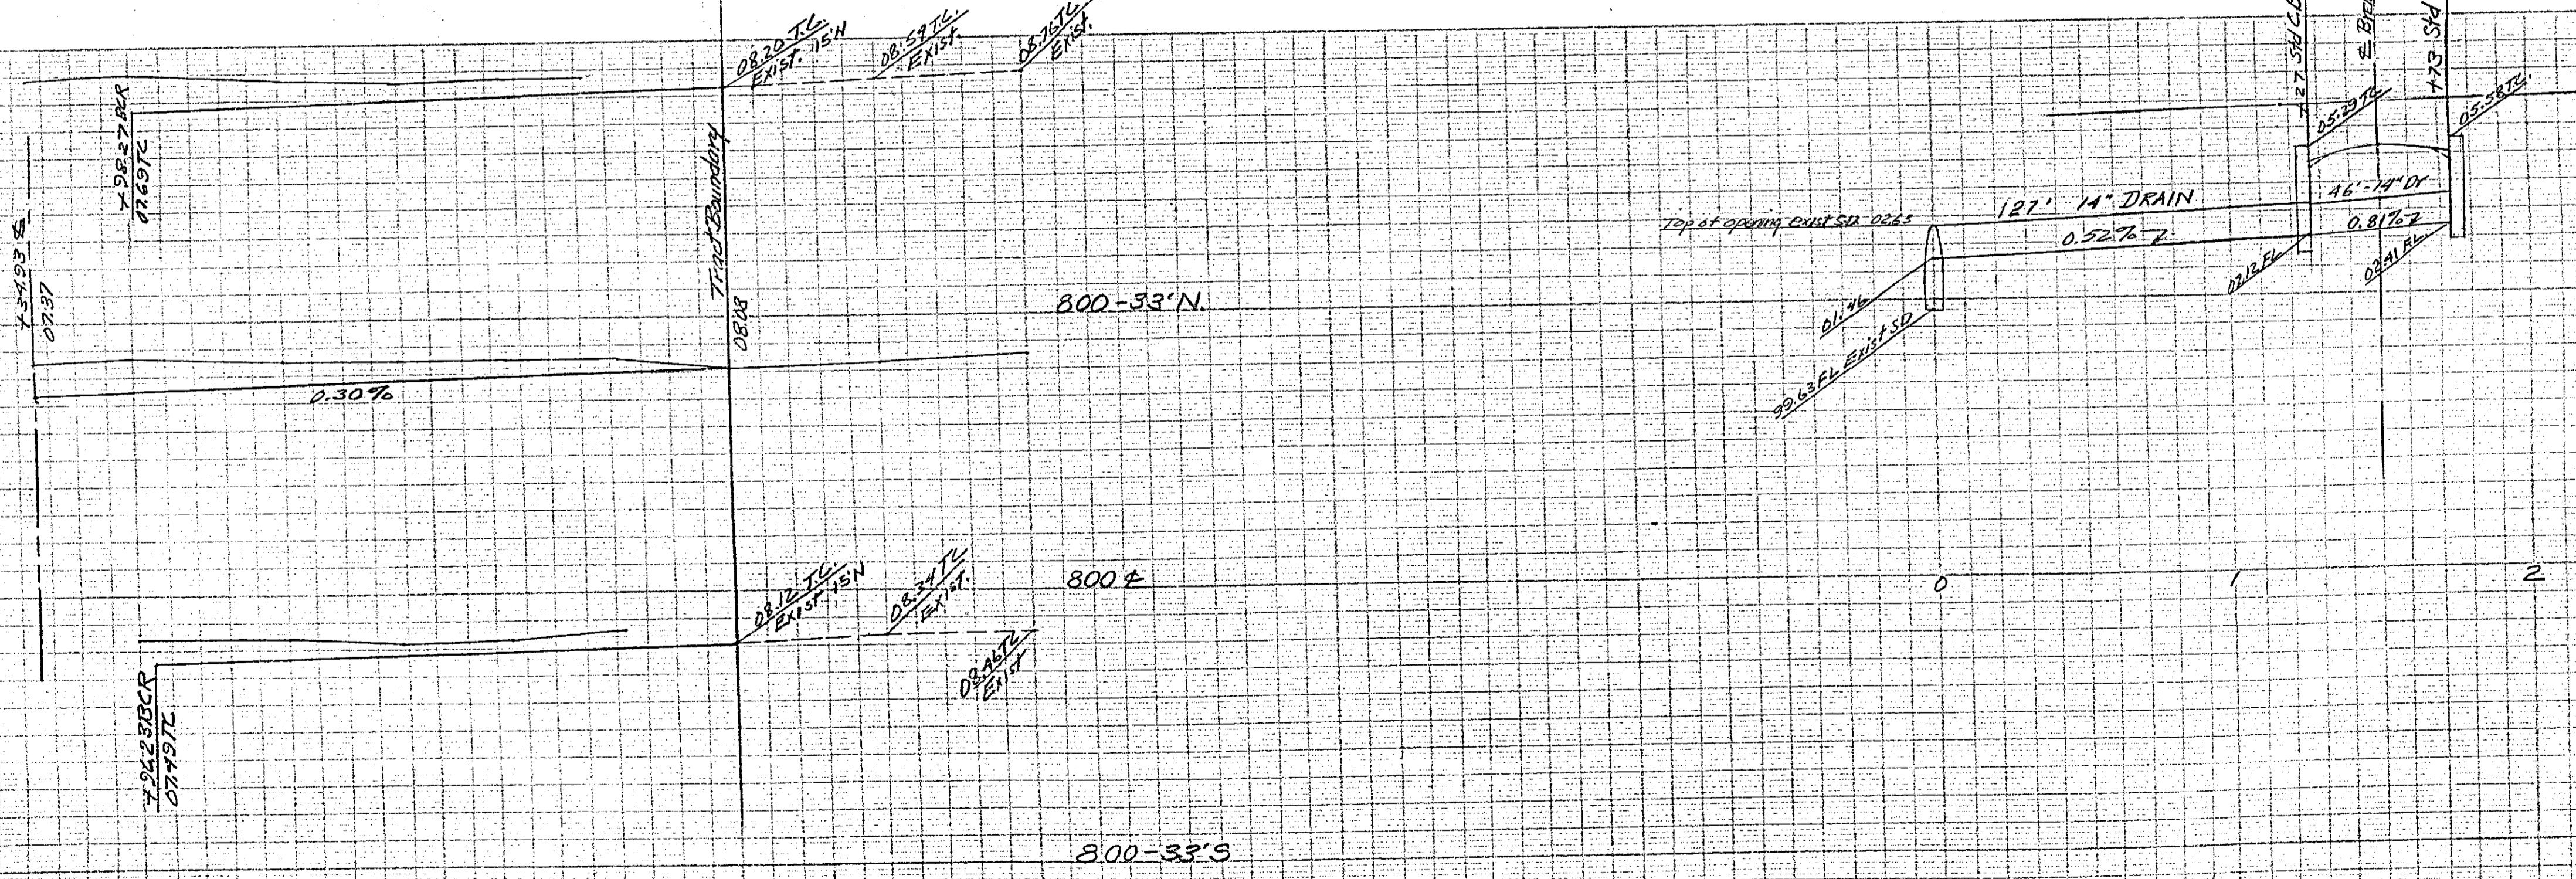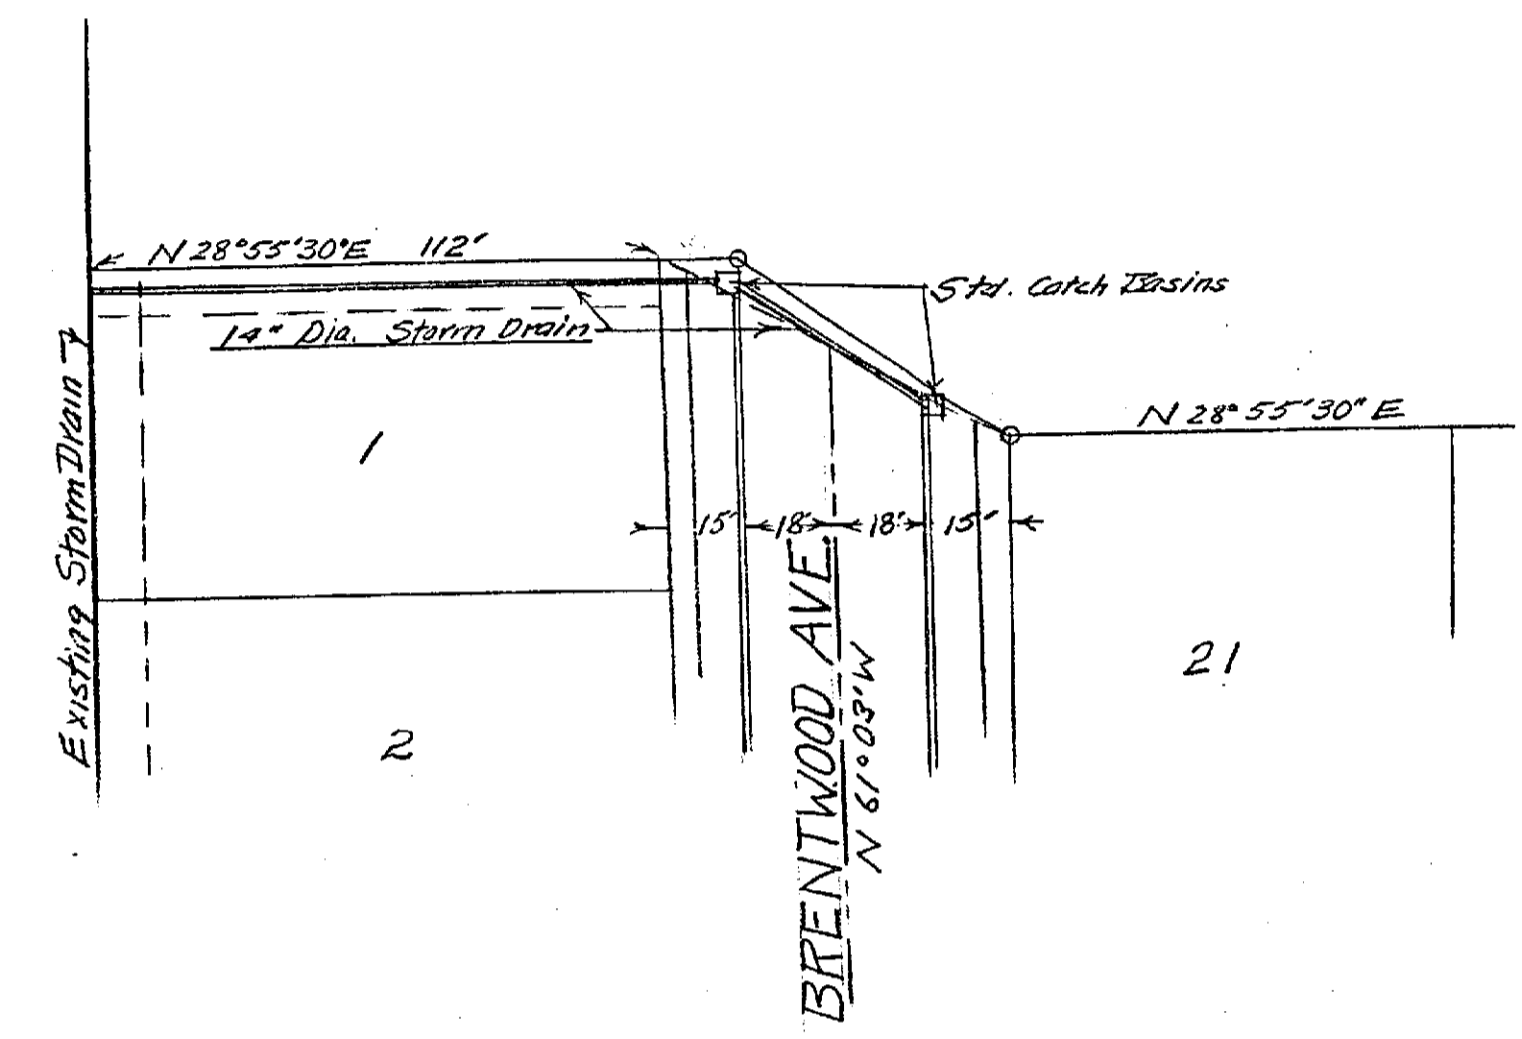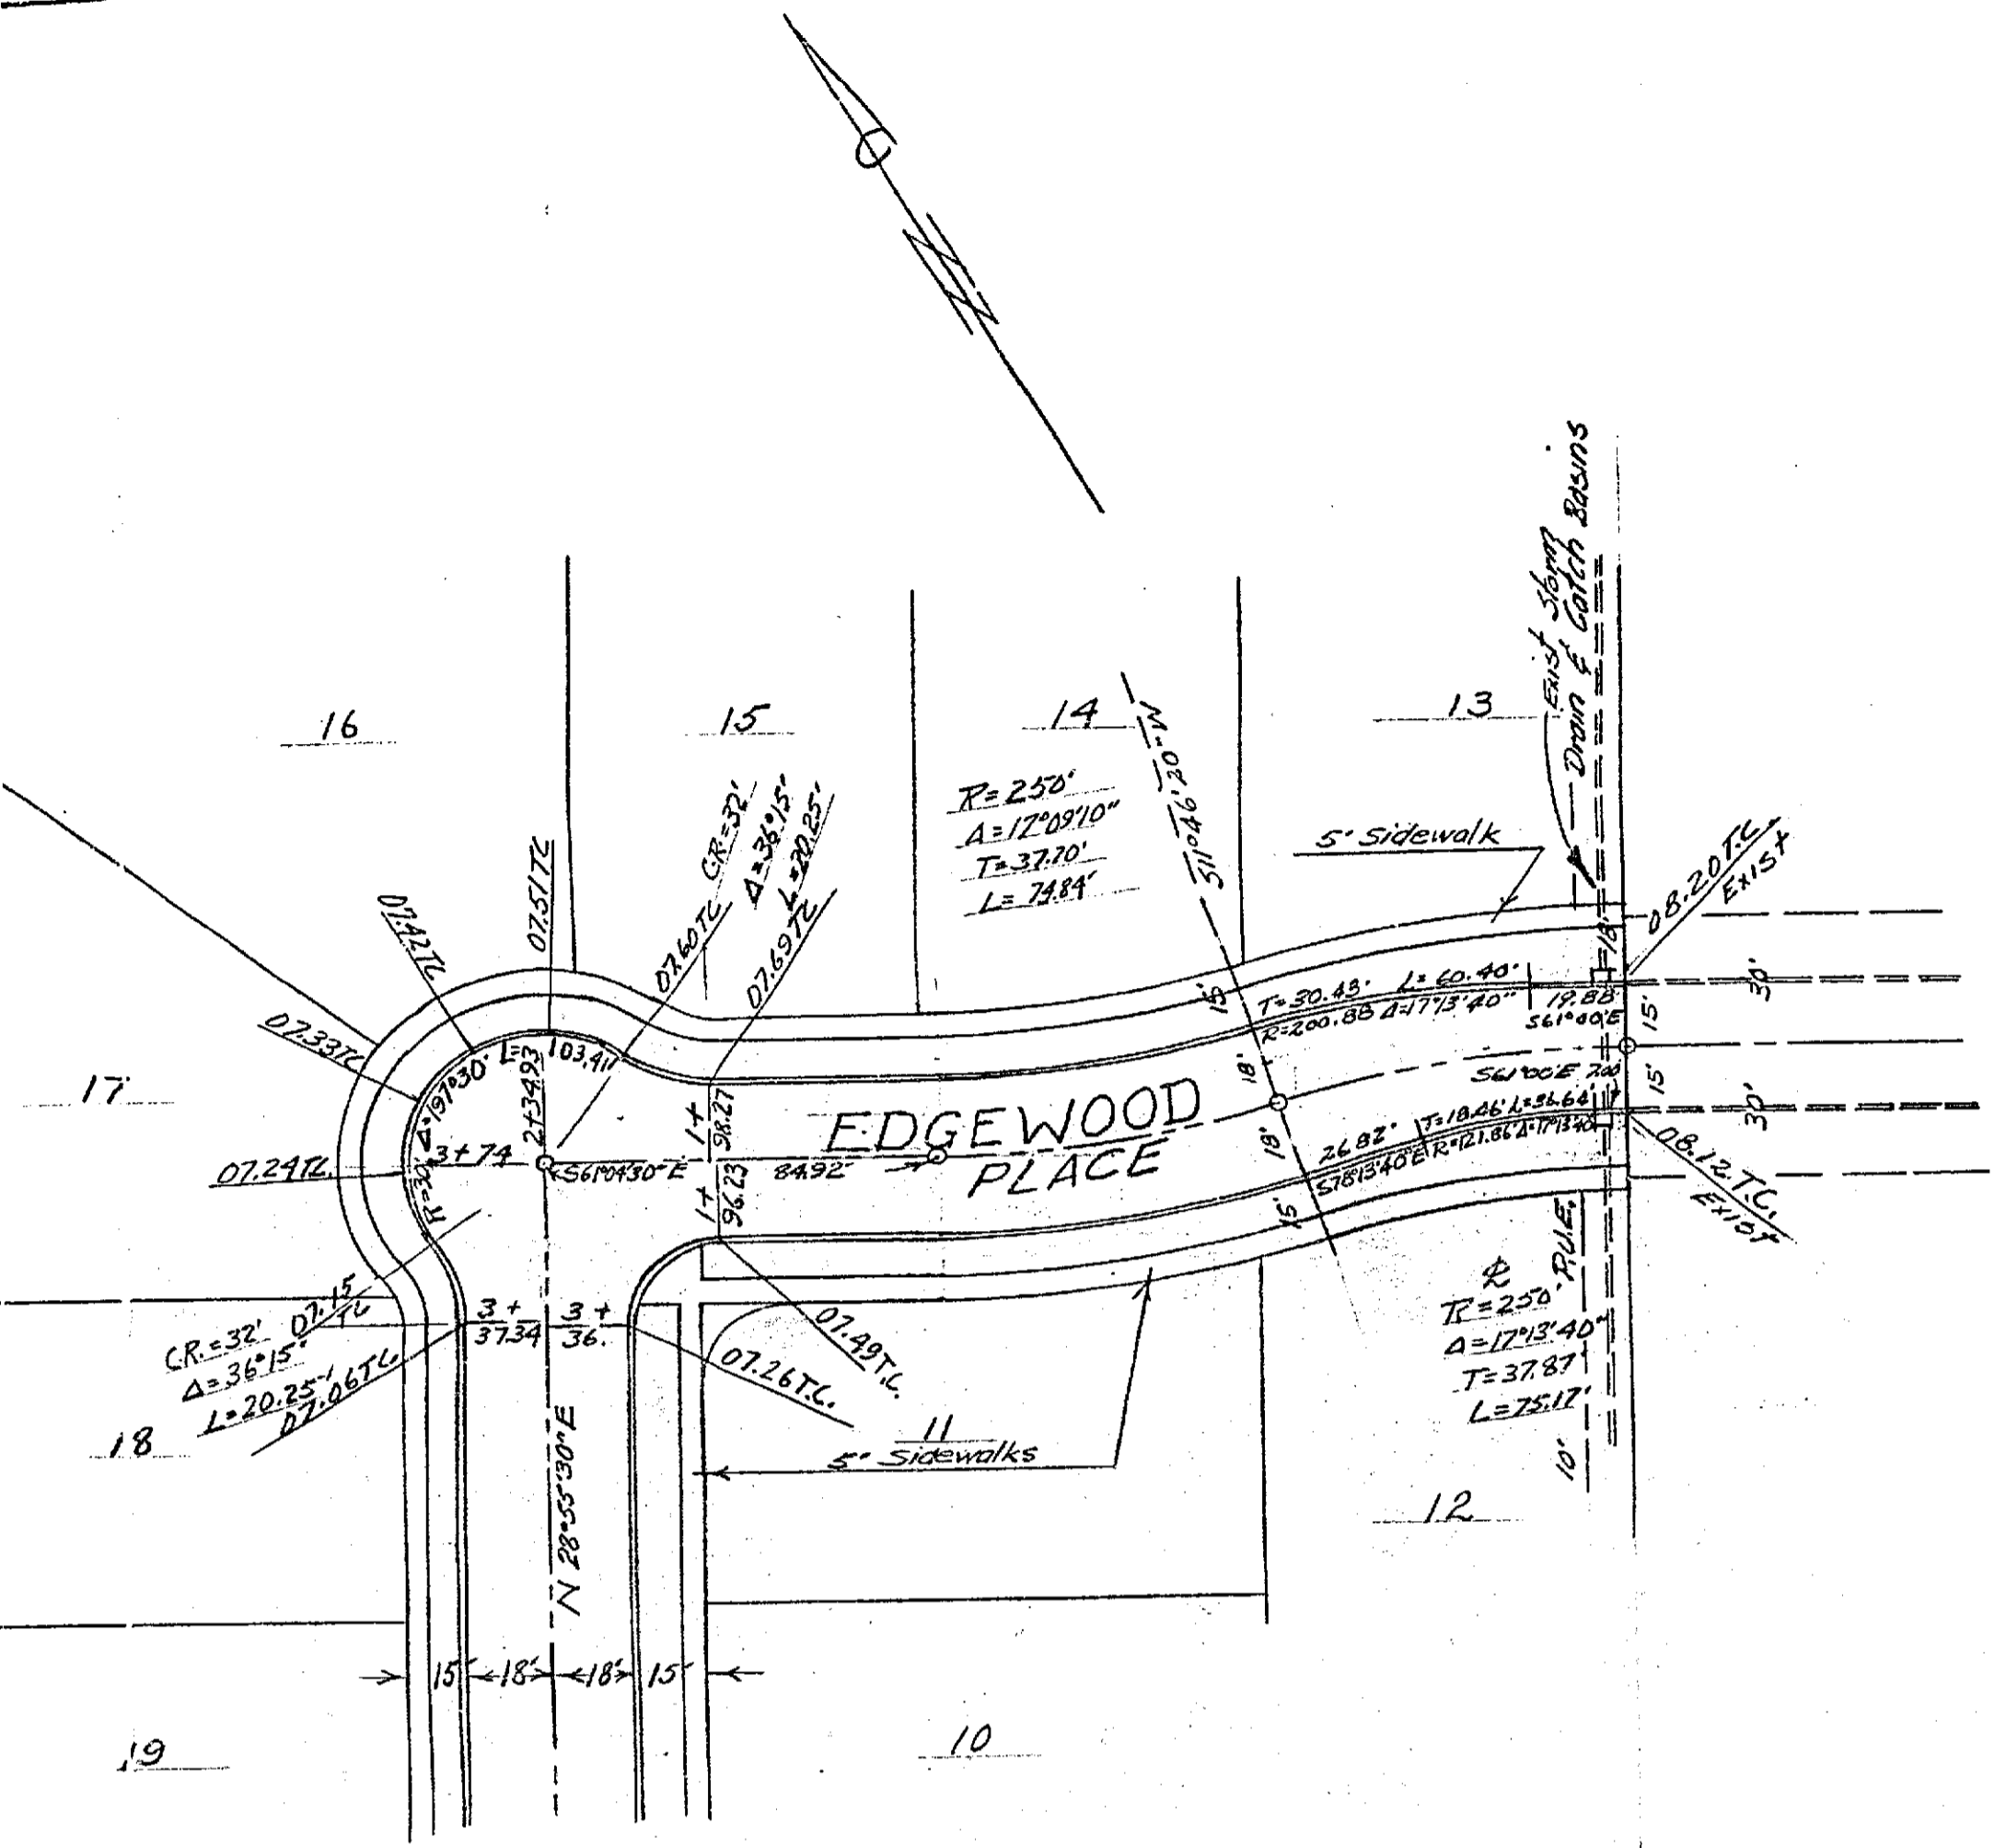

Approved *M. H. Durbin* 6-3-55
City Engineer

PLAN AND PROFILE
EDGEWOOD PLACE
BRENTWOOD PARK
MARCH 1955 J. E. DAVIDSON C.E.
SCALE: HORIZ. 1" = 40'
VERT. 1" = 4'
FB 495-61 SHEET 2 OF 2

15417

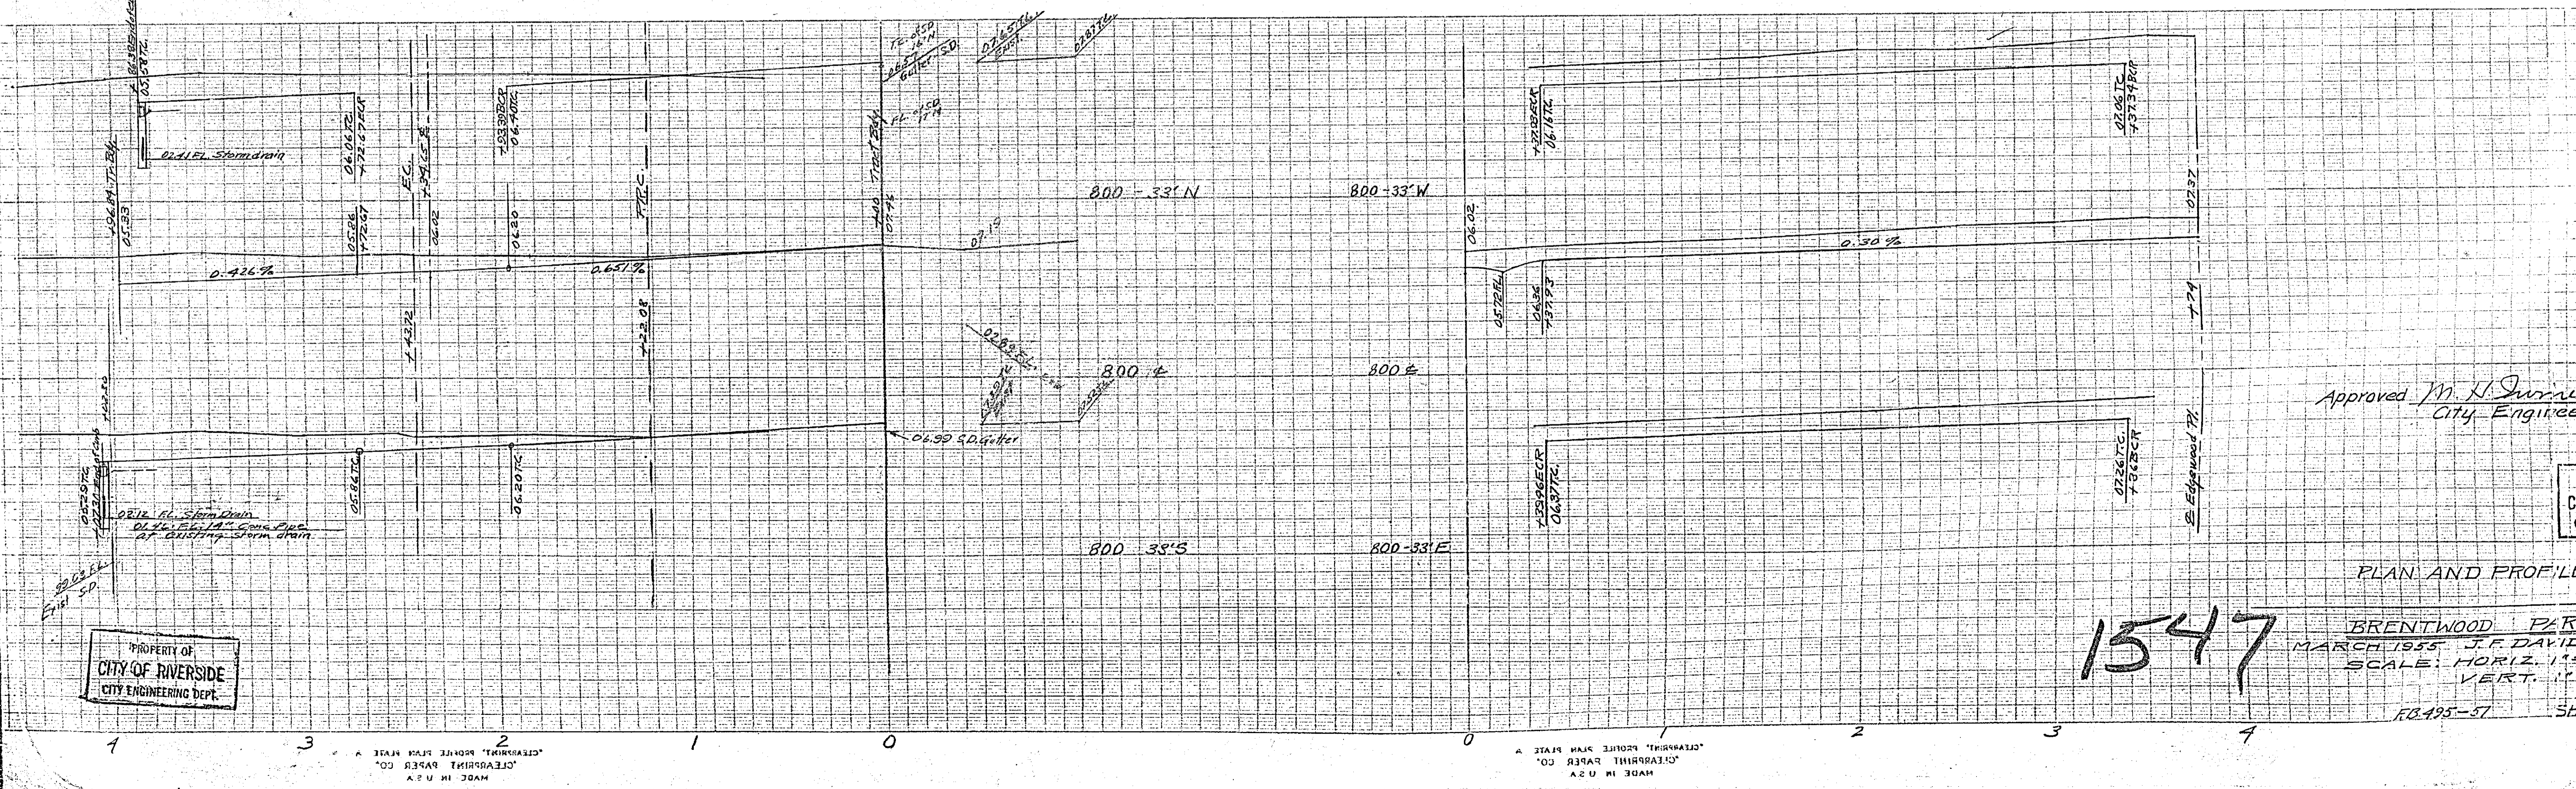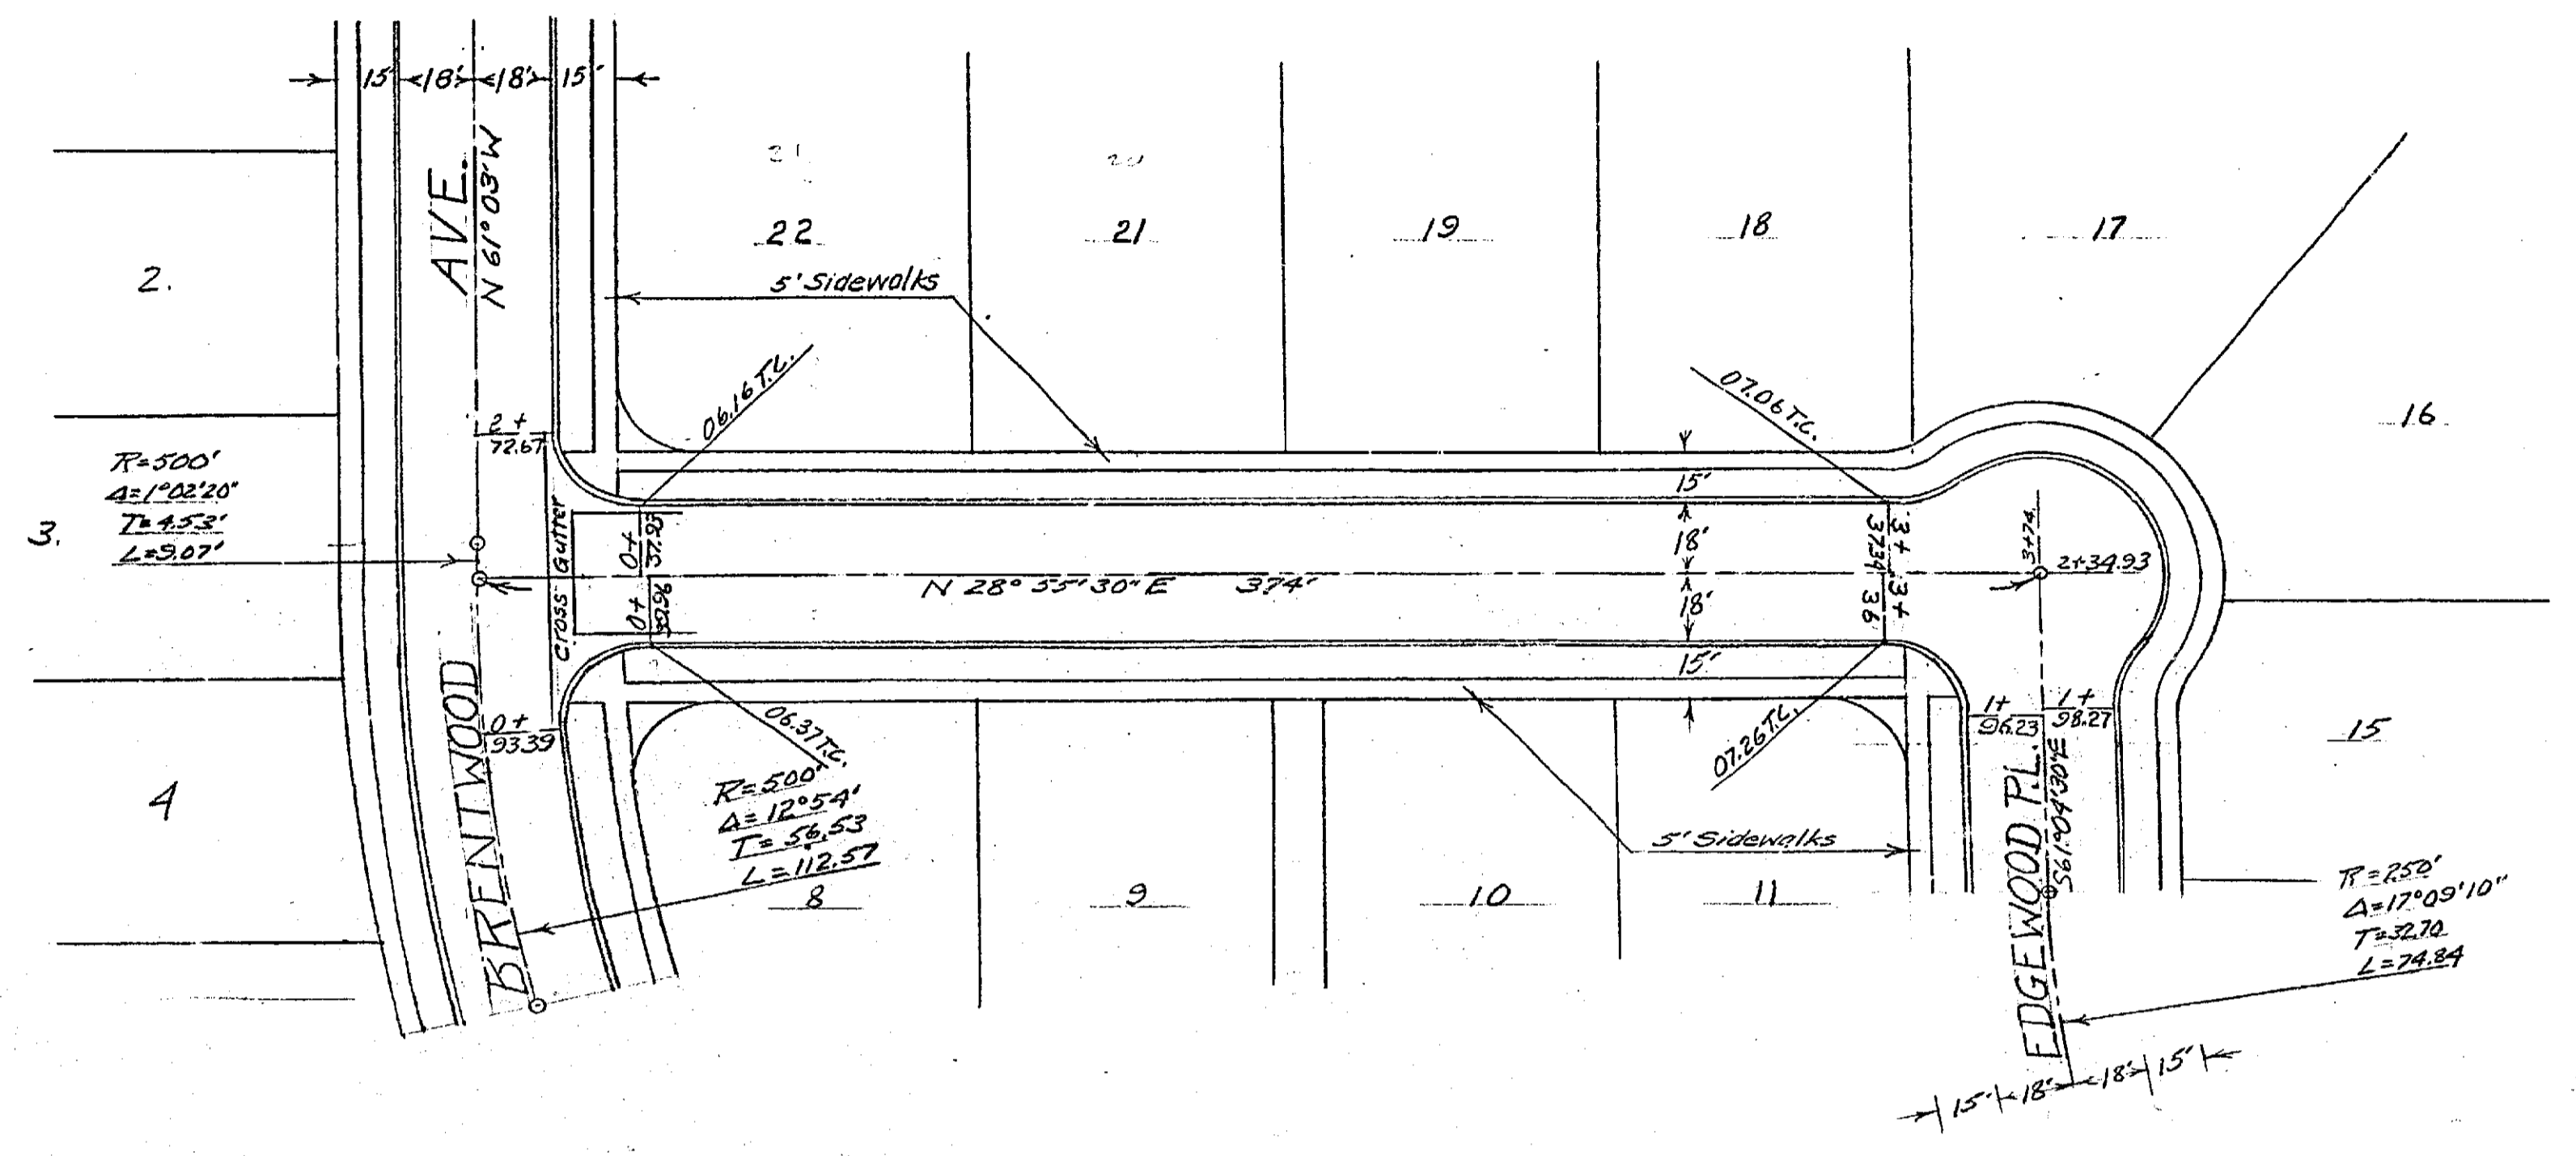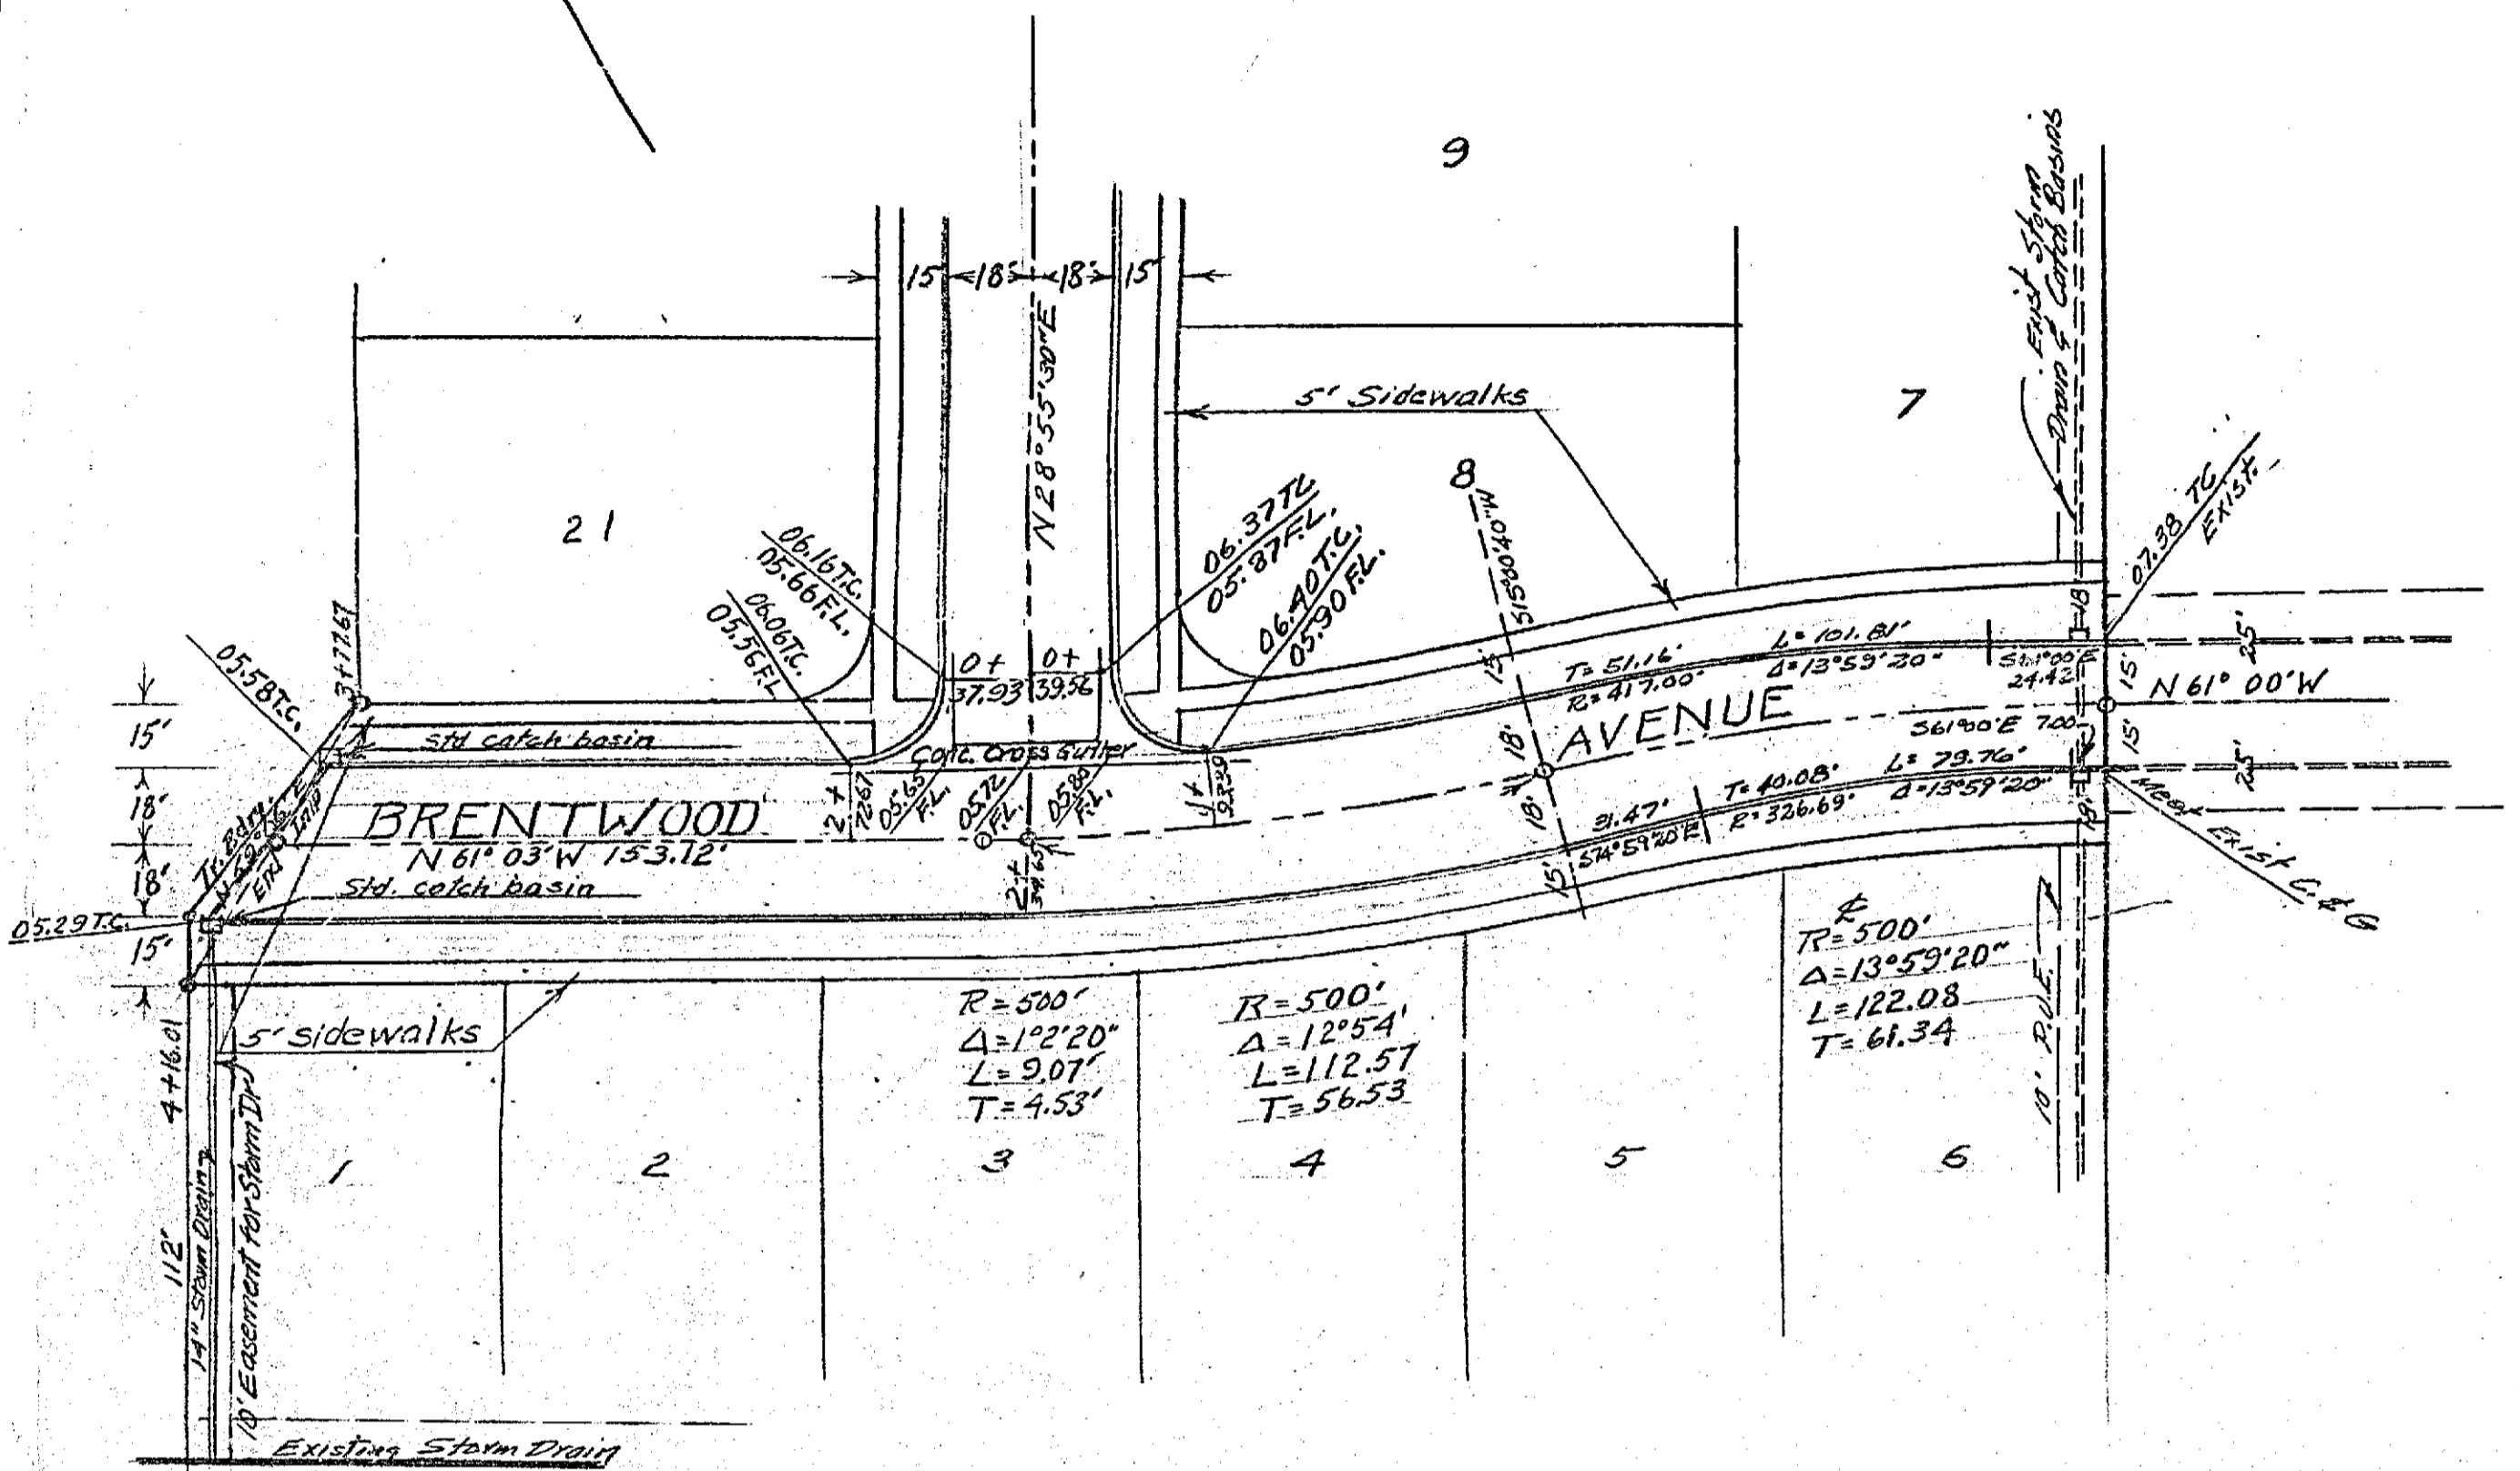

Approved *M. H. Swain*
City Engineer

PLAN AND PROFILE

1547

BRENTWOOD PARK
MARCH 1955 J.F. DAVIDSON
SCALE: HORIZ. 1" = 10'
VERT. 1" = 10'

FB 495-57 SH